
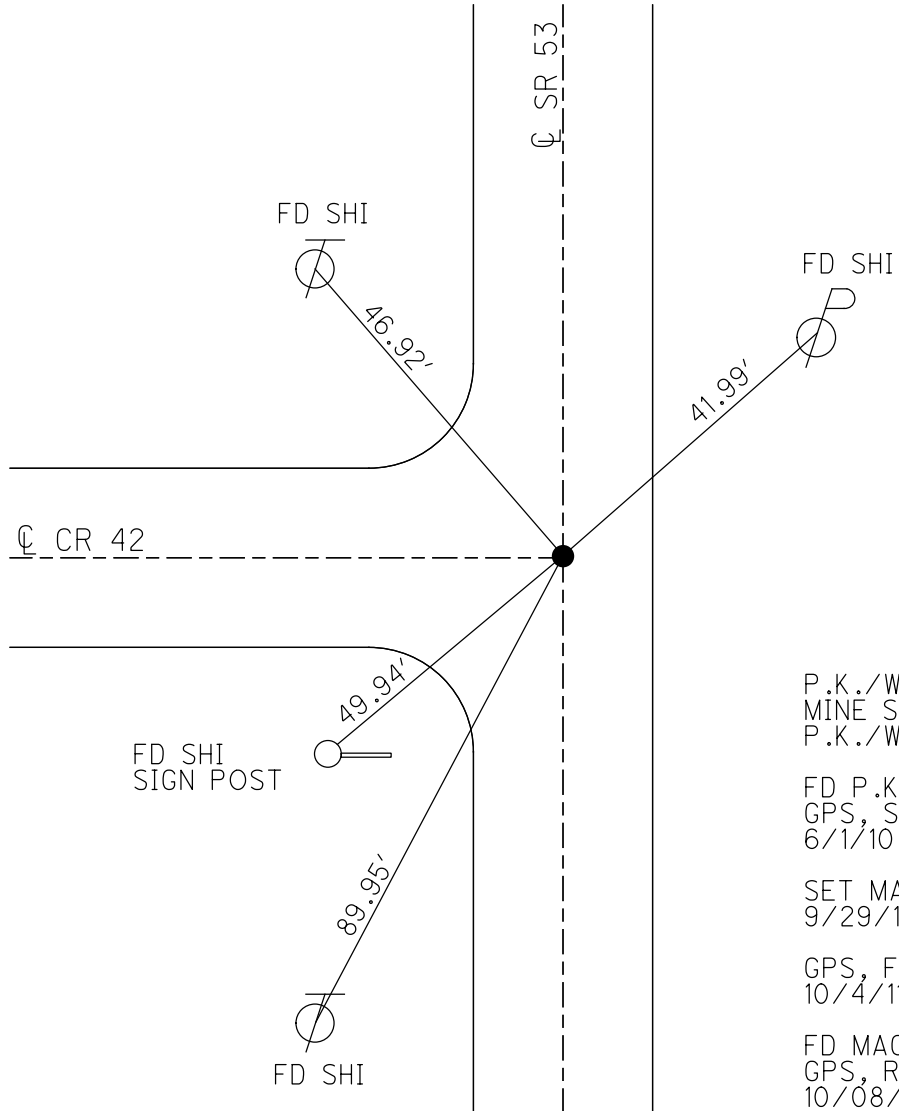


O.D.O.T. DISTRICT 2 SURVEY OFFICE (USE ONLY)

PERSONNEL	REFERENCE NO.	<u>70</u>	SHEET	<u>19</u>	OF	<u>26</u>
NOTES	<u>MOSER</u>	DATE	<u>6/14/11</u>	ROUTE	<u>SR 53</u>	
H.C.	<u>LUMBREZER</u>	WEATHER	<u>CLOUDY</u>	COUNTY	<u>SENECA</u>	
R.C.	<u>HARBAUGH</u>	TEMP.	<u>70°</u>	TOWNSHIP	<u>PLEASANT</u>	
				SECTION	<u>18</u>	
				<u>T 3 N</u>	<u>R 15 E</u>	

TYPE MONUMENT P.K.SHANK
~~ON SURFACE~~ - BELOW 3"
 LEFT - CL PAV'T - RIGHT ON
20.45' TO RT EDGE PAVEMENT
 S.L.M. 907+41.28
 GRID: NORTHING: 568752.474 EASTING: 1784843.596

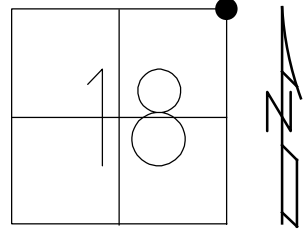

P.K./WASHER ATOP
 MINE SPIKE BELOW
 P.K./WASHER
 FD P.K.SHANK
 GPS, SV115
 6/1/10, KPM
 SET MAG/WASHER
 9/29/11, RJL
 GPS, FIN115
 10/4/11, RJL
 FD MAG/WASHER
 GPS, REF70
 10/08/20, JFO

O.D.O.T. DISTRICT 2 SURVEY OFFICE (USE ONLY)

PERSONNEL

REFERENCE NO. 70

SHEET 19 OF 26

NOTES MOSE

DATE 6/14/11

ROUTE SR 53

H.C. LUMBREZER

WEATHER CLOUDY

COUNTY SENECA

R.C. HARBAUGH

TEMP. 70°

TOWNSHIP PLEASANT

SECTION 18

T 3 N R 15 E

TYPE MONUMENT P.K.SHANK



~~ON SURFACE~~ - BELOW 3"

LEFT - Q PAV'T - RIGHT ON

20.45' TO RT. EDGE PAVEMENT

S.L.M. 907+41.28

Grid: Northing: 568752.5261 Easting: 1784843.5472

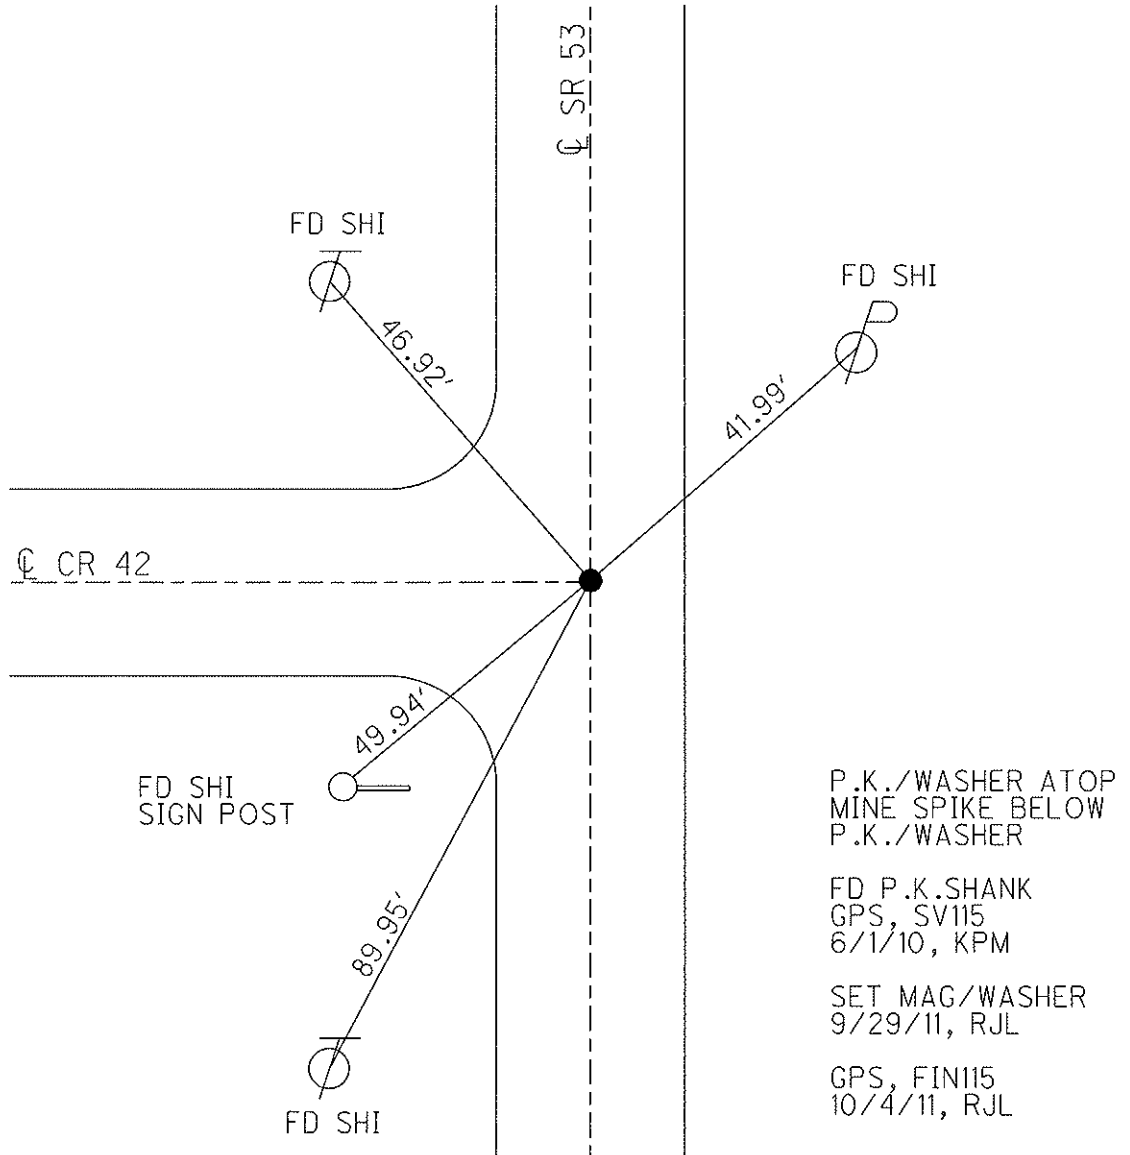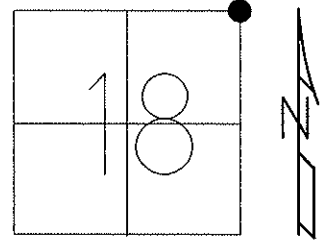

O.D.O.T. DISTRICT 2 SURVEY OFFICE

PERSONNEL



NOTES CRONIN
 H.C. RIPPLE
 R.C. BARBOUR
GEYMAN

REFERENCE NO. 70
 DRAWN 9/12/88-RAN
 DATE 8/31/88
 WEATHER SUNNY
 TEMP. 60°

SHEET 20 OF 21

ROUTE #53
 COUNTY SENECA
 TOWNSHIP PLEASANT
 SECTION 18
T 3 N R 15 E

TYPE MONUMENT P.K. & WASHER
 ON SURFACE - BELOW _____
 LEFT - € PAV'T. - RIGHT _____
 _____ TO _____ EDGE PAVEMENT
 S.L.M. 907446.30

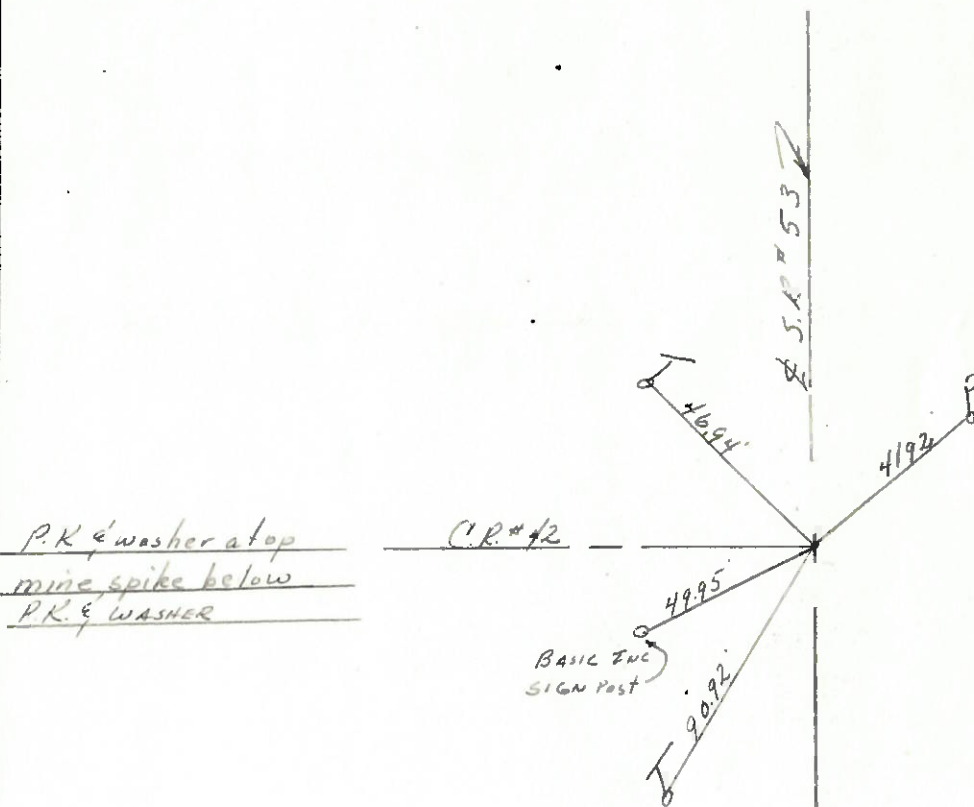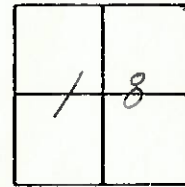


PERSONNEL	TITLE	PERSONNEL	TITLE	COUNTY	DATE
Schneider		Cronin		Seneca	5-7-77
Barbour		Ripple		S. R. 53	Weather Hot
		Geyman		SEC. 18&17-7&8	TEMP. 90°

DESCRIPTION Tiffin to Sandusky Co. Line JOB NO. _____

71-A


933+27.18
Iron pin in
Mon. Box # 1

center of Box
is tied in.

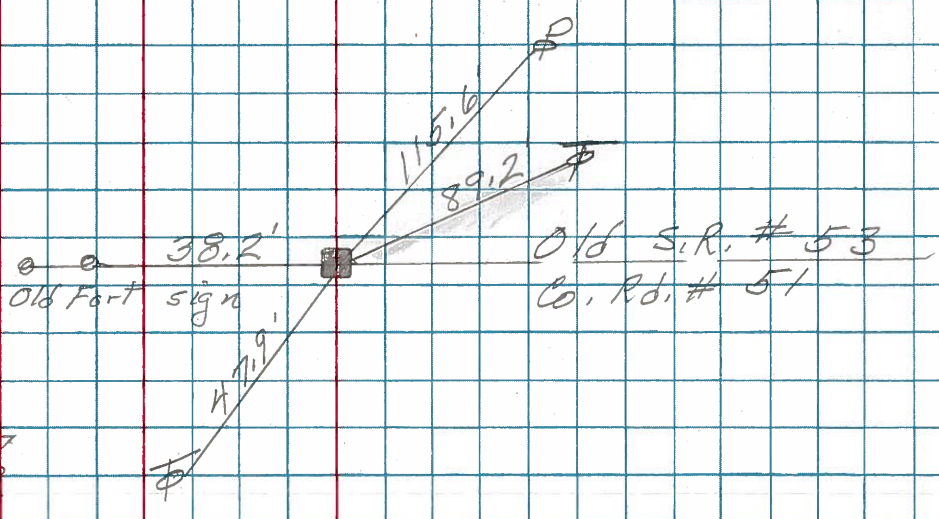


71

P.I.
930+69.77
small spk.
1" down

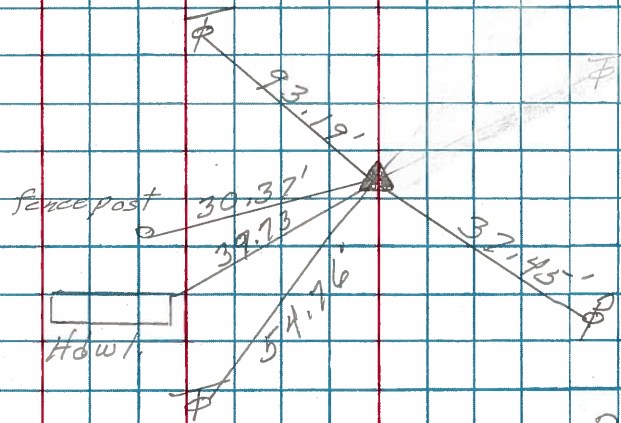

70

P.I.
907+46.30
small spk.
Reset P.K. Nail

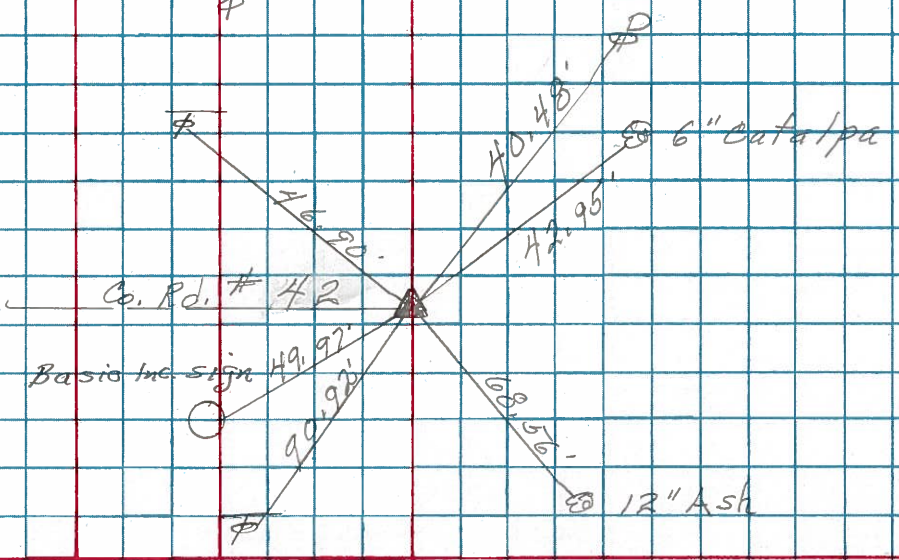


PERSONNEL	TITLE	PERSONNEL	TITLE	COUNTY	DATE
Schneider				Seneca	10-1-69
Mosser				S. R. 53	WEATHER Fair
Barbour				SEC. Tiffin to Sen. Co. Lines	TEMP. 70°
Potts					


DESCRIPTION Ties for Control Points JOB NO. _____

LEFT CENTER LINE RIGHT


70
 907+46.30
 small spk.
 8388

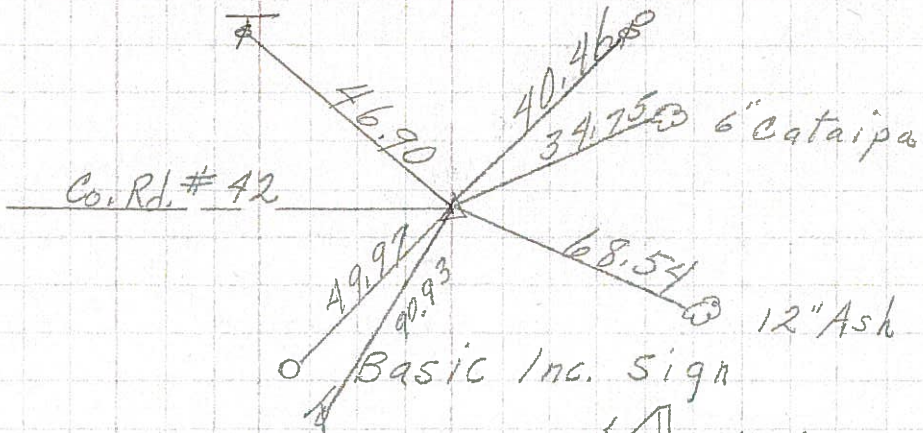


69-A
 880 + 32.81
 small spk.
 8388

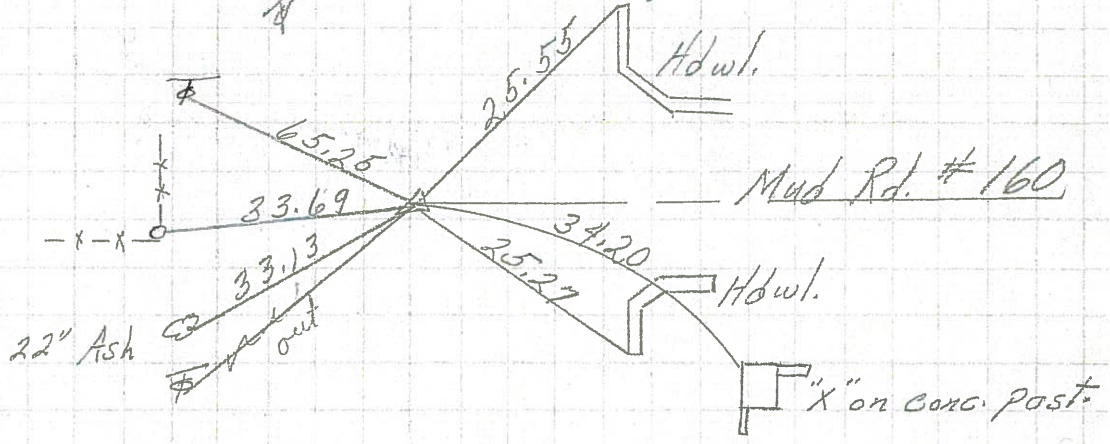

69
 870+59.75
 small spk.
 8386

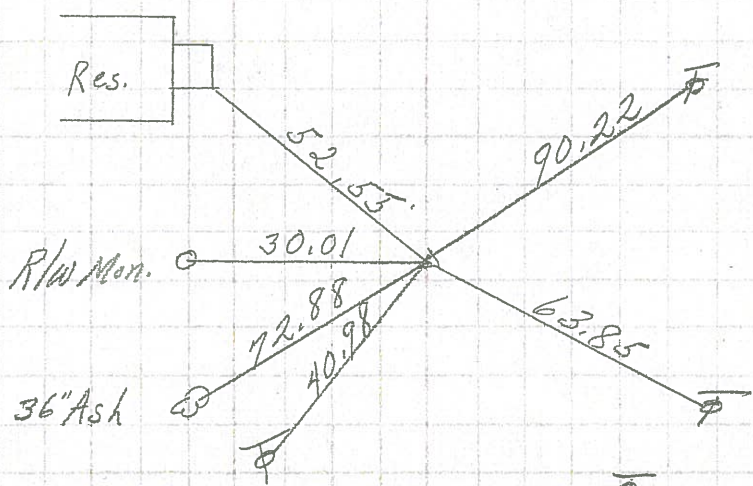


68
 860+60.77
 R.R. spk. 2" down
 8385

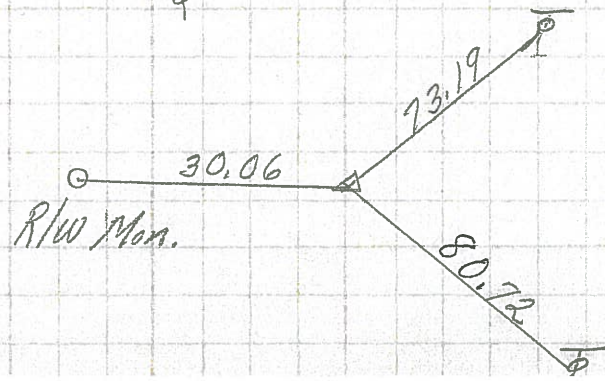

PERSONNEL	TITLE	PERSONNEL	TITLE	COUNTY	DATE
Kradlich				Seneca	
Xowaleski				# 53	
Geymatt					

DESCRIPTION	LEFT	CENTER LINE	RIGHT	JOB NO.
-------------	------	-------------	-------	---------

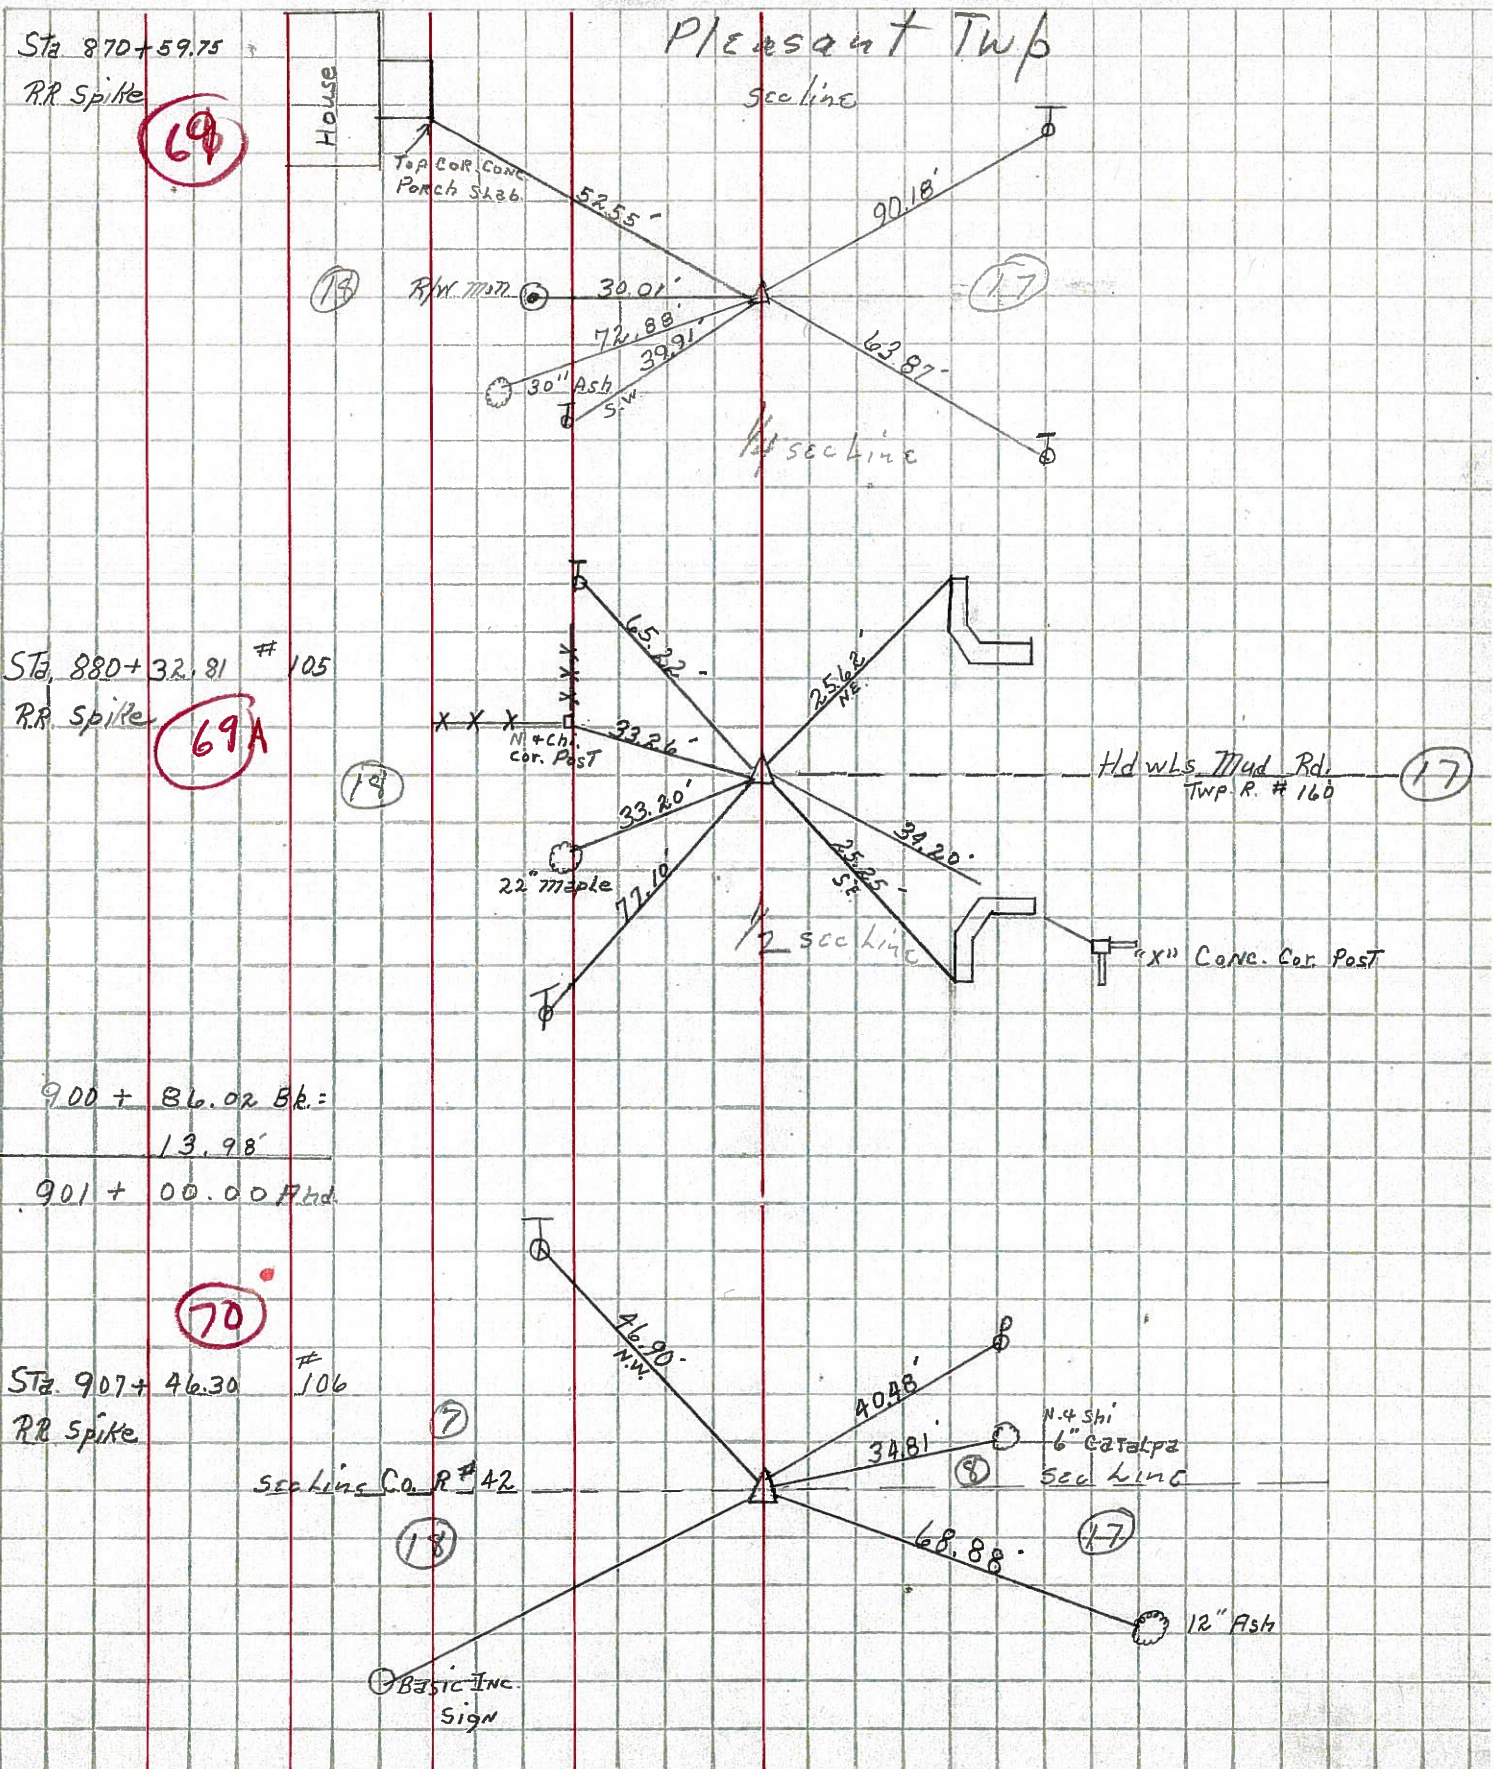

POT. = 900 + 86.02 Bk. =
 To Eg. = 13.98'
 TOT. = 901 + 00.00 Fhd.