


O.D.O.T. DISTRICT 2 SURVEY OFFICE (USE ONLY)

PERSONNEL _____ REFERENCE NO. 5 SHEET 6 OF 11
 NOTES RHOADES DATE 4/3/15 ROUTE SR 67
 H.C. LEU WEATHER FAIR COUNTY SENECA
 R.C. RHOADES TEMP. 46° TOWNSHIP EDEN
 _____ SECTION 27
 _____ T 1 N R 15 E

TYPE MONUMENT P.K./WASHER
 ON SURFACE - ~~BELOW~~ ON _____
~~LEFT~~ - C PAV'T - RIGHT 1.5'
8.5' TO RT EDGE PAVEMENT
 S.L.M. 83+15.01

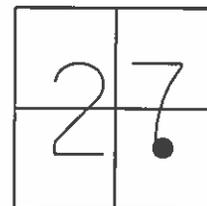


Grid: Northing: 490664.998 Easting: 1797786.100

RECORD: P.I.
 STA = 83+43.87

FD P.K./WASHER
 5/3/94, DC
 SET P.K./WASHER
 5/26/94, DC

FD P.K./WASHER
 GPS, REFS
 2/19/14, TMR

SET MAG/WASHER
 GPS, NEWREFS
 7/8/15, JFO

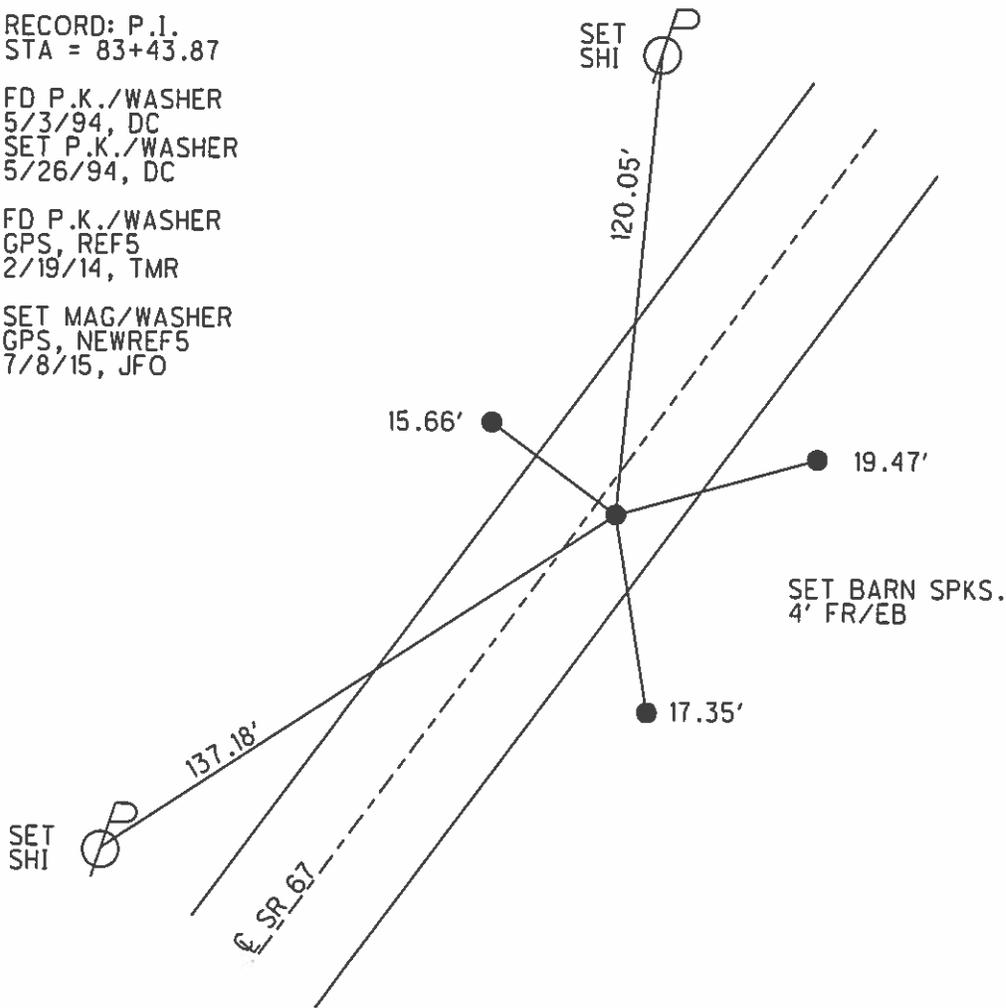

O.D.O.T. DISTRICT 2 SURVEY OFFICE

PERSONNEL _____

REFERENCE NO. 5

SHEET 4 OF 7

NOTES LOHRKE

H.C. RIPPLE

DATE 5-3-94

ROUTE S.R. 67

R.C. BARBOUR

WEATHER _____

COUNTY SENECA

GEYMAN

TEMP. _____

TOWNSHIP Eden

SECTION 27

RESET - 9-26-94

T 1 N R 15 E


TYPE MONUMENT PK. / WASHER

ON SURFACE - ~~BELOW~~ yes


~~LEFT~~ - C PAV'T. - RIGHT 1.5' Rt

0.5 TO Rt EDGE PAVEMENT

S.L.M. 83+39

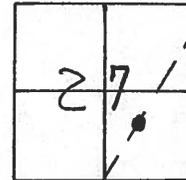

RECORD: P.I. Sta 83+43.87

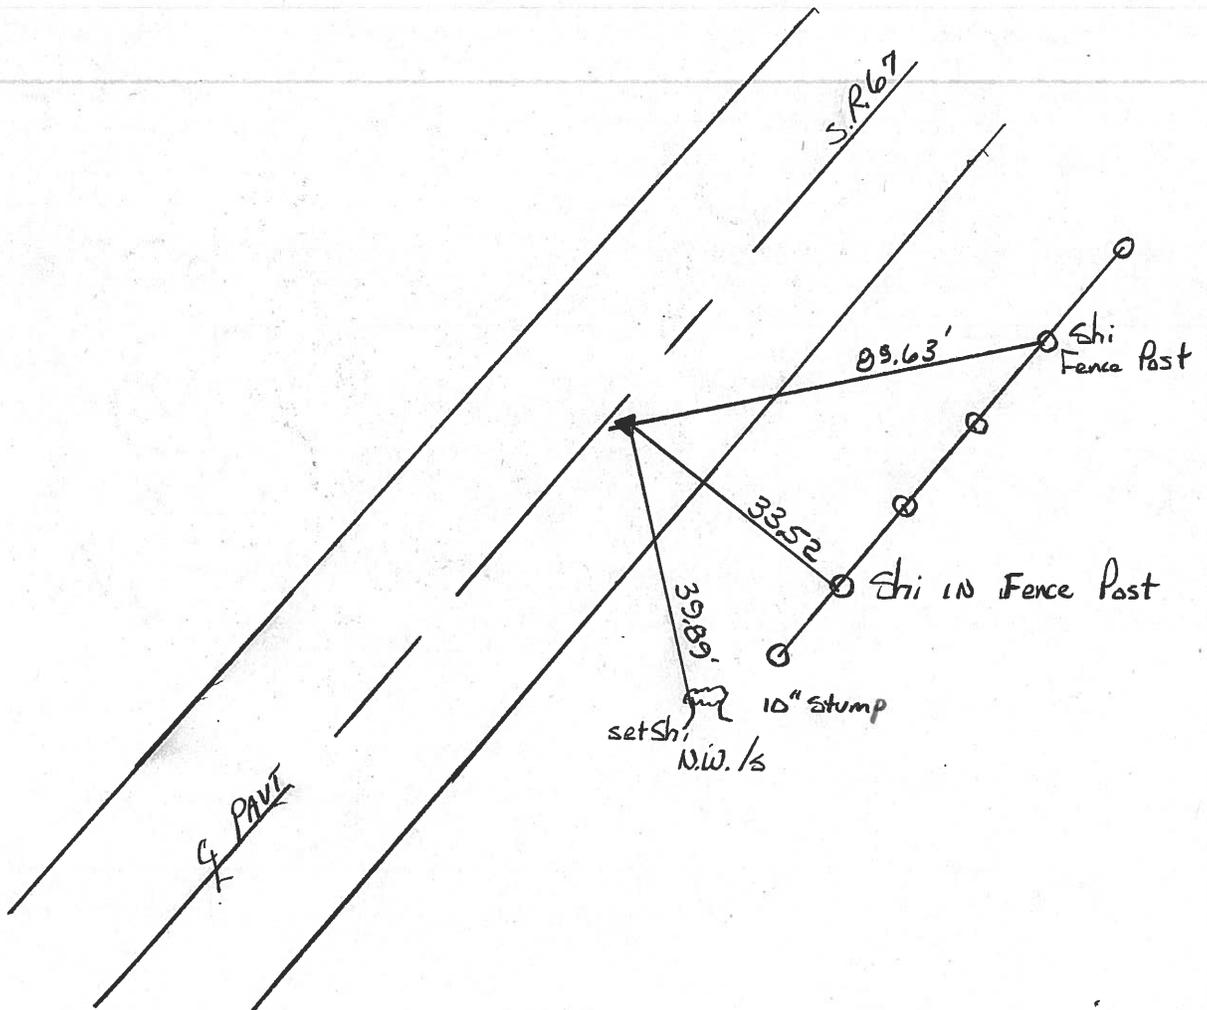

County Seneca S.R. #67

Date 6/08/82

Township Eden

Weather Sunny

Section 27

Temp. 72°

T1N, R15E

Personnel Cronin


Ripple

Geyman

Mosser

Barbour

#5

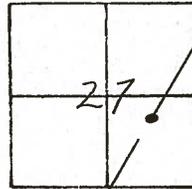


P.I.

83+43.87

Mine spike atop R.L. spike

Reset P.K. & Washer

1' Rt & Pavement

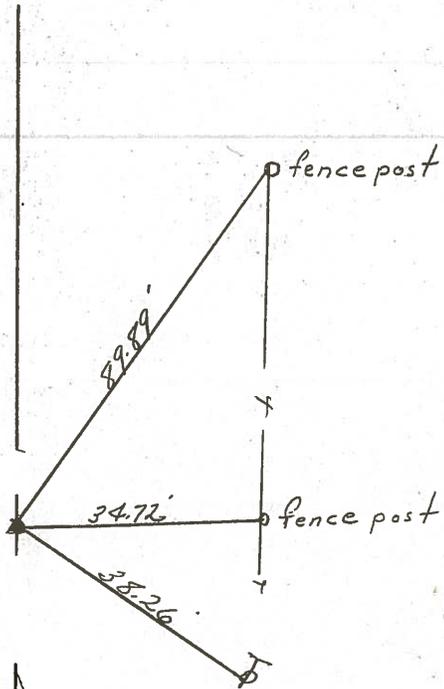

E.R/W S.R. #67

County Seneca S.R. 67

Date 6-13-79

Township Eden

Weather Fair

Section 27


Temp. 72°

T1N, R15E

Personnel Schneider

Masser

Barbour

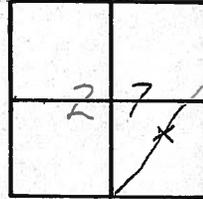

5



⊕ S.R. # 67


P.I.

83 + 43.87

R.R. spk. on E R/W

Small spk. on surface

1' Lt. of ⊕

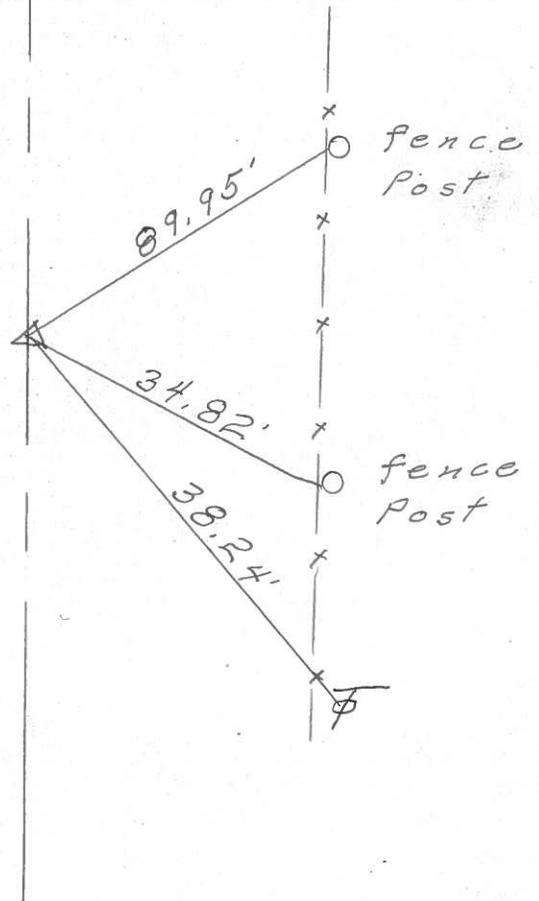


PERSONNEL	TITLE	PERSONNEL	TITLE	COUNTY	DATE
<u>2-H-105</u>	<u>Ash & Cronin</u>			<u>Schenectady</u>	<u>Oct. 28 & 31, '68</u>
	<u>Ripple</u>				<u>Oct. 28, Cloudy & Rain</u>
	<u>Goyman</u>			S. R. <u>#67</u>	WEATHER <u>Oct. 31, Clear & Sun</u>
	<u>Anderson</u>			SEC. <u>W-B-X-P-Z</u>	TEMP. <u>50° - 65°</u>
DESCRIPTION	<u>Check - Control Points + Ties</u>				JOB NO. <u>02994</u>
	LEFT	CENTER LINE	RIGHT		
		<u>S.R. 67</u>			

Note
Nails & Skiner @ All Ties
All Measurements Plumbed
All Points Located & Painted


5

#273
Const. Sur. '64 - Br. Sen. 67-0117
P.I. 93 + 43.87 = 13 + 56.07
Found R.R. Spk. on R/W
1/2" Below Surface
8410

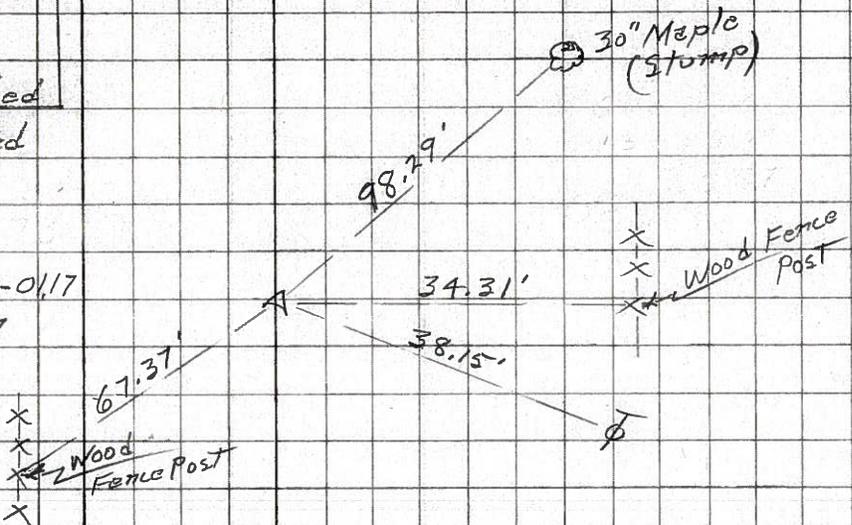


4

Sec. 13 #272
Const. Sur. '64
Br. Sen. 67-0117
P.I. 69 + 87.80 = 0 + 00
Found R.R. Spk. on R/W
1 1/2" Below Surface
A = 0° - 09' Rt. (Const. Sur. Notes)
8409

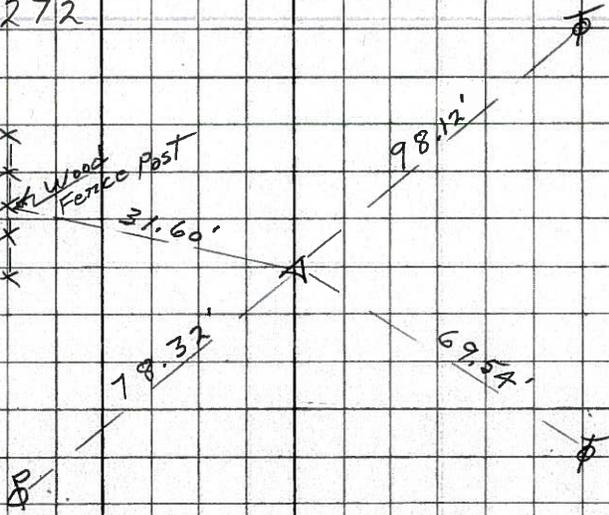

Const. Sur. '64
Br. Sen. 67-0117
P.O.T. 65 + 49.05
Found P.K.
1 1/2" Below Surface
A = 0° 00' (Const. Sur. Notes)
8408
Sec 27
Sec. 34

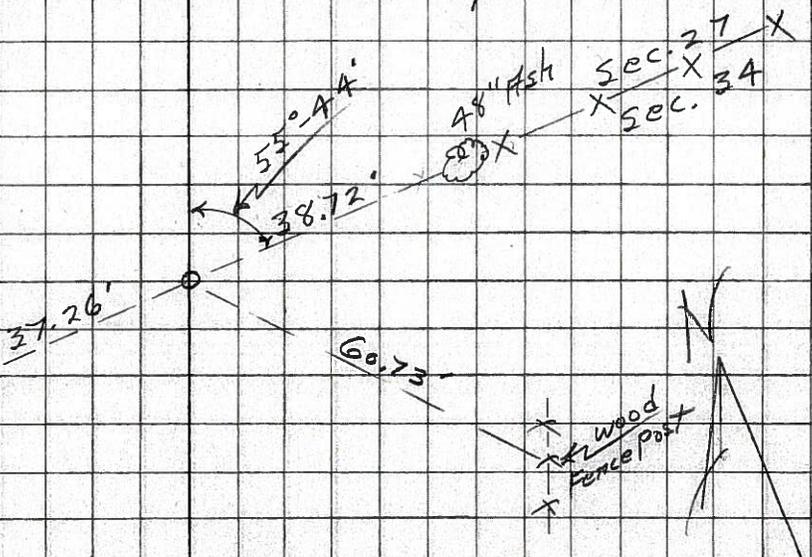

PERSONNEL TITLE PERSONNEL TITLE

COUNTY Seneca DATE 12-21-65

S. R. # 67 WEATHER

SEC W-B-X-P-Z TEMP


DESCRIPTION S.H. 267 starting at Seneca-Wyandot Co Line JOB NO.

LEFT CENTER LINE RIGHT

5

P.I. 83+43.87
Found R.R. spl.
on & R/W
83+43.87 = 13+58.07
Sec B
8410


FOUND 12/13/68
ASH 1/2" BELOW SURFACE
1/2" BELOW SURFACE

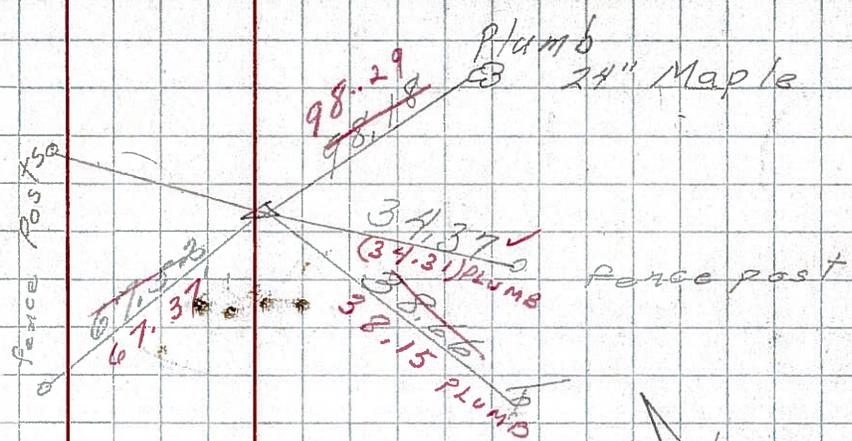

4

P.I. 69+878 = 0+00
Found R.R. spl.
on & R/W
8409


FOUND 12/13/68
ASH 1/2" BELOW SURFACE
1/2" BELOW SURFACE

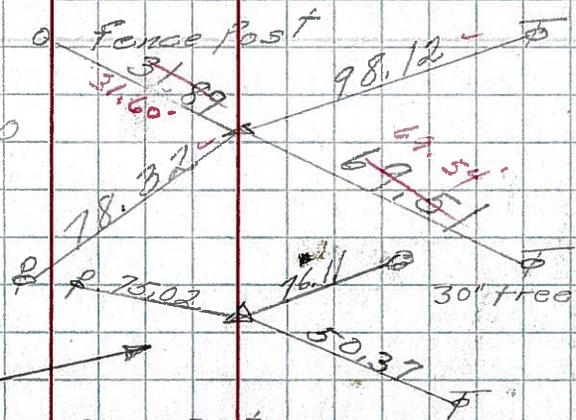

3

23+95.26
Δ = 0° 34' 30" Lt.


Found

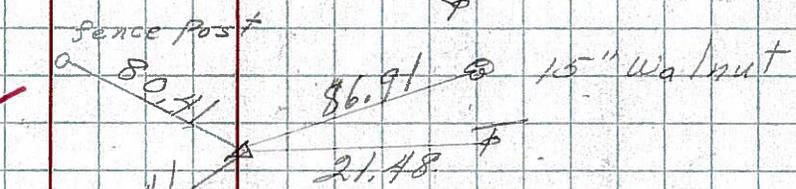

2-A

P.I. 20+14.8
Found R.R. spl.
on & R/W
8401

Found

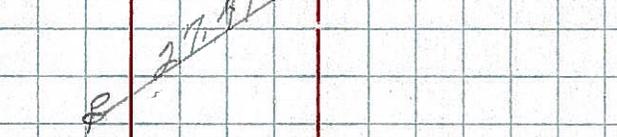

1

P.I. 0+00
Found R.R. spl.
on & R/W
3" Below Perm. T.
8400

Found

