


O.D.O.T. DISTRICT 2 SURVEY OFFICE (USE ONLY)


PERSONNEL \_\_\_\_\_ REFERENCE NO. 8 A SHEET 10 OF 11  
 NOTES RHOADES DATE 4/3/15 ROUTE SR 67  
 H.C. O'DONNELL WEATHER CLOUDY COUNTY SENECA  
 R.C. LEU TEMP. 59° TOWNSHIP EDEN  
 \_\_\_\_\_ SECTION 26  
 \_\_\_\_\_ T 1 N R 15 E

TYPE MONUMENT R.R.SPIKE  
~~ON SURFACE~~ - BELOW 1"  
 LEFT - ☉ PAV'T - RIGHT - \_\_\_\_\_  
8' TO RT EDGE PAVEMENT  
 S.L.M. 122+29.14

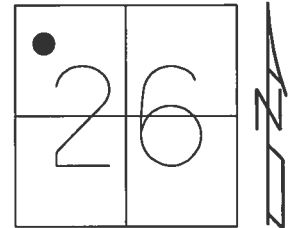

Grid: Northing: 493763.530 Easting: 1800126.305


RECORD: P.I.  
 $\Delta = 23^\circ 32' RT$   
 1951 PLANS, ☉ SURVEY  
 STA: 107+27.41  
 FD R.R.SPIKE  
 5/3/94, CL  
 SET R.R.SPIKE  
 9/26/94, CL  
 FD R.R.SPIKE  
 GPS, REFA8  
 2/19/14, TMR  
 SET MAG/WASHER  
 GPS, NEWREFA8  
 7/13/15, JFO  
 FD MAG/WASHER  
 REFA8  
 2/4/16, JFO

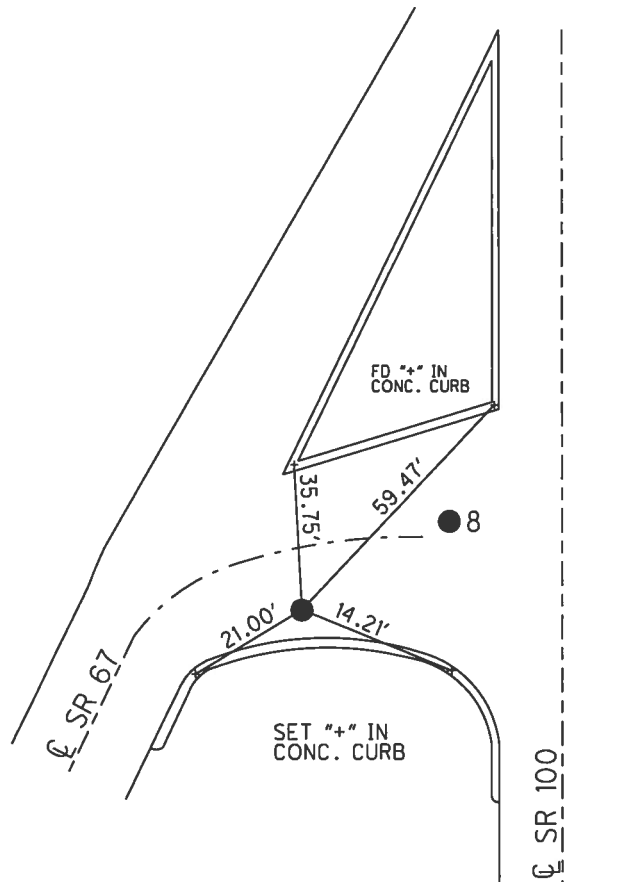

O.D.O.T. DISTRICT 2 SURVEY OFFICE (USE ONLY)

PERSONNEL \_\_\_\_\_ REFERENCE NO. 8 A SHEET 10 OF 11  
 NOTES RHOADES DATE 4/3/15 ROUTE SR 67  
 H.C. O'DONNELL WEATHER CLOUDY COUNTY SENECA  
 R.C. LEU TEMP. 59° TOWNSHIP EDEN  
 \_\_\_\_\_ SECTION 26  
 \_\_\_\_\_ T 1 N R 15 E

TYPE MONUMENT R.R.SPIKE  
~~ON SURFACE~~ - BELOW 1"  
 LEFT - CL PAV'T - RIGHT - \_\_\_\_\_  
8' TO RT EDGE PAVEMENT  
 S.L.M. 121+98.25  
 Grid: Northing: 493763.5604 Easting: 1800126.311

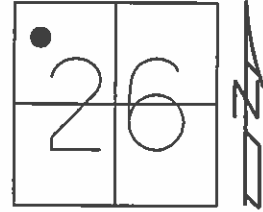


RECORD: P.I.  
 $\Delta = 23^\circ 32' RT$   
 1951 PLANS, CL SURVEY  
 STA: 107+27.41

FD R.R.SPIKE  
 5/3/94, CL  
 SET R.R.SPIKE  
 9/26/94, CL

FD R.R.SPIKE  
 GPS, REFA8  
 2/19/14, TMR

SET MAG/WASHER  
 GPS, NEWREFA8  
 7/13/15, JFO

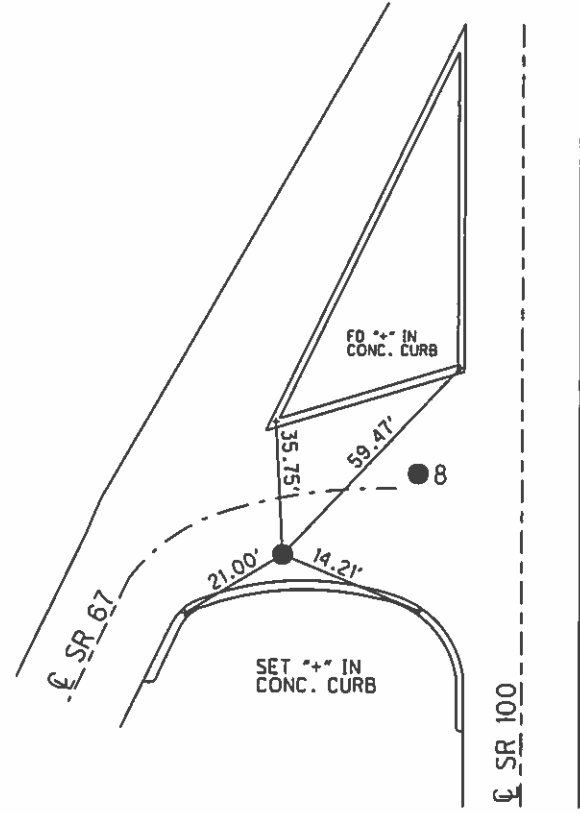

# O.D.O.T. DISTRICT 2 SURVEY OFFICE

PERSONNEL \_\_\_\_\_

REFERENCE NO. 8

SHEET 7 OF 7

NOTES LOENRKE

H.C. RIPPLE

R.C. BARBOUR

GEYMAN

DATE 5-3-94

WEATHER \_\_\_\_\_

TEMP. \_\_\_\_\_

ROUTE S.R. 67

COUNTY Seneca

TOWNSHIP EDEN

SECTION 26

T L N R 15 E


TYPE MONUMENT A = P.K/WASHER @ Surface  
B = P.R. SPIKE 1" DOWN

ON SURFACE - BELOW \_\_\_\_\_

LEFT - & PAV'T. - RIGHT \_\_\_\_\_

8' TO RT EDGE PAVEMENT

S.L.M. \_\_\_\_\_

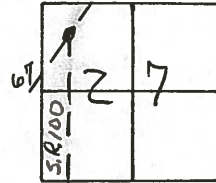

A = 23' R/E/P SLM 122+47  
 B = 8' R/E/P

Reset


A → P.K/WASHER  
 B → Sm. P.R. SPIKE  
 9-26-94

16.00 BETWEEN

RECORD "A" Δ = 26°-10' Lt  
 P.I Sta 107+43.41, & Survey

RECORD "B" P.I Sta 107+27.41  
 Δ = 23°-32' Rt  
 1951 Plans, & Survey

**8-A**

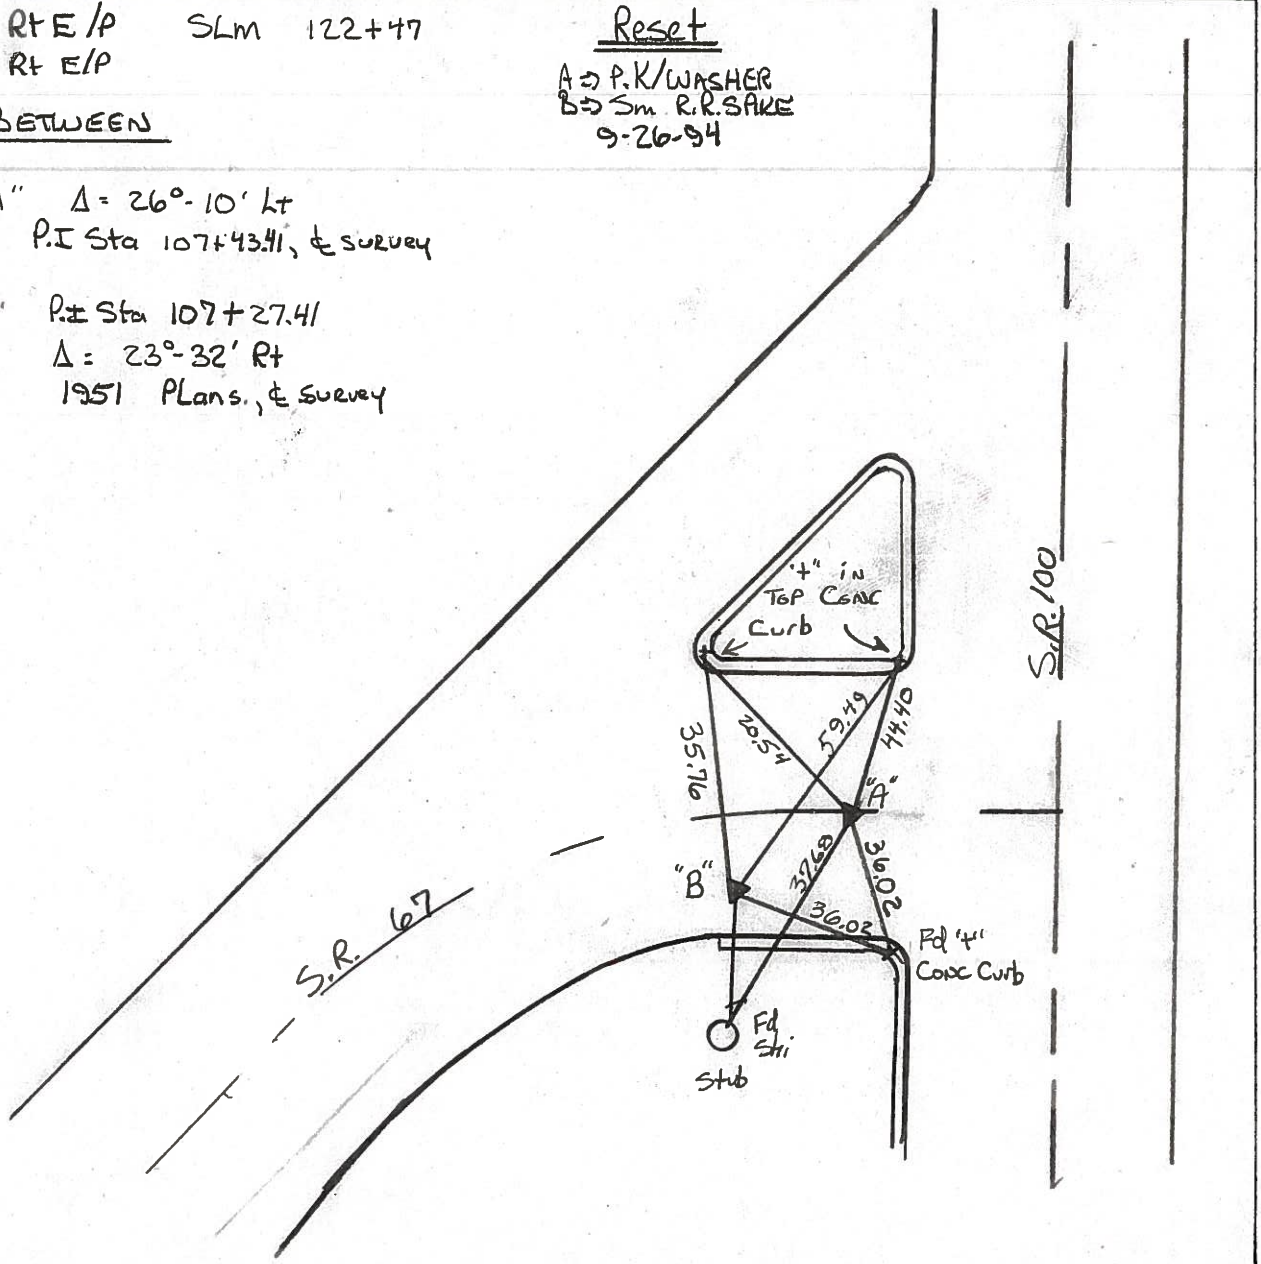



County Seneca S.R. # 67 & 100

Date 8-3-77

Township Eden

Weather Sunny

Section 26



Temp. 75°

T1N, R15E

Personnel copy, sheet #4

S.R. # 100

8-3-77

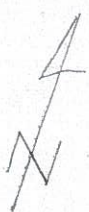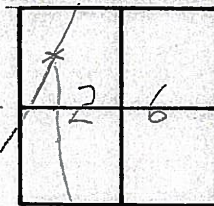

8-A

Note: Both points are in the approach of S.R. # 67 to S.R. # 100

$\Delta = 23^{\circ} 32' \text{ Rt.}$  Meas. & Rec.

P. I. survey

107+27.41 meas.-

set R. R. spk. (Punched)

1951 Plans

N&S top 3rd G.R.

Post S., West side S.R. # 67

$\Delta = 26^{\circ} 10' \text{ Lt.}$   
Meas. & Rec.  
P. I. survey  
107+43.41  
set R.R. spk. (Punched)

