


O.D.O.T. DISTRICT 2 SURVEY OFFICE (USE ONLY)

PERSONNEL _____ REFERENCE NO. 12 A SHEET 6 OF 25


NOTES RHOADES DATE 7/12/17 ROUTE SR 67
 H.C. O'DONNELL WEATHER CLOUDU COUNTY SENECA
 R.C. RHOADES TEMP. 83° TOWNSHIP EDEN
 _____ SECTION 13
 _____ T 1 N R 15 E

TYPE MONUMENT MAG NAIL SHANK
 ON SURFACE - ~~BELOW~~ ON _____
~~LEFT~~ - CL PAV'T - RIGHT 6'
 _____ TO _____ EDGE PAVEMENT
 S.L.M. 205+32.16

Grid: Northing: 500370.253 Easting: 1804728.160

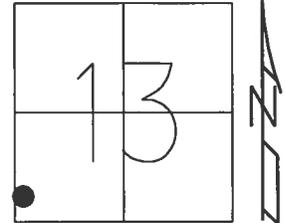

RECORD: P.I.
 STA. 205+85
 FD P.K./WASHER ATOP
 BOAT SPIKE ATOP
 R.R.SPIKE
 FD P.K./WASHER
 5/30/02, DCH
 SET MAG/WASHER
 9/14/02, DCH
 FD MAG/WASHER
 REFA12
 2/4/16, JFO
 FD MAG NAIL SHANK
 7/12/17, JFO
 SET MAG/WASHER
 11/9/17, JFO

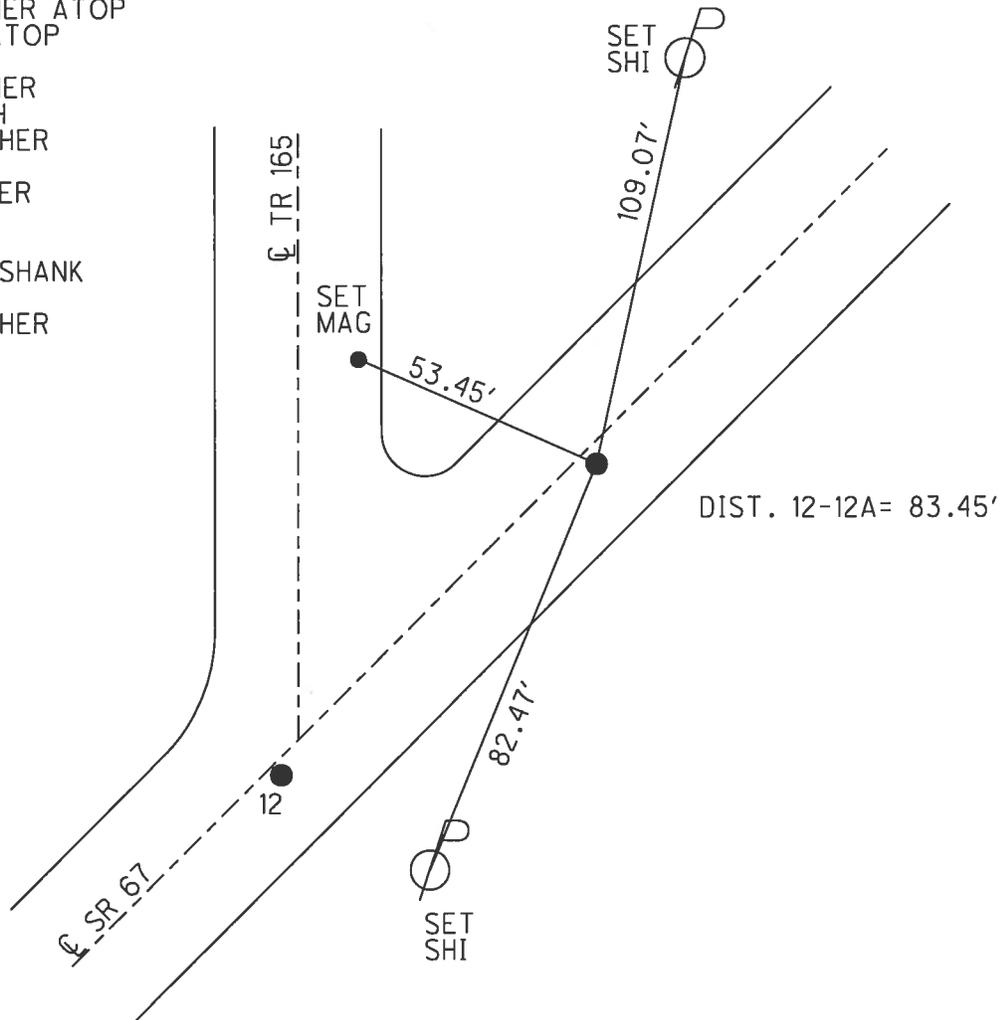

O.D.O.T. DISTRICT 2 SURVEY OFFICE

PERSONNEL

REFERENCE NO. 12

SHEET 3 OF 18

NOTES ROUSOS

H.C. HOMAN

R.C. MICHALAK

DATE 5/30/02

WEATHER WINDY

TEMP. 65°

ROUTE 67


COUNTY SENECA

TOWNSHIP EDEN

SECTION 13

T. 1 N. R 15 E

TYPE MONUMENT PK & WASHER "A"; MAG NAIL "B"
 ON SURFACE - BELOW ON SURFACE
 LEFT - 6' RT & PAVT "A" RIGHT 1' RT & PAVT "B"
 TO EDGE PAVEMENT
 S.L.M. STA 205+85 "A" STA 205+02 "B"

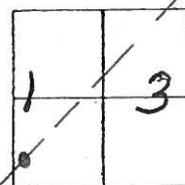


PI Record:
 205+34.15
 PK & WASHER ATOP
 BOAT SPIKE ATOP R.R.
 SPIKE

12-A

DIST BETWEEN
 A+B 83.43'

Left Pavt

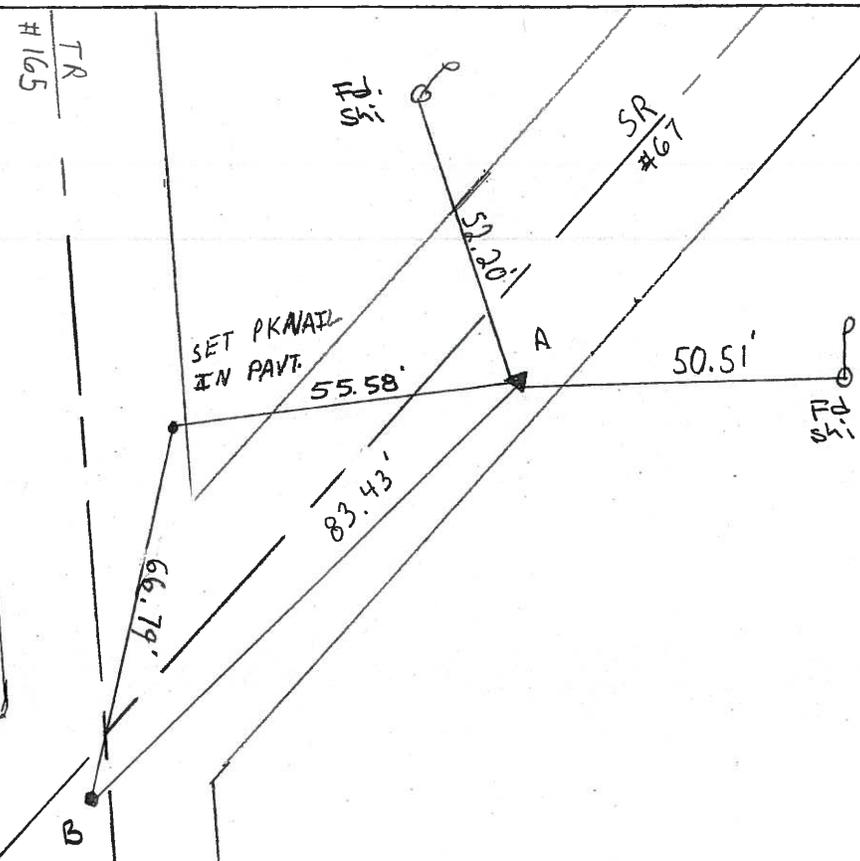

SET MAG NAIL
 & WASHER
 7-14-02 D.C.H.

O.D.O.T. DISTRICT 2 SURVEY OFFICE

PERSONNEL

NOTES Cronin
 H.C. Ripple
 R.C. Geyman
Barbour



REFERENCE NO. 12
 DRAWN 11/12/86
 DATE 11/10/86
 WEATHER sunny
 TEMP. 46°

SHEET 13 OF _____

ROUTE #67
 COUNTY Seneca
 TOWNSHIP Eden
 SECTION 13
T 1 N R 15 E

TYPE MONUMENT P.K. & washer
 ON SURFACE - BELOW on surface
 LEFT- & PAV'T. - RIGHT 6.0' Rt. & Pav't.
 TO _____ EDGE PAVEMENT
 S.L.M. _____

12-A

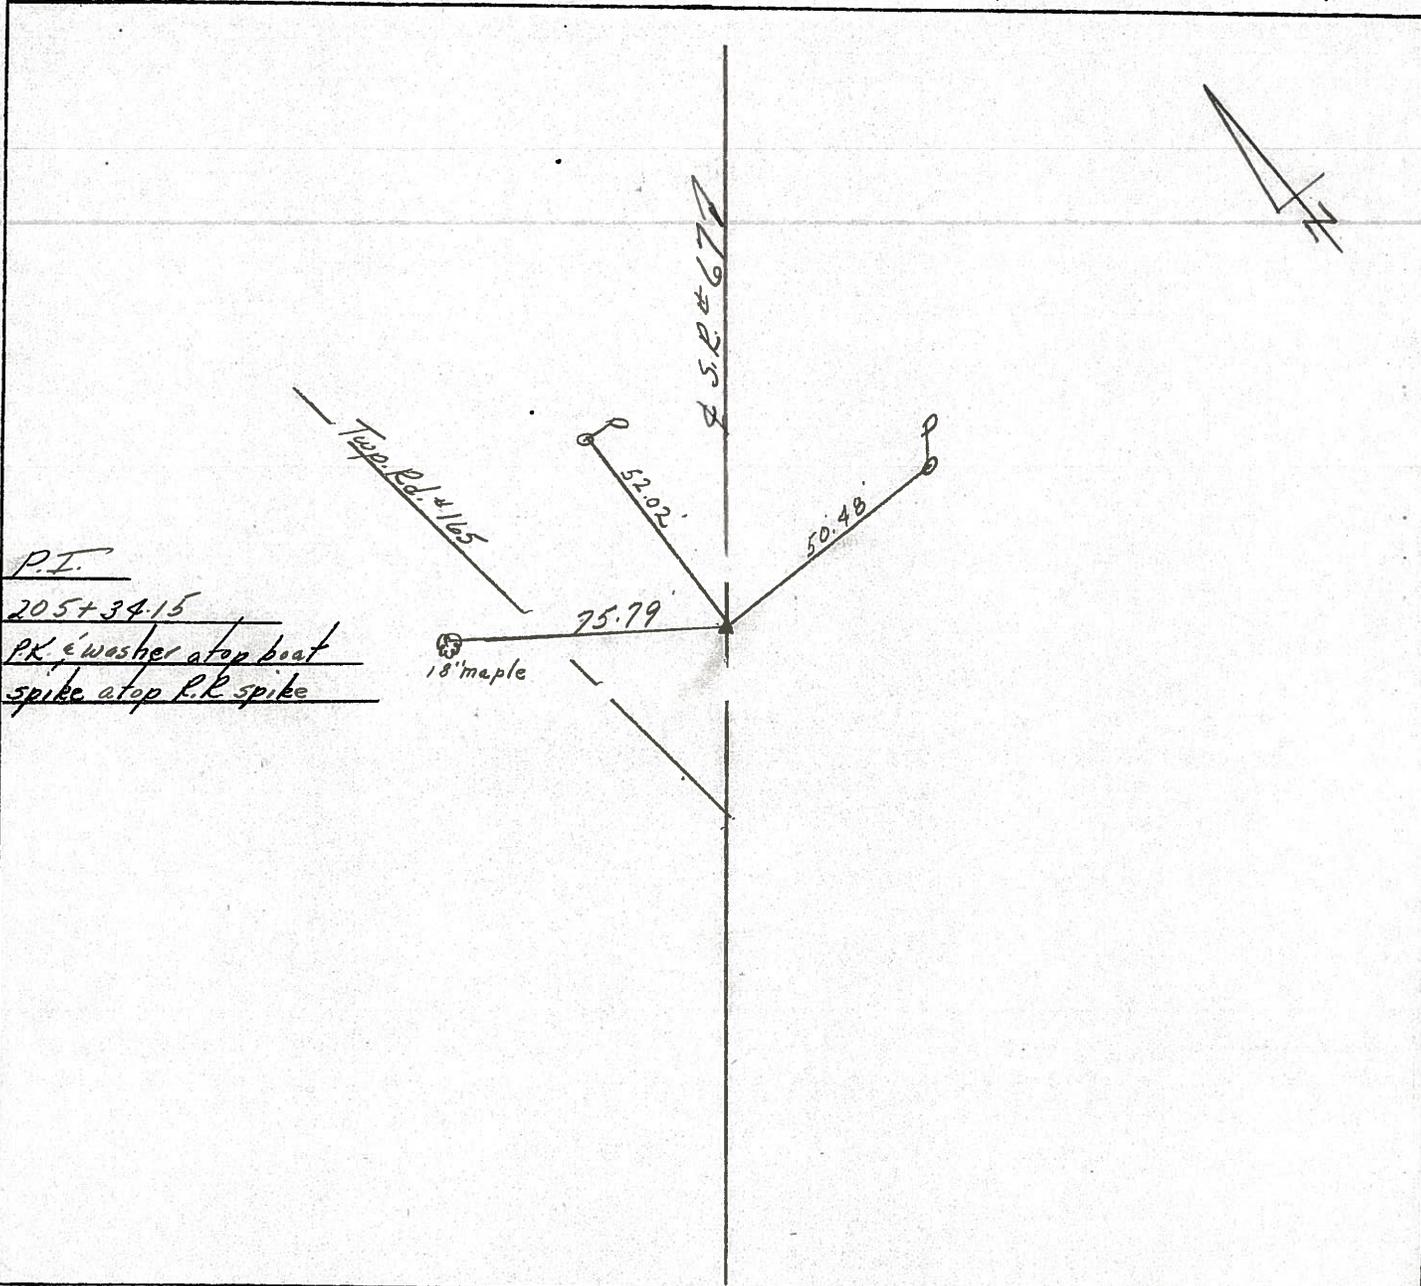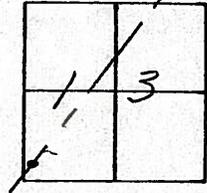

County SENECA S.R. 67

Date 8/10/81

Township EDEN

Weather SUNNY

Section 13

Temp. 72°

T/LN, R/E


Personnel CRONIN

RIPPLE


GEYMAN

MOSSER

BARBOUR

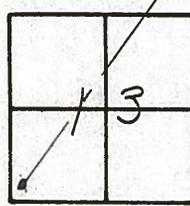

#12-A

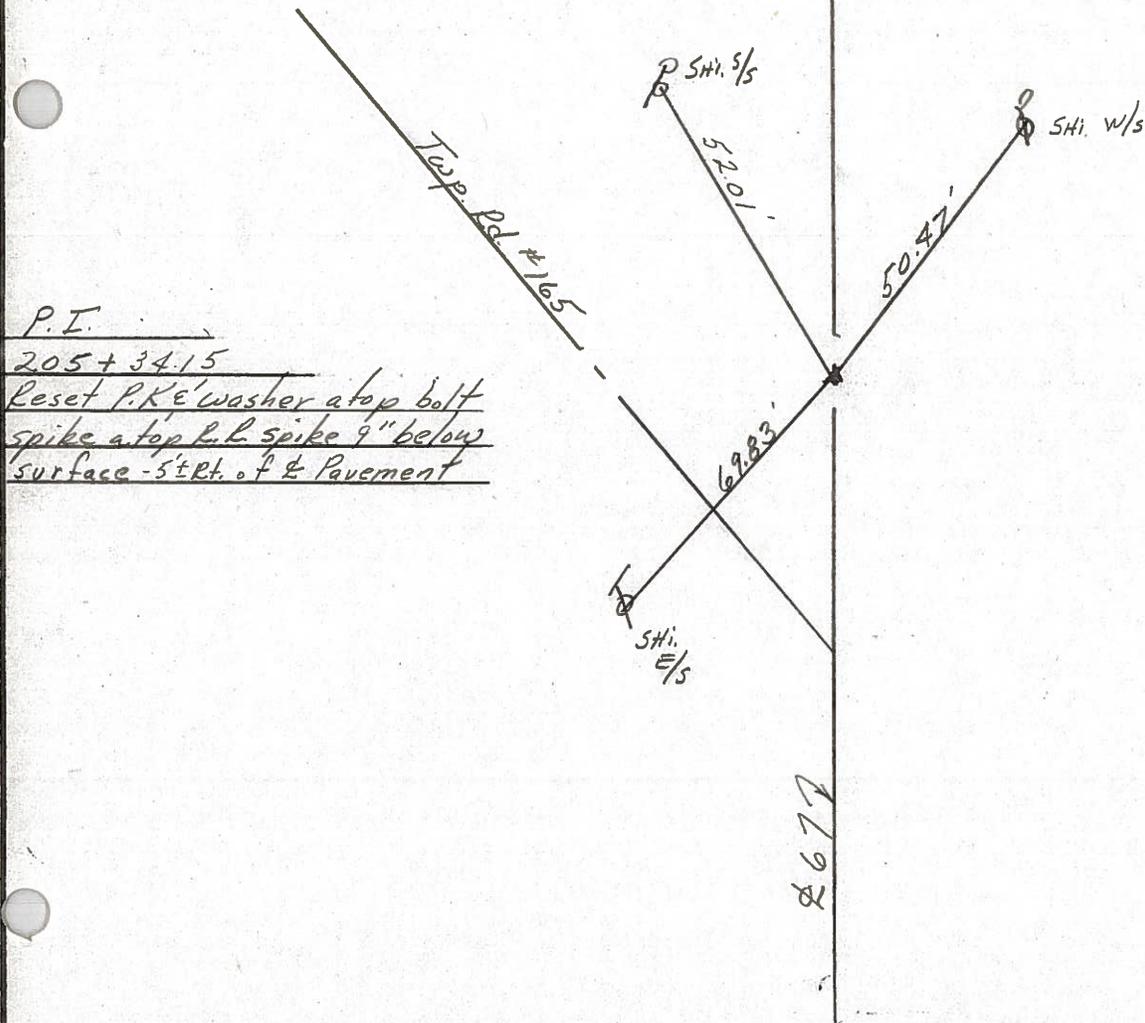

P.I.
 205+34.15
 Reset P.K.E. washer atop bolt
 spike atop L.L. spike 9" below
 surface - 5' RT. of Pavement

County Seneca S.R. 67

Township Eden

Section 23

T/LN, R/E

Personnel HOFFMAN


HOUSEHOLDER

Barbour


Date 6-16-81

Weather FAIR

Temp. 85

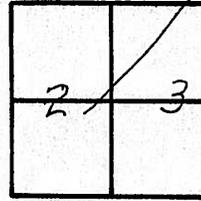

12-A

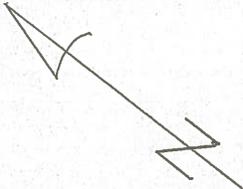

§ S.R. #67

SHI. S/S



52.03
52.87

50.49'

SHI. W/S



Twp. Rd. #165

69.90'

SHI. E/S



100.±

P. I.

205 + 34.15

R.R. spk. on § R/W

7" down

~~set~~ Mine spk. on surface

FD. BOLT

23.7 S. OF. SEN 67 #4 MILE MARK

3.8 TO E.E.P.

County Seneca S.R. 67

Township Eden

Section 23

TLN, R15E

Personnel Schneider H.



Messer H.

Barbour

Date 6-25-79 6-16-81

Weather Fair ✓

Temp. 65 + 85

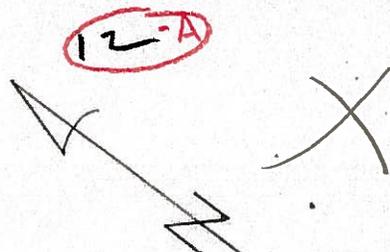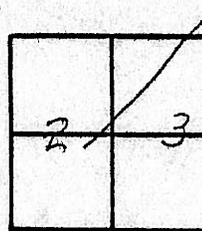

± S.R. #67

shi s/s

52.03
52.01'

50.49'
shi w/s

Twp Rd #165
69.90'

shi E/S

7.80 ±

P.I.

205 + 34.15

R.R. spk. on E R/W

7" down

Fd. set ~~mine~~ Bolt spk. on surface

23.7 S. of sen 67 #4 milemarker

3.8' to E.C.P.

± 205 + 28 PROJECT STA.

PERSONNEL TITLE PERSONNEL TITLE

COUNTY Seneca DATE 12-21-65

S. R. # 67 WEATHER

SEC. TEMP.


DESCRIPTION LEFT CENTER LINE RIGHT JOB NO.

(15)

FOUND 2/10/69

263 + 17.05
small R.R. spk.
on & R/W
1/3" below surface

~~287~~ 8418

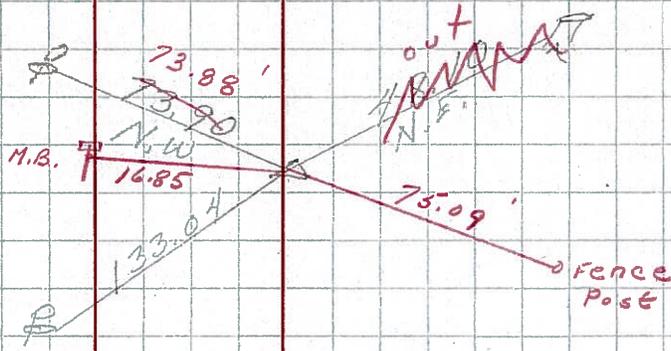


(12-A)

FOUND 2/10/69
6" below surface

P.I. 205 + 34.15
R.R. spk. on &
R/W


~~280~~ 8417

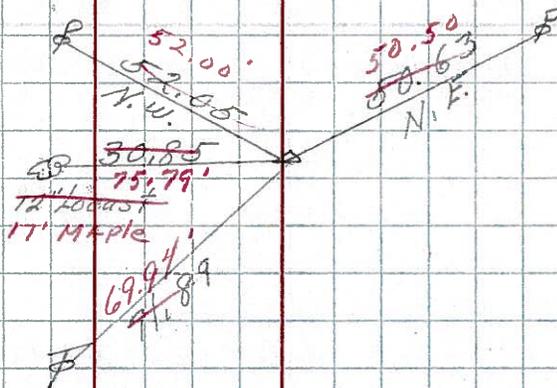

FOUND 12/13/68
15" & CRW

P.I. 758 + 37.7
R.R. spk. on & of R/W
1/2" below surface

~~277~~ 8416

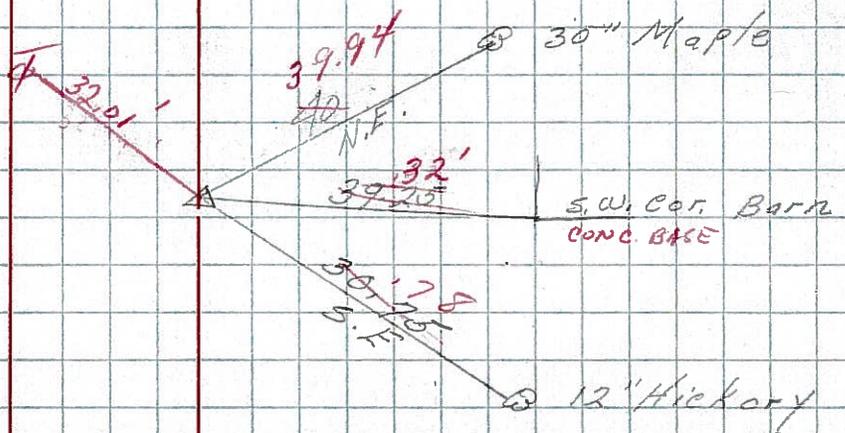

(11)

P.I. 143 + 41.2
Sec. X (start)
did not find

~~278~~ 8415

PERSONNEL TITLE PERSONNEL TITLE

COUNTY Seneca

DATE

S. R. 67

WEATHER

SEC.

TEMP.

DESCRIPTION

LEFT

CENTER LINE

RIGHT

JOB NO.

Sta. 145+41.2

P.I. Not set

278

Sec. X Starts

Sta. 158+37.7

R.R. Spike on of RLW

279

PK Nail

39.25'

Barn

S.W. Cor

OK

3-28-60

30" Maple

30.75'

12" Hickory

(11)

(12-A)

Sta. 205+34.15

R.R. Spike on of RLW

280

30.85'

12" Locust

50.63'

NE

PK Nail

OK

3-28-60

22" Locust
shrub

71.89'

(15)

Sta. 263+17.05

R.R. Spike on of RLW

281

73.9'

48.10'

NE

set RR SPIKE

80.55'

S.E.

OK

3-28-60

15" walnut

22" Cherry