


O.D.O.T. DISTRICT 2 SURVEY OFFICE (USE ONLY)


PERSONNEL _____ REFERENCE NO. 17 B SHEET 11 OF 25
 NOTES ROUSOS DATE 5/30/02 ROUTE SR 67
 H.C. HOMAN WEATHER CLOUDY COUNTY SENECA
 R.C. MICHALAK TEMP. 68° TOWNSHIP BLOOM
 _____ SECTION 6
 _____ T 1 N R 16 E

TYPE MONUMENT MONBOX W/ 1" IPIN
 ON SURFACE - ~~BELOW~~ ON
 LEFT - ℄ PAV'T - RIGHT ON
- TO - EDGE PAVEMENT
 S.L.M. 375+93.54

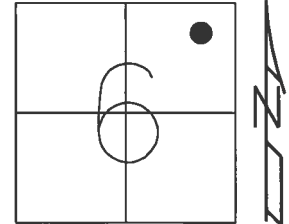

Grid: Northing: 514414.654 Easting: 1814415.470

RECORD:
 STA. 376+72
 FD MONBOX
 W/ 1" IPIN
 5/30/02, DCH
 FD MONBOX
 W/ 1" IPIN
 REFB17
 2/5/16, JFO

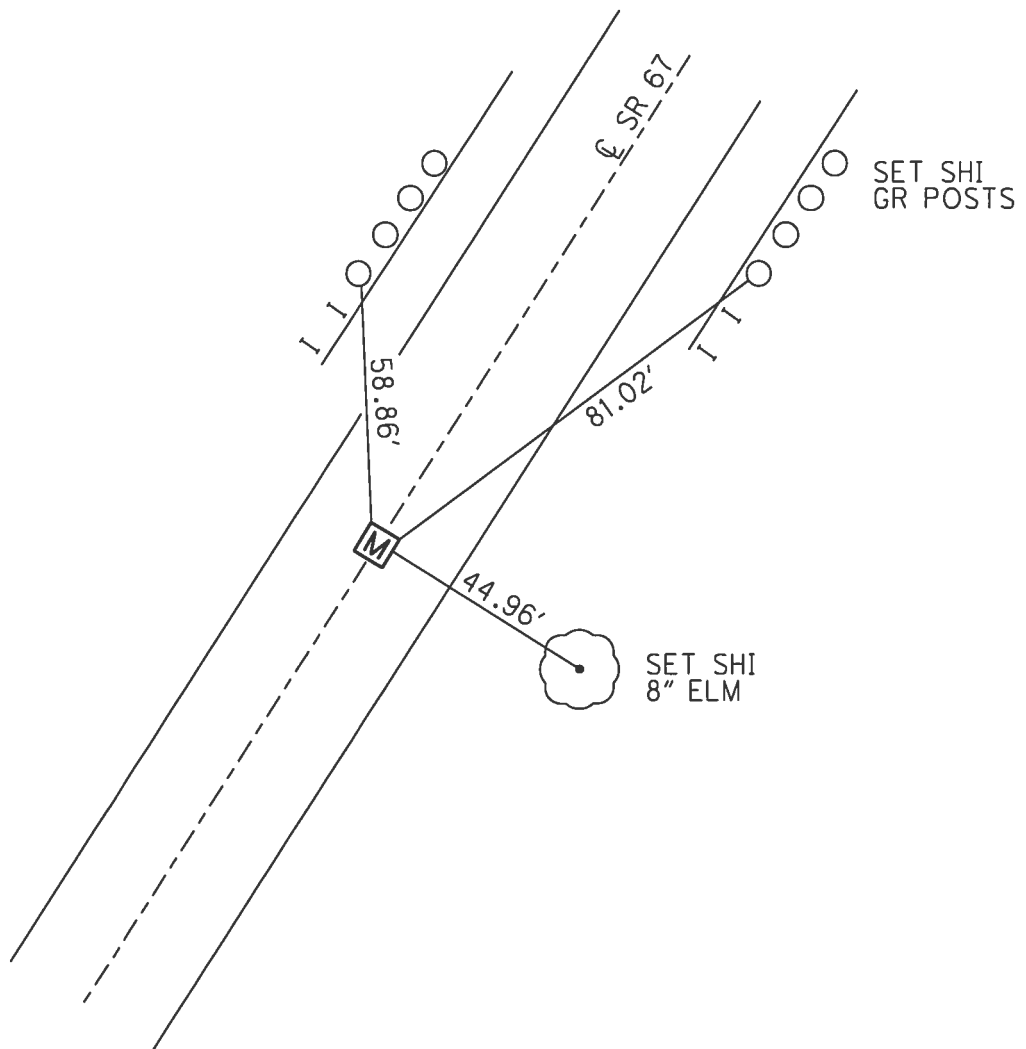

O.D.O.T. DISTRICT 2 SURVEY OFFICE

PERSONNEL _____

REFERENCE NO. _____

SHEET 7 OF 10

NOTES ROUSOS

H.C. HOMAN

R.C. MICHALAK

DATE 5/30/02

WEATHER CLOUDY

TEMP. 68°

ROUTE 67

COUNTY SENECA

TOWNSHIP _____

SECTION _____

T _____ R _____

TYPE MONUMENT MON. BOX


ON SURFACE - ~~BELOW~~ _____

~~LEFT - & PAV'T. - RIGHT~~ _____

TO EDGE PAVEMENT

S.L.M. STA 376+72

17-B

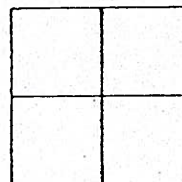

MEASURED TO
CENTER OF BOX.

