


O.D.O.T. DISTRICT 2 SURVEY OFFICE (USE ONLY)

PERSONNEL _____ REFERENCE NO. 20 B SHEET 16 OF 25


NOTES RHOADES DATE 7/13/17 ROUTE SR 67
 H.C. O'DONNELL WEATHER CLOUDY COUNTY SENECA
 R.C. RHOADES TEMP. 79° TOWNSHIP SCIPIO
 _____ SECTION 32
 _____ T 2 N R 16 E

TYPE MONUMENT MAG/WASHER
 ON SURFACE - ~~BELOW~~ ON
 LEFT - ☉ PAV'T - RIGHT ON
9.2' TO RT EDGE PAVEMENT
 S.L.M. 410+48.98

Grid: Northing: 517266.330 Easting: 1816366.845

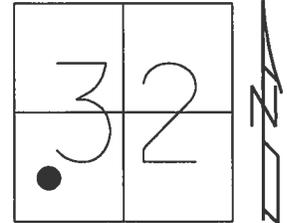

RECORD:
 P.K./WASHER ATOP
 R.R.SPIKE ATOP
 1" IPIN
 STA. 410+54.70
 FD P.K./WASHER
 6/1/02, DCH
 SET MAG/WASHER
 9/14/02, DCH
 FD MAG/WASHER
 REFB20
 2/5/16, JFO
 SET MAG/WASHER
 11/14/17, JFO

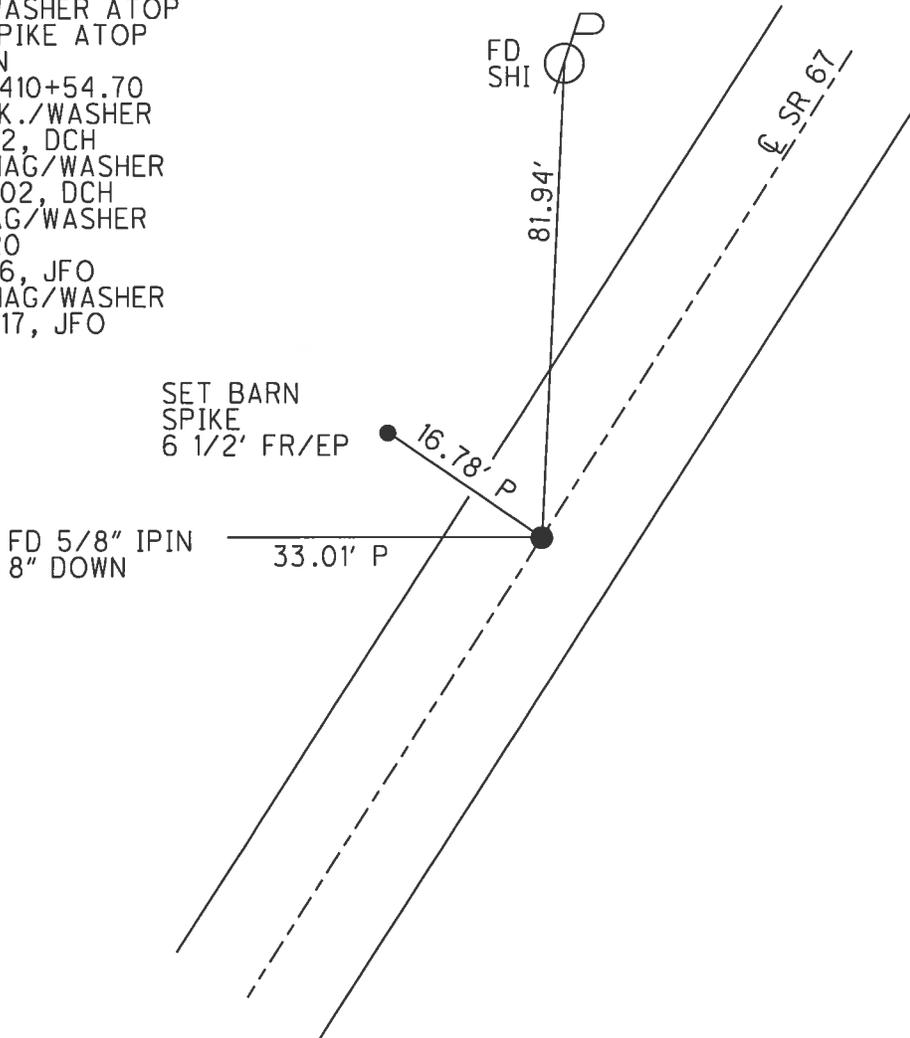

O.D.O.T. DISTRICT 2 SURVEY OFFICE

PERSONNEL

REFERENCE NO. 20B

SHEET 12 OF 18

NOTES HOMAN

H.C. MOSSER

R.C. BARNHISEL

ROUSOS

CANTERBURY

DATE 6/1/02

WEATHER SUNNY

TEMP. 75°

ROUTE 67

COUNTY SENECA

TOWNSHIP SCRIPTO

SECTION 32

T 2 N R 15 E


TYPE MONUMENT PK+WASHER

ON SURFACE - ~~BELOW~~


~~LEFT~~ - ~~PAV'T.~~ - ~~RIGHT~~ ON

9.2' TO RT. EDGE PAVEMENT

S.L.M. 411+17

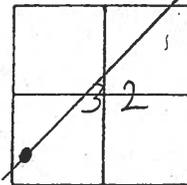

Record: 410+54.70
PK+WASHER ATOP R.R. SPIKE
ATOP 1" x 30" IRON ROD

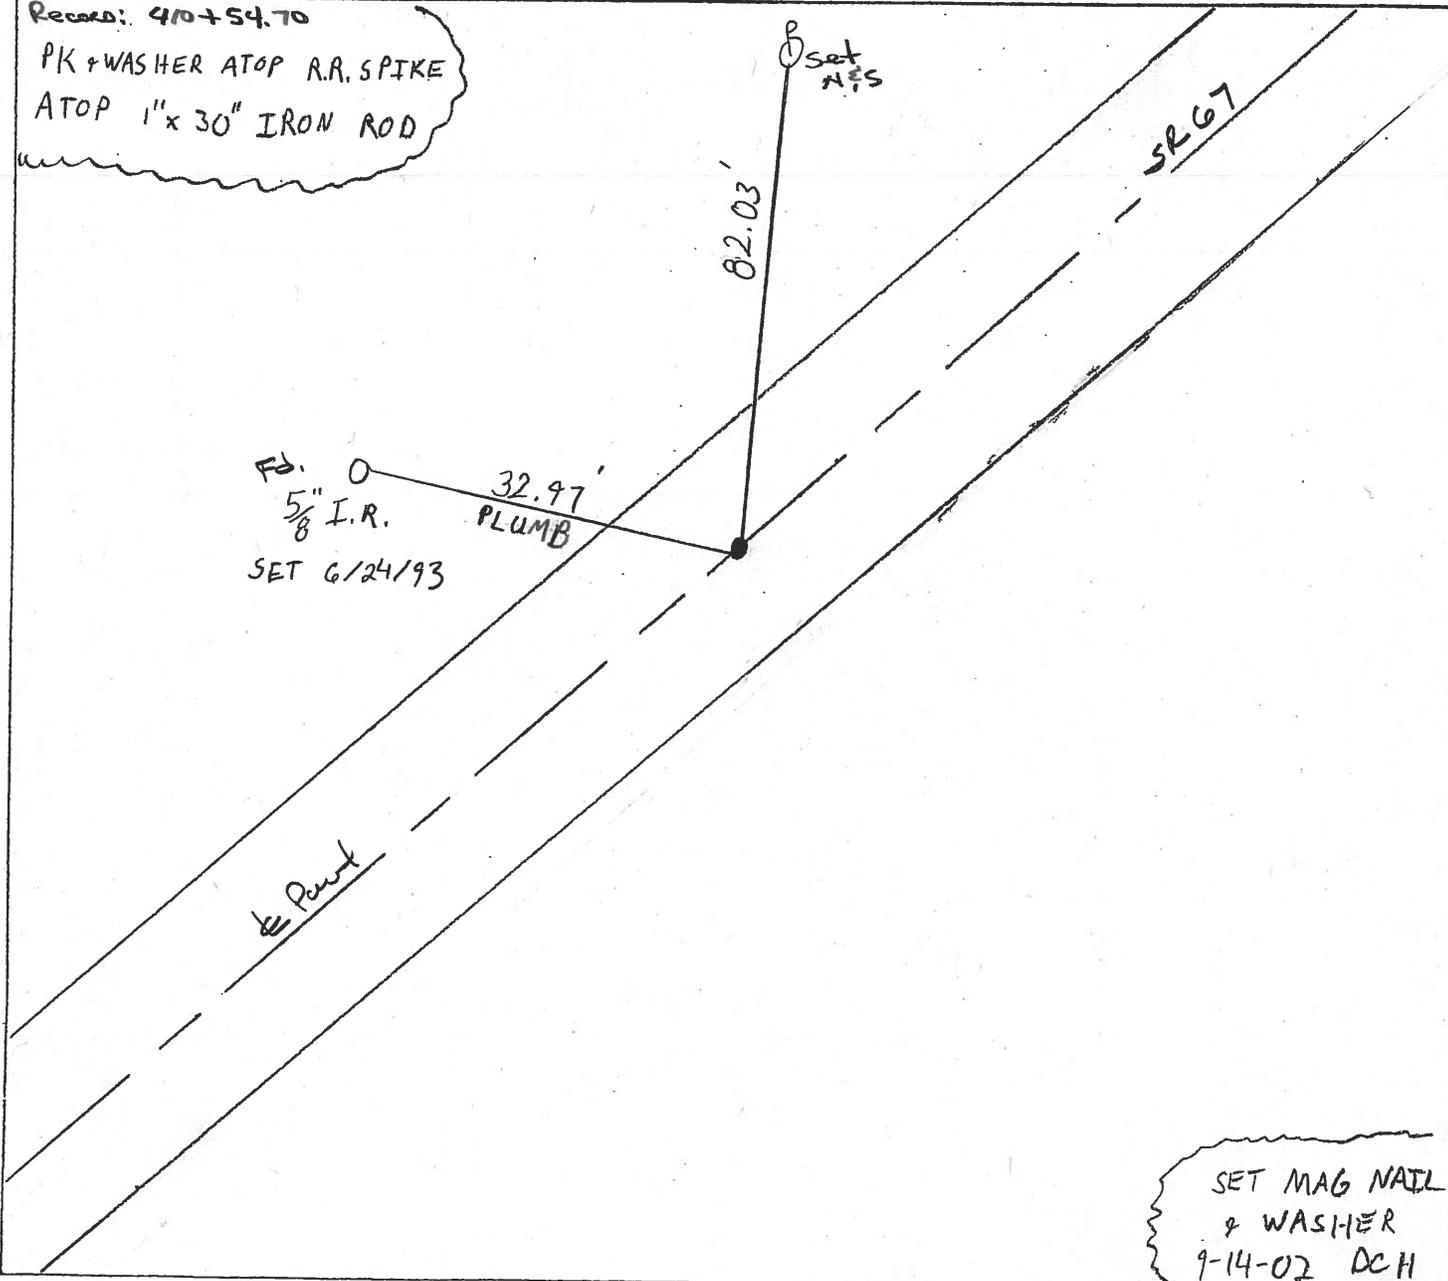

SET MAG NAIL
& WASHER
9-14-02 DCH

O.D.O.T. DISTRICT 2 SURVEY OFFICE

PERSONNEL

REFERENCE NO. 20B

SHEET 2 OF 9

NOTES CHENEY

H.C. _____

DATE 12-10-1971

ROUTE 67

R.C. _____

WEATHER CLOUDY

COUNTY SENECA

TEMP. 35°

TOWNSHIP SCIPPO

SECTION 32

T 2 N R 15 E


TYPE MONUMENT SET PK/WASHER

ON SURFACE - BELOW

~~LEFT~~ - & PAV'T. - ~~RIGHT~~

9.5' TO RT. EDGE PAVEMENT

S.L.M. _____

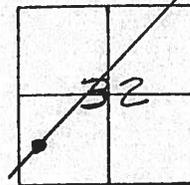

RECORD STA. 410+54.70

PREVIOUS MONUMENTS:

PK/WASHER

R.R. SPK.

1" x 30" IRON ROD

Set $\frac{5}{8}$ " I.R.

6/24/93

Plumb
32.97'


67.30'

67

S.P.

Plumb
35.90'

Set $\frac{5}{8}$ " I.R.
6/24/93

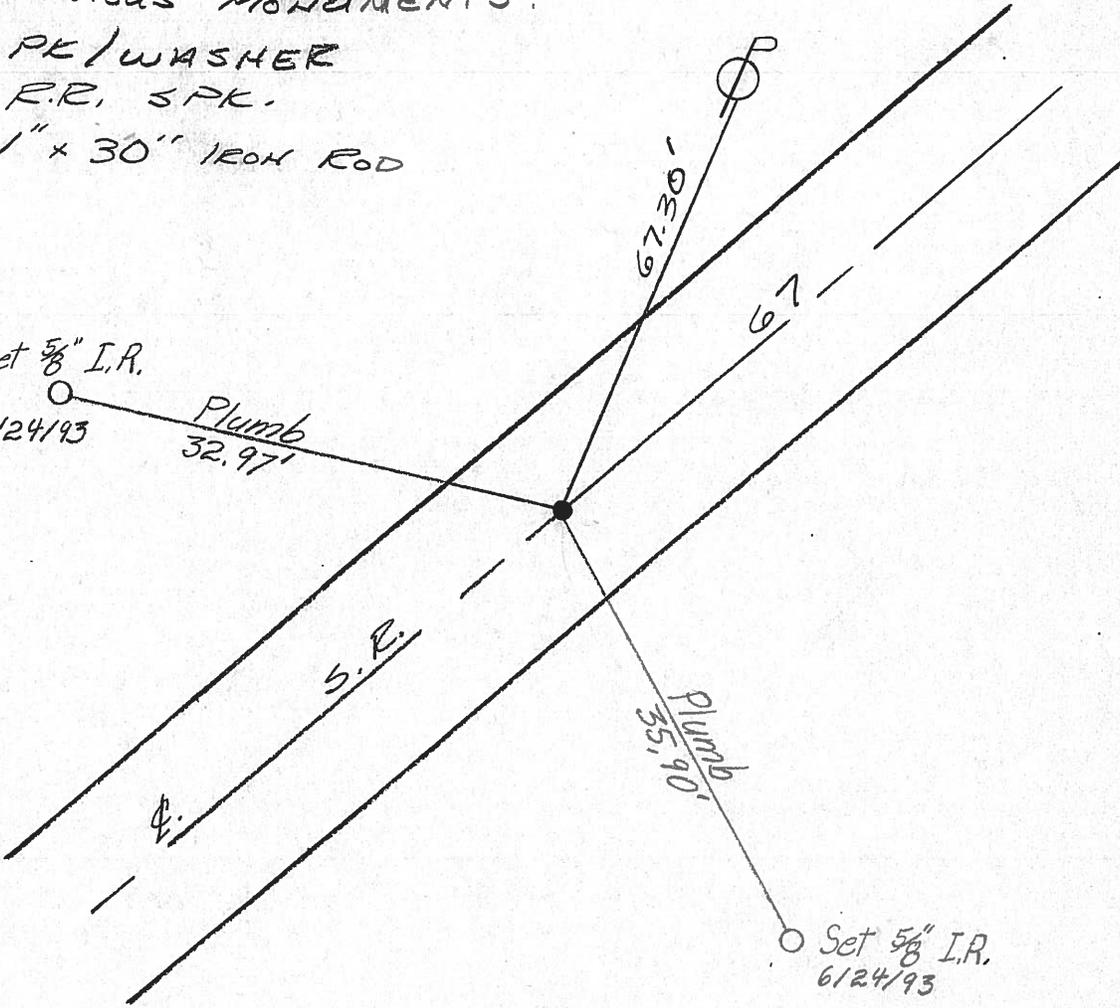

County Seneca S.R. #67

Date 6/08/82

Township Scipio

Weather Sunny

Section #32

Temp. 80°

T2N, R15E

Personnel Cronin


Ripple

Geyman

Mosser

Barbour

20-B

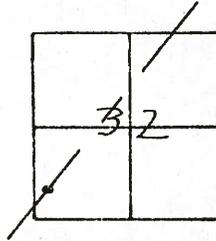

SET PK WASH 12-10-91

9.5' RT E/D
ON E

elt
B-NC
B-EL
G

5/21/91
TEMP. 80°




110 + 54.70

R spike atop a 1"x30" I. Pin
set P.K. e Washer

DO NOT

E R/W S.R. #67

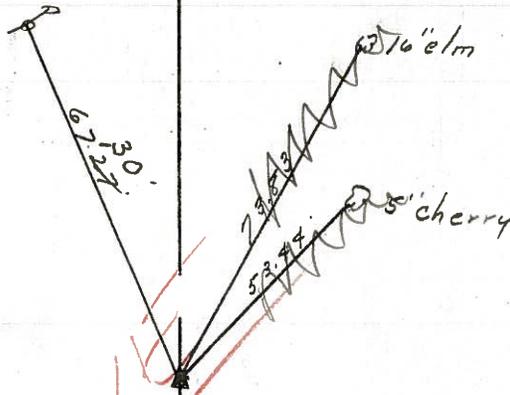

O.D.O.T. DISTRICT 2 SURVEY OFFICE

PERSONNEL

REFERENCE NO. 20-A

SHEET _____ OF _____

NOTES LOEHRKE

H.C. BARNHISEL

R.C. SOCKMAN

DATE 10-26-87

WEATHER CLEAR

TEMP. +45

ROUTE SR 67

COUNTY SENECA

TOWNSHIP Scipio

SECTION 32

T 2 N R 15 E

TYPE MONUMENT PK & WASHER



ON SURFACE - BELOW

~~LEFT - C~~ PAV'T. - RIGHT

10.2 TO Rt EDGE PAVEMENT

S.L.M. 410+54.7 (REC)

20-B

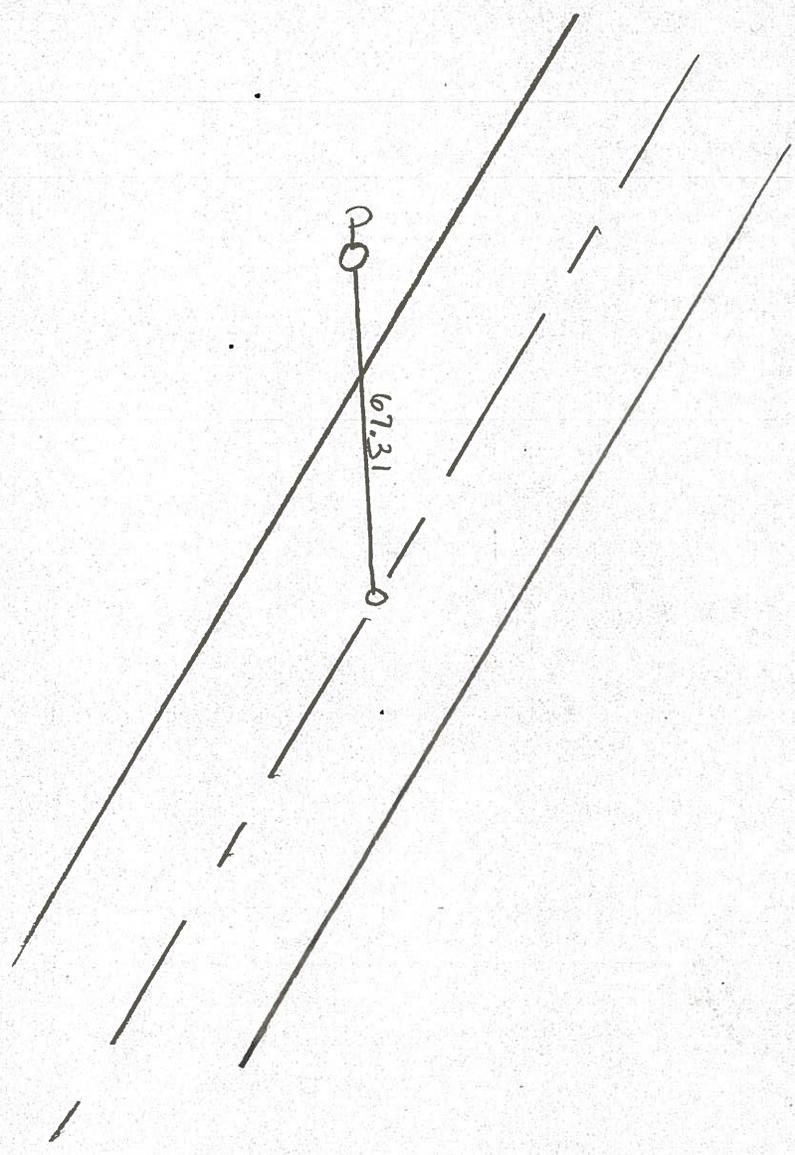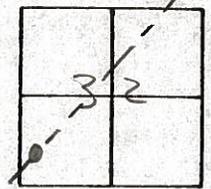

County Seneca S.R. #67

Date 6/08/82

Township Scipio

Weather Sunny

Section #32

Temp. 80°

T2N, R15E

Personnel Cronin


Ripple

Geyman


Mosser

Barbour

~~2DA~~

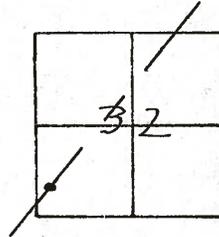

(20-B)

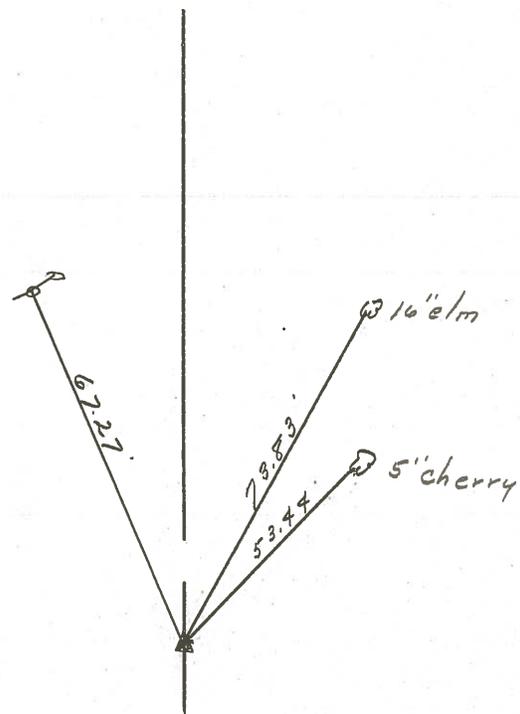

410+54.70
R.R. spike atop a 1"x30" I. Pin
Reset P.K. & Washer

R/R/W S.R. #67

County Seneca S.R. #67

Date 7-16-79

Township Scipio

Weather Sunny

Section 32


Temp. 80°

T2N, R16E

Personnel Schneider

Mosser


Barbour

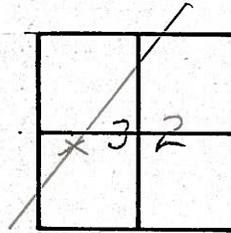

~~20-A~~

20-B

⊥ S.R. #67

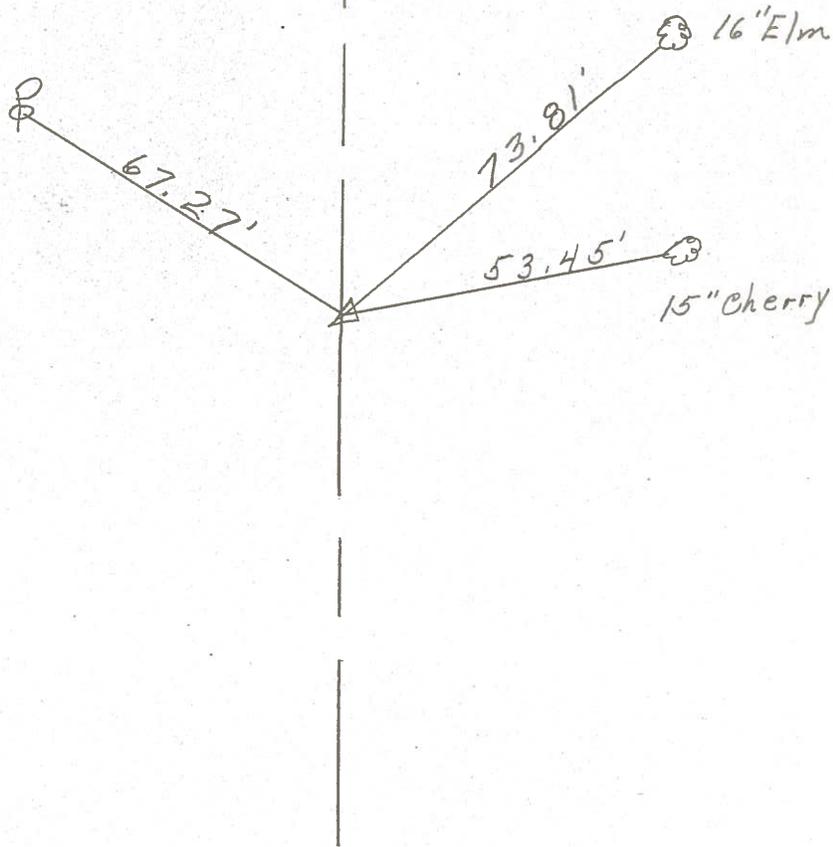

410 + 54.7

Iron Pin on ⊥ R/w

R.R. spk on top

PERSONNEL TITLE PERSONNEL TITLE

COUNTY Seneca DATE 12-21-65

S. R. #67 WEATHER

SEC. TEMP.

DESCRIPTION LEFT CENTER LINE RIGHT JOB NO.

2/13/69

FOUND IRON PIN
5" below surface

23 STA 487+53.55
Small R.R. SPIKE on E of R/W
1" below surface

8426 ~~288~~

FOUND 2/13/69

22 STA 477+66.25
R.R SPIKE on E R/W
3" below surface

~~287~~
8425

2/13/69

FOUND old P.K. Nail 6" below
surface set R.R. spk.

21 STA. 455+20.05
RR SPIKE on E of R/W





~~286~~
8424

20-13

FOUND R/W spk.
5" below surface

STA. 410+54.7
IRON PIN on E of R/W

~~285~~
8423

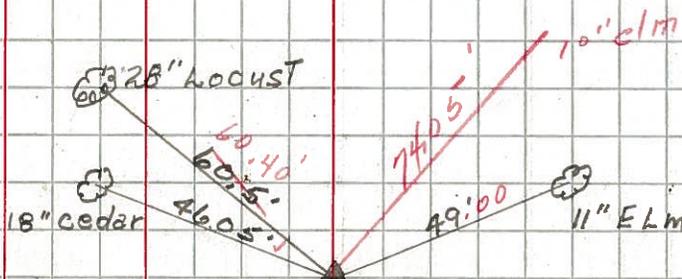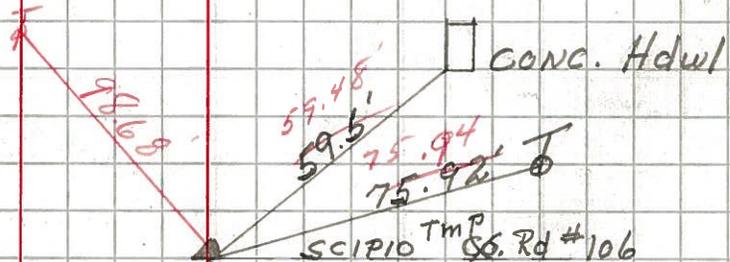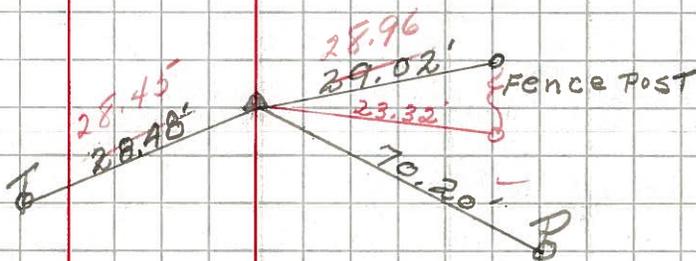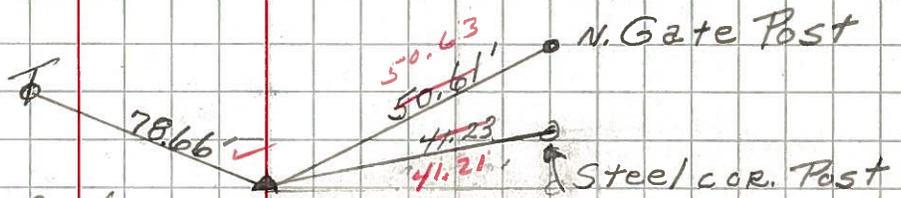

PERSONNEL TITLE PERSONNEL TITLE

COUNTY Seneca

DATE

S. R. 67

WEATHER

SEC.

TEMP.

DESCRIPTION

LEFT


CENTER LINE

RIGHT

JOB NO.


20-B

Sta. 410+54.7
Found Iron pin on $\frac{1}{2}$ of R/W
285

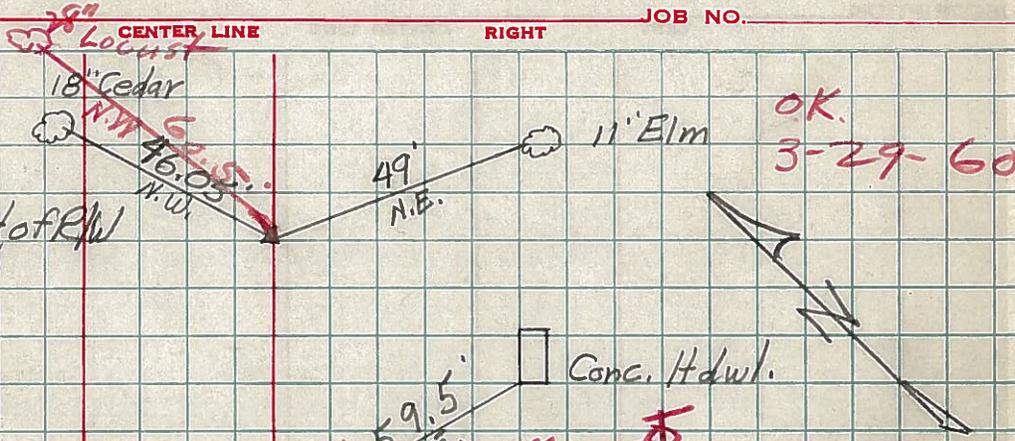


21

Sta. 455+20.05
R.R. Spike on $\frac{1}{2}$ of R/W
286

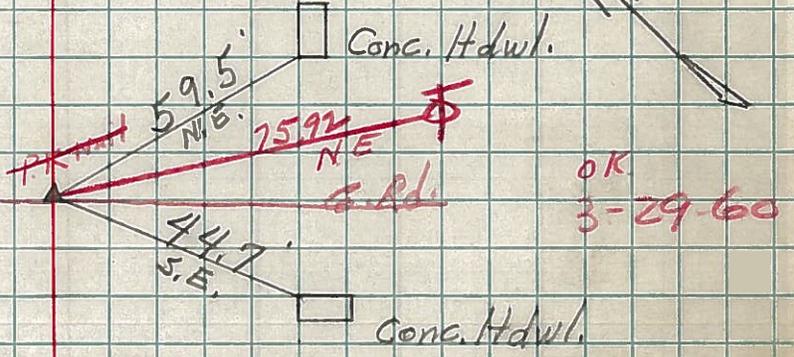

22

Sta. 477+66.25
R.R. Spike on $\frac{1}{2}$ of R/W
3"
10" Cedar
287

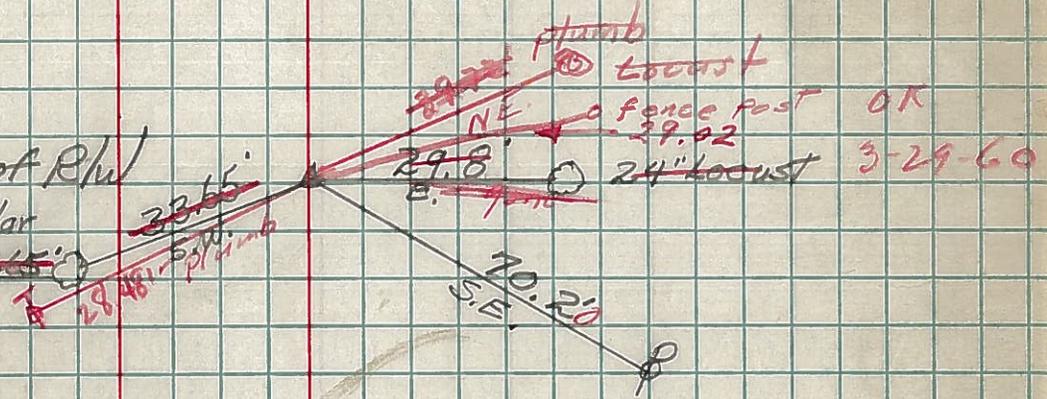

23

Sta. 487+53.55
Small R.R. Spike on $\frac{1}{2}$ of R/W
1" of R/W
19" Hickory
288

