

O.D.O.T. DISTRICT 2 SURVEY OFFICE 16 of 18

PERSONNEL

REFERENCE NO. 24? SHEET ~~16~~ OF ~~18~~

NOTES CHENEY

H.C. BARBOUR

R.C. RIPPLE

GEYMAN

DATE 12-10-1991

WEATHER CLOUDY

TEMP. 35°

ROUTE 67

COUNTY SENECA

TOWNSHIP SCIPIO

SECTION 29

T2 N R 15 E


TYPE MONUMENT _____

ON SURFACE - BELOW _____

LEFT - & PAV'T. - RIGHT _____

TO _____ EDGE PAVEMENT

S.L.M. _____

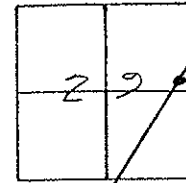


RECORD STA. 493+30.85

* POINT NOT FOUND - R.P. SPK. DNE 6-1-02

* NOTE: SEE SHEET # 22 OF 25

DATED 7-16-1979

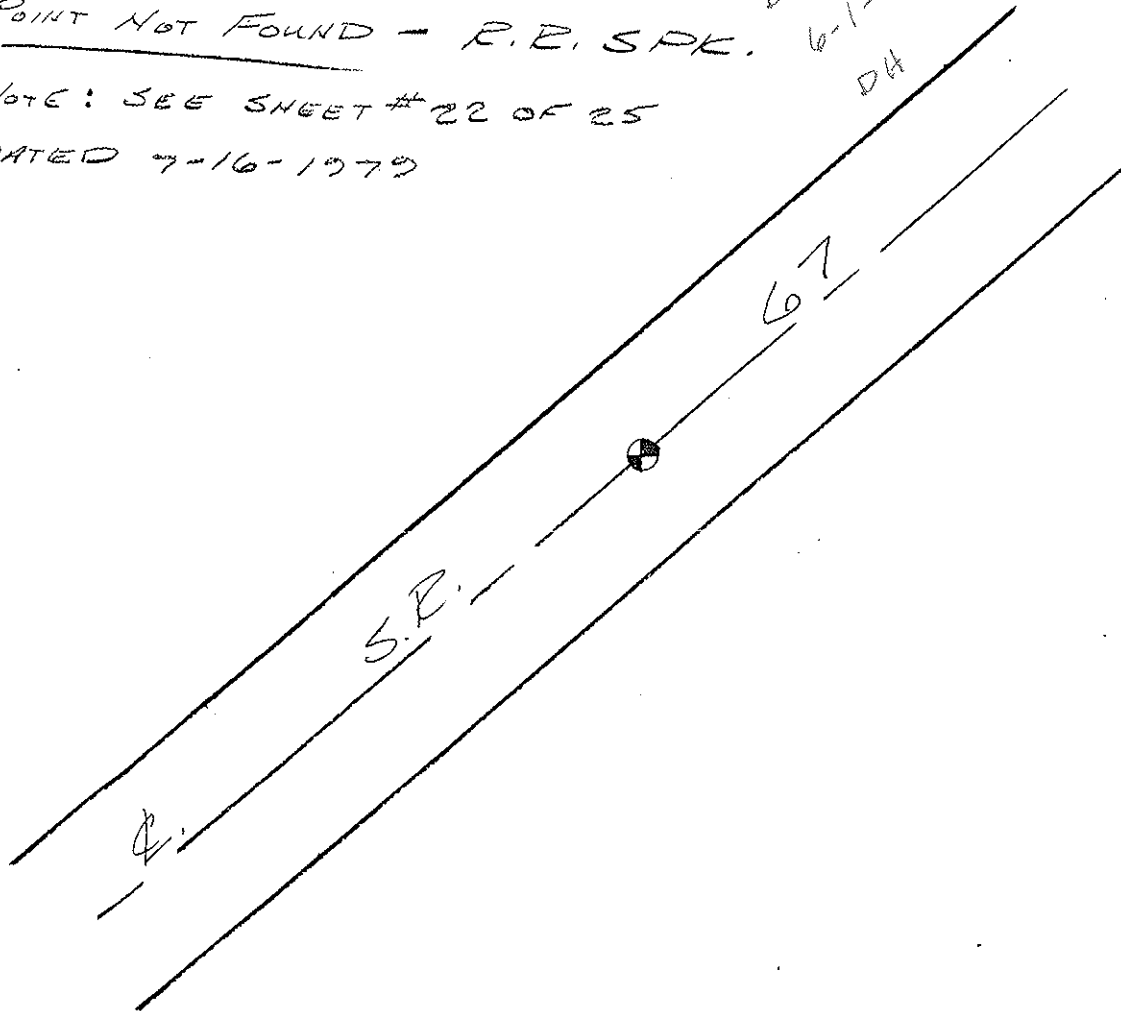

County Seneca S.R. # 67

Date Copy 7-16-79

Township Scipio

Weather Sunny

Section _____



Temp. 82°

T2N, R16E

Personnel Schneider

Mosser

Barbour

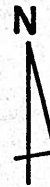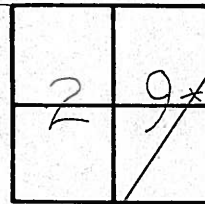


24

⊥ S.R. # 67

493 + 30.85

R.R. spk. on ⊥ R/W

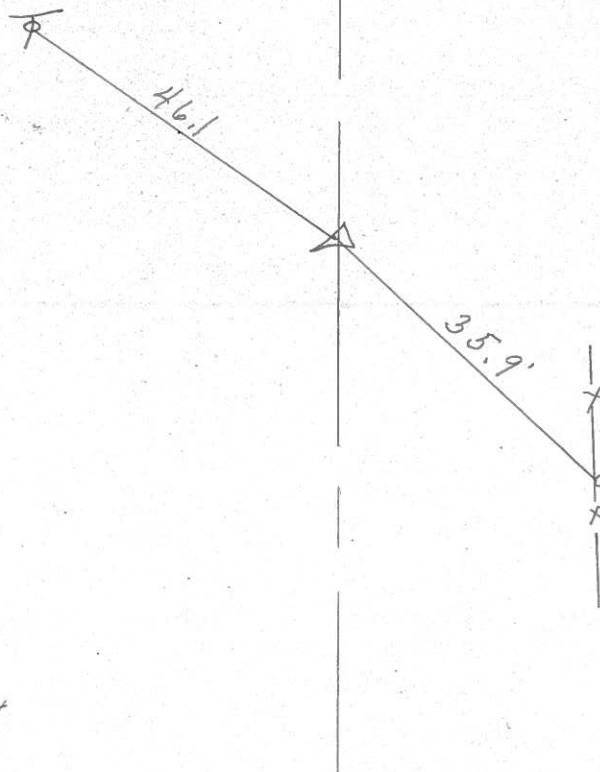

6/20/73

Used Magnetic detector in
 about an 8' area, did not
 pick up anything, Probably just
 a P.O.T. because it was set
 just before a dip