

O.D.O.T. DISTRICT 2 SURVEY OFFICE (USE ONLY)

PERSONNEL

REFERENCE NO. 14

SHEET 17 OF 46

NOTES RHOADES

DATE 6/15/22

ROUTE SR 100

H.C. AUBLE

WEATHER SUNNY

COUNTY SENECA

R.C. WHITAKER

TEMP. 82°

TOWNSHIP EDEN

SECTION 22

DWG BY WHITAKER

PID 95778

T 1 N R 15 E

TYPE MONUMENT MAG/WASHER

ON SURFACE - ~~BELOW~~ ON

OFFSET \varnothing PAVEMENT 1.1' LT : ~~RT~~

- TO - EDGE PAVEMENT


STATION: 176+93

HORZ.DATUM: NAD83(2011)


GEOID: 2012A

GRID: NORTHING: 499848.504

EASTING: 1797268.623

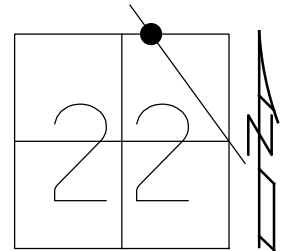

RECORD:
 SET P.K./WASHER
 10-18-00, MRC
 FD P.K./WASHER
 REF14
 1-24-19
 8-19-19, JFO
 SET MAG/W
 NEWREF14
 6/15/22, DSA

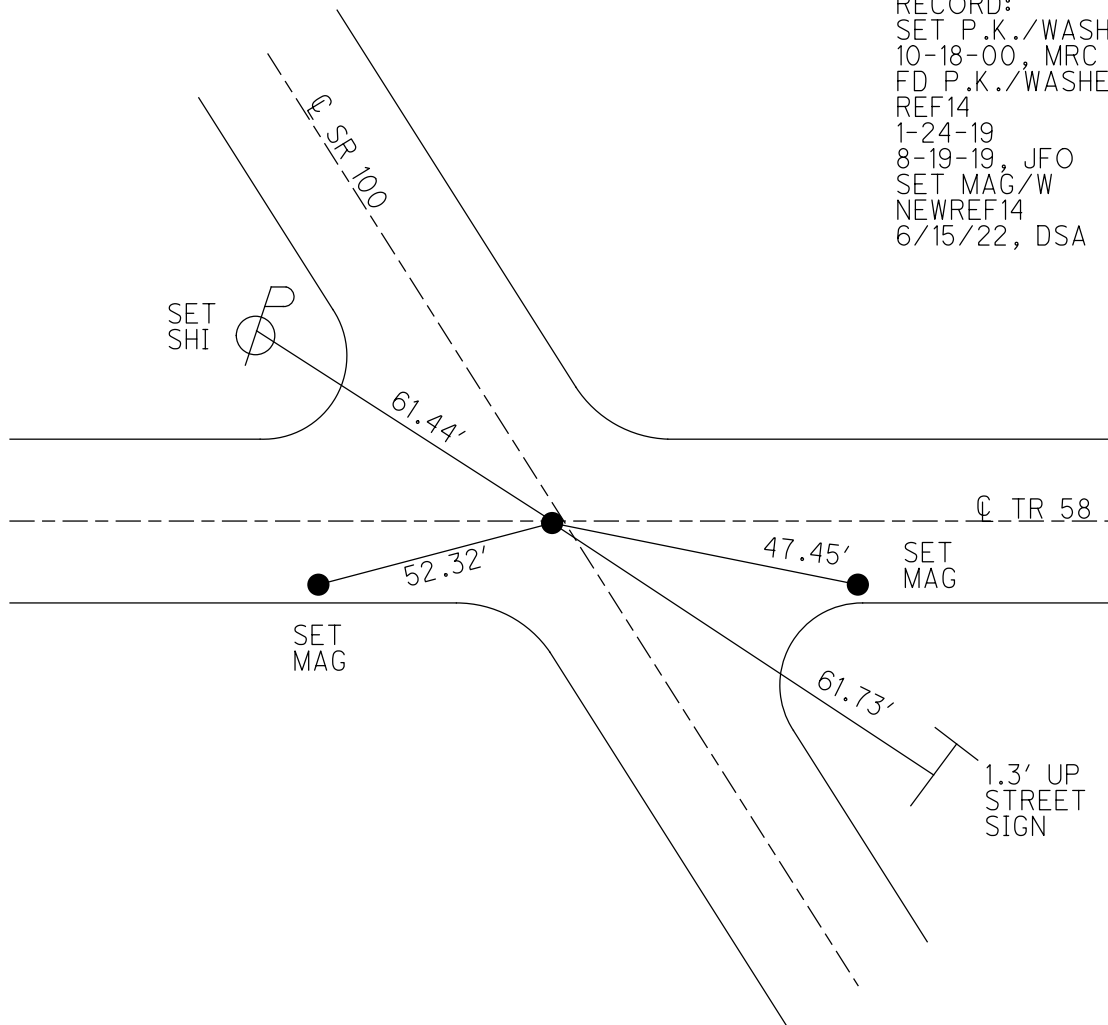

O.D.O.T. DISTRICT 2 SURVEY OFFICE (USE ONLY)

PERSONNEL _____

REFERENCE NO. 14

SHEET 17 OF 38

NOTES CANTERBURY

DATE 7-25-00

ROUTE SR 100

H.C. BARNHISEL

WEATHER SUNNY

COUNTY SENECA

R.C. MOSER

TEMP. 82°

TOWNSHIP EDEN

SECTION 22

DWG BY NIESE

PID 107060

T 1 N R 15 E

TYPE MONUMENT P.K./WASHER

ON SURFACE - ~~BELOW~~ ON

OFFSET 1.1' LT : ~~RT~~

- TO - EDGE PAVEMENT



STATION: 176+93

HORZ.DATUM: NAD83(2011)

GEOID: 2012A

GRID: NORTHING: 499848.504

EASTING: 1797268.623

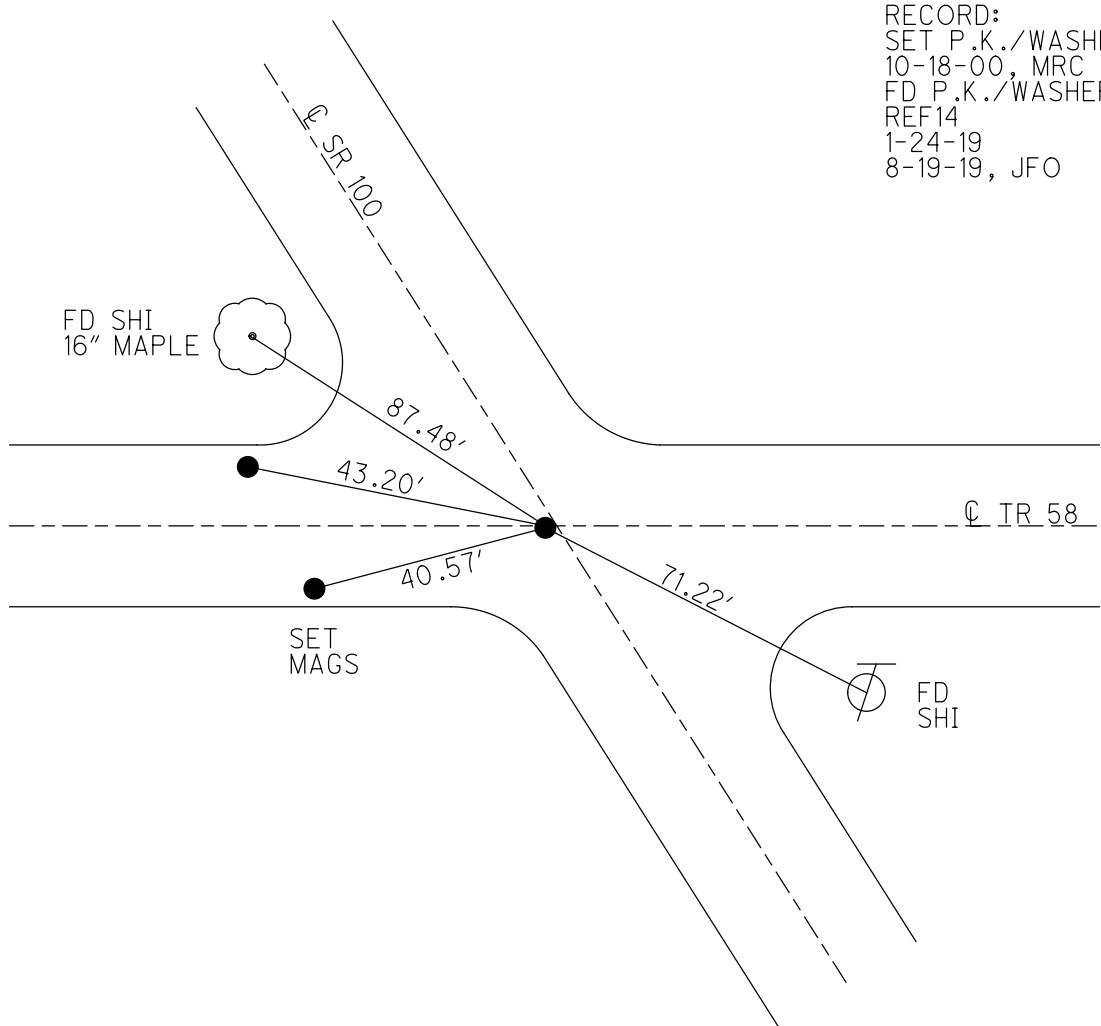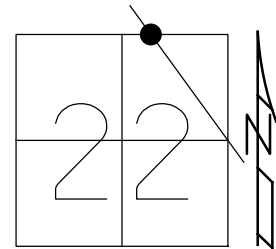

RECORD:
 SET P.K./WASHER
 10-18-00, MRC
 FD P.K./WASHER
 REF14
 1-24-19
 8-19-19, JFO

O.D.O.T. DISTRICT 2 SURVEY OFFICE

PERSONNEL _____

REFERENCE NO. 14

SHEET 15 OF 31

NOTES CANTERBURY

H.C. BARNHISEL

R.C. MOSEK

DATE 7-25-00

WEATHER SUN

TEMP. +82°

ROUTE #100

COUNTY SENECA

TOWNSHIP Eden

SECTION #22

T 1 N R 15 E

TYPE MONUMENT P.K + WASHER


ON SURFACE - BELOW SURFACE

LEFT - Q PAV'T. - RIGHT 1.1' LT Q PAVT


TO EDGE PAVEMENT ON Q E.

S.L.M. 176 + 93

RESET P.R. + WASHER
 10-18-00
 M.R.C.

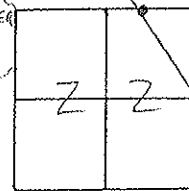

RECORD: MAY OR MAY
 NOT BE ON Q & SEC. LINE.

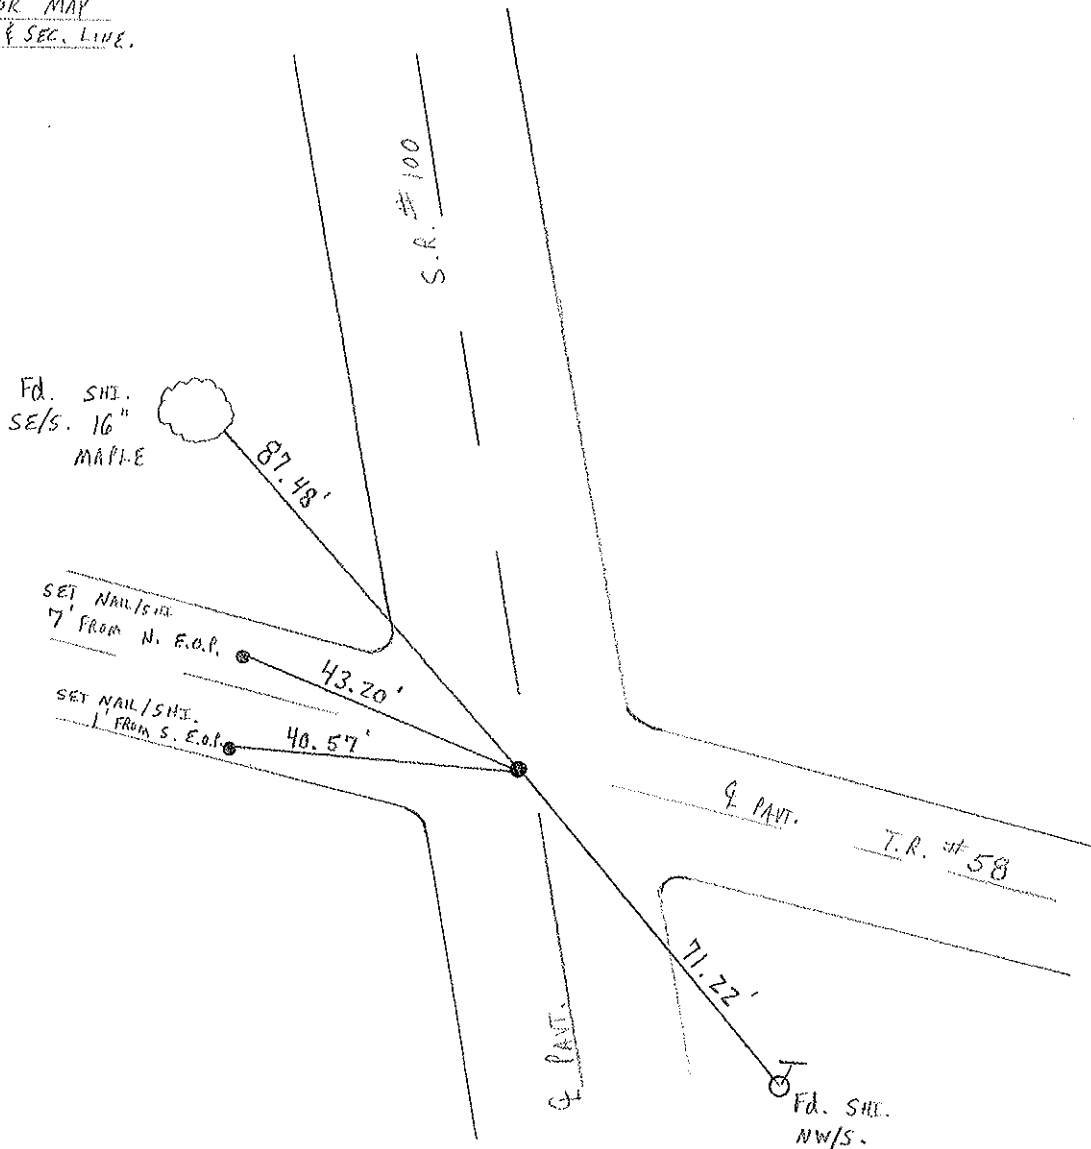

O.D.O.T. DISTRICT 2 SURVEY OFFICE

PERSONNEL

NOTES CROWN
 H.C. RIPPLE
 R.C. BARBOUR MEAS.
GEYMAN



REFERENCE NO. 14
 DRAWN 12/20/88
 DATE 11-28-89
 WEATHER SUNNY Windy
 TEMP. 32°

SHEET 14 OF

ROUTE #100
 COUNTY SENECA
 TOWNSHIP EDEN
 SECTION #22
T 1 N R 15 E

TYPE MONUMENT P.K. Washer
 ON SURFACE - BELOW SURFACE
 LEFT - PAV'T. - RIGHT 1' LT. &
 TO EDGE PAVEMENT
 S.L.M.

14

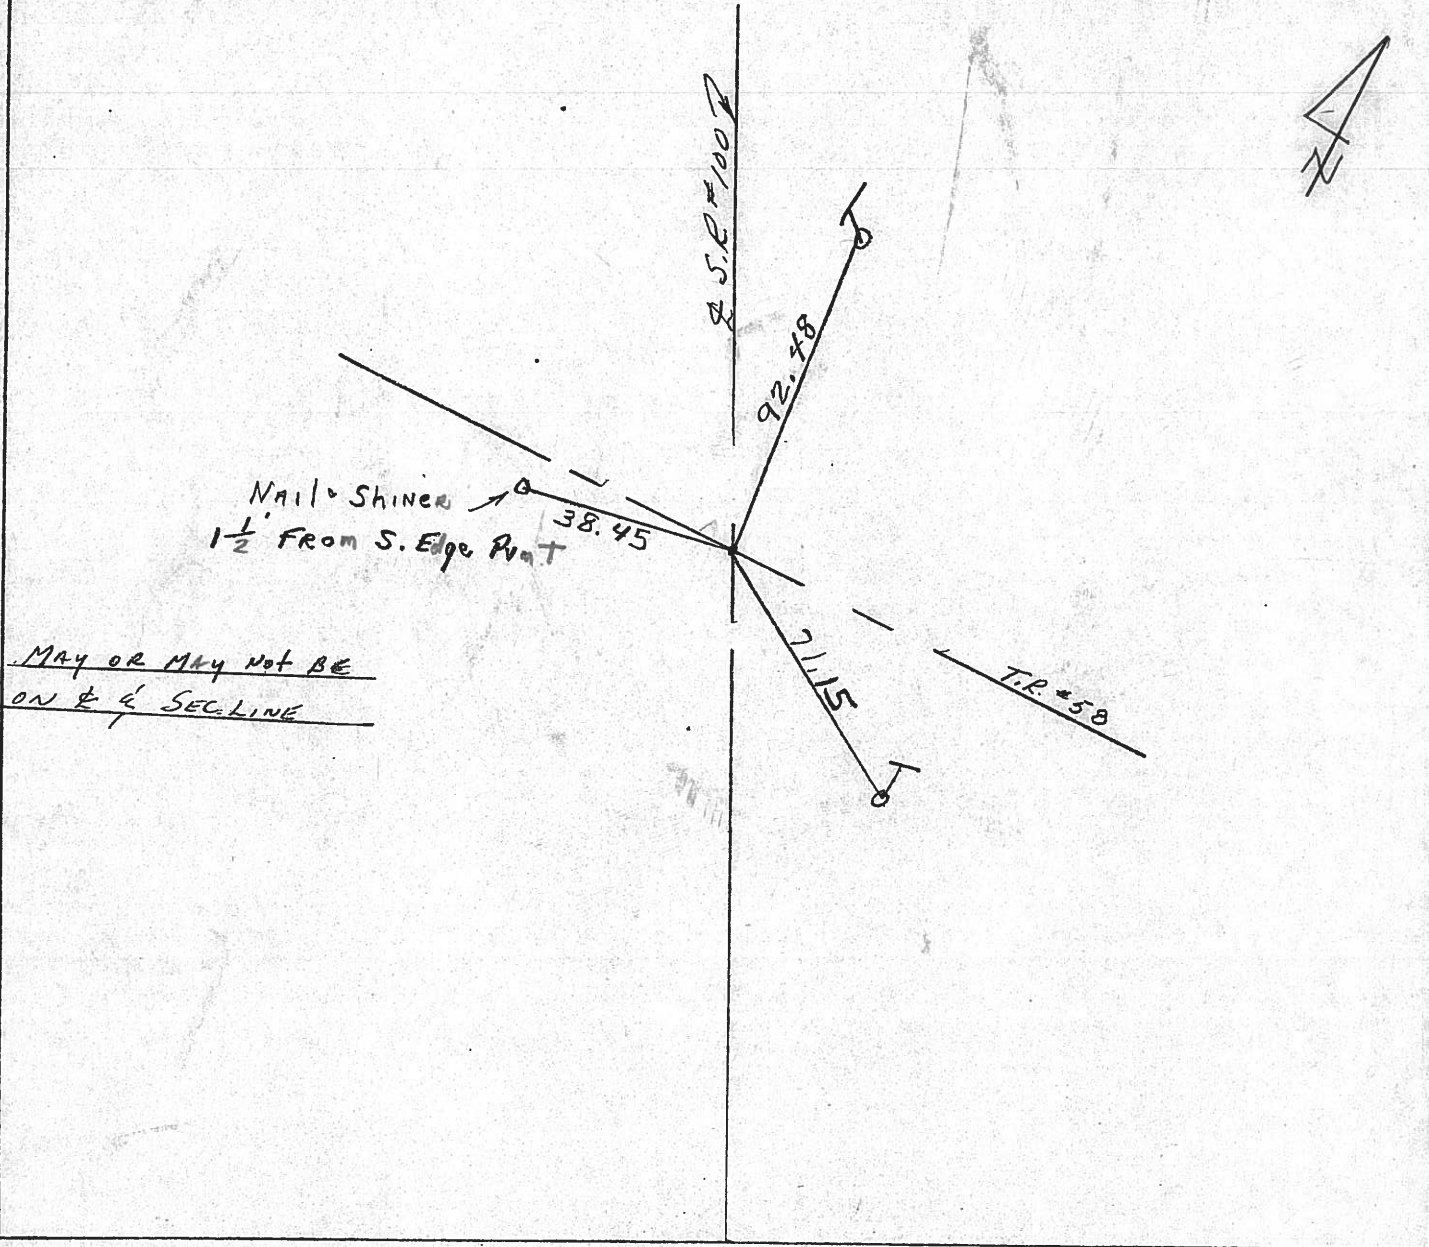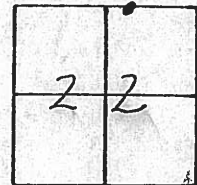

MAY OR MAY NOT BE
ON & SEC. LINE