


O.D.O.T. DISTRICT 2 SURVEY OFFICE (USE ONLY)


PERSONNEL _____ REFERENCE NO. 25 SHEET 33 OF 46
 NOTES RHOADES DATE 7/9/21 ROUTE SR 100
 H.C. AUBLE WEATHER CLOUDY COUNTY SENECA
 R.C. NIESE TEMP. 69° TOWNSHIP CLINTON
 DWG BY WHITAKER PID 95778 SECTION 32
 T 2 N R 15 E

TYPE MONUMENT MAG/WASHER
 ON SURFACE - ~~BELOW~~ ON _____
 OFFSET \varnothing PAVEMENT ON _____ LT : ~~RT~~
10' TO LT EDGE PAVEMENT
 STATION: 406+88

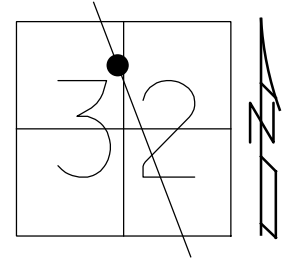

HORZ.DATUM: NAD83(2011) GEOID: 2012A
 GRID: NORTHING: 519314.054 EASTING: 1786635.598


RECORD:
 SLM. 408+63±
 FD IPIN
 8" DOWN
 7/26/00
 SET P.K./WASHER
 10-19-00, MRC
 FD PK/WASHER
 REF25
 2-14-19
 8-19-19, JFO
 SET MAG/WASHER
 NEWREF25
 11/19/21, DSA

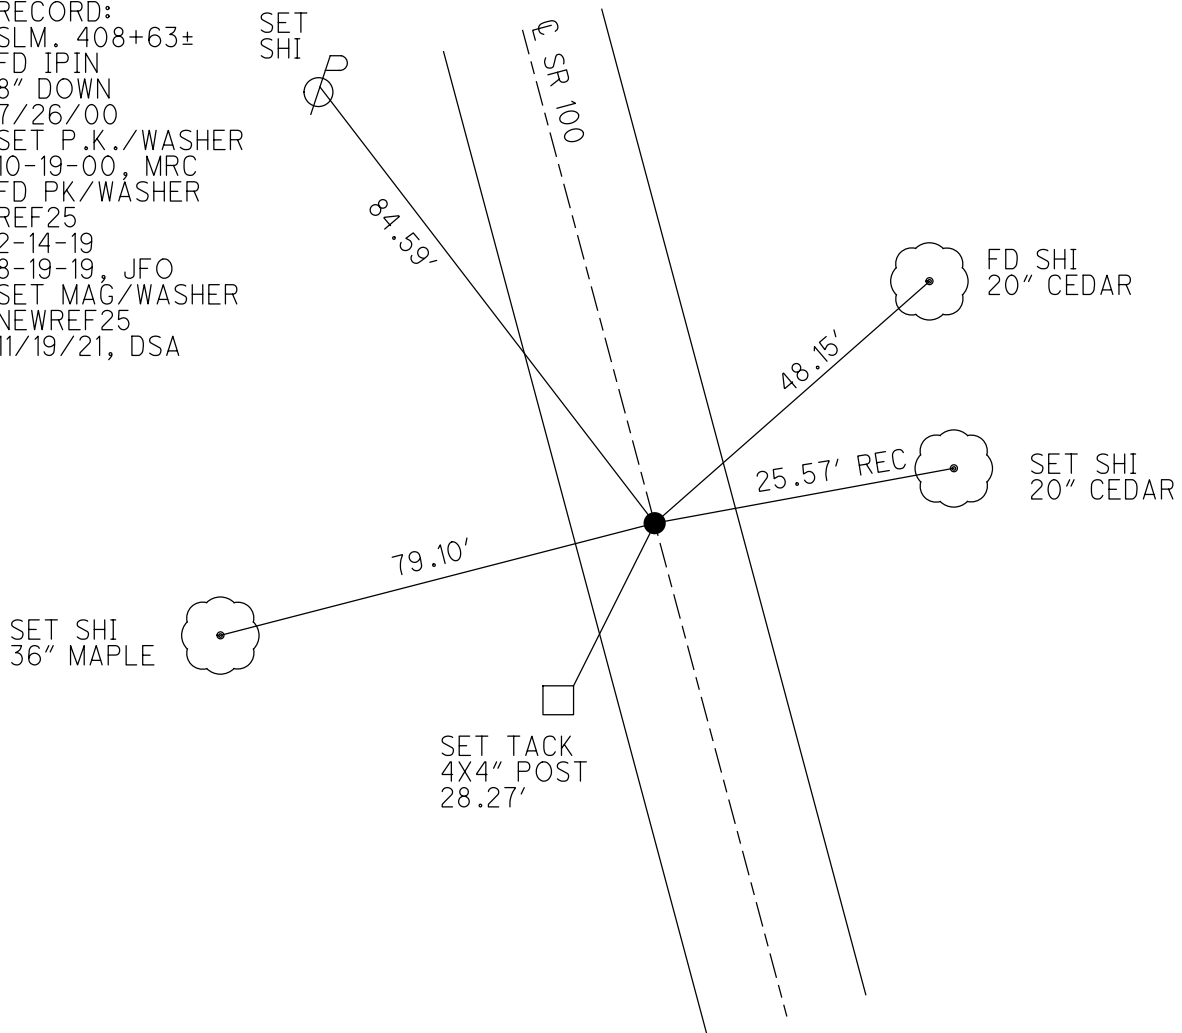


O.D.O.T. DISTRICT 2 SURVEY OFFICE (USE ONLY)

PERSONNEL _____ REFERENCE NO. 25 SHEET 33 OF 38
NOTES CANTERBURY DATE 7-26-00 ROUTE SR 100
H.C. MOSER WEATHER CLOUDY COUNTY SENECA
R.C. CANTERBURY TEMP. 80° TOWNSHIP CLINTON
SECTION 32
DWG BY NIESE PID 107060 T 2 N R 15 E

TYPE MONUMENT IPIN
~~ON SURFACE~~ - BELOW 8"
OFFSET \varnothing PAVEMENT 0.2' LT : ~~RT~~
10' TO LT EDGE PAVEMENT
STATION: 406+88

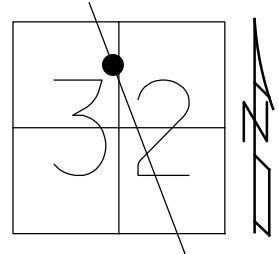

HORZ. DATUM: NAD83(2011) GEOID: 2012A
GRID: NORTHING: 519314.054 EASTING: 1786635.598

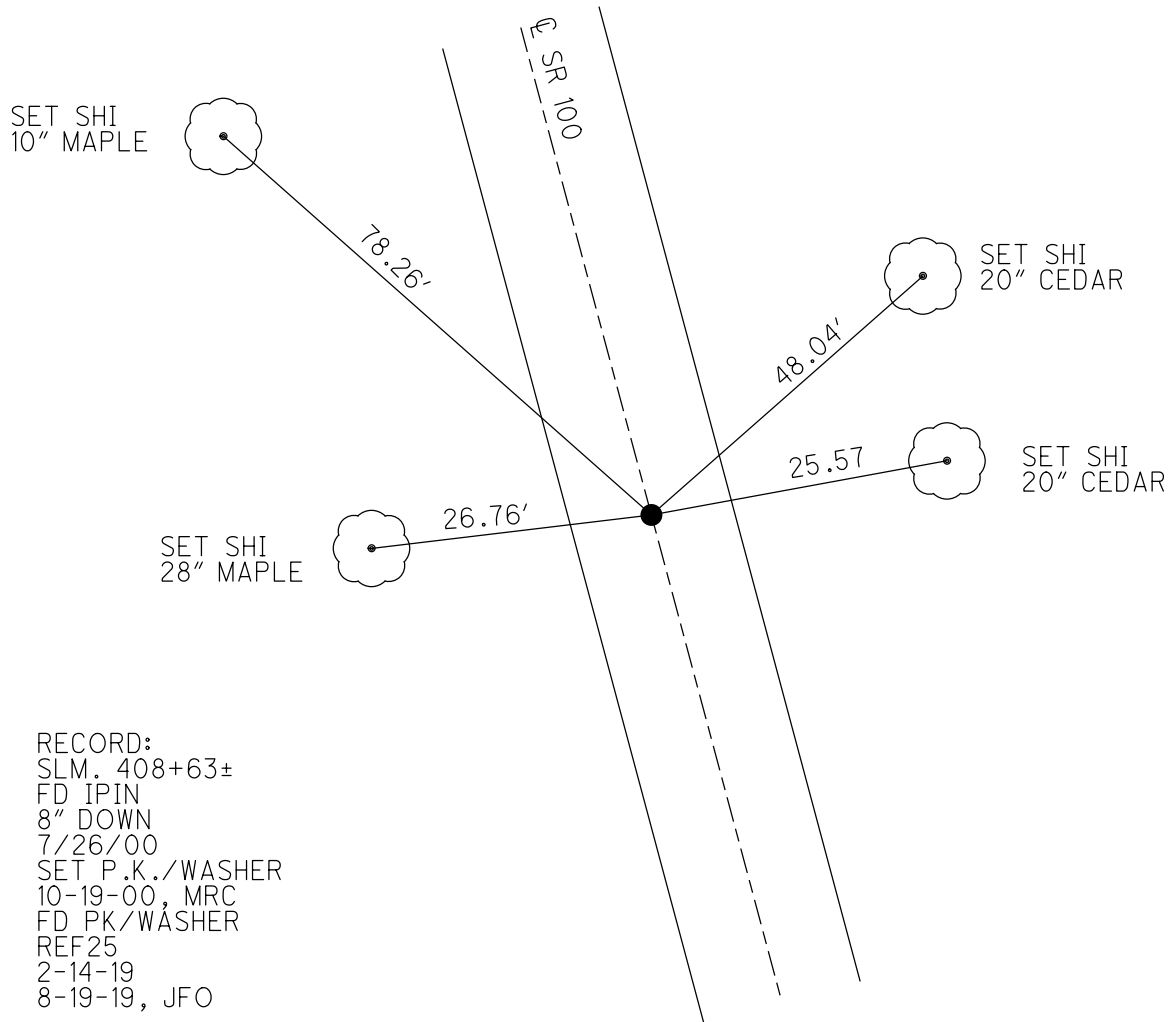

O.D.O.T. DISTRICT 2 SURVEY OFFICE

PERSONNEL _____

REFERENCE NO. _____

SHEET 28 OF 31

NOTES CANTERBURY

H.C. MOSEK

R.C. CANTERBURY

DATE 7-26-00

WEATHER OVERCAST

TEMP. +80°

ROUTE # 100

COUNTY SENECA

TOWNSHIP CLINTON

SECTION 32

T 2 N R 15 E

TYPE MONUMENT IRON PIN



ON SURFACE - BELOW 8" DOWN

LEFT-~~Q~~ PAW'T. - ~~RIGHT~~ 0.2' LT Q

10.0' TO LT EDGE PAVEMENT

S.L.M. 406+88

RESET P.K. + WASHER
10-19-00
M.R.C.

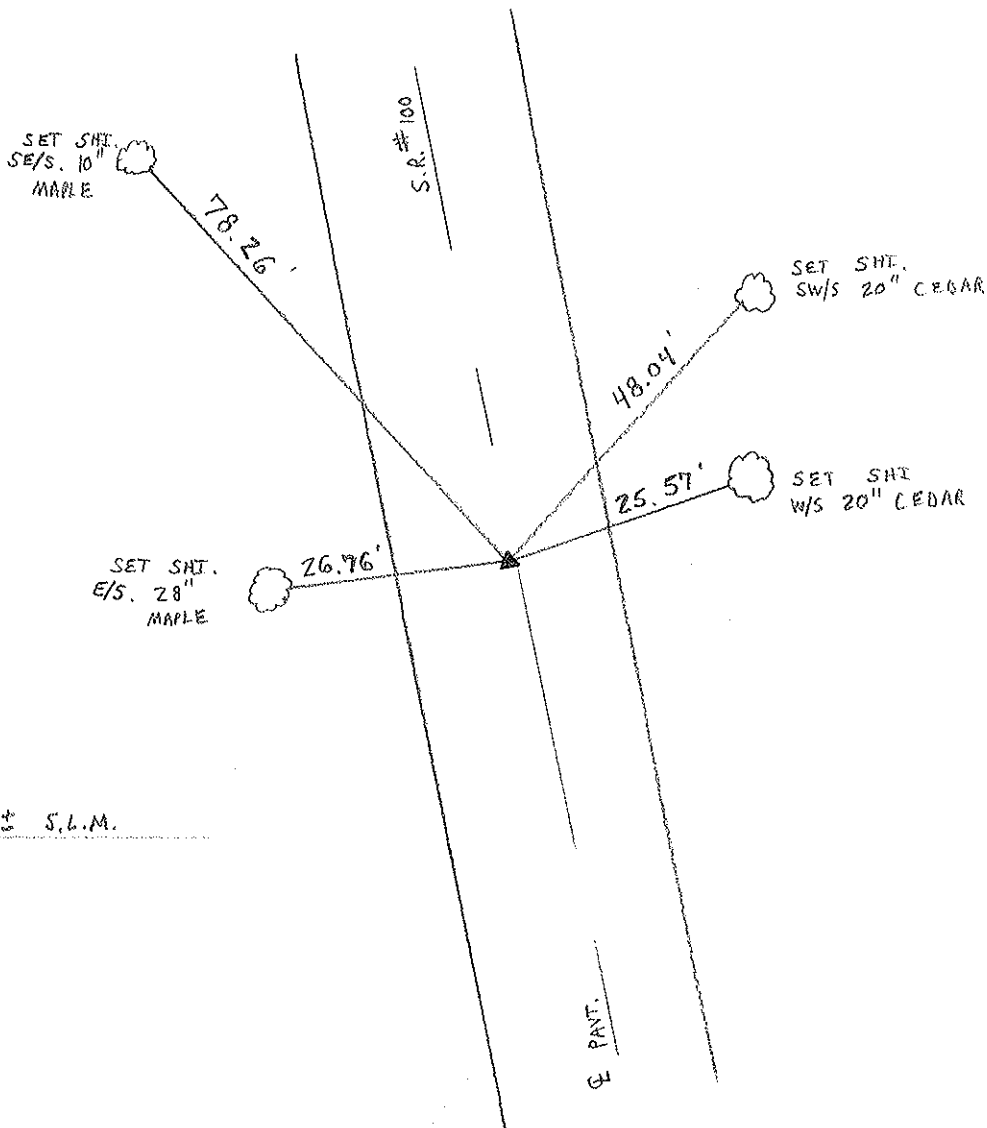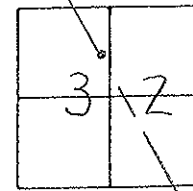

RECORD: 408+63± S.L.M.

O.D.O.T. DISTRICT 2 SURVEY OFFICE

PERSONNEL _____

REFERENCE NO. _____

SHEET _____ OF _____

NOTES Cronin

DRAWN 11/13/86

H.C. Ripple

DATE 11/12/86

R.C. Geyman

WEATHER sunny

Barbour

TEMP. 32°

ROUTE #100

COUNTY Seneca

TOWNSHIP Clinton

SECTION 32

T 2 N R 15 E

TYPE MONUMENT I. Pipe or Pin


ON SURFACE - BELOW Below

LEFT- & PAV'T. - RIGHT & Pavt.

TO _____ EDGE PAVEMENT

S.L.M. _____

25

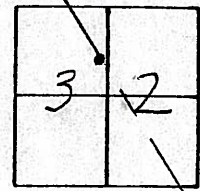

408+63 ± S.L.M.

