

O.D.O.T. DISTRICT 2 SURVEY OFFICE (USE ONLY)

PERSONNEL	REFERENCE NO. <u>2 A</u>	SHEET <u>3</u> OF <u>27</u>
NOTES <u>RHOADES</u>	DATE <u>3/15/18</u>	ROUTE <u>SR 101</u>
H.C. <u>O'DONNELL</u>	WEATHER <u>SUNNY</u>	COUNTY <u>SENECA</u>
R.C. <u>SEAMAN</u>	TEMP. <u>32°</u>	TOWNSHIP <u>CLINTON</u>
		SECTION <u>20</u>
DWG BY <u>MILLER</u>	PID <u>102817</u>	T <u>2</u> N R <u>15</u> E

TYPE MONUMENT MAG/WASHER

ON SURFACE - ~~BELOW~~ ON

OFFSET 2.3' LT : ~~RT~~

7.3' TO LT EDGE PAVEMENT


STATION: 85+69.53

HORZ. DATUM: NAD83 2011

GEOID: 2012A NAVD88


GRID: NORTHING: 531189.526

EASTING: 1786750.311

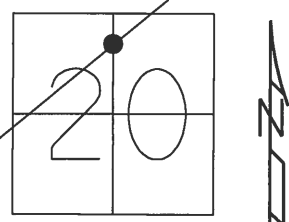

RECORD:
 FD R.R. SPIKE
 3" DOWN
 6/23/08, DCH
 SET MAG/WASHER
 9-30-08, DCH
 FD MAG/WASHER
 REFA2
 10-11-16, JFO
 SET MAG/WASHER
 10-10-18, JFO

DIST. 2-2A= 16.52'


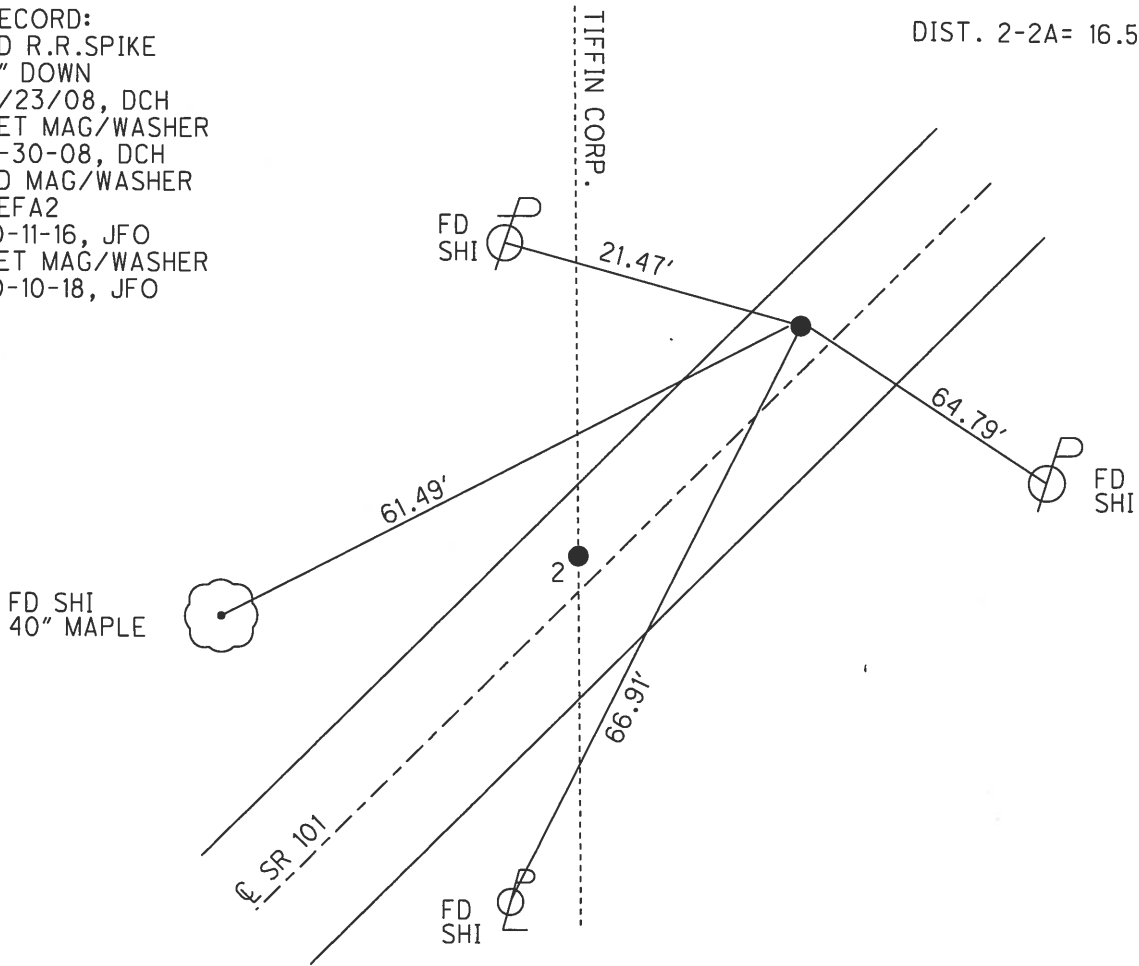


O.D.O.T. DISTRICT 2 SURVEY OFFICE (USE ONLY)

PERSONNEL _____ REFERENCE NO. 2A SHEET 3 OF 27


NOTES HOMAN _____ DATE 6/23/08 ROUTE SR 101
 H.C. ROUSOS _____ WEATHER SUNNY COUNTY SENECA
 R.C. HOMAN _____ TEMP. 65° TOWNSHIP CLINTON
 _____ SECTION 20
 _____ T 2 N R 15 E

TYPE MONUMENT R.R.SPIKE
~~ON SURFACE~~ - BELOW 3"
 LEFT - ☉ PAV'T - ~~RIGHT~~ 2.3'
7.3' TO W EDGE PAVEMENT
 S.L.M. 85+70.6

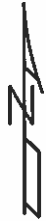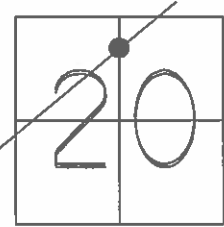

GRID: NORTHING: 531189.529 EASTING: 1786750.238

RECORD:
 SET MAG/WASHER
 9-30-08, DCH

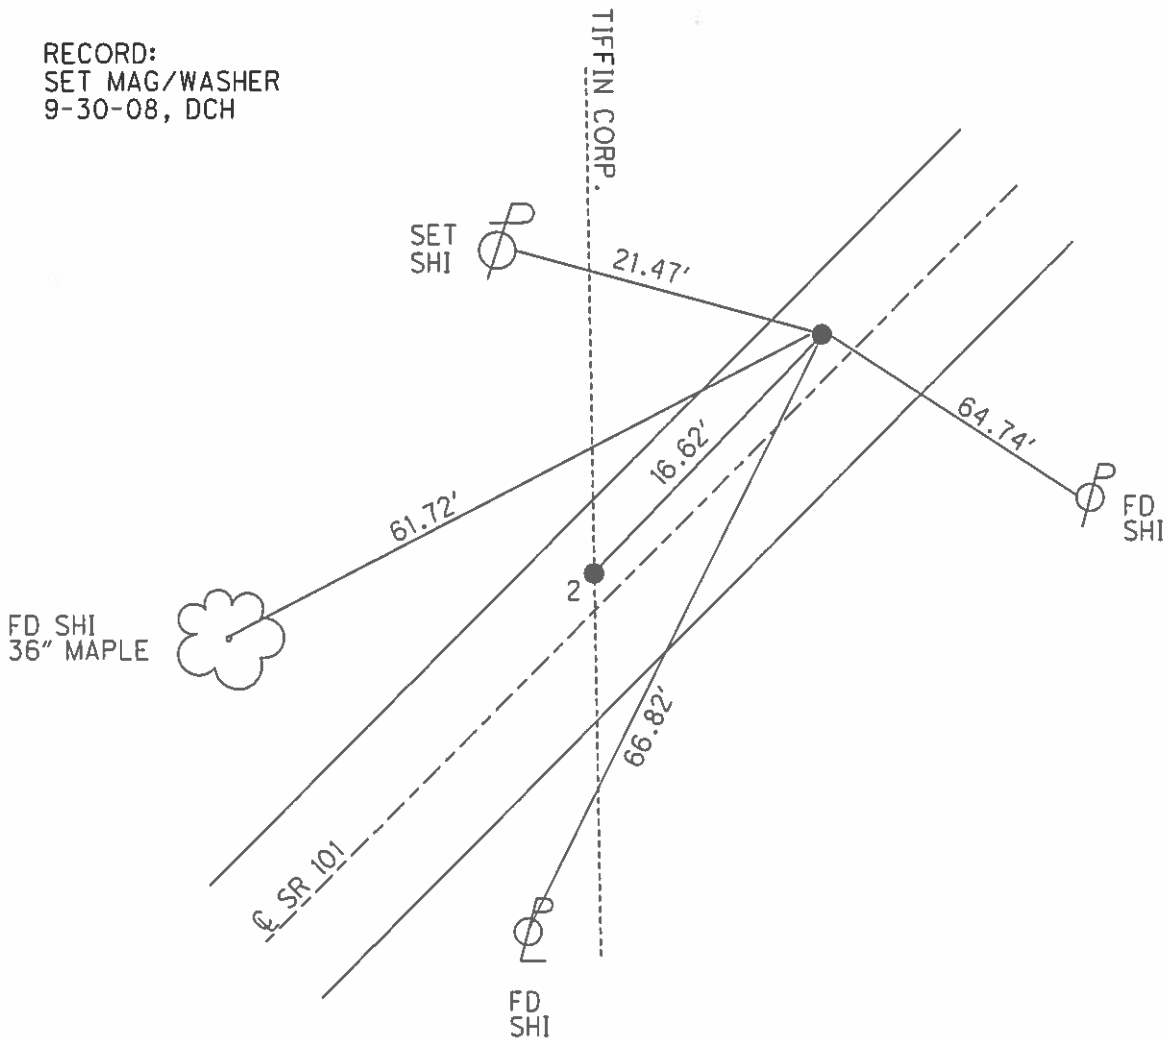

O.D.O.T. DISTRICT 2 SURVEY OFFICE

PERSONNEL

REFERENCE NO. 2/2A

SHEET 2 OF 26

NOTES Cheney

H.C. RIPPLE

R.G. BARBOUR

Geyman

DATE 7-9-92

WEATHER SUNNY

TEMP. 60°

ROUTE SR.# 101

COUNTY Seneca

TOWNSHIP CLINTON

SECTION 20

T 2 N R 15 E

TYPE MONUMENT Fd. IRON BAR 4" down (NOT COVERED)


ON SURFACE - BELOW 3' LT. C.

~~LEFT - C~~ PAV'T. - RIGHT

7.4' TO W. EDGE PAVEMENT

S.L.M. 85+54

(2-A)

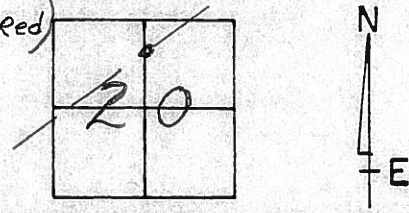

Record:

1925 PLAN STA. 0+00

