


O.D.O.T. DISTRICT 2 SURVEY OFFICE (USE ONLY)


PERSONNEL _____ REFERENCE NO. 5 SHEET 6 OF 27
 NOTES RHOADES DATE 3/15/18 ROUTE SR 101
 H.C. O'DONNELL WEATHER SUNNY COUNTY SENECA
 R.C. SEAMAN TEMP. 32° TOWNSHIP CLINTON
 DWG BY MILLER PID 102817 SECTION 20
 T 2 N R 15 E

TYPE MONUMENT MAG/WASHER
 ON SURFACE - ~~BELOW~~ ON _____
 OFFSET Q PAVEMENT 0.5' LT : ~~RT~~
10.3' TO RT EDGE PAVEMENT
 STATION: 101+68.46

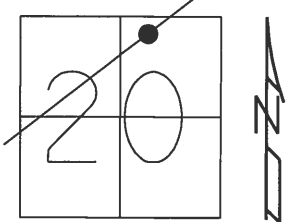

HORIZ.DATUM: NAD83 2011 GEOID: 2012A NAVD88
 GRID: NORTHING: 532256.078 EASTING: 1787941.538


RECORD:
 STA. 16+00
 IPIN ON Q R/W
 3" BELOW
 3-4-70
 FD P.K.SHANK
 6/23/08, DCH
 SET MAG/WASHER
 10-1-08, DCH
 FD MAG/WASHER
 REF5
 10-11-16, JFO
 SET MAG/WASHER
 10-10-18, JFO

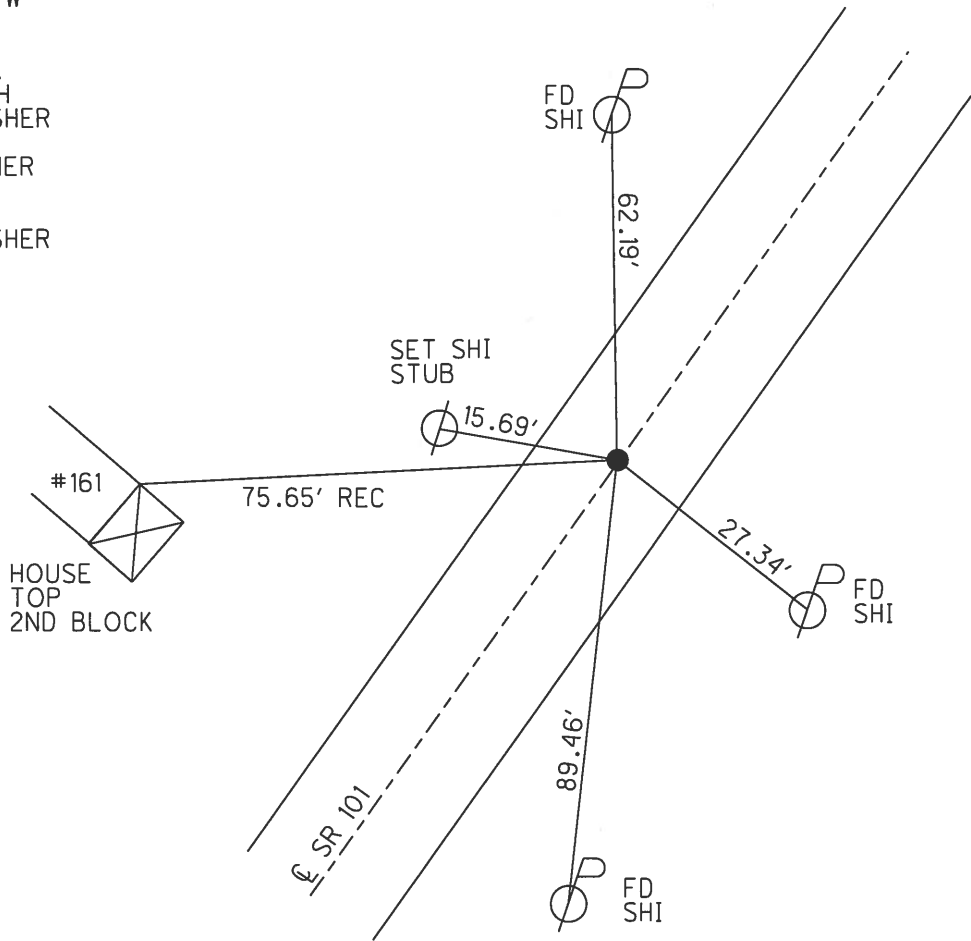

O.D.O.T. DISTRICT 2 SURVEY OFFICE (USE ONLY)


PERSONNEL _____ REFERENCE NO. 5 SHEET 6 OF 27
 NOTES HOMAN _____ DATE 6-23-08 ROUTE SR 101
 H.C. ROUSOS _____ WEATHER SUNNY COUNTY SENECA
 R.C. HOMAN _____ TEMP. 70° TOWNSHIP CLINTON
 _____ SECTION 20
 _____ T 2 N R 15 E

TYPE MONUMENT P.K.SHANK
 ON SURFACE - ~~BELOW~~ ON _____
 LEFT - ☉ PAV'T - ~~RIGHT~~ 0.5'
10.3' TO RT EDGE PAVEMENT
 S.L.M. 101+69

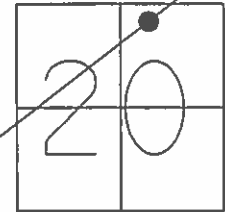

GRID: NORTHING: 532253.037 EASTING: 1787941.503

RECORD:
 STA. 16+00
 IPIN ON ☉ R/W
 3" BELOW
 3/4/70
 SET MAG/WASHER
 10/1/08, DCH

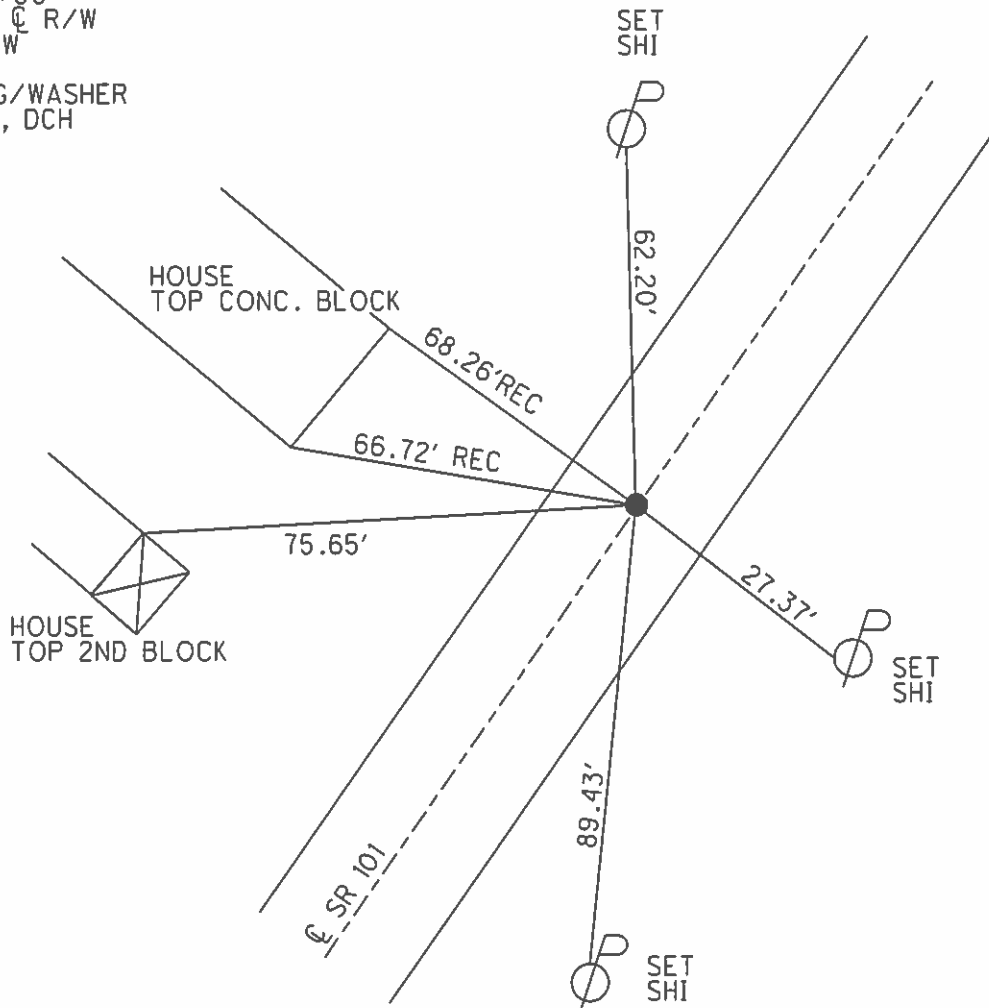

O.D.O.T. DISTRICT 2 SURVEY OFFICE

PERSONNEL

REFERENCE NO. 5

SHEET 6 OF 27

NOTES CHENEY

DATE 7/9/92

ROUTE SR 101

H.C. RIPPLE

WEATHER SUNNY

COUNTY SENECA

R.C. BARBOUR

TEMP. 60°

TOWNSHIP CLINTON

GEYMAN

SECTION 20

T 2 N R 15 E


TYPE MONUMENT P.K. SHANK.

ON SURFACE - ~~BELOW~~ ON

LEFT - ~~C PAVT~~ - RIGHT 1'


10.3 TO RT EDGE PAVEMENT

S.L.M. 101+69

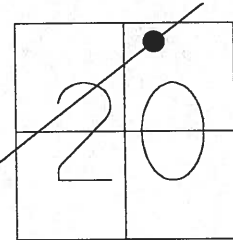

Grid: Northing: 532256.090 Easting: 1787941.467

Record: 3/4/70
Iron Pin on C.L. R/W
3" below surface
16+00

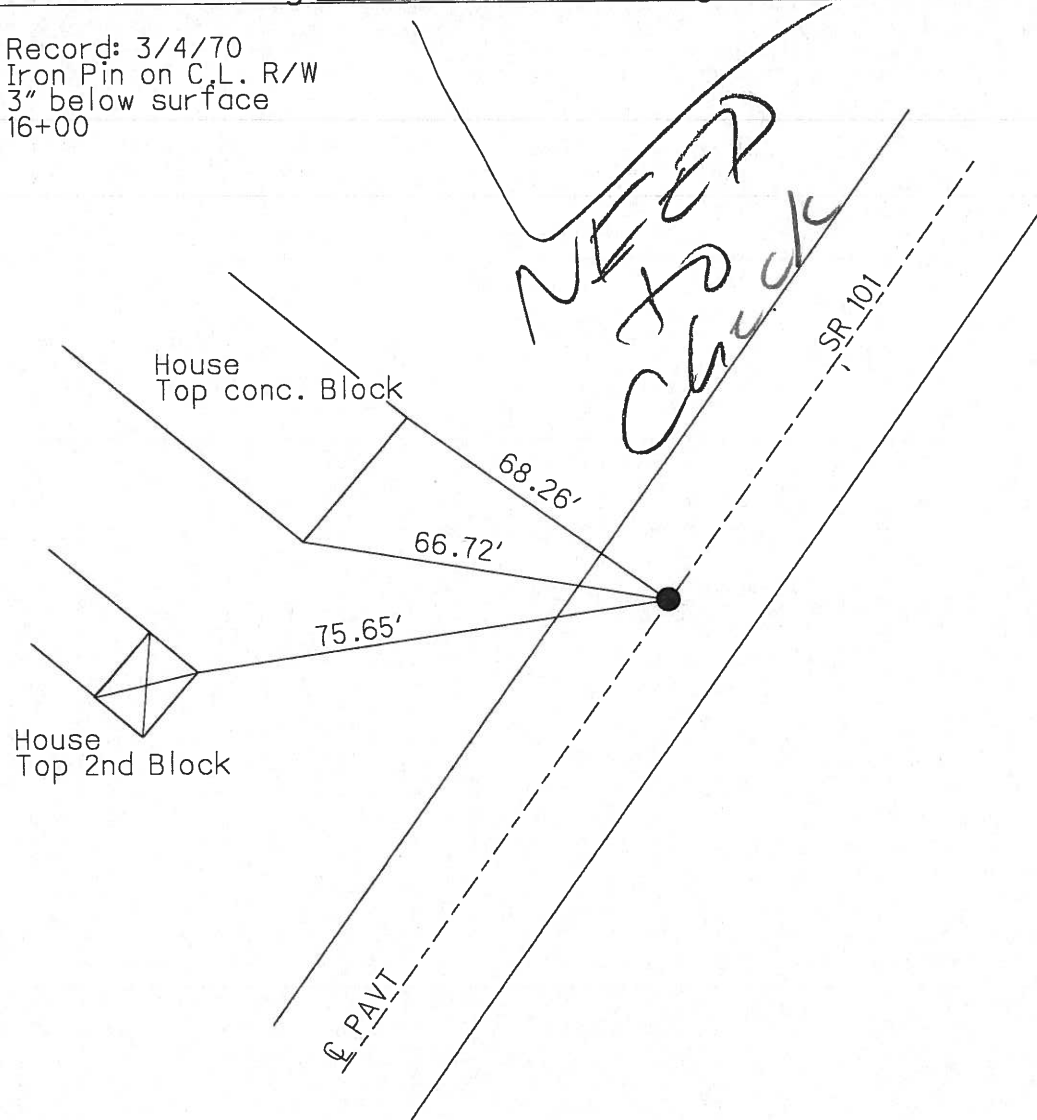

O.D.O.T. DISTRICT 2 SURVEY OFFICE

PERSONNEL

REFERENCE NO. 5

SHEET 5 OF 26

NOTES CHENEY

H.C. RIPPLE

R.C. BARBOUR

Geyman

DATE 7-9-92

WEATHER SUNNY

TEMP. 60°

ROUTE SR#101

COUNTY Seneca

TOWNSHIP CLINTON

SECTION 20

T2 N R 15 E

TYPE MONUMENT P.K. SHANK


ON SURFACE - BELOW yes

LEFT- & PAV'T. - RIGHT 1'

10.3 TO RT. EDGE PAVEMENT


S.L.M. 101+69

SET P.K./washer
9-30-92

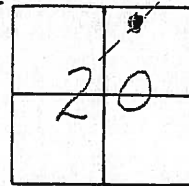

Record: 3/4/70
Iron pin on & R/W
3" below surface
16+00

101+56

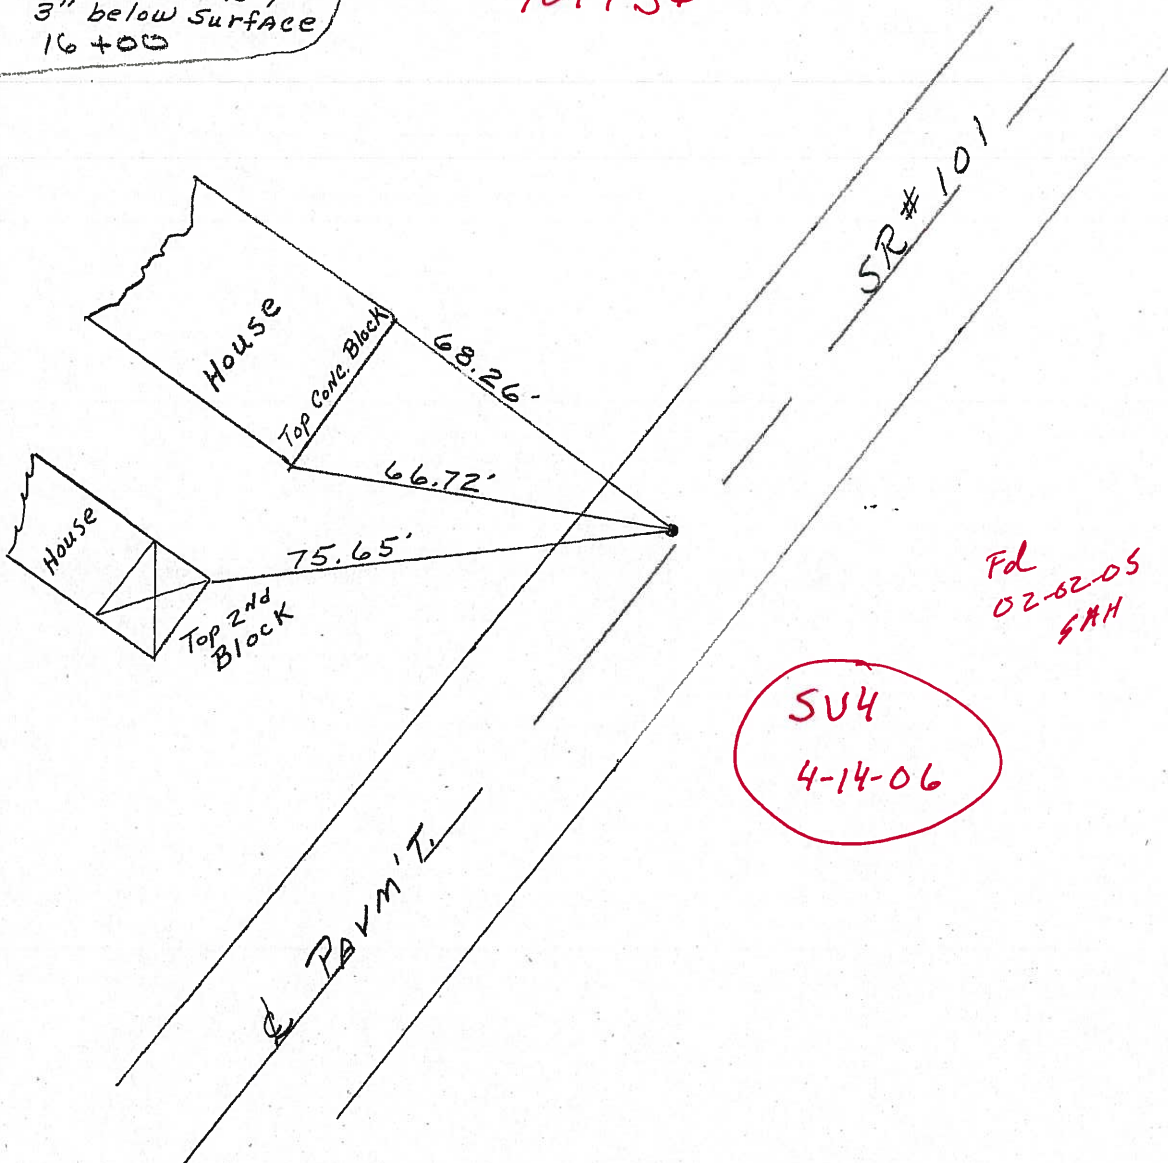

O.D.O.T. DISTRICT 2 SURVEY OFFICE

PERSONNEL

REFERENCE NO. 5

SHEET 6 OF 26

NOTES CHENEY

H.C. RIPPLE

R.C. BARBOUR

Geyman

DATE 7-9-92

WEATHER SUNNY

TEMP. 60°

ROUTE SR#101

COUNTY SENECA

TOWNSHIP CLINTON

SECTION 20

T2 N R 15 E

TYPE MONUMENT P.K. SHANK


ON SURFACE - BELOW yes

LEFT - ℄ PAV'T. - RIGHT 1'


10.3 TO RT. EDGE PAVEMENT

S.L.M. 101+69

SET P.K./washer
9-30-92

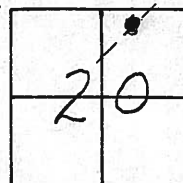


Record: 3/4/70
Iron pin on ℄ R/W
3" below surface
16+00

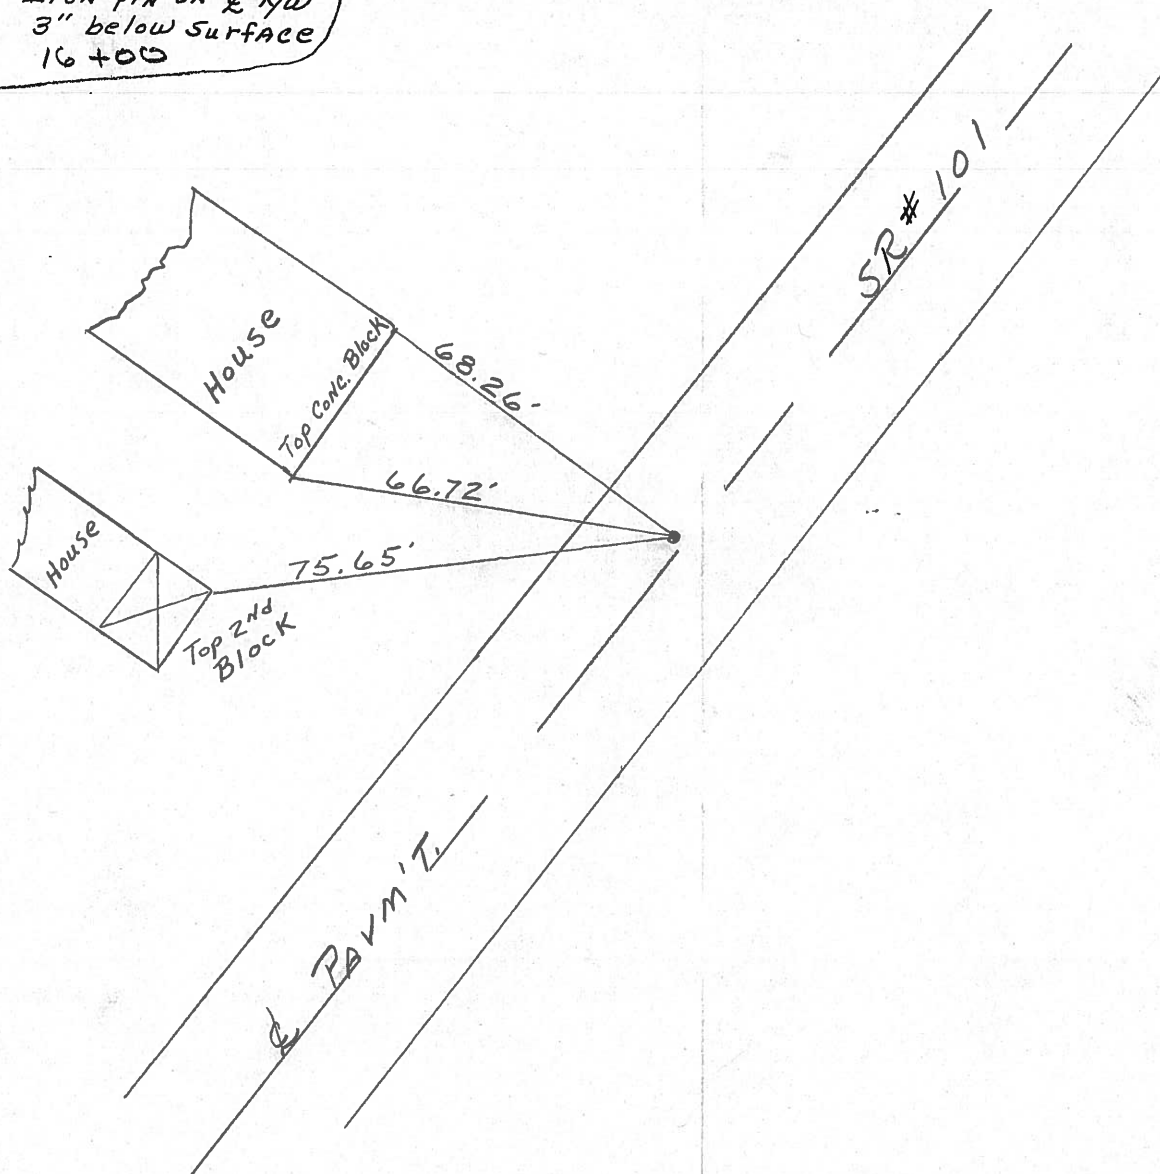

PERSONNEL TITLE PERSONNEL TITLE
 Cronin _____
 Ruppel _____
 Geyman _____
 Anderson _____

COUNTY Seneca DATE 3/4/70
 S. R. #101 (T.C.H. #271) WEATHER _____
 SEC. I-K-O-J TEMP _____

DESCRIPTION Ties for Control Points - T. Fin Corp. to Sand Co. Line JOB NO. _____

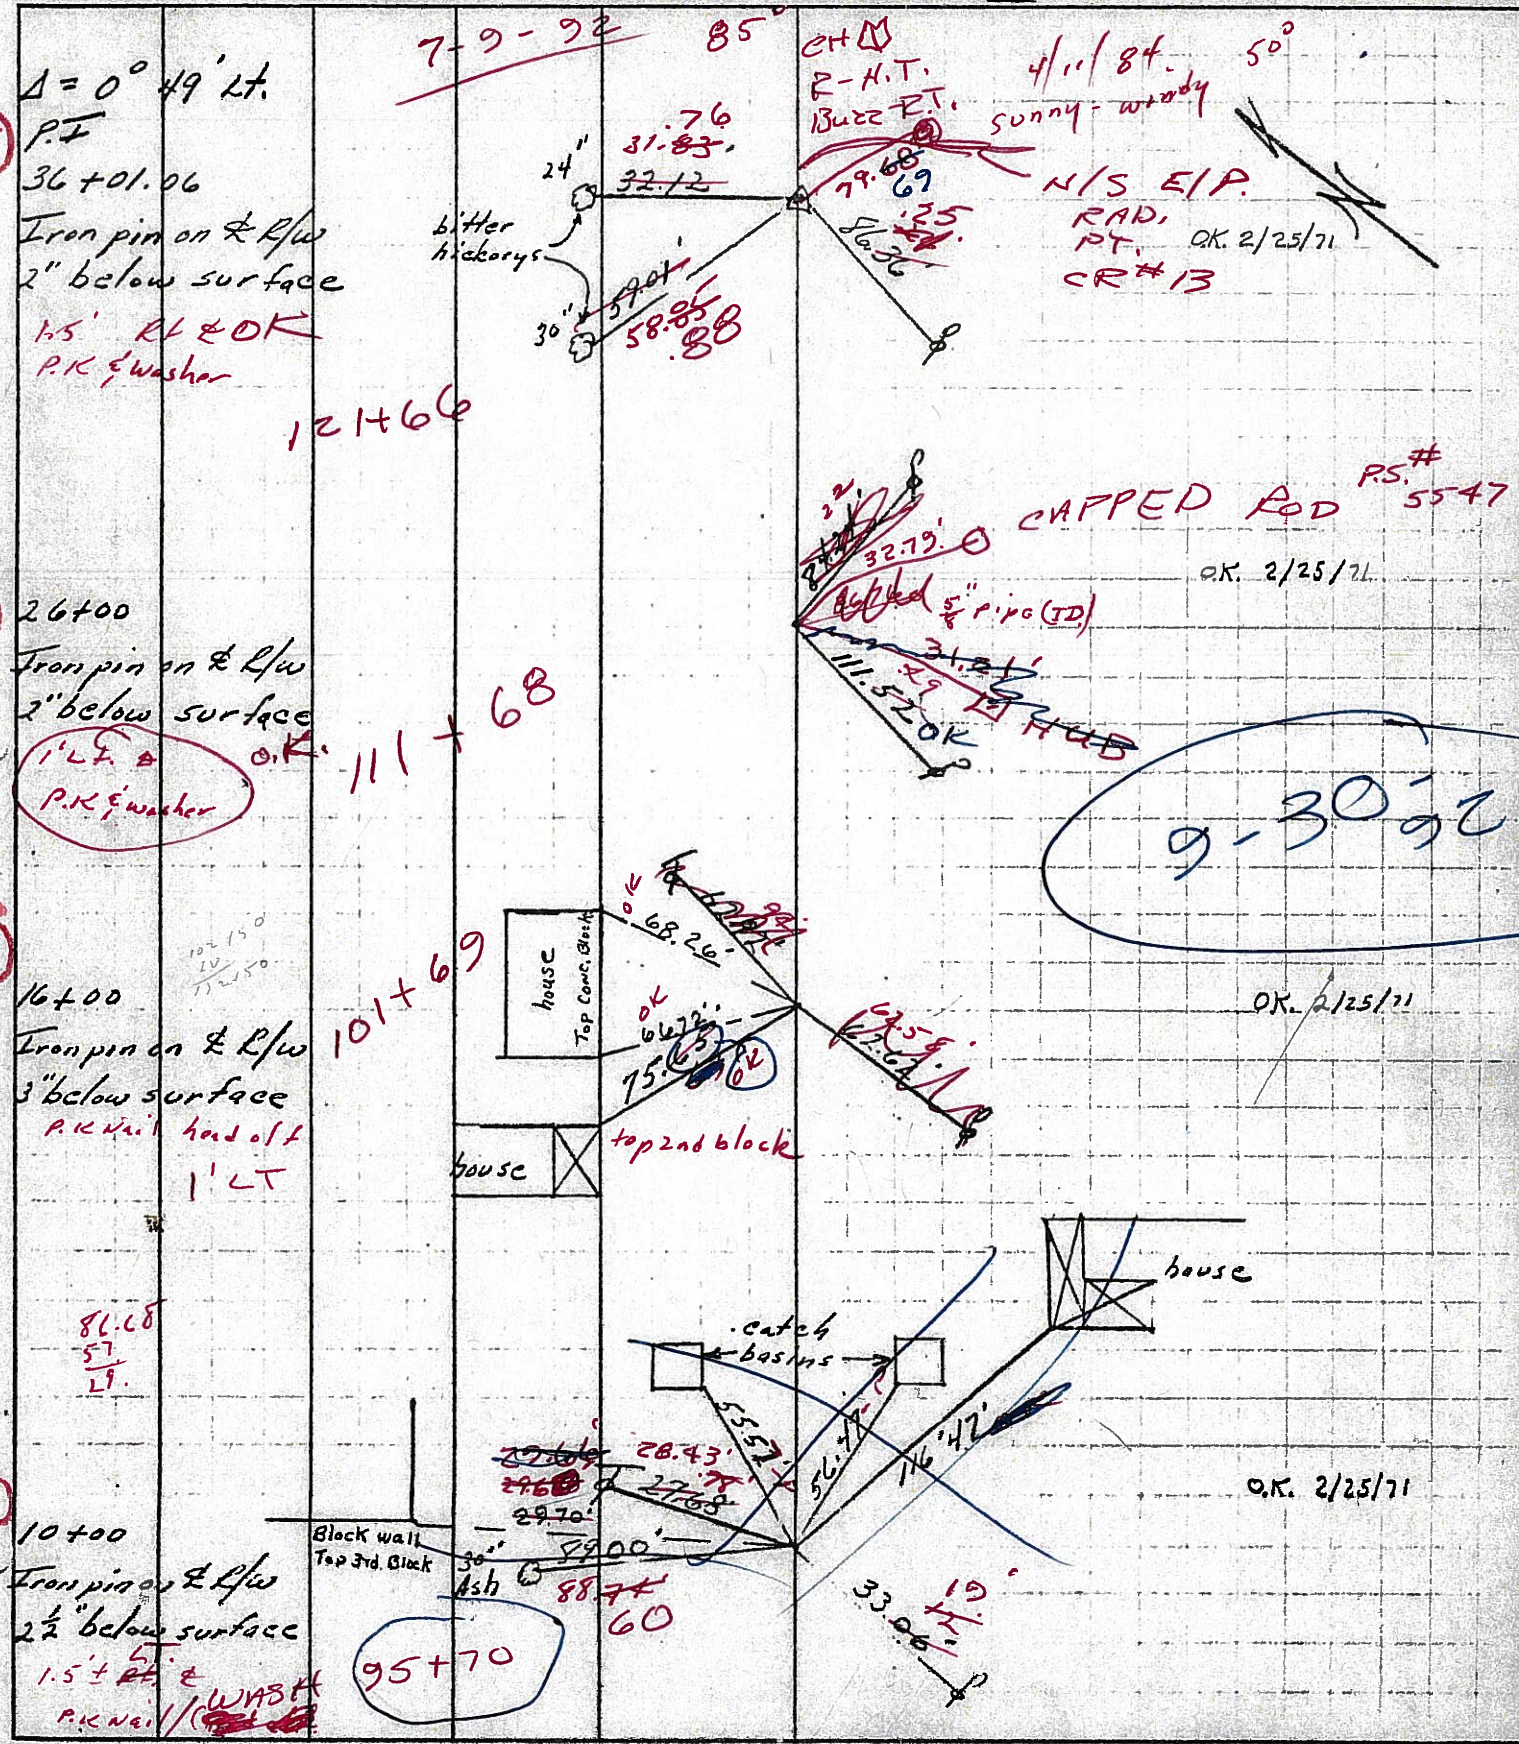



PERSONNEL TITLE PERSONNEL TITLE
 Cronin _____
 Ripple _____
 Geyman _____
 Anderson _____

COUNTY Seneca DATE 3/4/70
 S. R. #101 (I.C.H. #271) WEATHER _____
 SEC. I-K-O-J TEMP. _____

DESCRIPTION Ties for Control Points - Tiffin Corp. to Sand Co. Line JOB NO. _____


LEFT CENTER LINE RIGHT

⑦ $\Delta = 0^\circ 49' \text{ Lt.}$
 P.F. ~~ⓧ~~
 36 + 01.96
 Iron pin on & R/w
 2" below surface

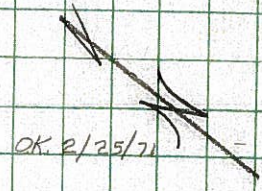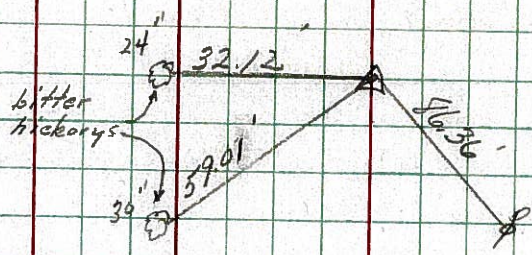


OK 2/25/71

⑥ 26 + 00 ~~ⓧ~~
 Iron pin on & R/w
 2" below surface

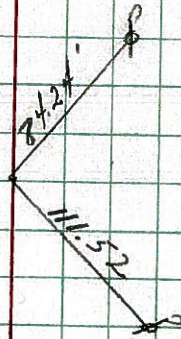


OK 2/25/71

⑤ Nat 00 ~~ⓧ~~
 Iron pin on & R/w
 3" below surface

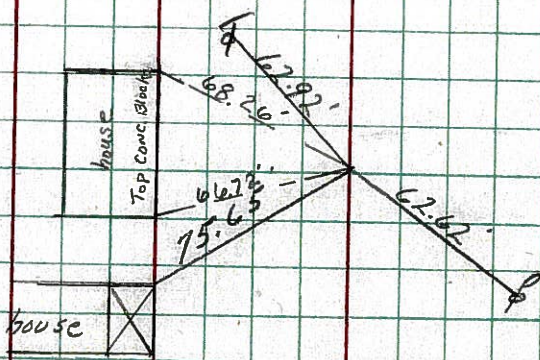

OK 2/25/71


④ 10 + 00 ~~ⓧ~~
 Iron pins on & R/w
 2 1/2" below surface

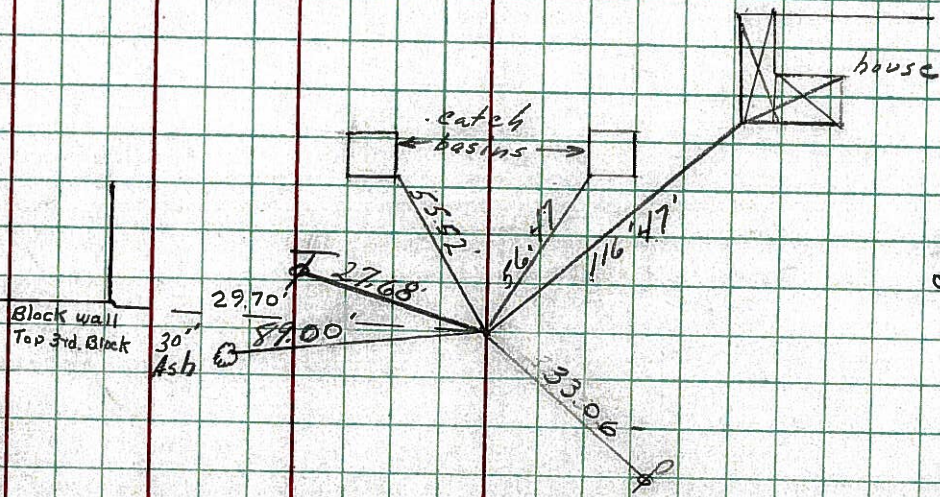

OK 2/25/71

PERSONNEL	TITLE	PERSONNEL	TITLE	COUNTY	DATE	WEATHER	TEMP.
Cronin				Seneca	3/4/70		
Pipple				S. R. #101 (S.H. #271)			
Geyman							
Anderson				SEC. I-K-O-J.			

DESCRIPTION Tics for Control Points - Tiffin Corp. to Sandusky Co. Line JOB NO. _____

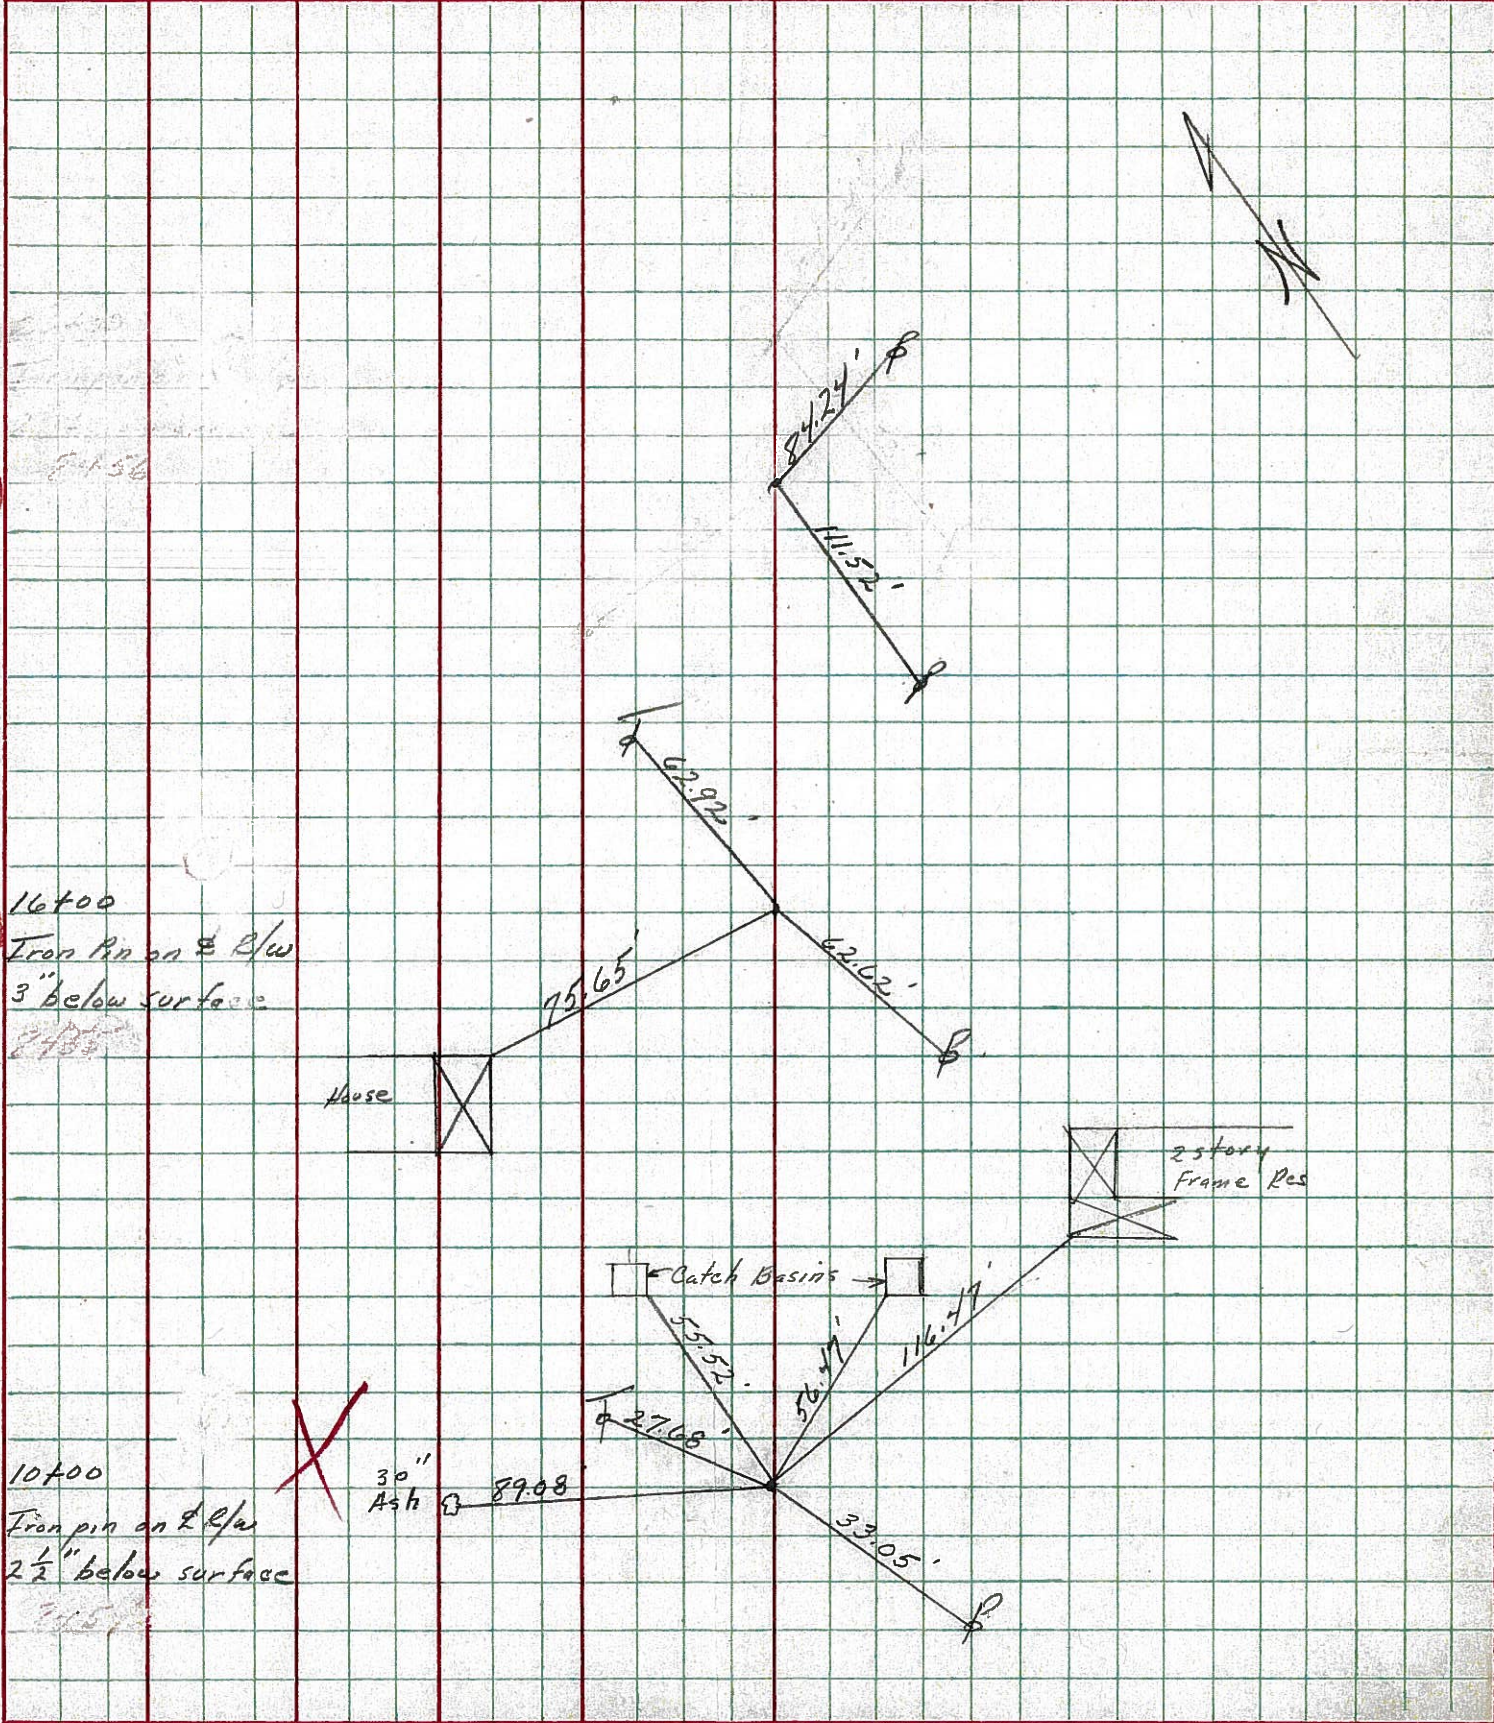

LD-5 (25M-4-59)



PERSONNEL	TITLE	PERSONNEL	TITLE	COUNTY	DATE
Krabill				Seneca	
Kowaleski				S. R. # 101	WEATHER
Geyman				SEC. I-K-O-J	TEMP.

DESCRIPTION S.H. # 271 Tiffin Corp. to Sand. Co. Line

LEFT CENTER LINE RIGHT JOB NO.

2

STA. 0+00
 Iron Pin # 357
 2-3-64

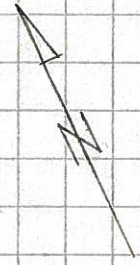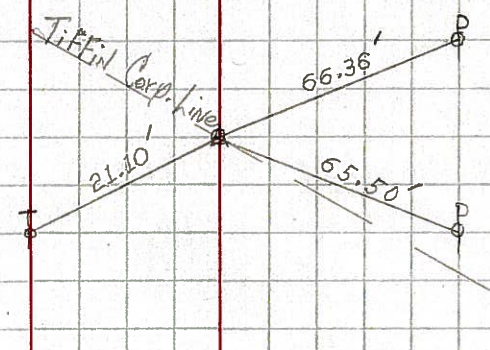


3

STA. 3+53.60
 Iron Pin # 358
 2-3-64

Did Not Find
 No Ties

4

STA. 10+00
 Iron Pin # 359
 2-3-64

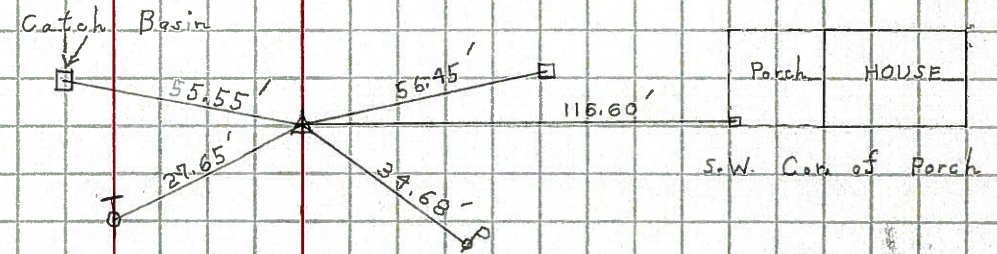

5

STA. 16+00
 Iron Pin # 360
 2-3-64

