


O.D.O.T. DISTRICT 2 SURVEY OFFICE (USE ONLY)


PERSONNEL _____ REFERENCE NO. 25 SHEET 26 OF 27
 NOTES RHOADES DATE 3/23/18 ROUTE SR 101
 H.C. O'DONNELL WEATHER SUNNY COUNTY SENECA
 R.C. SEAMAN TEMP. 33° TOWNSHIP CLINTON
 DWG BY MILLER PID 102817 SECTION 2
 T 2 N R 15 E

TYPE MONUMENT _____ P.K.NAIL
 ON SURFACE - ~~BELOW~~ _____ ON _____
 OFFSET \bar{C} PAVEMENT 1' LT : ~~RT~~
10' TO RT EDGE PAVEMENT

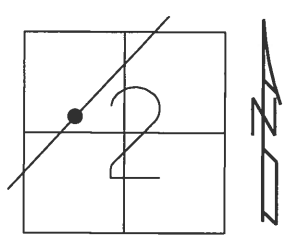

STATION: 283+95.10
 HORZ.DATUM: NAD83 2011 GEOID: 2012A NAVD88
 GRID: NORTHING: 544959.366 EASTING: 1800925.156

RECORD:
 FD. R.R. SPIKE
 11-23-65
 FD P.K.NAIL
 7/21/92, CHENEY
 SET P.K./WASHER
 10-1-92
 FD MAG/WASHER
 REF25
 10-12-16, JFO
 SET MAG/WASHER
 10-9-18, JFO

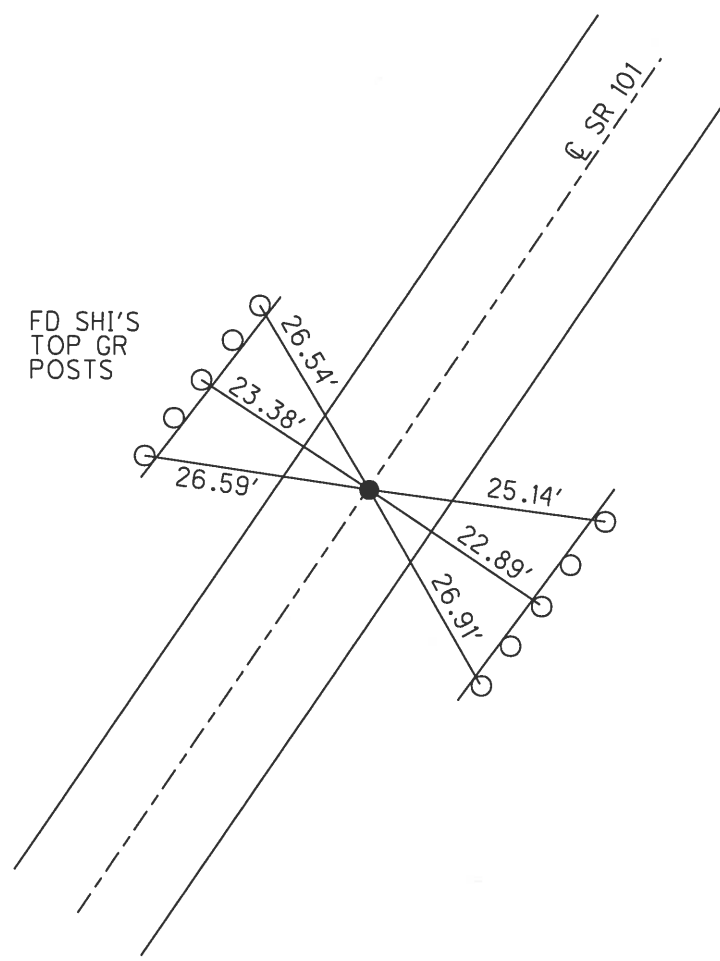


O.D.O.T. DISTRICT 2 SURVEY OFFICE (USE ONLY)


PERSONNEL _____ REFERENCE NO. 25 SHEET 26 OF 27

NOTES CHENEY DATE 7/21/92 ROUTE SR 101
 H.C. RIPPLE WEATHER SUNNY COUNTY SENECA
 R.C. BARBOUR TEMP. 55° TOWNSHIP CLINTON
 _____ SECTION 2
 _____ T 2 N R 15 E

TYPE MONUMENT P.K.NAIL
 ON SURFACE - ~~BELOW~~ ON
 LEFT - ☉ PAV'T - RIGHT ON
10' TO RT EDGE PAVEMENT
 S.L.M. 284+01
 GRID: NORTHING: _____ EASTING: _____

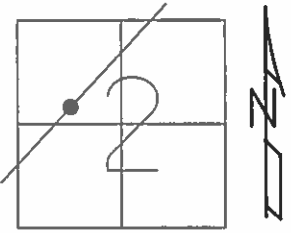

RECORD:
 FD. R.R. SPIKE
 ON SURFACE
 11/23/65
 SET P.K./WASHER
 10/1/92

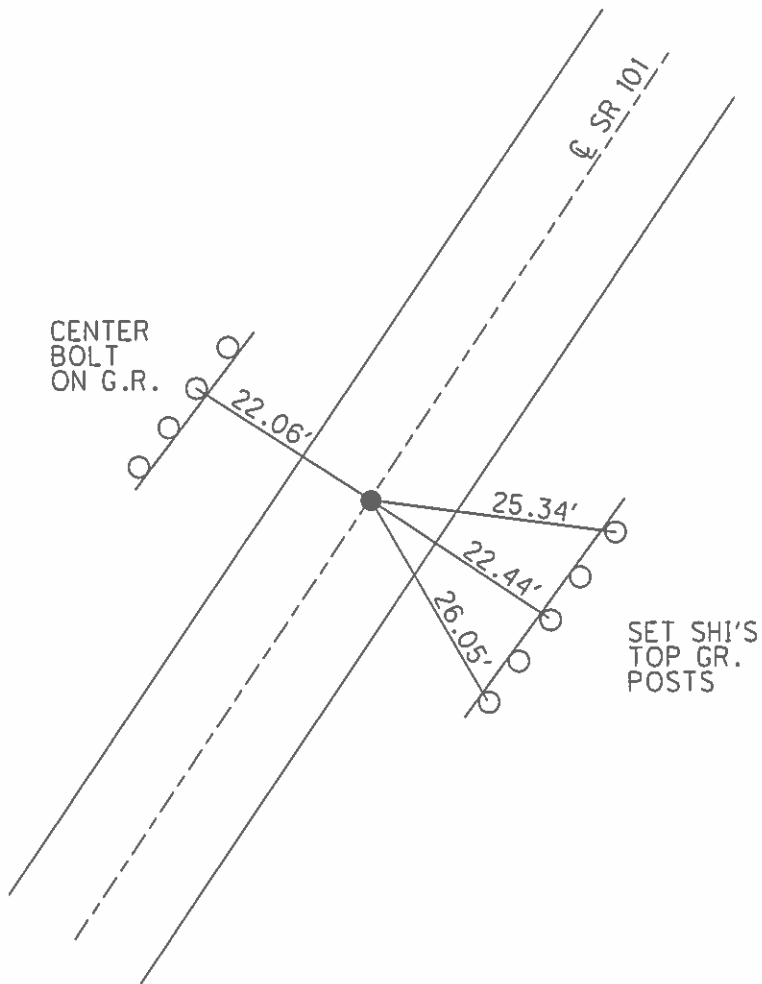

O.D.O.T. DISTRICT 2 SURVEY OFFICE

PERSONNEL

REFERENCE NO. 25

SHEET 25 OF 26

NOTES Cheney

H.C. RIPPLE

R.C. BARBOUR

DATE 7-21-92

WEATHER SUNNY

TEMP. 55°

ROUTE SR #101

COUNTY Seneca

TOWNSHIP CLINTON

SECTION _____

T2 N R 15 E

TYPE MONUMENT P.K.?

set PREWASHER
10-01-92

ON SURFACE - ~~BELOW~~ yes

~~LEFT - & PAV'T. - RIGHT~~ yes

10' TO RT. EDGE PAVEMENT

S.L.M. 284+01

3	2
10	11




Record: 11-23-65
Fd. RR. spk. on surface

283+91

Stn # 11

SR. 101

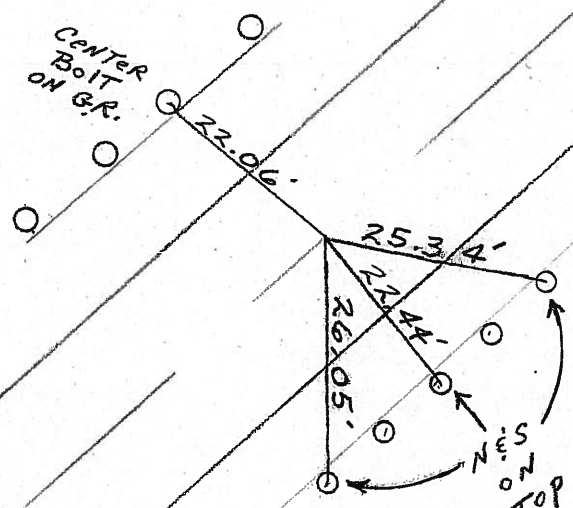

Fd
02-04-05
SAH

E PAVM'T.

O.D.O.T. DISTRICT 2 SURVEY OFFICE

26

PERSONNEL

REFERENCE NO. 25

SHEET 25 OF 26

NOTES Cheney

H.C. RIPPLE

R.C. BARBOUR

DATE 7-21-92

WEATHER SUNNY

TEMP. 55°

ROUTE SR #101

COUNTY SENECA

TOWNSHIP CLINTON

SECTION _____

T 2 N R 15 E

TYPE MONUMENT P.K.? *11-23-65 R set PK washer 10-01-92*

ON SURFACE - BELOW yes

LEFT - & PAV'T. - RIGHT yes


10' TO RT. EDGE PAVEMENT

S.L.M. 284+01

3	2
10	11



Record: 11-23-65
Fd. RR. spk. on surface

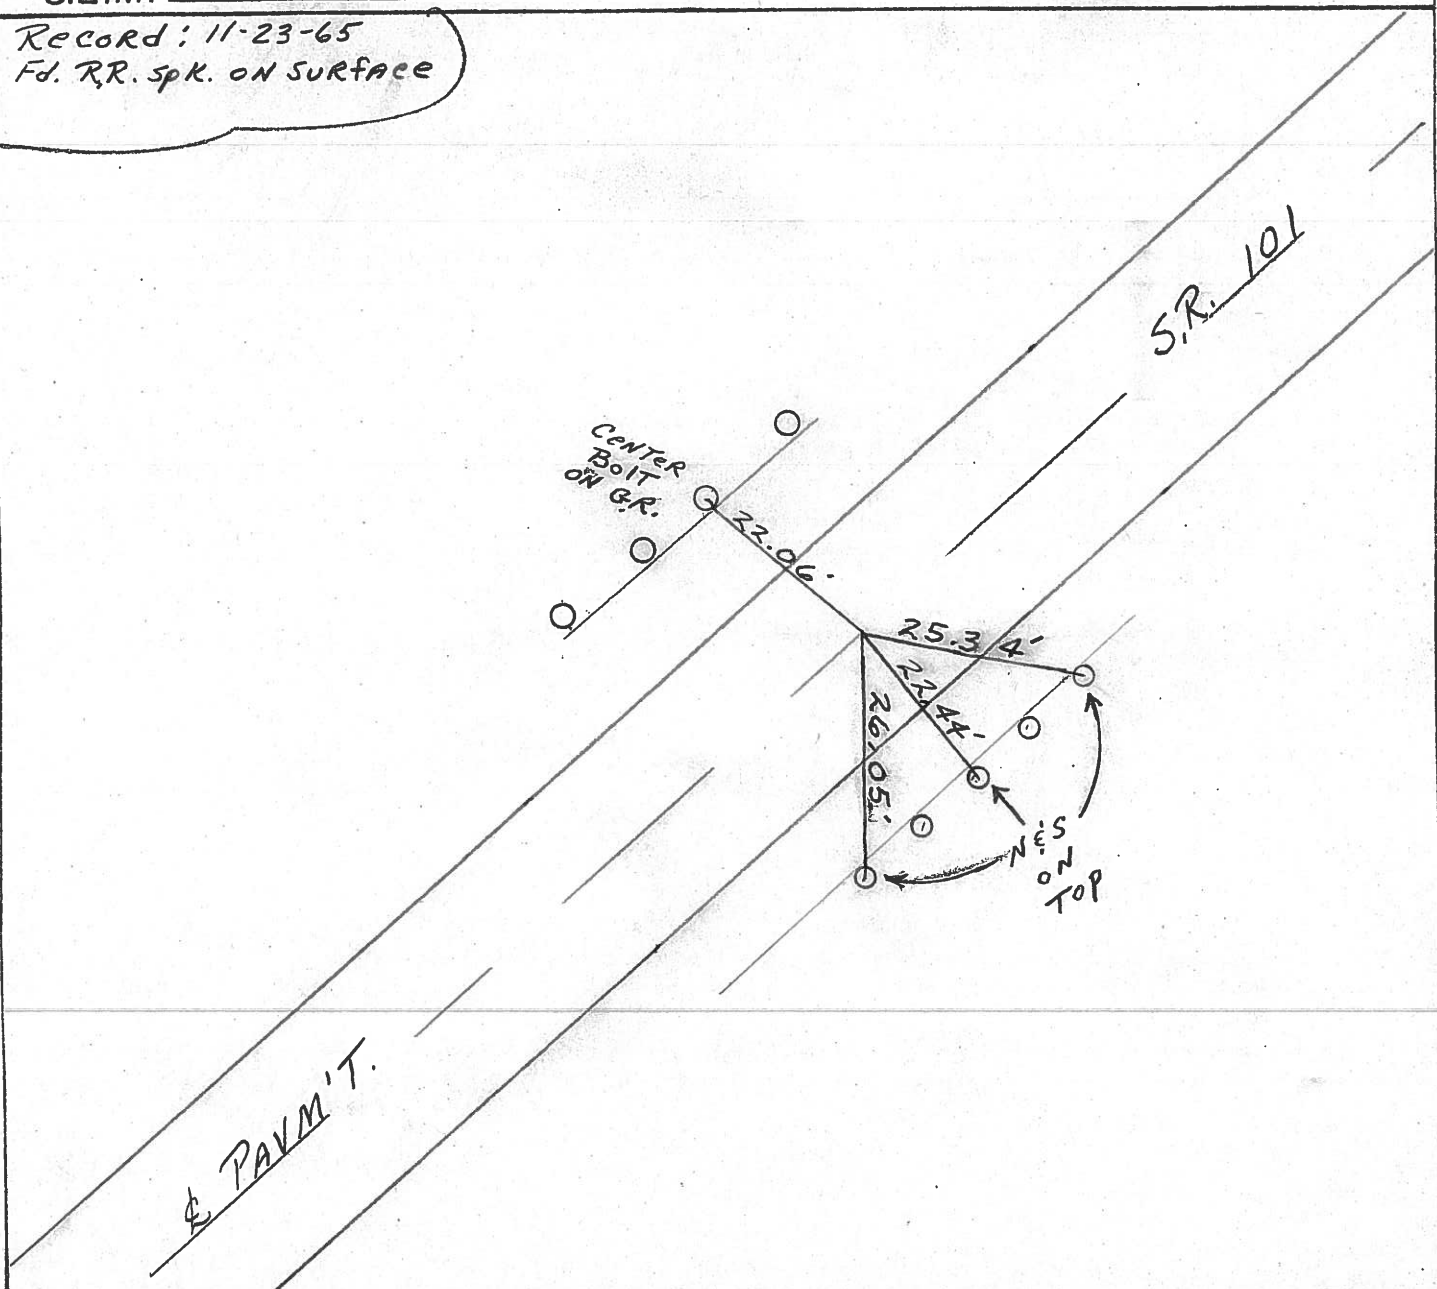

PERSONNEL TITLE PERSONNEL TITLE

COUNTY Seneca DATE 11-23-63

S. R. # 101 WEATHER


SEC. TEMP. 50°

DESCRIPTION LEFT CENTER LINE RIGHT JOB NO.

29

Ties Good 2/21/69
Sta. 115+72
R.R. spt. on & R/W
1/2" below surface


381
8477

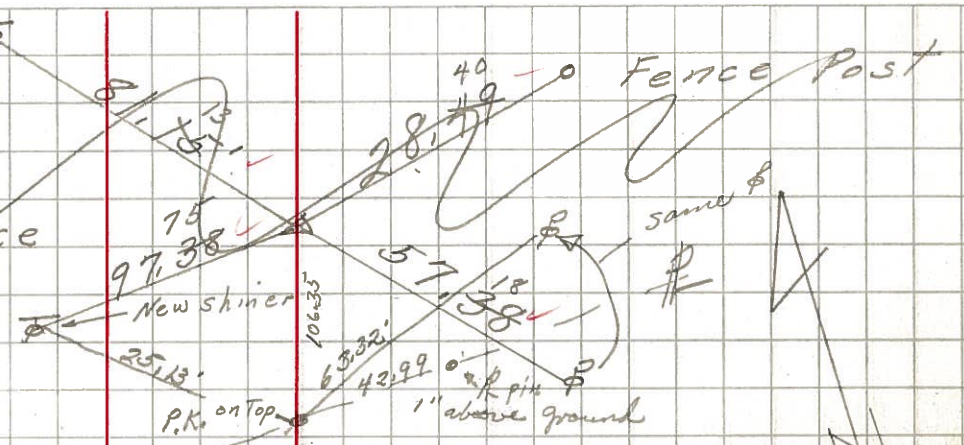

28

Ties Good 2/24/69
Sta. 191+00
R.R. spt. on & R/W
1/2" below surface


380 8476

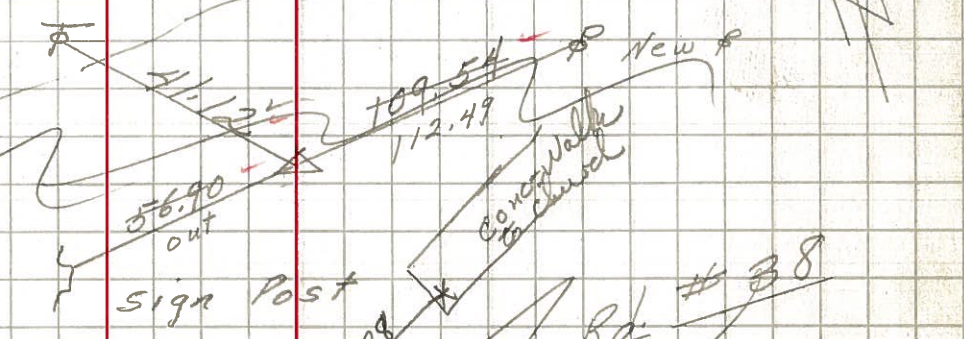

27

Ties Good - 2/24/69
Sta. 77+00
P.K. R.R. spt. on & R/W
1" & 2" below surface


8475 379

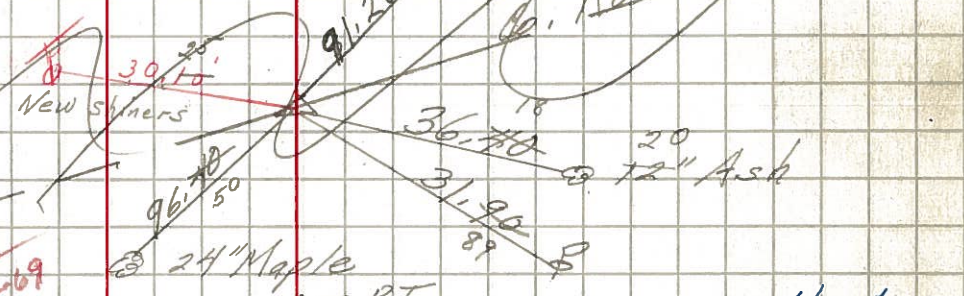

8935
7792
1723
766
717

Found
Ties Good 2/24/69
Sta. 49+35.6
R.R. spt. on & R/W
on surface
2' R & P.T.


8474 378

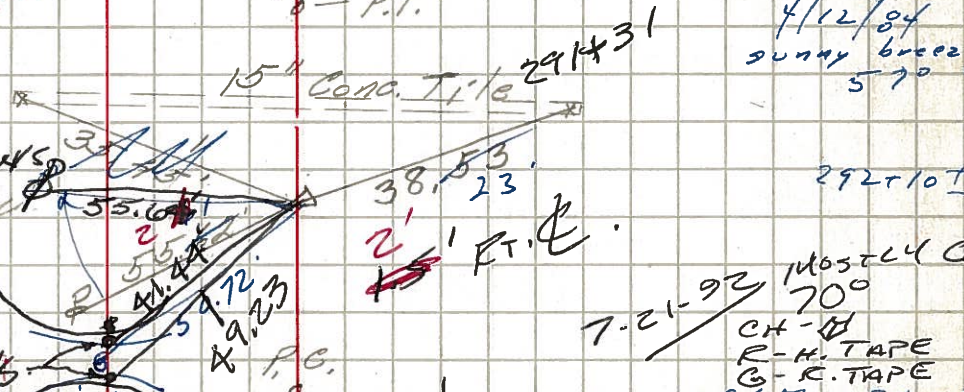

25

Found
Found R.R. spt.
on surface

8473

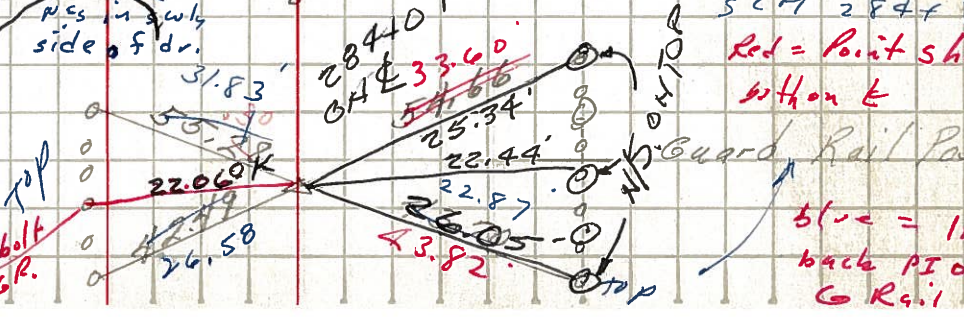

4/12/84
sunny breezy
57°
291+31
292+10
Mostly Cloud
700
CH & R-H TAPE
G-R TAPE
SCM 284 x 84
Red = Point shown
within &
Blue = 190 on
back PI on
G Rail