

O.D.O.T. DISTRICT 2 SURVEY OFFICE (USE ONLY)

PERSONNEL _____

REFERENCE NO. 27

SHEET 1 OF 46

NOTES HOMAN

DATE 6-30-09

ROUTE SR 101

H.C. HOMAN

WEATHER SUNNY

COUNTY SENECA

R.C. ROUSOS

TEMP. 65°F

TOWNSHIP PLEASENT

SECTION 35

DWG BY MAHLER

PID 100787

T 3 N R 15 E

TYPE MONUMENT MAG/WASHER

ON SURFACE - ~~BELOW~~ ON

OFFSET \varnothing PAVEMENT ON LT : RT

- TO - EDGE PAVEMENT


STATION: 318+73.57

HORZ.DATUM: NAD83 2011


GEOID: NAVD88-2012A

GRID: NORTHING: 547506.005

EASTING: 1803294.084

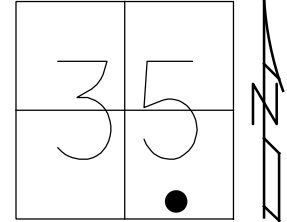

RECORD: P.O.T.
 SLM. 77+00
 SET P.K./ WASHER
 8-27-90
 FD P.K./WASHER
 2-4-05, SAH
 SET P.K./WASHER
 6/30/09, DCH
 SET MAG/WASHER
 NEWREF27
 10-05-09, DCH
 FD MAG/WASHER
 REF27
 6-14-16, JFO
 10-12-16, JFO
 9-18-17, JFO

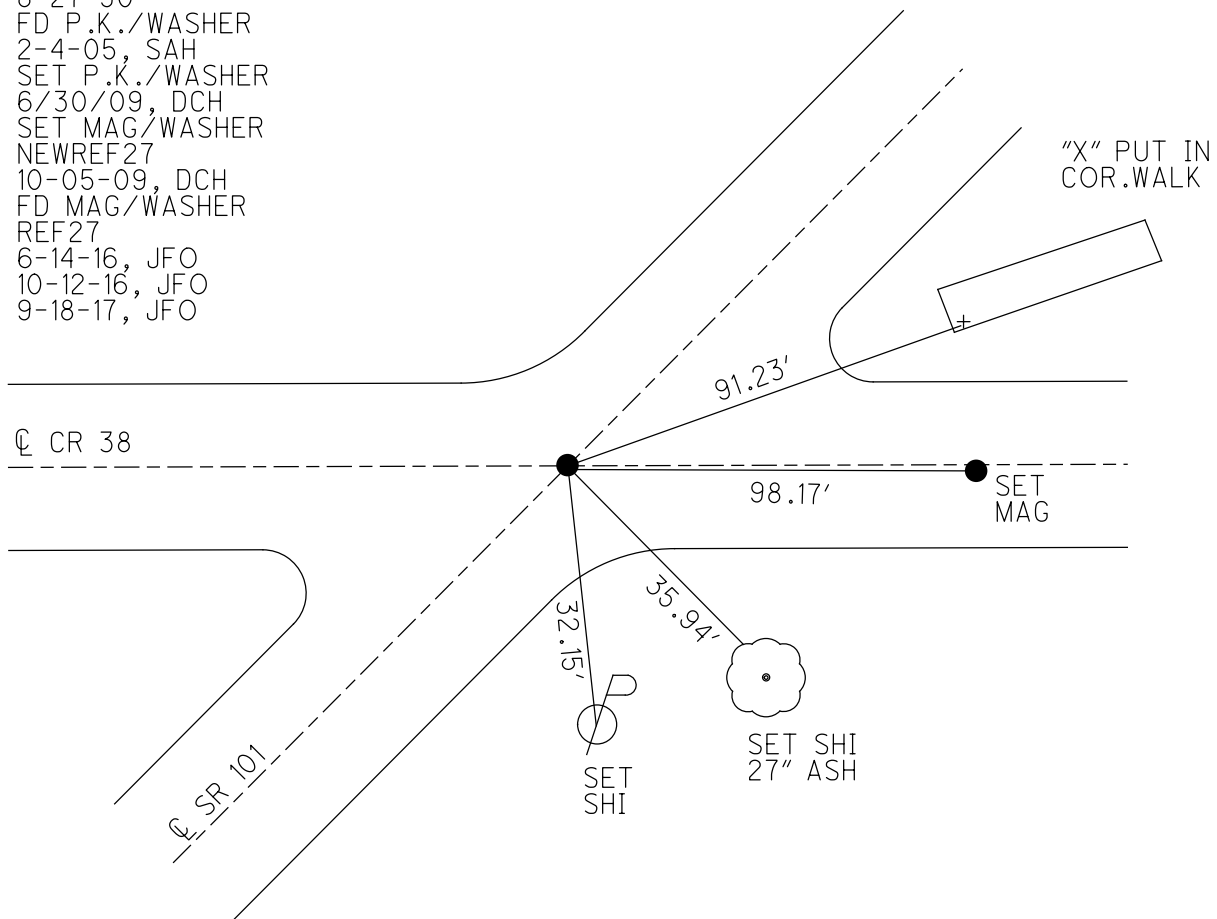

O.D.O.T. DISTRICT 2 SURVEY OFFICE (USE ONLY)

PERSONNEL _____ REFERENCE NO. 27 SHEET 1 OF 46

NOTES HOMAN _____ DATE 6/30/09 ROUTE SR 101

H.C. HOMAN _____ WEATHER SUNNY COUNTY SENECA

R.C. ROUSOS _____ TEMP. 65° TOWNSHIP PLEASANT

SECTION 35

T 3 N R 15 E

TYPE MONUMENT _____ MAG/WASHER _____


ON SURFACE - ~~BELOW~~ _____ ON _____

LEFT - ☉ PAV'T - RIGHT _____ ON _____


_____ TO _____ EDGE PAVEMENT

S.L.M. 318+73.57

GRID: NORTHING: 547506.027 EASTING: 1803294.082

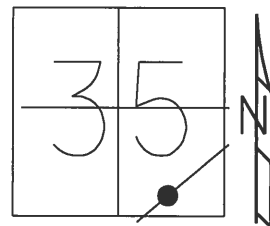


RECORD: P.O.T.
 SLM. 77+00
 SET P.K./ WASHER
 8-27-90
 FD P.K./WASHER
 2-4-05, SAH
 SET P.K./WASHER
 6/30/9, DCH
 SET MAG/WASHER
 10-05-09, DCH
 FD MAG/WASHER
 REF27
 6-14-16, JFO
 FD MAG/WASHER
 REF27
 10-12-16, JFO
 9-18-17, JFO

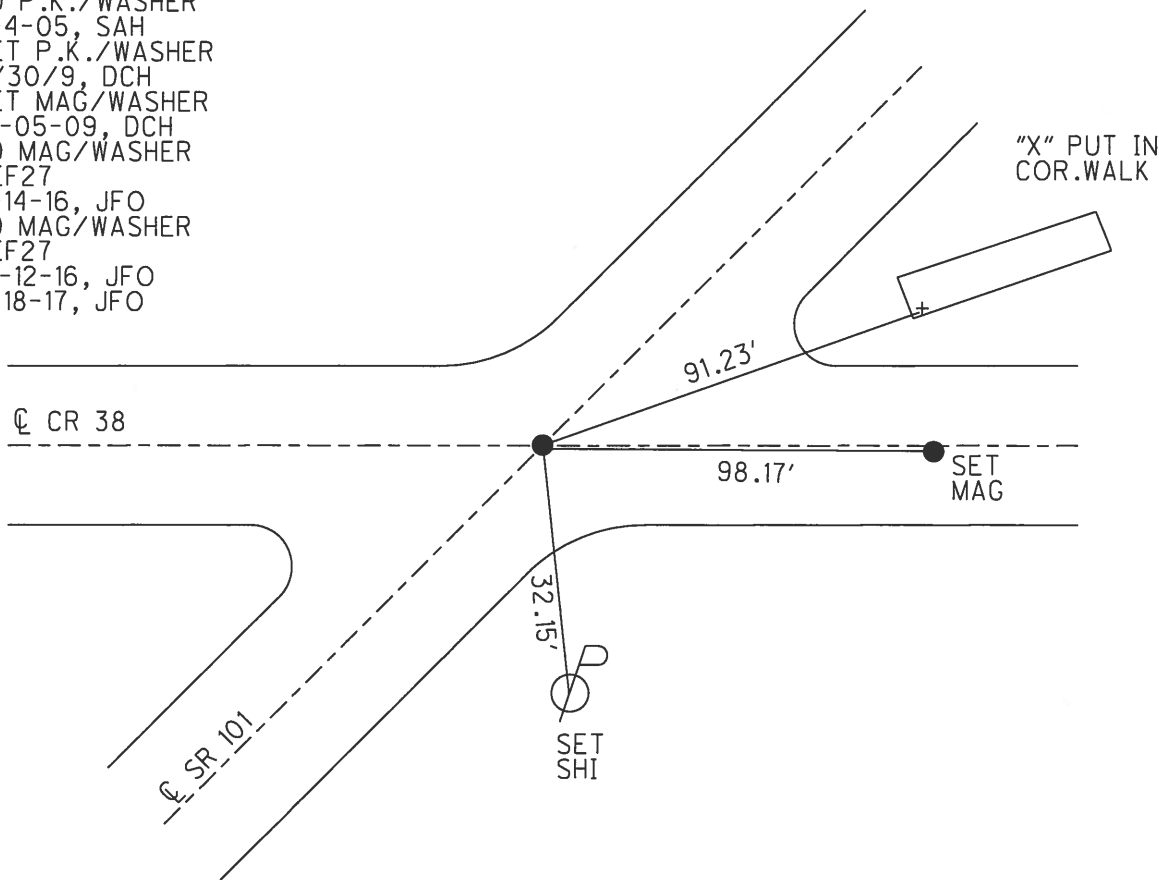

O.D.O.T. DISTRICT 2 SURVEY OFFICE (USE ONLY)


PERSONNEL _____ REFERENCE NO. 27 SHEET 1 OF 46
 NOTES HOMAN DATE 6/30/09 ROUTE SR 101
 H.C. HOMAN WEATHER SUNNY COUNTY SENECA
 R.C. ROUSOS TEMP. 65° TOWNSHIP PLEASANT
 _____ SECTION 35
 _____ T 3 N R 15 E

TYPE MONUMENT _____ P.K./WASHER _____
 ON SURFACE - ~~BELOW~~ _____ ON _____
 LEFT - \odot PAV'T - RIGHT _____ ON _____
 _____ TO - _____ EDGE PAVEMENT
 S.L.M. 318+73

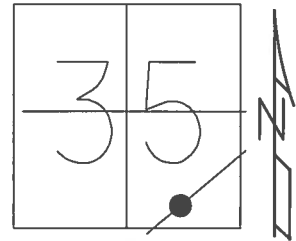

GRID: NORTHING: 547506.005 EASTING: 1803294.084


RECORD: P.O.T.
 SLM. 77+00
 SET P.K./ WASHER
 8/27/90
 FD P.K./WASHER
 2/4/05, SAH
 SET MAG/WASHER
 10-05-09, DH
 FD MAG/WASHER
 REF27
 6/14/16, JFO
 UNCOVERED
 9/18/17, JFO

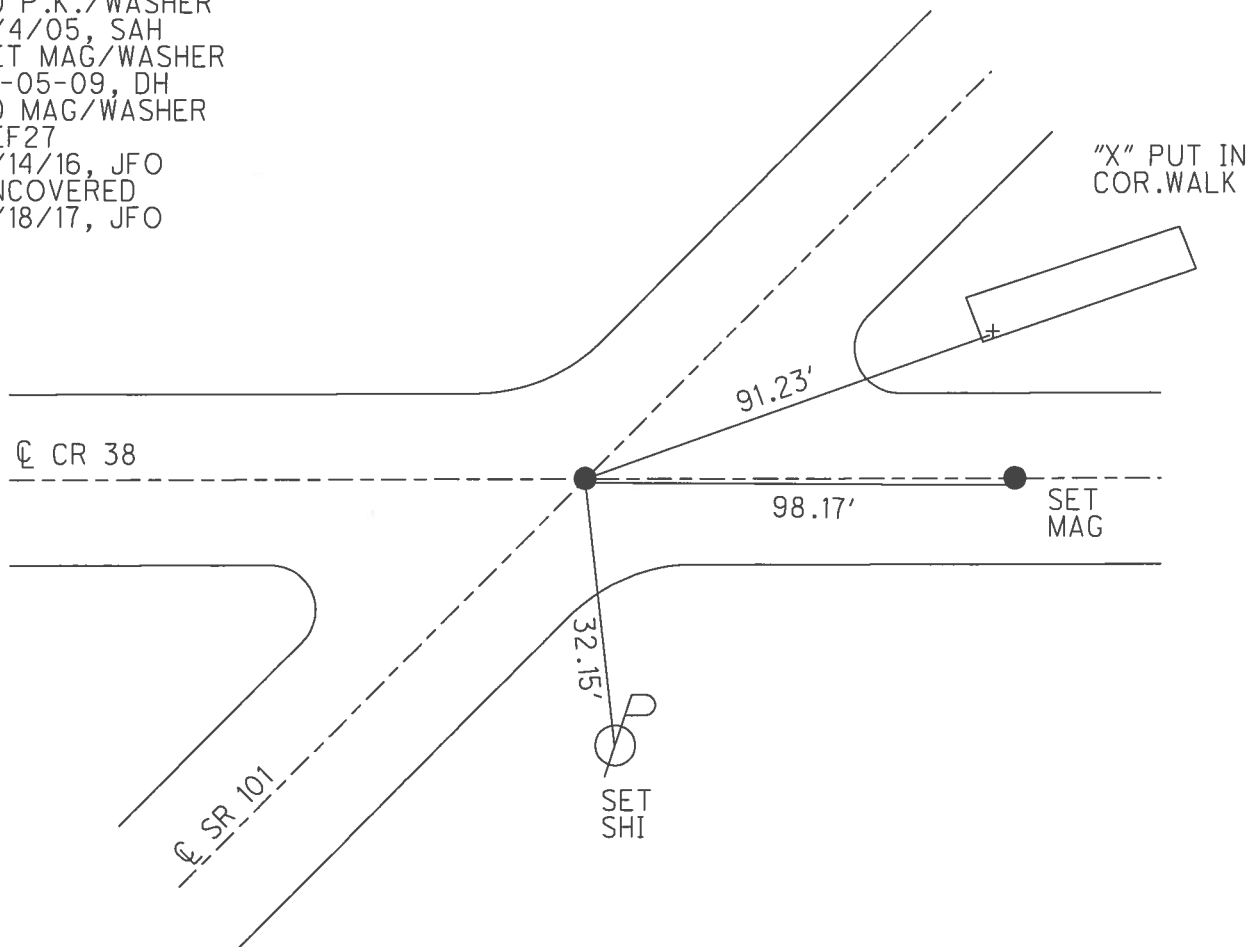

O.D.O.T. DISTRICT 2 SURVEY OFFICE (USE ONLY)


PERSONNEL _____ REFERENCE NO. 27 SHEET 1 OF 46
 NOTES HOMAN DATE 6/30/09 ROUTE SR 101
 H.C. HOMAN WEATHER SUNNY COUNTY SENECA
 R.C. ROUSOS TEMP. 65° TOWNSHIP PLEASANT
 _____ SECTION 35
 _____ T 3 N R 15 E

TYPE MONUMENT _____ P.K./WASHER
 ON SURFACE - ~~BELOW~~ _____ ON
 LEFT - ☉ PAV'T - RIGHT _____ ON
 - _____ TO - _____ EDGE PAVEMENT
 S.L.M. 318+73

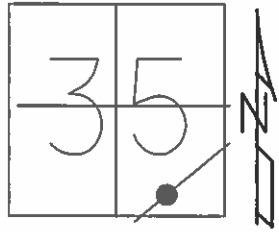

GRID: NORTHING: 547506.058 EASTING: 1803294.020

RECORD: P.O.T.
 SLM. 77+00
 SET P.K./ WASHER
 8/27/90
 FD P.K./WASHER
 2/4/05, SAH
 SET MAG/WASHER
 10-05-09, DH

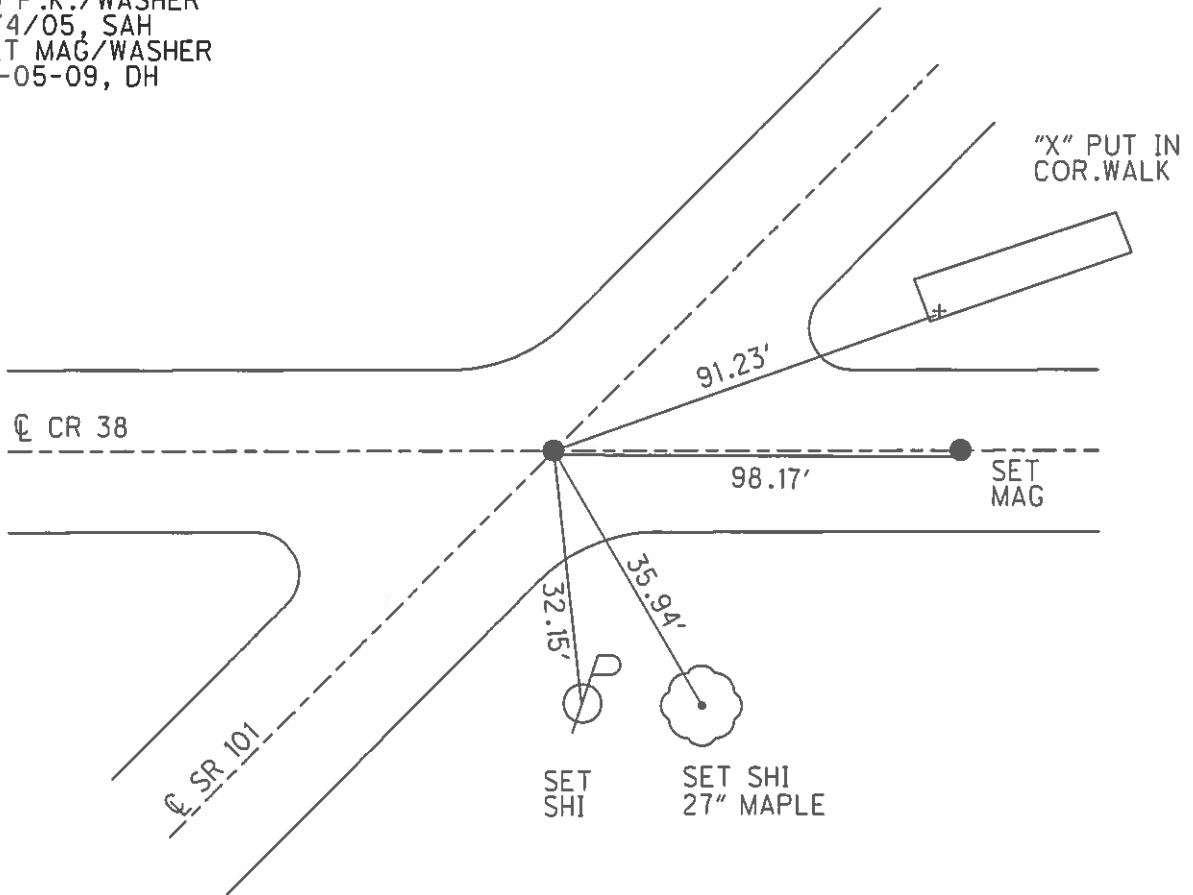

O.D.O.T. DISTRICT 2 SURVEY OFFICE

PERSONNEL

REFERENCE NO. 27

SHEET 1 OF 41

NOTES Ripple

H.C. Barbour

R.C. _____

DATE 8/27/90

WEATHER SUNNY

TEMP. 73°

ROUTE SR#101

COUNTY Seneca

TOWNSHIP Pleasant

SECTION 35

T 3 N R 15 E


TYPE MONUMENT set P.K. & washer

ON SURFACE - BELOW P.K. nail

LEFT - ☉ PAW'T. - RIGHT ☉

TO _____ EDGE PAVEMENT

S.L.M. _____

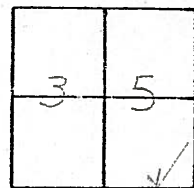

P.O.T. 77+00

318+73

CONC. WALK
"X" CUT IN CORNER
WALK

Co. Rd. # 387

91.25'

36.05'

31.98'

Fd
02-04-05
SAH

24" Ash

This Ref. out - No. 4
Check old Ref
TIES ON FILE

SR# 101

O.D.O.T. DISTRICT 2 SURVEY OFFICE

PERSONNEL _____

REFERENCE NO. 27

SHEET 1 OF 41

NOTES Ripple

H.C. BARBOUR

DATE 8/27/90

ROUTE SR#101

R.C. _____

WEATHER SUNNY

COUNTY SENECA

TEMP. 73°

TOWNSHIP Pleasant

SECTION 35

T 3 N R 15 E


TYPE MONUMENT set P.K. & washer

ON SURFACE - BELOW P.K. nail


LEFT- & PAV'T. - RIGHT &

TO _____ EDGE PAVEMENT

S.L.M. _____

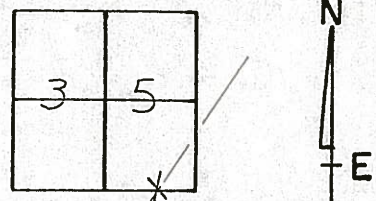

P.O.T. 77+00

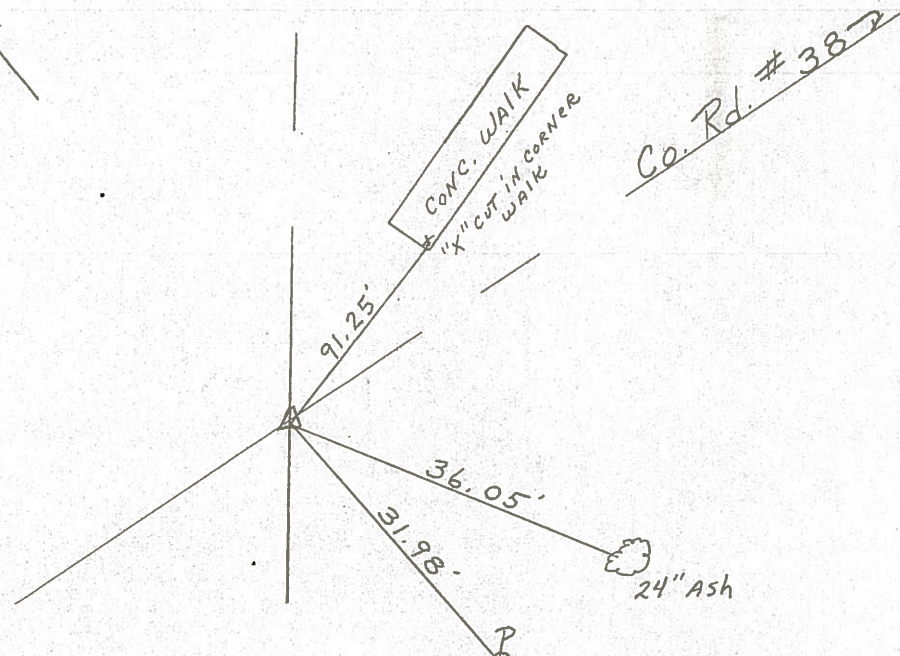

This Ref. on-Next
check OLD Ref
TIES ON FILE

SR#101

County Seneca S.R. 101

Date 6-26-79

Township Pleasant

Weather Fair

Section 35

Temp. 65°


T³N, R¹⁵E

Personnel Schneider

Mosser

Barbour

(27)

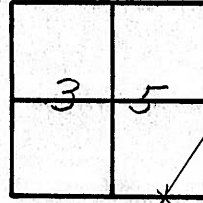

~~#36~~




P.O.T.

77+00

P.K. on ϕ Rlw

Reset P.K. Nail

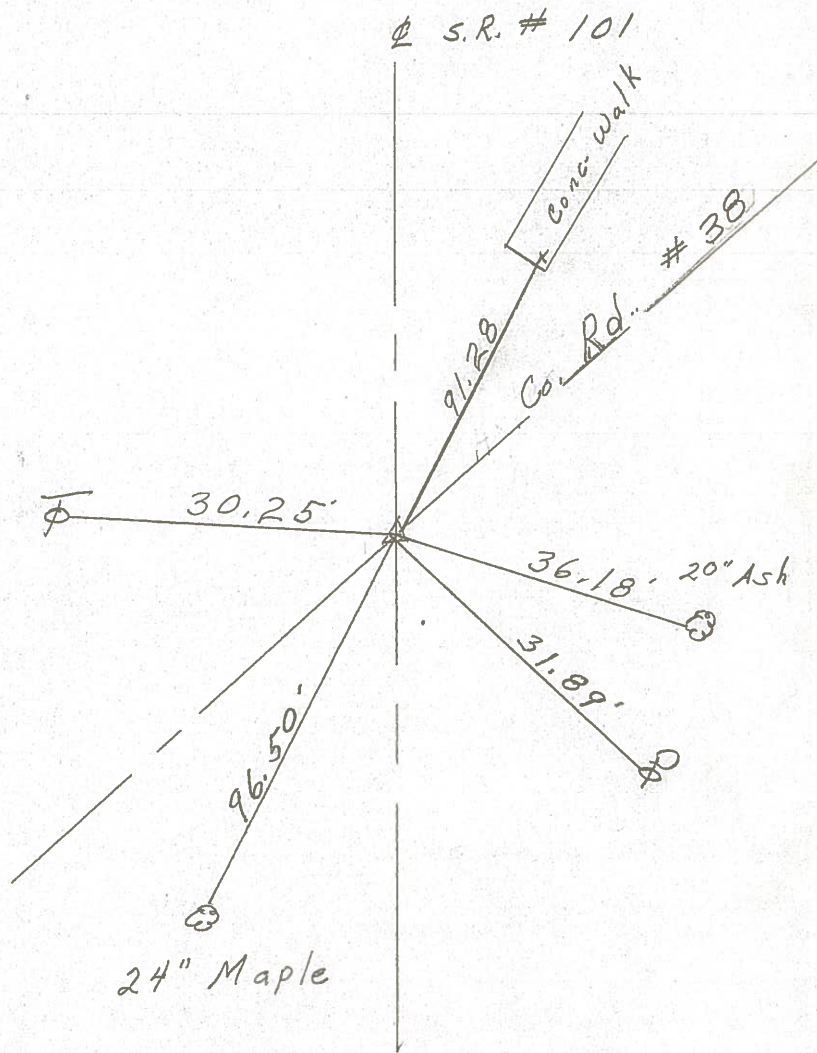

PERSONNEL TITLE PERSONNEL TITLE

COUNTY Seneca DATE _____

F Krabill
Kowaleski
Geyman
Bruggman

S. R. 101 WEATHER _____


SEC. _____ TEMP. _____

DESCRIPTION LEFT CENTER LINE RIGHT JOB NO.

49+35.6 #378

RR spike

2-10-64

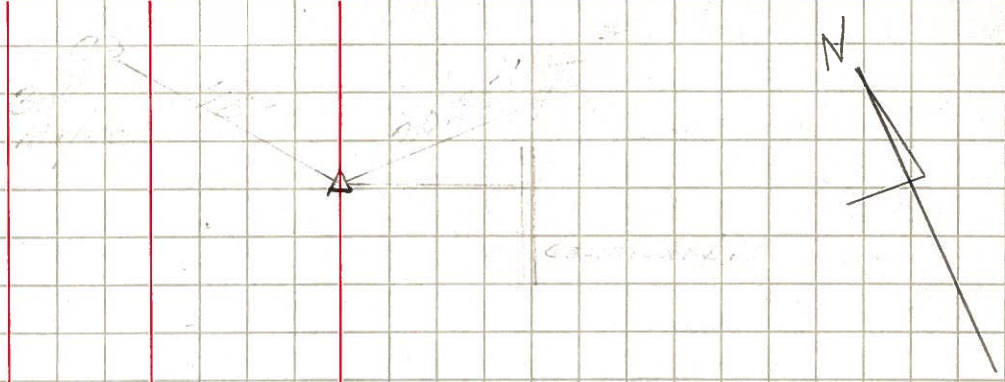


27

77+00 #379

P. Nail

2-10-64

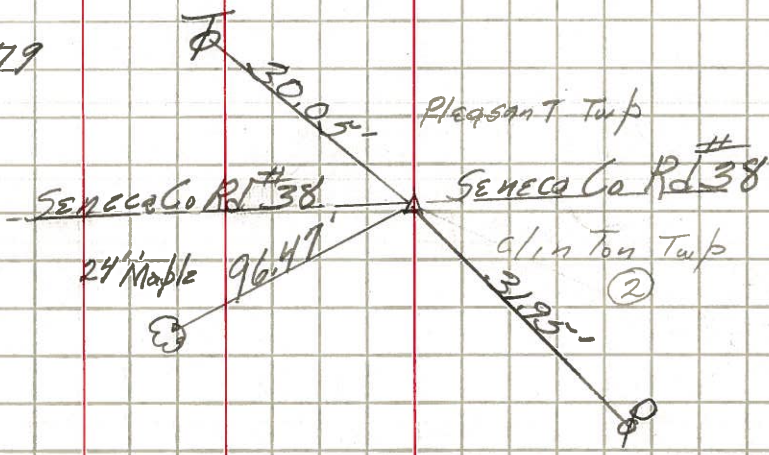


28

101+00 #380

RR spike

2-10-64

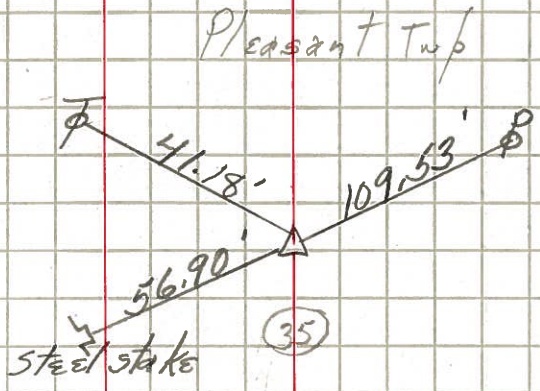

29

115+72

P. Nail

2-10-64

