


O.D.O.T. DISTRICT 2 SURVEY OFFICE (USE ONLY)

PERSONNEL _____ REFERENCE NO. 29 A SHEET 4 OF 46
 NOTES HOMAN DATE 7-14-09 ROUTE SR 101
 H.C. HOMAN WEATHER SUNNY COUNTY SENECA
 R.C. ROUSOS TEMP. 75°F TOWNSHIP PLEASENT
 DWG BY MAHLER PID 100787 SECTION 36
 T 3 N R 15 E


TYPE MONUMENT MAG NAIL
 ON SURFACE - ~~BELOW~~ ON
 OFFSET ☉ PAVEMENT ON LT : RT
- TO - EDGE PAVEMENT
 STATION: 356+29

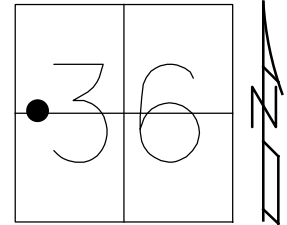

HORZ. DATUM: NAD83 2009 GEOID: NAVD88-2009
 GRID: NORTHING: 550274.265 EASTING: 1805831.787

RECORD:
 D.N.F.
 2/4/05, SAH
 FD P.K./WASHER
 REFB29
 7/14/09, DCH
 SET MAG/WASHER
 NEWREFB29
 10/8/09, DCH
 D.N.F.
 6/14/16, JFO


DIST.
 29-29A = 8.70'
 29-29B = 106.40'
 29A-29B = 97.70'

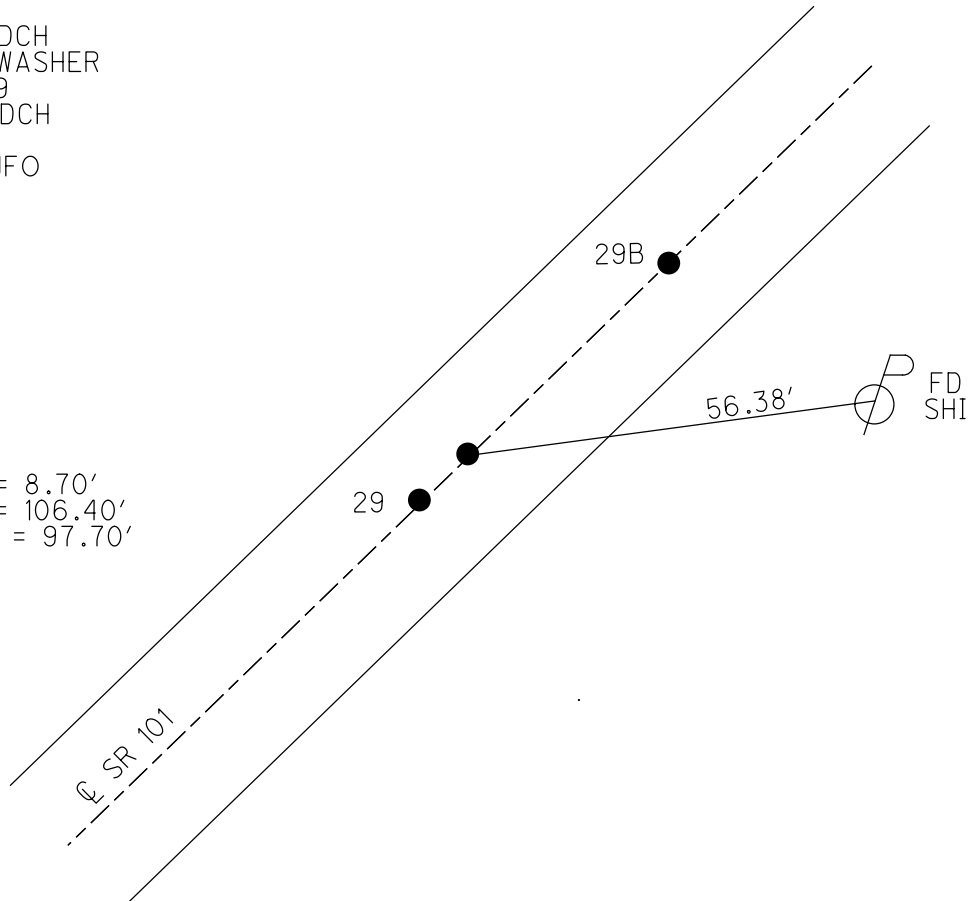

O.D.O.T. DISTRICT 2 SURVEY OFFICE (USE ONLY)


PERSONNEL _____ REFERENCE NO. 29 A SHEET 4 OF 46
 NOTES HOMAN DATE 7/14/09 ROUTE SR 101
 H.C. HOMAN WEATHER SUNNY COUNTY SENECA
 R.C. ROUSOS TEMP. 75° TOWNSHIP PLEASANT
 _____ SECTION 36
 _____ T 3 N R 15 E

TYPE MONUMENT P.K.NAIL
~~ON SURFACE~~ - BELOW 1 1/2"
 LEFT - ☉ PAV'T - RIGHT ON
- TO - EDGE PAVEMENT
 S.L.M. 356+29
 GRID: NORTHING: - EASTING: -

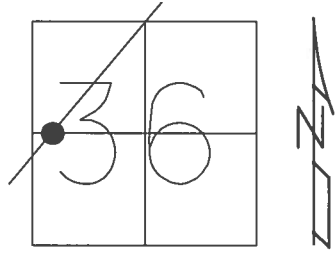

RECORD:
 D.N.F.
 2/4/05, SAH
 6/14/16, JFO


DIST.
 29-29A = 8.70'
 29-29B = 106.40'
 29A-29B = 97.70'

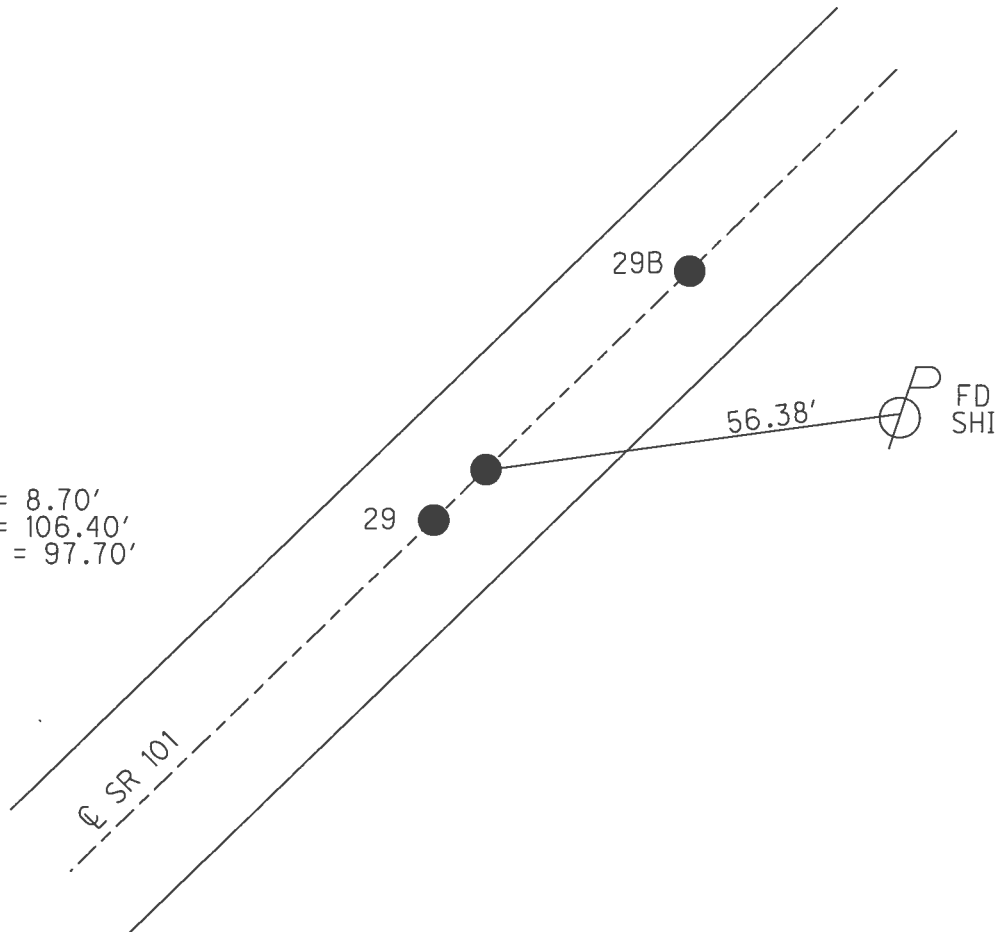

O.D.O.T. DISTRICT 2 SURVEY OFFICE (USE ONLY)

PERSONNEL _____ REFERENCE NO. 29 A SHEET 4 OF 46
 NOTES HOMAN DATE 7/14/09 ROUTE SR 101
 H.C. HOMAN WEATHER SUNNY COUNTY SENECA
 R.C. ROUSOS TEMP. 75° TOWNSHIP PLEASANT
 _____ SECTION 36
 _____ T 3 N R 15 E

TYPE MONUMENT _____ P.K.NAIL
~~ON SURFACE~~ - BELOW 1 1/2"
 LEFT - ☉ PAV'T - RIGHT ON
 _____ TO _____ EDGE PAVEMENT
 S.L.M. 356+29

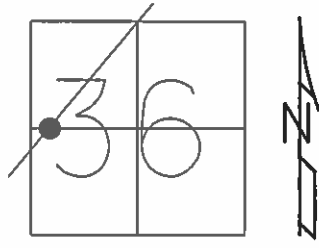

GRID: NORTHING: 550346.277 EASTING: 1805897.737

RECORD:
 SET MAG & WASHER
 10-08-09, DH

DIST.
 29-29A = 8.70'
 29-29B = 106.40'
 29A-29B = 97.70'

