

O.D.O.T. DISTRICT 2 SURVEY OFFICE (USE ONLY)

PERSONNEL

REFERENCE NO. 29 B

SHEET 5 OF 46

NOTES HOMAN

DATE 7-14-09

ROUTE SR 101

H.C. HOMAN

WEATHER SUNNY

COUNTY SENECA

R.C. ROUSOS

TEMP. 75°F

TOWNSHIP PLEASENT

SECTION 36

DWG BY MAHLER

PID 100787

T 3 N R 15 E

TYPE MONUMENT P.K./WASHER

~~ON SURFACE~~ - BELOW 1.5"

OFFSET \odot PAVEMENT ON LT : RT

- TO - EDGE PAVEMENT


STATION: 357+26

HORZ.DATUM: NAD83 2011

GEOID: NAVD88-2012A


GRID: NORTHING: 550346.303

EASTING: 1805897.713

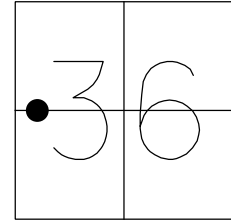

RECORD:
 FD MAG NAIL
 REFA29
 7/14/09, DCH
 SET MAG/WASHER
 NEWREFA29
 10-08-09, DCH
 FD MAG/WASHER
 REFA29
 6/14/16
 9/18/17, JFO


DIST.
 29-29A = 8.70'
 29-29B = 106.40'
 29A-29B = 97.70'

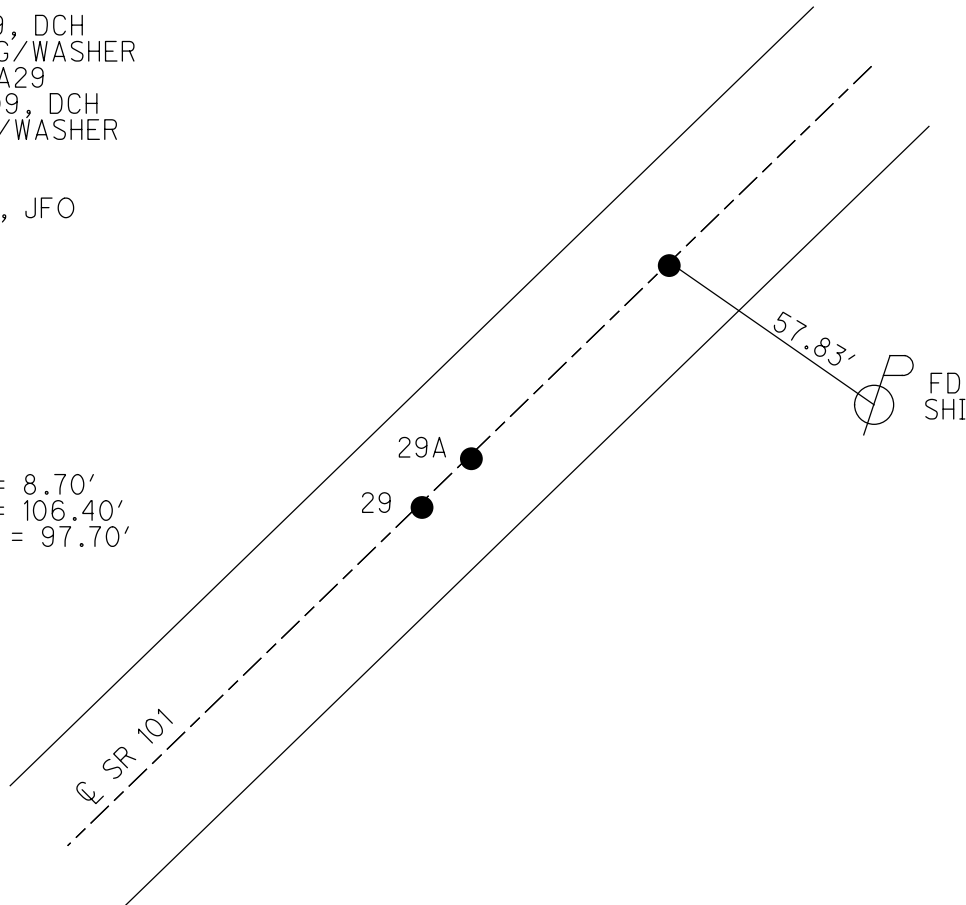

O.D.O.T. DISTRICT 2 SURVEY OFFICE (USE ONLY)

PERSONNEL _____ REFERENCE NO. 29 B SHEET 5 OF 46
 NOTES HOMAN DATE 7/14/09 ROUTE SR 101
 H.C. HOMAN WEATHER SUNNY COUNTY SENECA
 R.C. ROUSOS TEMP. 75° TOWNSHIP PLEASENT
 SECTION 36
 T 3 N R 15 E


TYPE MONUMENT MAG NAIL
~~ON SURFACE~~ - BELOW 1 1/2"
 LEFT - ☉ PAV'T - RIGHT ON
- TO - EDGE PAVEMENT
 S.L.M. 357+26

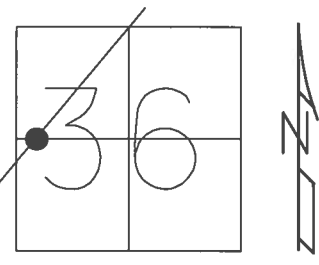

GRID: NORTHING: 550346.303 EASTING: 1805897.713

RECORD:
 SET MAG & WASHER
 10-08-09, DH
 FD MAG/WASHER
 REFA29
 6/14/16, JFO
 UNCOVERED
 9/18/17, JFO


DIST.
 29-29A = 8.70'
 29-29B = 106.40'
 29A-29B = 97.70'

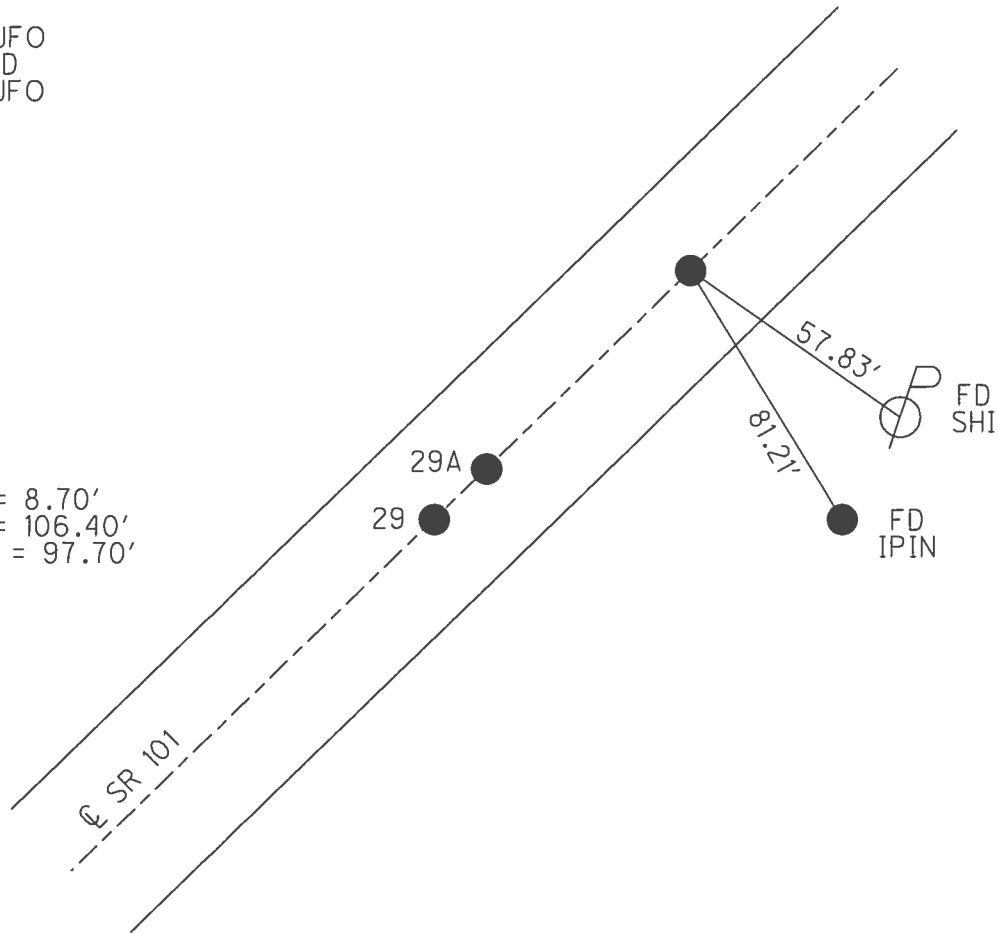

O.D.O.T. DISTRICT 2 SURVEY OFFICE (USE ONLY)

PERSONNEL _____ REFERENCE NO. 29 B SHEET 5 OF 46
 NOTES HOMAN DATE 7/14/09 ROUTE SR 101
 H.C. HOMAN WEATHER SUNNY COUNTY SENECA
 R.C. ROUSOS TEMP. 75° TOWNSHIP PLEASANT
 _____ SECTION 36
 _____ T 3 N R 15 E


TYPE MONUMENT MAG NAIL
~~ON SURFACE~~ - BELOW 1 1/2"
 LEFT - ☉ PAV'T - RIGHT ON
- TO - EDGE PAVEMENT
 S.L.M. 357+26

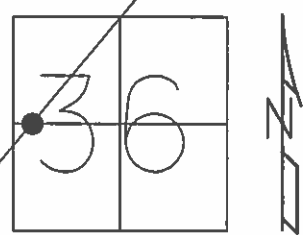

GRID: NORTHING: 550346.277 EASTING: 1805897.737

RECORD:
 D.N.F.
 2/4/05, SAH
 SET MAG & WASHER
 10-08-09, DH

DIST.
 29-29A = 8.70'
 29-29B = 106.40'
 29A-29B = 97.70'

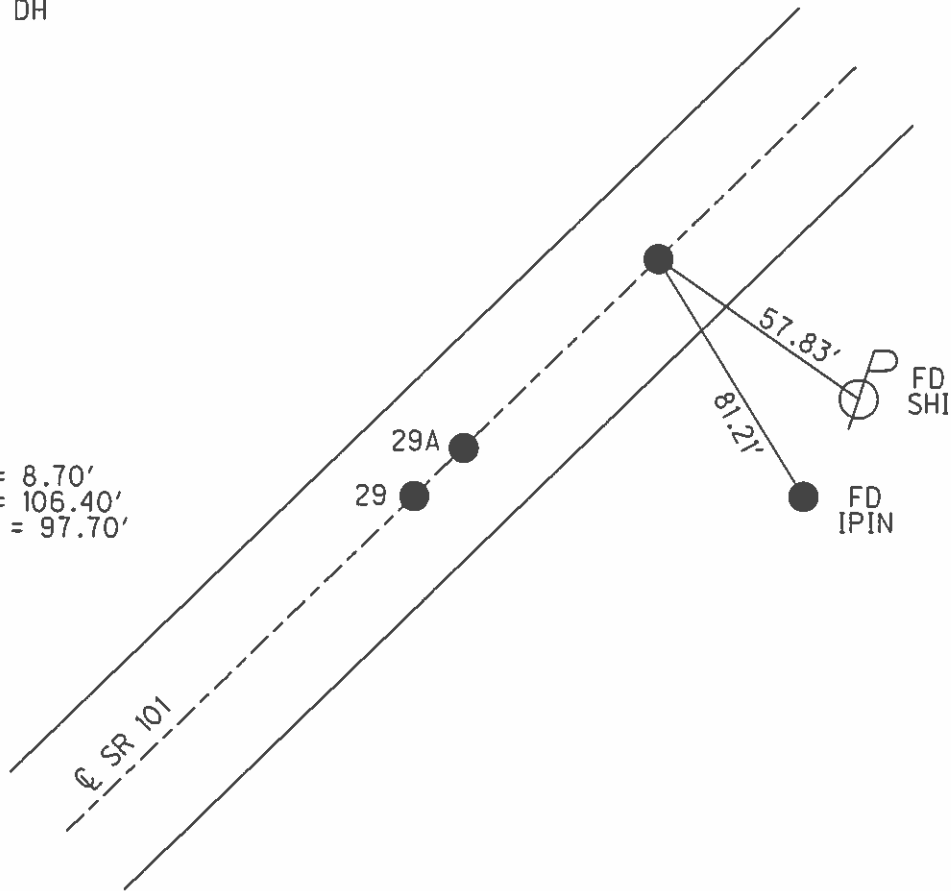

O.D.O.T. DISTRICT 2 SURVEY OFFICE

PERSONNEL _____

REFERENCE NO. 29

SHEET 3 OF 41

NOTES Ripple

H.C. Barbour

DATE 8/27/90

ROUTE S.R.# 101

R.C. _____

WEATHER SUNNY

COUNTY Seneca

TEMP. 73°

TOWNSHIP Pleasant

SECTION 36


T. 3 N. R. 15 E.

TYPE MONUMENT set P.K. & washer
 ON SURFACE - BELOW PK. nail at top R.R. spike

LEFT - & PAV'T. - RIGHT &
 TO _____ EDGE PAVEMENT


S.L.M. _____

29-B

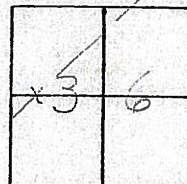

A 356+20

B DNF

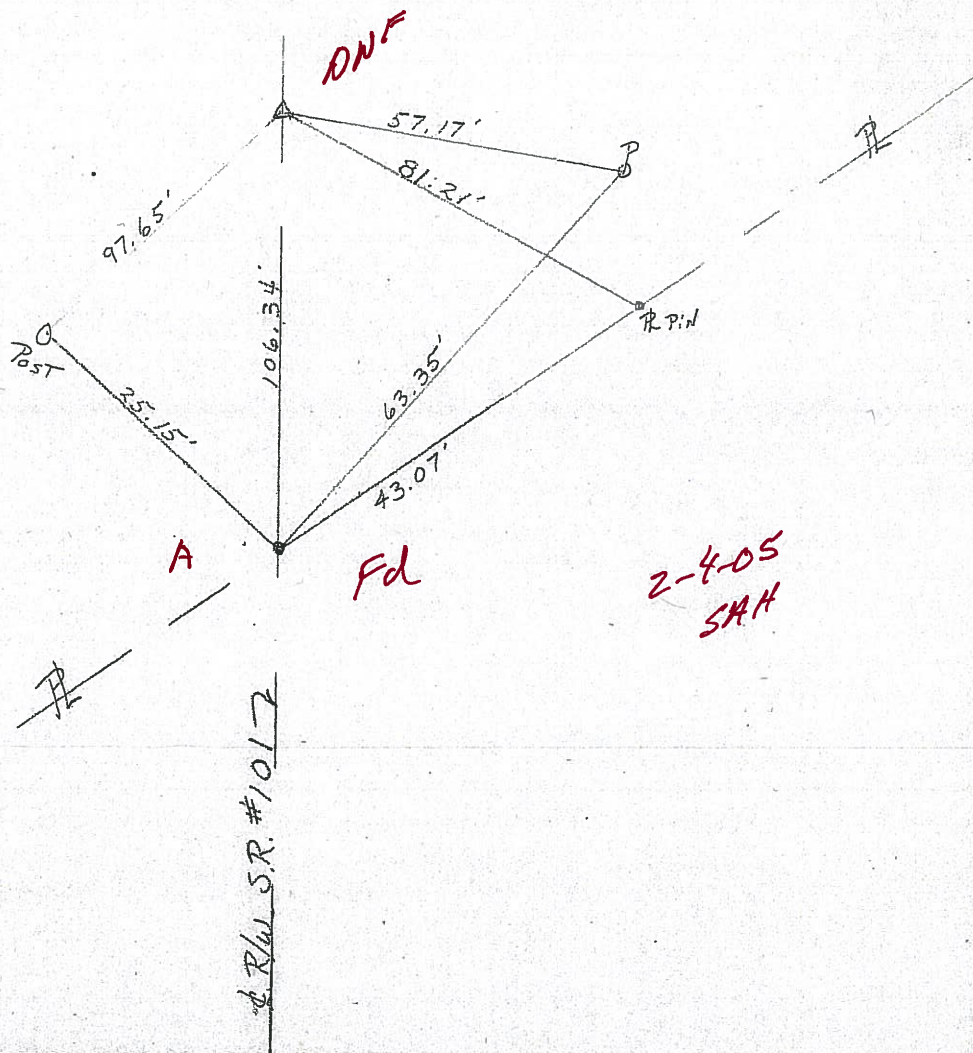

O.D.O.T. DISTRICT 2 SURVEY OFFICE

PERSONNEL _____

REFERENCE NO. 29

SHEET 3 OF 41

NOTES Ripple

H.C. Barbour

DATE 8/27/90

ROUTE SR.# 101

R.C. _____

WEATHER SUNNY

COUNTY Seneca

TEMP. 73°



TOWNSHIP Pleasant

SECTION 36

T 3 N R 15 E

TYPE MONUMENT Set P.K. & Washer
 ON SURFACE - BELOW PK. Nail at Top R/R spike
 LEFT - ☉ PAV'T. - RIGHT ☉
 _____ TO _____ EDGE PAVEMENT
 S.L.M. _____

29-B

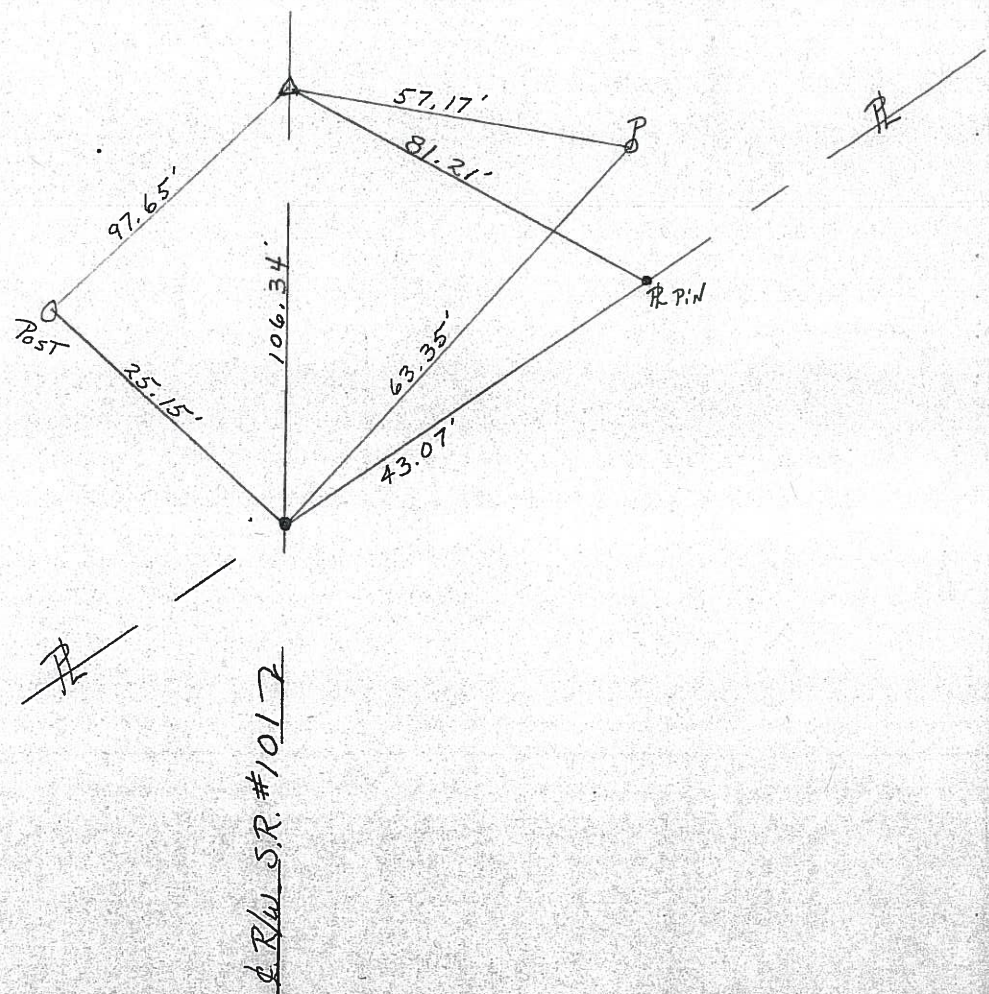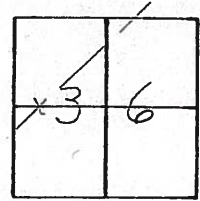

County Seneca S.R. 101

Date 6-26-79

Township Pleasant

Weather Fair

Section 36

Temp. 65°


T₃N, R₁₅E

Personnel Schneider

Mosser

Barbour

29-B

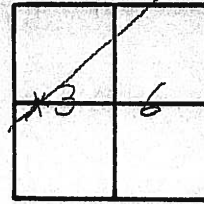

P.I.

115 + 72

R.R. spk. on E R/w

Reset P. K. Nail

$\Delta = 0^{\circ} - 18' LT.$

