


O.D.O.T. DISTRICT 2 SURVEY OFFICE (USE ONLY)


PERSONNEL \_\_\_\_\_ REFERENCE NO. 37 A SHEET 15 OF 46  
 NOTES HOMAN DATE 7-21-09 ROUTE SR 101  
 H.C. HOMAN WEATHER SUNNY COUNTY SENECA  
 R.C. ROUSOS TEMP. 75°F TOWNSHIP ADAMS  
 DWG BY MAHLER PID 100787 SECTION 19  
 T 3 N R 16 E

TYPE MONUMENT P.K.NAIL  
 ON SURFACE - ~~BELOW~~ ON  
 OFFSET  $\odot$  PAVEMENT 0.8' LT : ~~RT~~  
- TO - EDGE PAVEMENT  
 STATION: 467+46

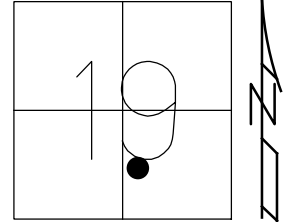

HORIZ.DATUM: NAD83 (2011) GEOID: NAVD88-2012A  
 GRID: NORTHING: 558520.901 EASTING: 1813244.488


RECORD:  
 FD P.K.NAIL  
 REFA38  
 7/21/09, DCH  
 SET MAG/WASHER  
 NEWREFA38  
 10/8/09, DCH  
 FD MAG/WASHER  
 REFA37  
 6/14/16  
 9/18/17, JFO

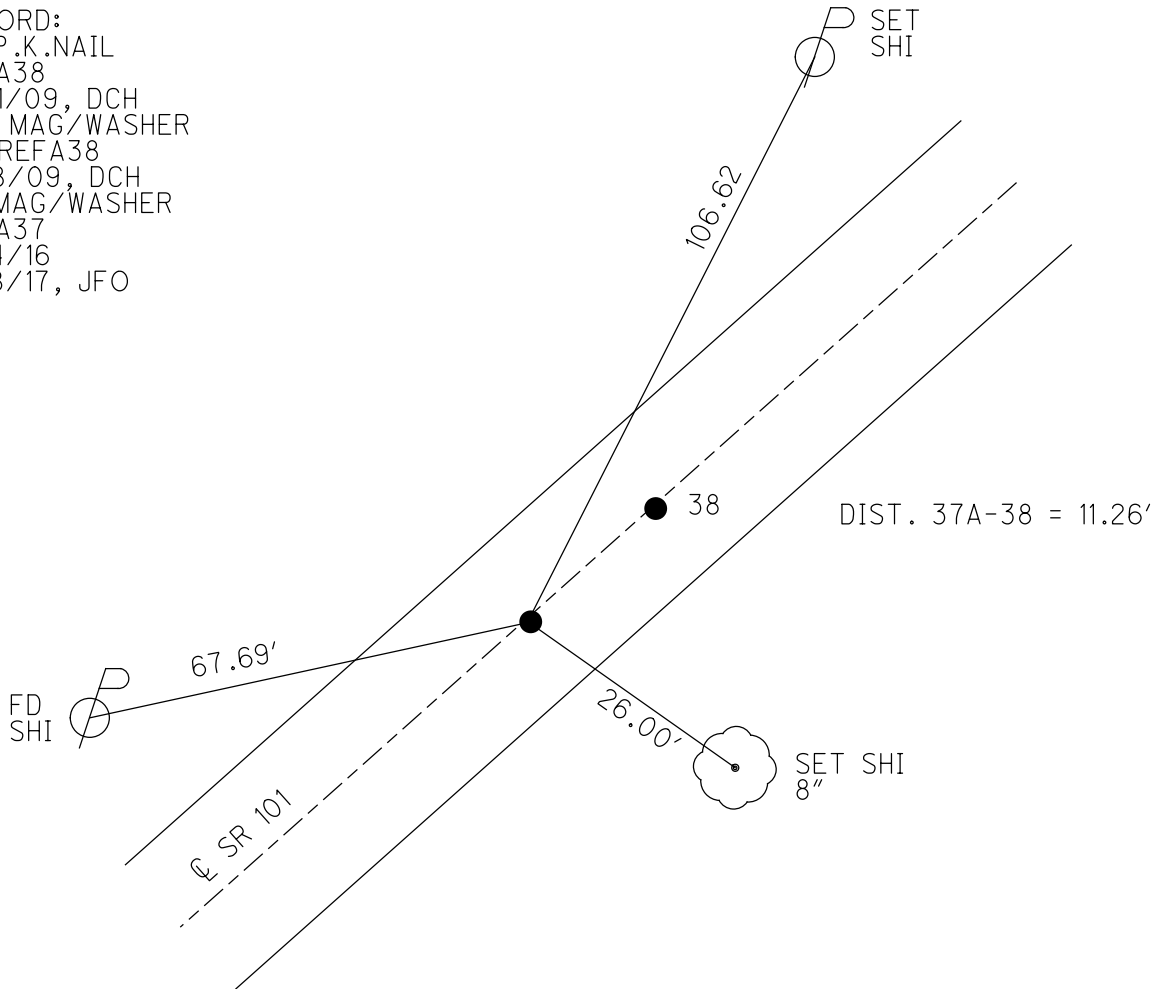

**O.D.O.T. DISTRICT 2 SURVEY OFFICE (USE ONLY)**


PERSONNEL	REFERENCE NO.	37 A	SHEET	15	OF	46
NOTES	HOMAN	DATE	7/21/09	ROUTE	SR 101	
H.C.	HOMAN	WEATHER	SUNNY	COUNTY	SENECA	
R.C.	ROUSOS	TEMP.	75°	TOWNSHIP	ADAMS	
				SECTION	19	
				T. 3 N	R. 16 E	

TYPE MONUMENT P.K.NAIL  
 ON SURFACE - ~~BELOW~~ ON  
 LEFT - ☉ PAV'T - ~~RIGHT~~ 0.8'  
 - TO - EDGE PAVEMENT  
 S.L.M. 467+46

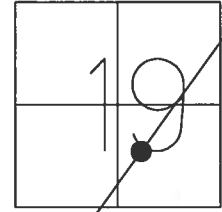

GRID: NORTHING: 558520.901 EASTING: 1813244.488

RECORD:  
 SET MAG/WASHER  
 10/8/09, DCH  
 FD MAG/WASHER  
 REFA37  
 6/14/16, JFO  
 UNCOVERED  
 9/18/17, JFO

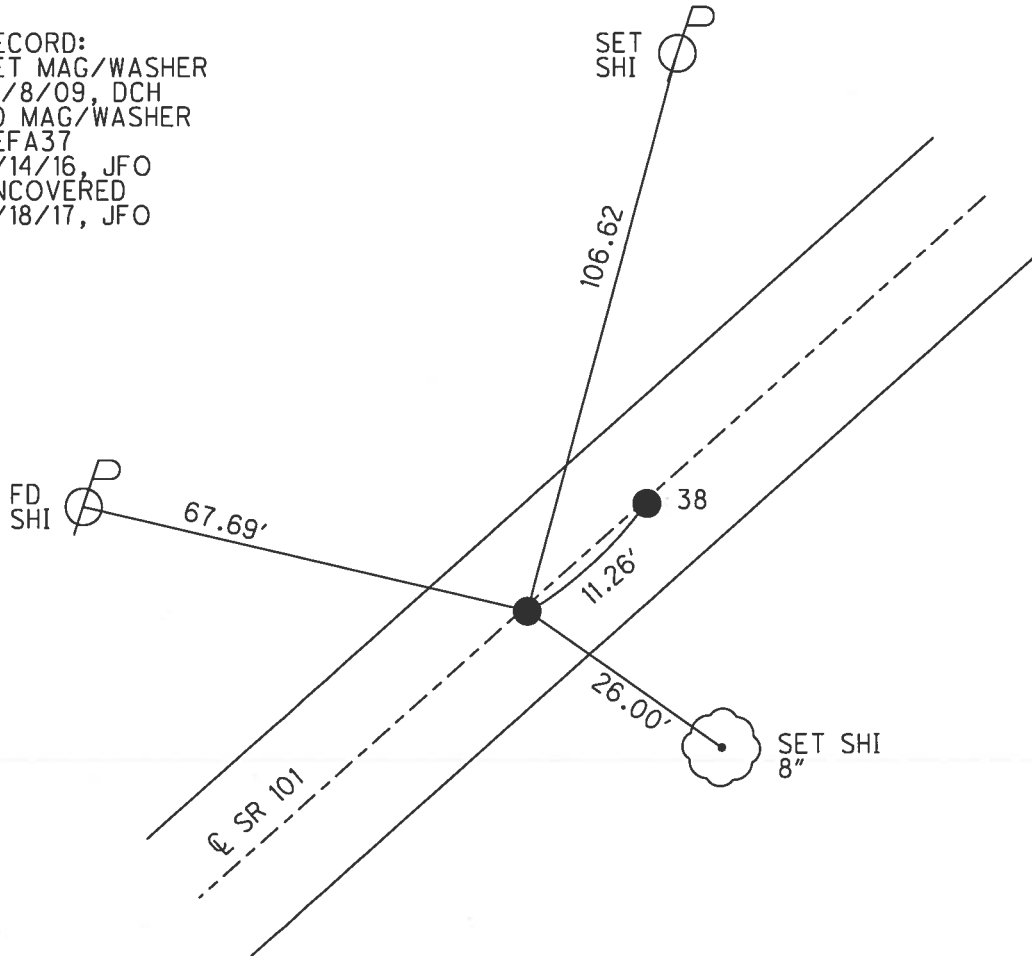

O.D.O.T. DISTRICT 2 SURVEY OFFICE (USE ONLY)

PERSONNEL \_\_\_\_\_ REFERENCE NO. 37 A SHEET 15 OF 46  
 NOTES HOMAN DATE 7/21/09 ROUTE SR 101  
 H.C. HOMAN WEATHER SUNNY COUNTY SENECA  
 R.C. ROUSOS TEMP. 75° TOWNSHIP ADAMS  
 \_\_\_\_\_ SECTION 19  
 \_\_\_\_\_ T 3 N R 16 E

TYPE MONUMENT P.K.NAIL


ON SURFACE - ~~BELOW~~ ON

LEFT - ☉ PAV'T - RIGHT ON

- TO - EDGE PAVEMENT

S.L.M. 467+46

GRID: NORTHING: 5558520.976 EASTING: 1813244.450

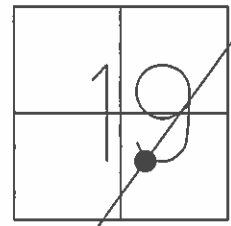

RECORD:  
 SET MAG/WASHER  
 10/8/09, DCH

