

O.D.O.T. DISTRICT 2 SURVEY OFFICE (USE ONLY)

PERSONNEL

REFERENCE NO. 59

SHEET 38 OF 46

NOTES HOMAN

DATE 7-8-09

ROUTE SR 101

H.C. HOMAN

WEATHER SUNNY

COUNTY SENECA

R.C. ROUSOS

TEMP. 80°F

TOWNSHIP ADAMS

SECTION 10

DWG BY MAHLER

PID 100787

T 3 N R 16 E

TYPE MONUMENT P.K./WASHER

ON SURFACE - ~~BELOW~~ ON

OFFSET 0 PAVEMENT 1' LT : RT

- TO - EDGE PAVEMENT


STATION: 690+97

HORZ.DATUM: NAD83 (2011)

GEOID: NAVD88-2012A


GRID: NORTHING: 573582.290

EASTING: 1829654.764

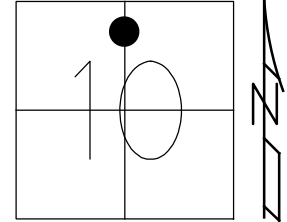

RECORD:


- STA. 181+00
- FD R.R. SPIKE
- 4" DOWN
- SET P.K./WASHER
- 8/29/90, BARBOUR
- FD P.K./WASHER
- 2/7/05, SAH
- FD P.K./WASHER
- REF59
- 7/8/09, DCH
- SET MAG/WASHER
- NEWREF59
- 10-06-09, DH
- FD MAG/WASHER
- REF59
- 6/15/16
- 9/19/17, JFO

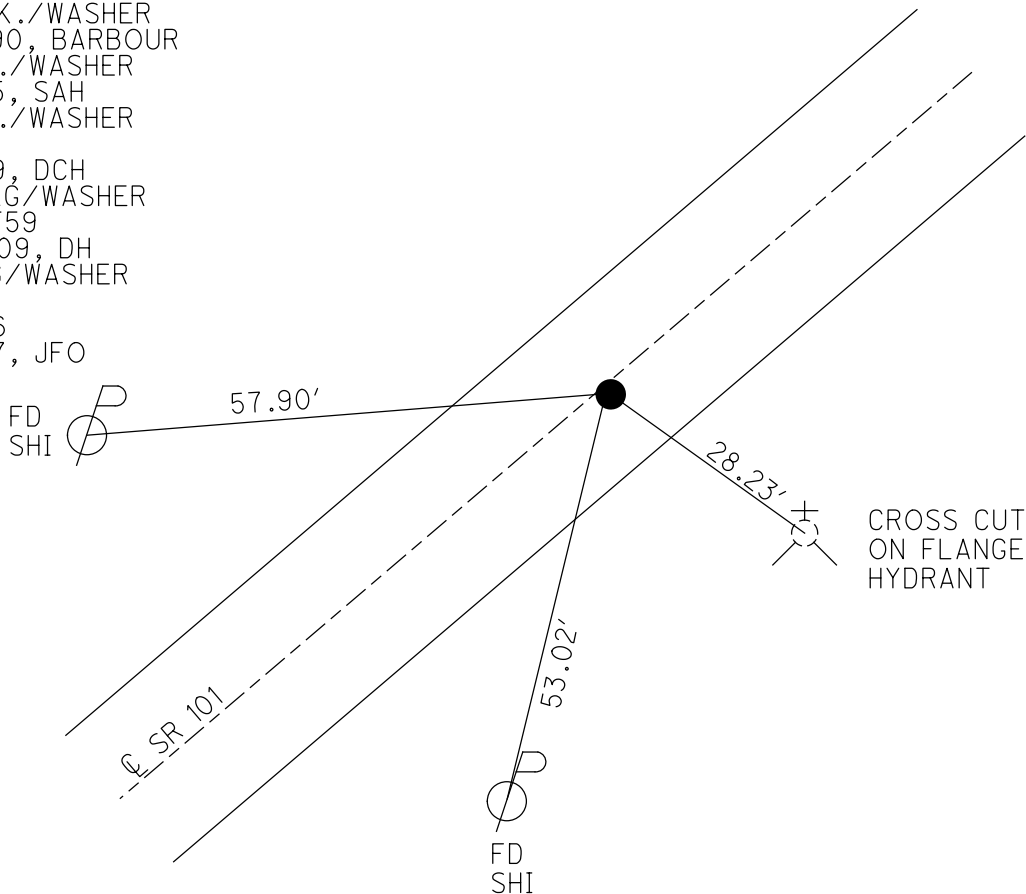

O.D.O.T. DISTRICT 2 SURVEY OFFICE (USE ONLY)


PERSONNEL _____ REFERENCE NO. 59 SHEET 38 OF 46
 NOTES HOMAN DATE 7/08/09 ROUTE SR 101
 H.C. HOMAN WEATHER SUNNY COUNTY SENECA
 R.C. ROUSOS TEMP. 80° TOWNSHIP ADAMS
 _____ SECTION 10
 _____ T 3 N R 16 E

TYPE MONUMENT P.K./WASHER
 ON SURFACE - ~~BELOW~~ ON _____
~~LEFT~~ - ☉ PAV'T - RIGHT 1'
 _____ TO _____ EDGE PAVEMENT
 S.L.M. 690+97

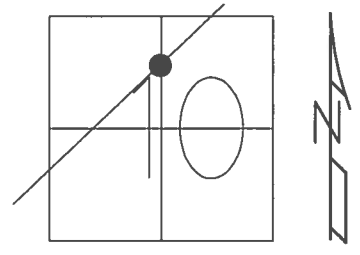

GRID: NORTHING: 573582.290 EASTING: 1829654.764


RECORD:
 STA. 181+00
 FD R.R. SPIKE
 4" BELOW
 SET P.K./WASHER
 8/29/90
 FD P.K./WASHER
 2/7/05, SAH
 SET MAG/WASHER
 10-06-09, DH
 FD MAG/WASHER
 REF59
 6/15/16, JFO
 UNCOVERED
 9/19/17, JFO

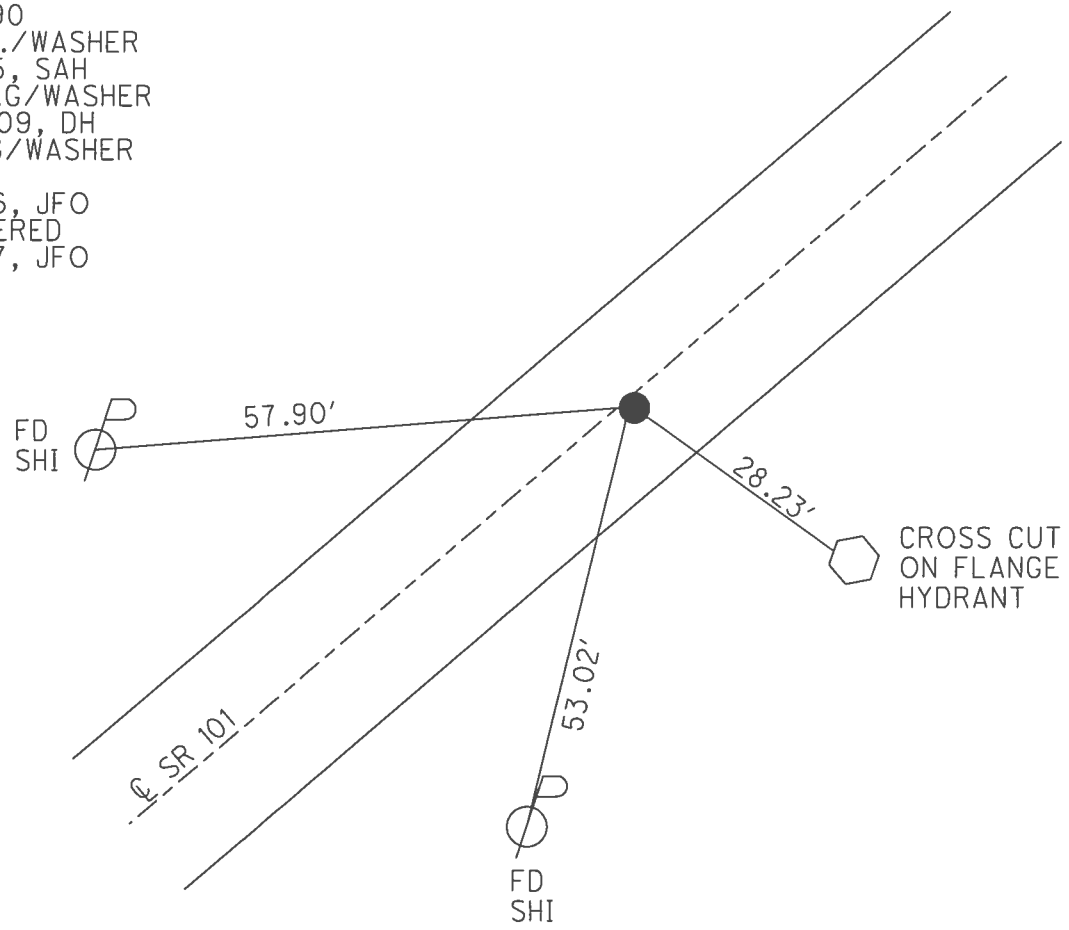

O.D.O.T. DISTRICT 2 SURVEY OFFICE (USE ONLY)


PERSONNEL	REFERENCE NO.	<u>59</u>	SHEET	<u>38</u>	OF	<u>46</u>
NOTES	HOMAN	DATE	<u>7/08/09</u>	ROUTE	<u>SR 101</u>	
H.C.	HOMAN	WEATHER	<u>SUNNY</u>	COUNTY	<u>SENECA</u>	
R.C.	ROUSOS	TEMP.	<u>80°</u>	TOWNSHIP	<u>ADAMS</u>	
				SECTION	<u>10</u>	
				T	<u>3</u>	N
				R	<u>16</u>	E

TYPE MONUMENT P.K./WASHER
 ON SURFACE - ~~BELOW~~ ON
~~LEFT~~ - CL PAV'T - RIGHT 1'
 - TO - EDGE PAVEMENT
 S.L.M. 690+97

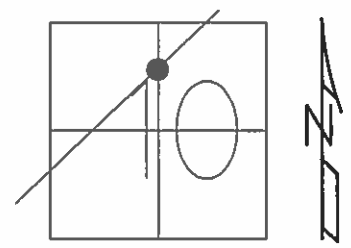

GRID: NORTHING: 573582.284 EASTING: 1829654.648

RECORD:
 STA. 181+00
 FD R.R. SPIKE
 4" BELOW
 SET P.K./WASHER
 8/29/90
 FD P.K./WASHER
 2/7/05, SAH
 SET MAG/WASHER
 10-06-09, DH

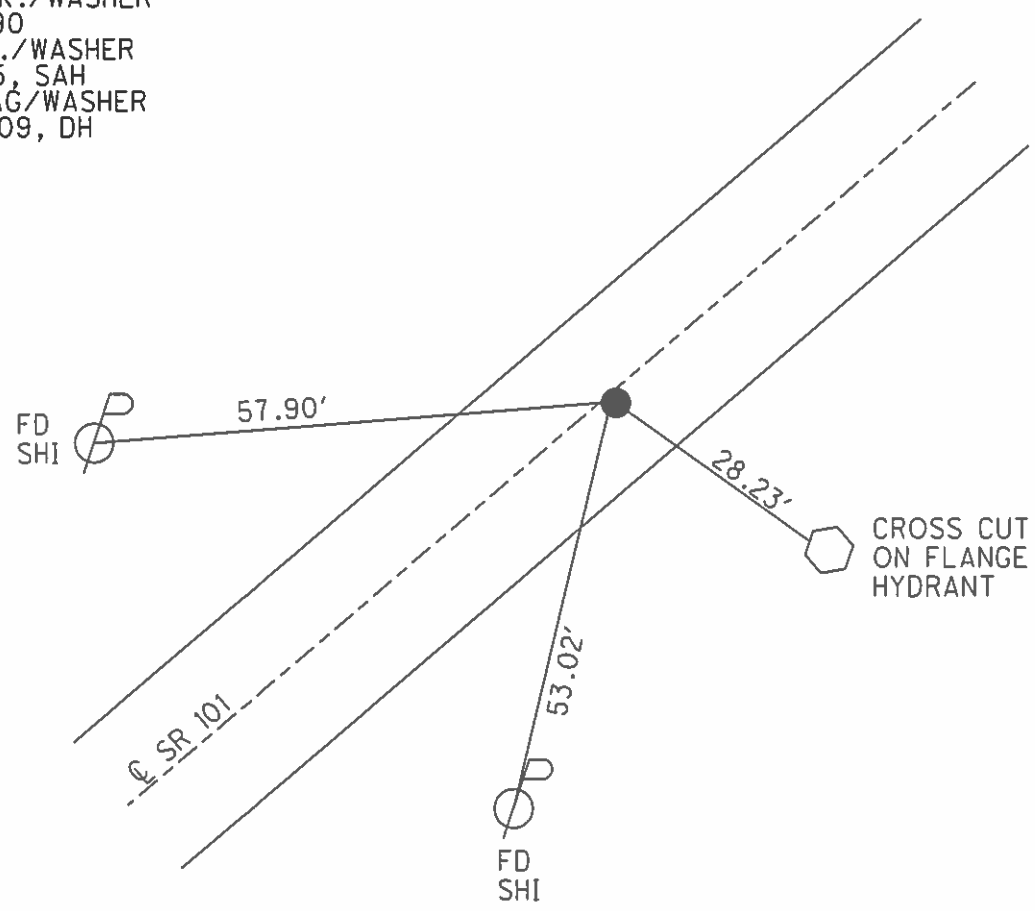

O.D.O.T. DISTRICT 2 SURVEY OFFICE

PERSONNEL

REFERENCE NO. 59

SHEET 34 OF 41

NOTES Ripple

H.C. Barbour

DATE 8-29-90

ROUTE 101

R.G. Geyman

WEATHER Cloudy

COUNTY Sen.



TEMP. 77°

TOWNSHIP Adams

SECTION 10

T 3 N R 16 E





TYPE MONUMENT set P.K. Washer
ON SURFACE - BELOW R/R Spike 4" below
LEFT - & PAV'T. - RIGHT 1' RT. &
TO EDGE PAVEMENT
S.L.M. _____

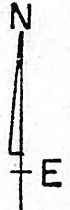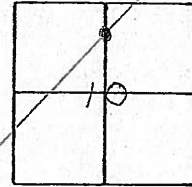

690+97

STA. 181+

Black Willow

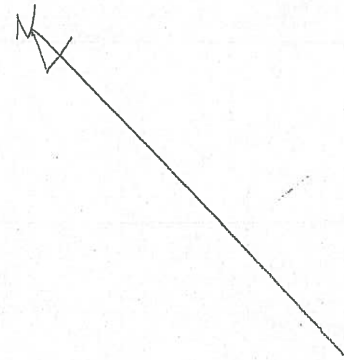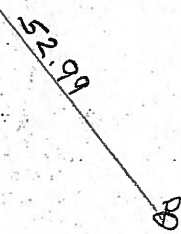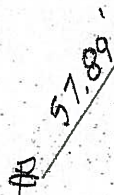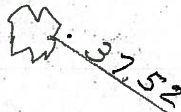

Fd

2-7-05

SAH

O.D.O.T. DISTRICT 2 SURVEY OFFICE

PERSONNEL

REFERENCE NO. 59

SHEET 34 OF 41

NOTES Ripph

H.C. Barbours

R.C. Geyman

DATE 8-29-90

WEATHER Cloudy

TEMP. 77°

ROUTE 101


COUNTY Sen.

TOWNSHIP Adams

SECTION 10




T. 3 N R. 16 E

TYPE MONUMENT set P.K. Washer
ON SURFACE - BELOW R/R Spike 4" below
LEFT - & PAV'T. - RIGHT 1' RT. &
TO EDGE PAVEMENT
S.L.M. _____

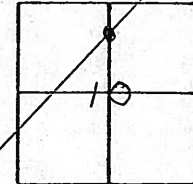

STA. 181+

Black Willow

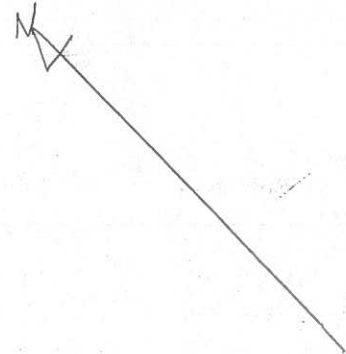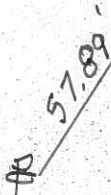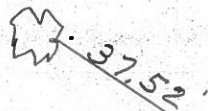

PERSONNEL TITLE PERSONNEL TITLE

COUNTY SULLY DATE 11-25-69


S. R. # 101 WEATHER

SEC. TEMP

DESCRIPTION LEFT CENTER LINE RIGHT JOB NO.


(61)

4-20-19
 2/27/69
 Sta. 211+00
 R.R. sph. on E R/W
 1/2" below surface
 #11

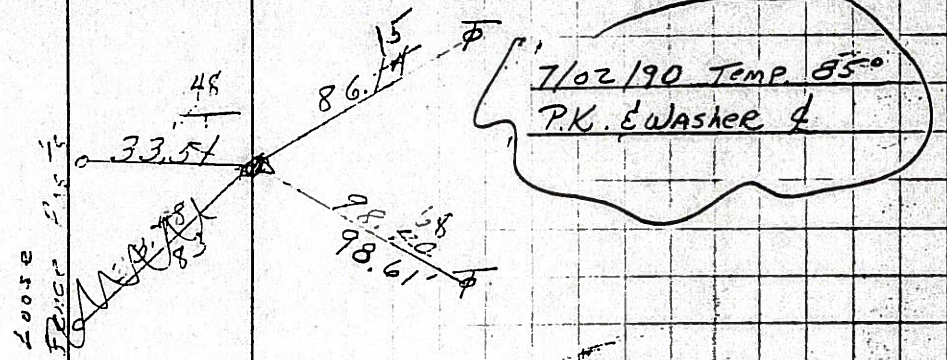


(60-A)

Sta. 192+00
 R.R. sph. on E R/W
 3" below surface
 1' RT. &
 #11
 8507

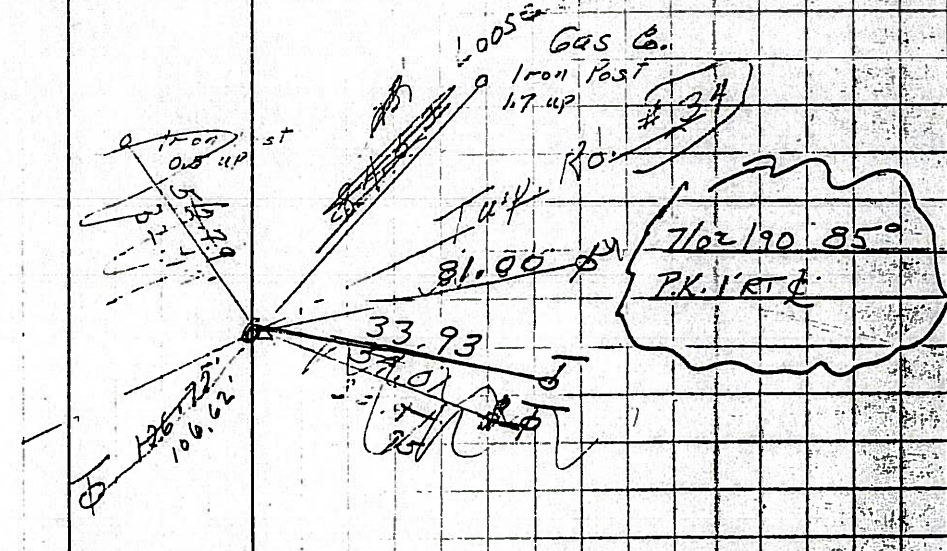


(59)

Found 2/27/69
 Sta. 181+00
 R.R. sph. on E R/W
 2" below surface
 #11
 178+
 688+05 8506

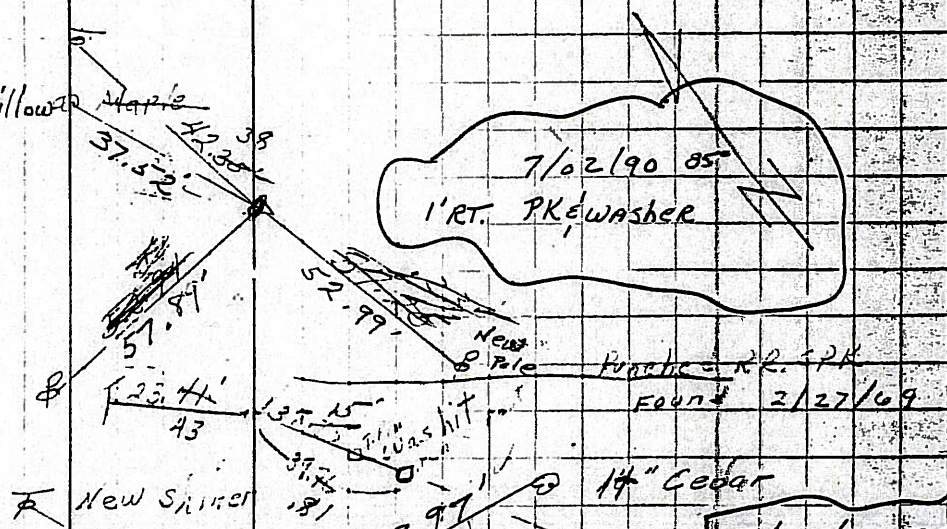

(58)

Sta. 175+00
 R.R. sph. on E R/W
 2" below surface
 683+
 #11 8505

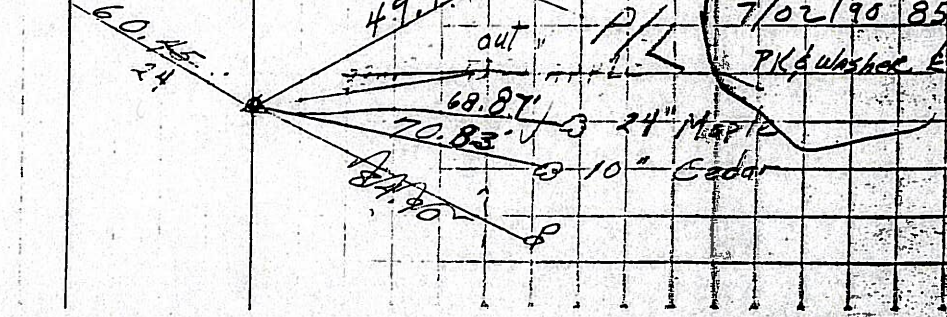

PERSONNEL TITLE PERSONNEL TITLE

COUNTY Seneca

DATE 2-11-64

Krabill

Kowaleski

S. R. # 101

WEATHER

Geyman

SEC.

TEMP.

Bruggeman

DESCRIPTION S. R. # 101 Tiffin to Sen. Co. Line

JOB NO.


LEFT

CENTER LINE

RIGHT


55

STA. 134+65
R. R. Spike
405

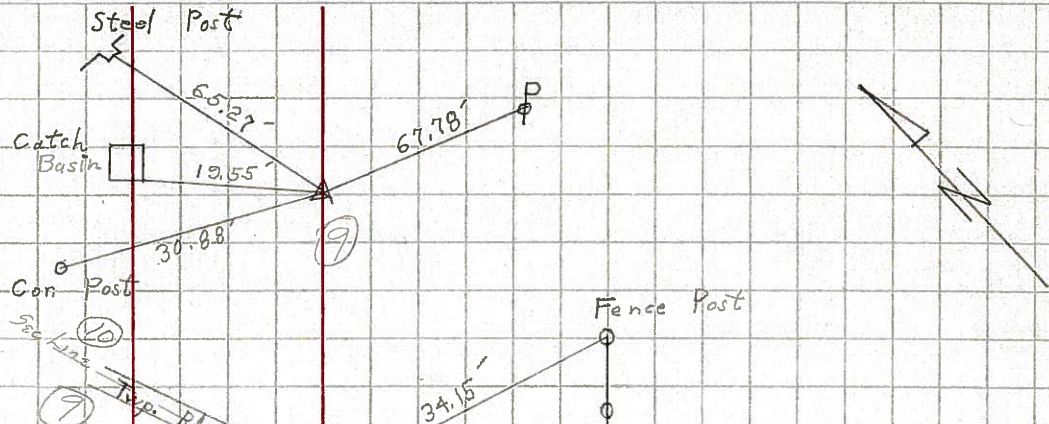


56

STA. 144+34.30'
R. R. Spike
406

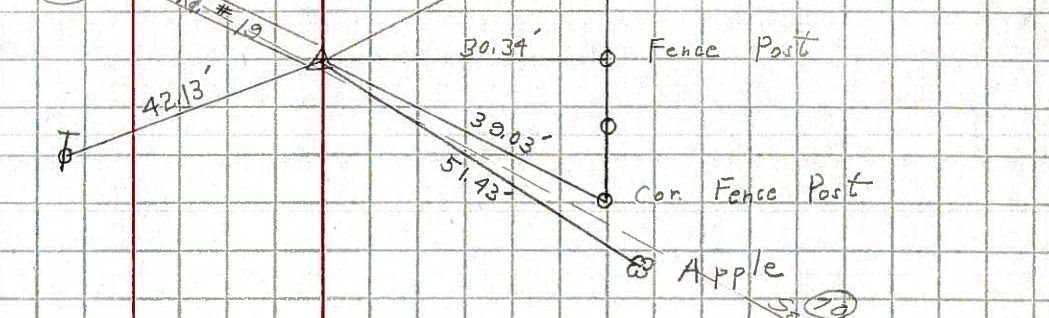


57

STA. 165+00
Iron Pin
407

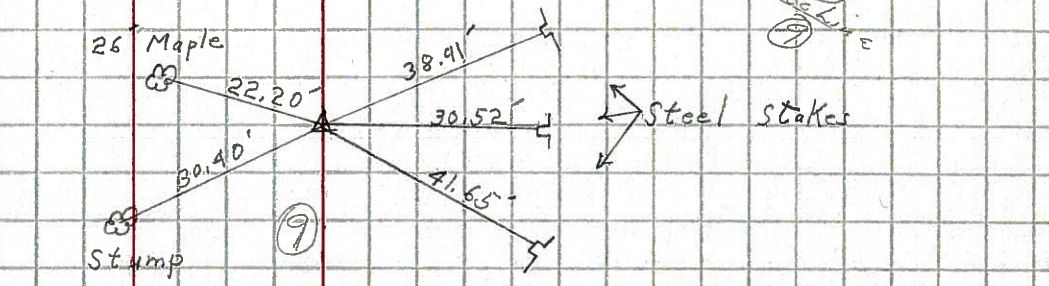

58

STA. 173+00
Iron Pin
408

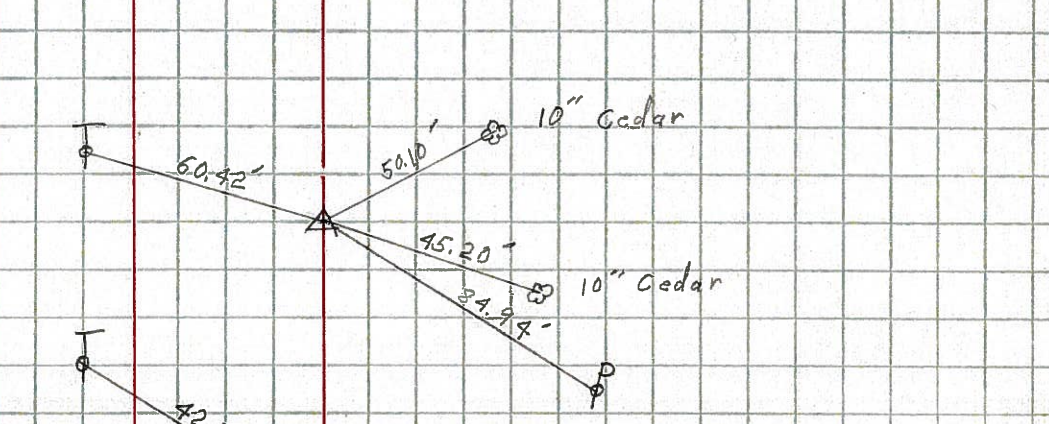

59

STA. 181+00
Iron Pin
409

