

O.D.O.T. DISTRICT 2 SURVEY OFFICE (USE ONLY)

PERSONNEL

REFERENCE NO. 60

SHEET 39 OF 46

NOTES HOMAN

DATE 7-8-09

ROUTE SR 101

H.C. HOMAN

WEATHER SUNNY

COUNTY SENECA

R.C. ROUSOS

TEMP. 80°F

TOWNSHIP ADAMS

SECTION 3

DWG BY MAHLER PID 100787

T 3 N R 16 E

TYPE MONUMENT P.K./WASHER

ON SURFACE - ~~BELOW~~ ON

OFFSET ☉ PAVEMENT 2' RT

- TO - EDGE PAVEMENT


STATION: 701+80

HORIZ.DATUM: NAD83 (2011)


GEOID: NAVD88-2012A

GRID: NORTHING: 574280.650

EASTING: 1830481.781

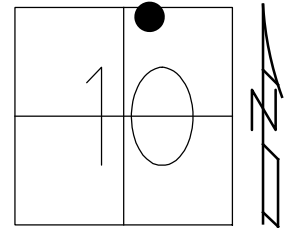


RECORD:  
 FD P.K.NAIL  
 REF60  
 7/8/09, DCH  
 SET MAG/WASHER  
 NEWREF60  
 10-06-09, DH  
 FD MAG/WASHER  
 REF60  
 6/15/16  
 9/12/17, JFO

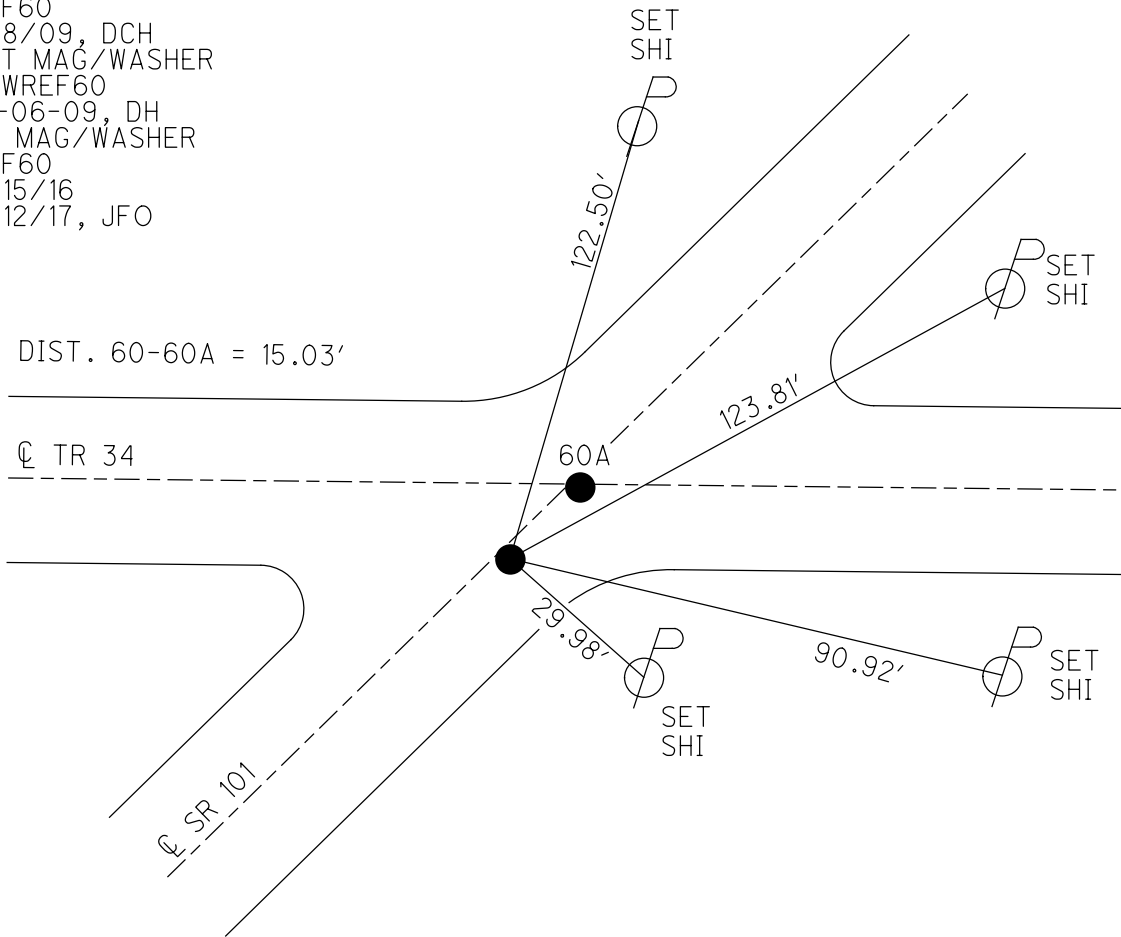


O.D.O.T. DISTRICT 2 SURVEY OFFICE (USE ONLY)

PERSONNEL	REFERENCE NO.	<u>60</u>	SHEET	<u>39</u>	OF	<u>46</u>
NOTES	HOMAN	DATE	<u>7/08/09</u>	ROUTE	<u>SR 101</u>	
H.C.	HOMAN	WEATHER	<u>SUNNY</u>	COUNTY	<u>SENECA</u>	
R.C.	ROUSOS	TEMP.	<u>80°</u>	TOWNSHIP	<u>ADAMS</u>	
				SECTION	<u>3</u>	
				T	<u>3</u>	R
					<u>N</u>	<u>16</u>
					<u>E</u>	

TYPE MONUMENT P.K./WASHER  
 ON SURFACE - ~~BELOW~~ ON  
~~LEFT~~ - ☉ PAV'T - RIGHT 2'  
- TO - EDGE PAVEMENT  
 S.L.M. 701+80  
 GRID: NORTHING: 574280.650 EASTING: 1830481.781

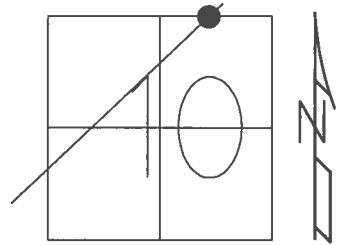


RECORD:  
 SET MAGS/WASHER  
 10-06-09, DH  
 FD MAG/WASHER  
 REF60  
 6/15/16, JFO  
 UNCOVERED  
 9/12/17, JFO

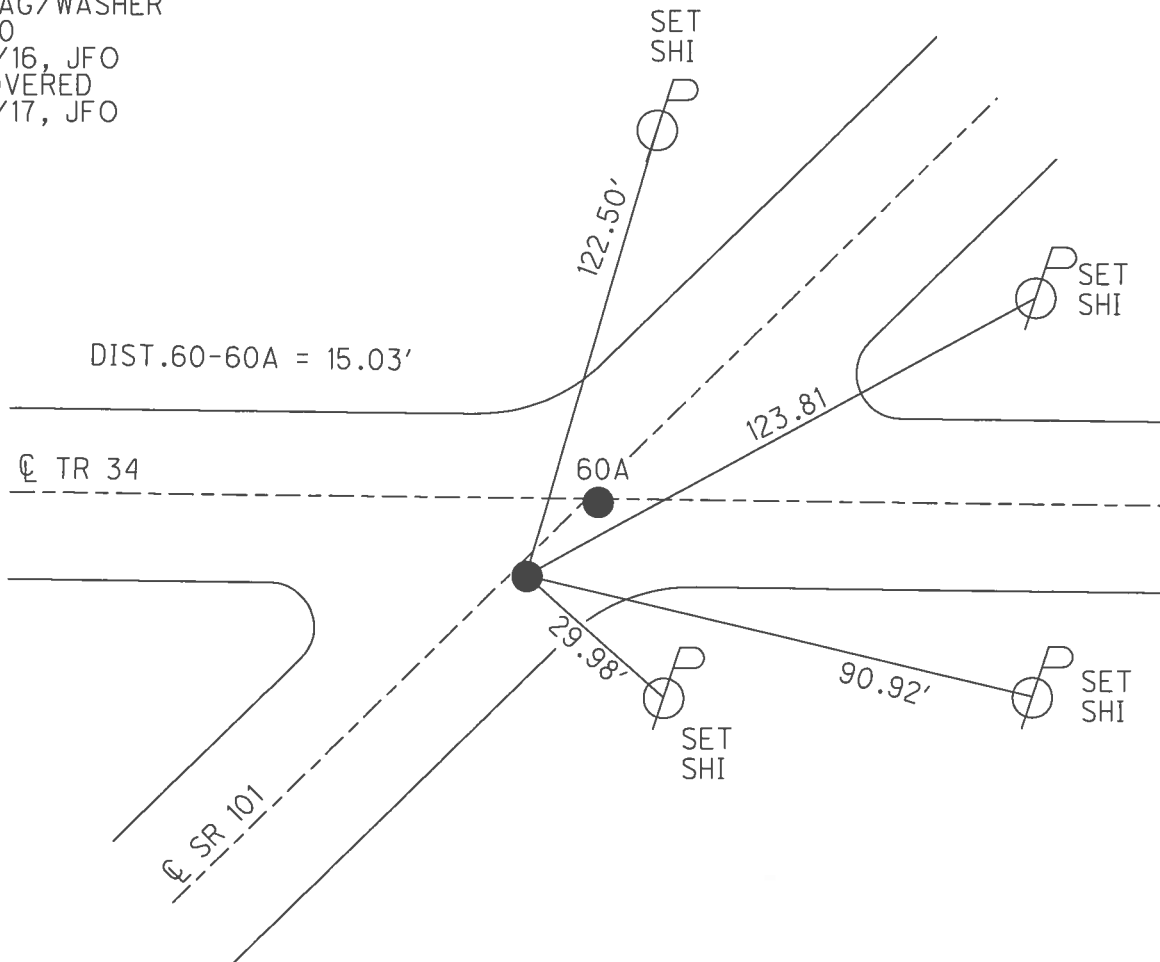

O.D.O.T. DISTRICT 2 SURVEY OFFICE (USE ONLY)

PERSONNEL \_\_\_\_\_ REFERENCE NO. 60 SHEET 39 OF 46  
 NOTES HOMAN DATE 7/08/09 ROUTE SR 101  
 H.C. HOMAN WEATHER SUNNY COUNTY SENECA  
 R.C. ROUSOS TEMP. 80° TOWNSHIP ADAMS  
 \_\_\_\_\_ SECTION 3  
 \_\_\_\_\_ T 3 N R 16 E

TYPE MONUMENT P.K./WASHER  
 ON SURFACE - ~~BELOW~~ ON  
~~LEFT~~ - ☉ PAV'T - RIGHT 2'  
- TO - EDGE PAVEMENT  
 S.L.M. 701+80

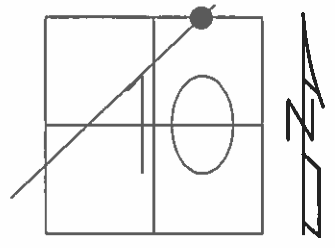

GRID: NORTHING: 574290.461 EASTING: 1830493.153

RECORD:  
 SET MAGS/WASHER  
 10-06-09, DH

