


O.D.O.T. DISTRICT 2 SURVEY OFFICE (USE ONLY)

PERSONNEL _____ REFERENCE NO. 10 SHEET 11 OF 32


NOTES HOMAN DATE 4/14/04 ROUTE SR 162
H.C. HOMAN WEATHER SUNNY COUNTY SENECA
R.C. ARMS TEMP. 55° TOWNSHIP SCIPIO
SECTION 13
T 2 N R 16 E

TYPE MONUMENT R.R.SPIKE
ON SURFACE - BELOW -
LEFT - ☉ PAV'T - RIGHT -
- TO - EDGE PAVEMENT
S.L.M. 121+07

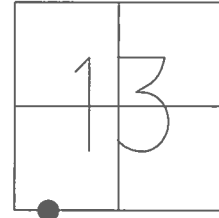

GRID: NORTHING: _____ EASTING: _____

RECORD: P.I.
STA. 278+23.4
R.R.SPIKE
 $\Delta = 00^\circ 0' RT$
D.N.F.
1979, 2004, 2016

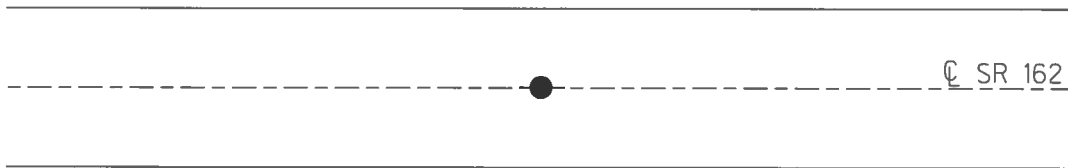


O.D.O.T. DISTRICT 2 SURVEY OFFICE (USE ONLY)

PERSONNEL _____ REFERENCE NO. 10 SHEET 11 OF 32


NOTES HOMAN DATE 4/14/04 ROUTE SR 162
H.C. HOMAN WEATHER SUNNY COUNTY SENECA
R.C. ARMS TEMP. 55° TOWNSHIP SCIPIO
SECTION 13
T 2 N R 16 E

TYPE MONUMENT R.R.SPIKE
ON SURFACE - BELOW -
LEFT - ☉ PAV'T - RIGHT -
- TO - EDGE PAVEMENT
S.L.M. 121+07

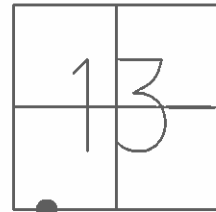

GRID: NORTHING: _____ EASTING: _____

RECORD: P.I.
 $\Delta = 00^\circ 0' RT$
D.N.F.

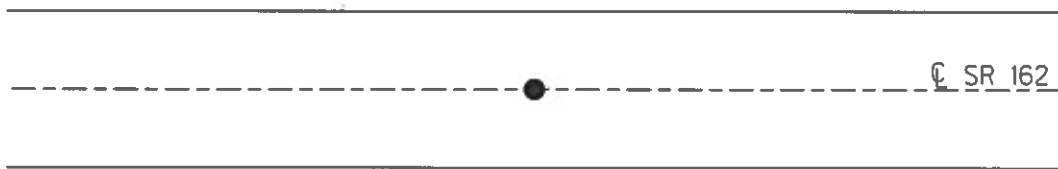

O.D.O.T. DISTRICT 2 SURVEY OFFICE

PERSONNEL

REFERENCE NO. 10

SHEET 10 OF 30

NOTES HOMAN

DATE 4-14-04

ROUTE SR 162

H.C. HOMAN

WEATHER SUNNY

COUNTY SENECA

R.C. ARMS

TEMP. 55°

TOWNSHIP SCIPIO

SECTION 13

T 2 N R 16 E

D.D. not find


TYPE MONUMENT R.R. SPK.

ON SURFACE - BELOW _____

LEFT - Q PAV'T - RIGHT _____

_____ TO _____ EDGE PAVEMENT

S.L.M. _____ 121+07

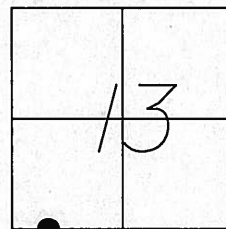


RECORD: PI DELTA= 00°-0' RT
DID NOT FIND
NO ORIGINAL TIES REMAINING
DID NOT GET A STRIKE WITH
METAL LOCATOR AROUND
THE APPROXIMATE LOCATION.

OLD Record Sta: 278+23.4

ALSO: 120+33.39

Believe to be a P.O.T.

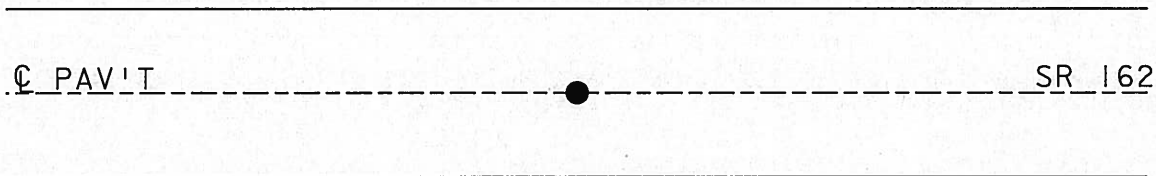

O.D.O.T. DISTRICT 2 SURVEY OFFICE

PERSONNEL

REFERENCE NO. _____

SHEET _____ OF _____

NOTES RIPPLE

H.C. BARBOUR

R.C. Geyman

DATE 2/07/91

WEATHER cloudy

TEMP. 35'

ROUTE S.R.#162

COUNTY Seneca

TOWNSHIP Scipio

SECTION 13 & 24

T. 2 N. R. 16 E.

TYPE MONUMENT P.O.T. Nail/Washer


ON SURFACE - BELOW

LEFT - ☉ PAV'T. - RIGHT 2.5' LT.




TO EDGE PAVEMENT

S.L.M. 120+33.39

1	3
2	4

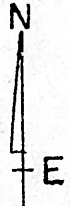

*Same as sheet
Before*

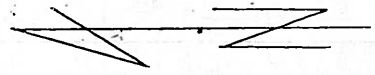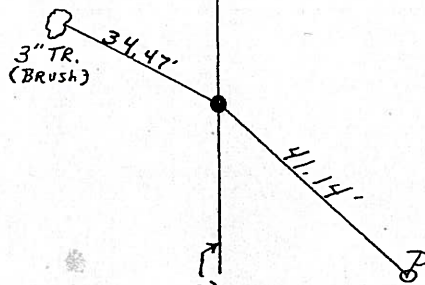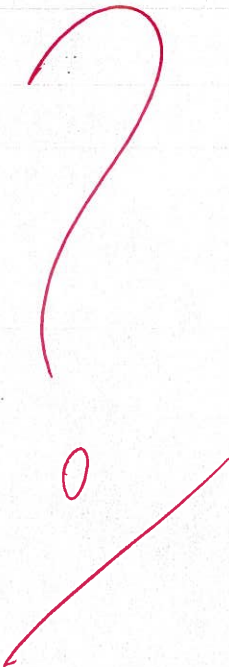

County Seneca S.R. 162

Township Sciprio

Section 13

T2N, R16E

Personnel Schneider

Messer

Barbour


#10

Date 6-11-79

Weather Fair

Temp. 65°

sciprio	Reed
13	18
X	
24	19

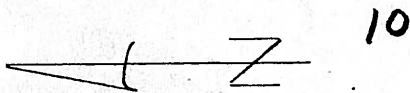

Did Not Find


S.R. #162

278 + 23.4

R.R. spk.

$\Delta = 0^{\circ} 01'$ rt

No Deflection

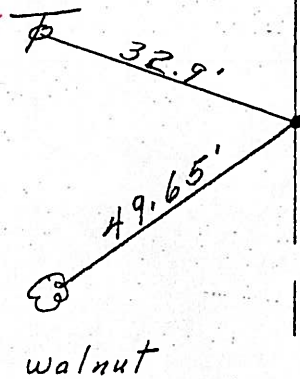

did not find

County Seneca S.R. 162

Date 6-11-79

Township Sciprio

Weather Fair

Section 13

Temp. 65°

T₂N, R₁₆E


Personnel Schneider

sciprio Reed

13	18
x	
24	19




Mosser
Barbour

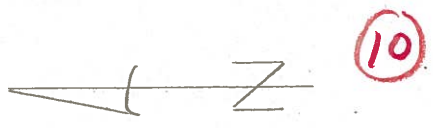

S.R. #162

278 + 23.4
R.R. SPk.
 $\Delta = 0^{\circ} 0'$

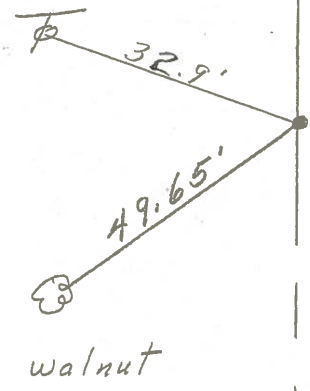

did not find

S.H. 449 Sec. M.

(6)

214+40.4 Set R.R. Spike

FD 3-25-04

(7)

233+54.45 R.R. Spike on ϵ

FD 4-14-04

(8)

241+26.2 Set R.R. Spike on ϵ

Need Help or Hill Limited

Sight Distance FD 4-20-04

(9)

268+09.75 R.R. Spike on ϵ

FD 4-13-04

(10)

278+23.1 Set R.R. Spike on ϵ

Need Help

