

O.D.O.T. DISTRICT 2 SURVEY OFFICE (USE ONLY)

PERSONNEL _____ REFERENCE NO. 11 SHEET 12 OF 32

NOTES RHOADES _____ DATE 8/1/17 ROUTE SR 162
 H.C. HOMAN _____ WEATHER SUNNY COUNTY SENECA
 R.C. CARSON _____ TEMP. 77° TOWNSHIP SCIPIO
 POORE _____ SECTION 13
 T 2 N R 16 E

TYPE MONUMENT MAG/WASHER


ON SURFACE - ~~BELOW~~ ON _____

LEFT - ☉ PAV'T - ~~RIGHT~~ 3.5'


TO EDGE PAVEMENT

S.L.M. 137+32

GRID: NORTHING: 531561.721 EASTING: 1839830.404

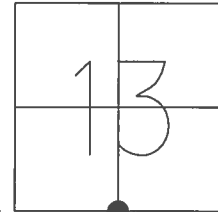

RECORD: P.I.
 $\Delta = 00^\circ 01' RT$
 STA: 294+43.3 (PLAN)
 P.I. $\Delta = 00^\circ 02' 30'' RT$
 POINT SET BY JERRY WEININGER
 APRIL 1984. S COR SEC. 13
 FD PK NAIL
 1" DOWN
 D.N.F R.R.SPIKE
 @ 9" DOWN
 SET P.K./WASHER
 10/6/04, DCH
 FD MAG/WASHER
 REF11
 1/8/16, JFO
 SET 1" MAG/WASHER
 8/1/17, DCH

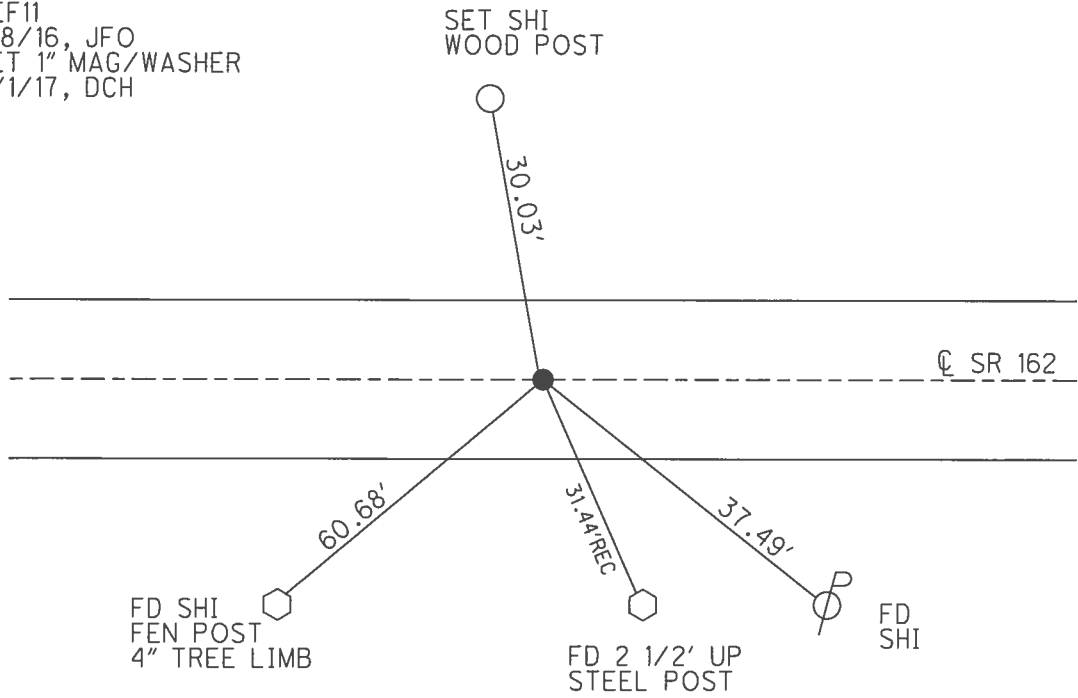


O.D.O.T. DISTRICT 2 SURVEY OFFICE (USE ONLY)


PERSONNEL _____ REFERENCE NO. 11 SHEET 12 OF 32

NOTES HOMAN _____ DATE 4/14/04 ROUTE SR 162
 H.C. HOMAN _____ WEATHER SUNNY COUNTY SENECA
 R.C. ARMS _____ TEMP. 55° TOWNSHIP SCIPIO
 _____ SECTION 13
 _____ T 2 N R 16 E

TYPE MONUMENT P.K./WASHER
 ON SURFACE - ~~BELOW~~ ON _____
 LEFT - \odot PAV'T - ~~RIGHT~~ 3'
 - TO - EDGE PAVEMENT
 S.L.M. 137+32
 GRID: NORTHING: _____ EASTING: _____

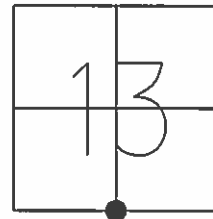

RECORD: P.I.
 $\Delta = 00^\circ 01' RT$
 STA: 294+43.3 (PLAN)
 P.I. $\Delta = 00^\circ 02' 30'' RT$
 POINT SET BY JERRY WEININGER
 APRIL 1984. S COR SEC. 13
 FD PK NAIL
 1" DOWN
 D.N.F R.R. SPIKE
 @ 9" DOWN
 SET P.K./WASHER
 10/6/04, DCH

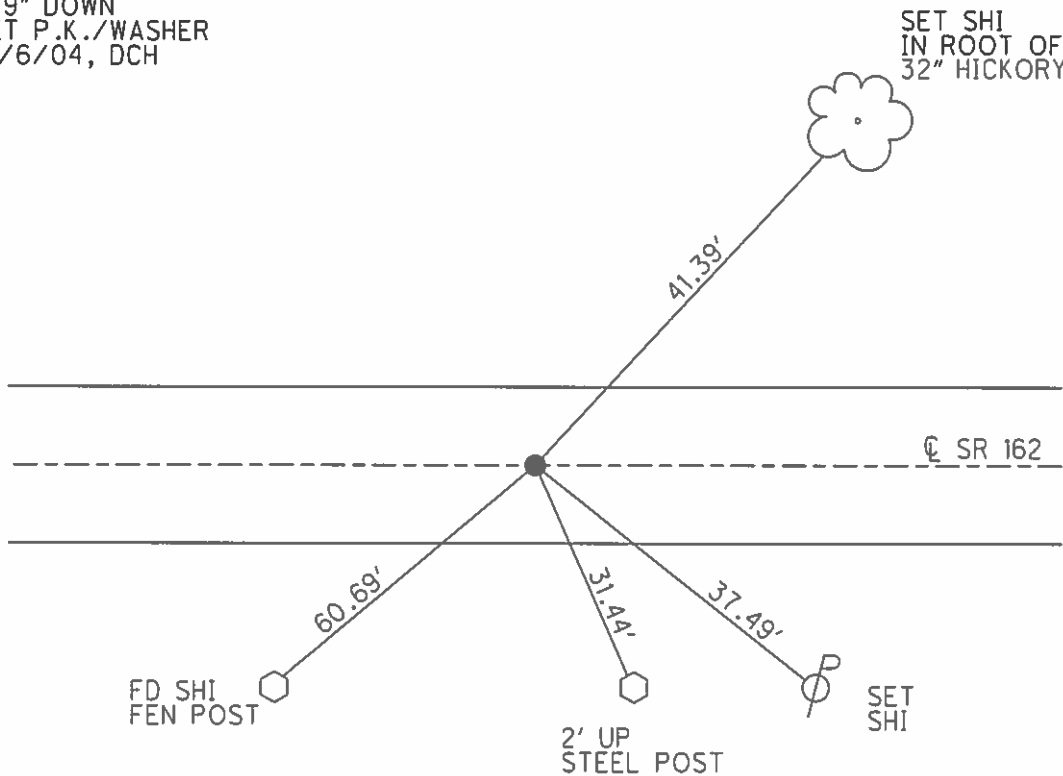

O.D.O.T. DISTRICT 2 SURVEY OFFICE

PERSONNEL _____

REFERENCE NO. 11

SHEET 11 OF 30

NOTES HOMAN

DATE 4-14-04

ROUTE SR 162

H.C. HOMAN

WEATHER SUNNY

COUNTY SENECA

R.C. ARMS

TEMP. 55°

TOWNSHIP SCIPPIO

SECTION 24

T 2 N R 16 E



TYPE MONUMENT P.K. & WASHER

ON SURFACE ~~BELOW~~ ON

LEFT ~~C PAV'T~~ ~~RIGHT~~ 3 1/2 LT

TO EDGE PAVEMENT

S.L.M. 137+32

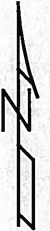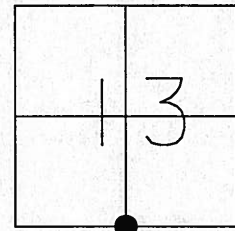


PLAN
RECORD: PI DELTA= 00°-01' RT
STA: 294+43.3

SET MAG NAIL
& WASHER
10-06-04
DCH

PI DELTA= 00°-02'-30" RT
POINT SET BY JERRY WEININGER
APRIL 1984. S 1/4 CORNER SEC. 13

FD PK NAIL 1 1/2" DOWN
WENT DOWN 9" NO R,R, SPIKE OR SIGNAL ON LOCATOR

SET N&S
SW/S IN ROOT
OF 32" HICKORY

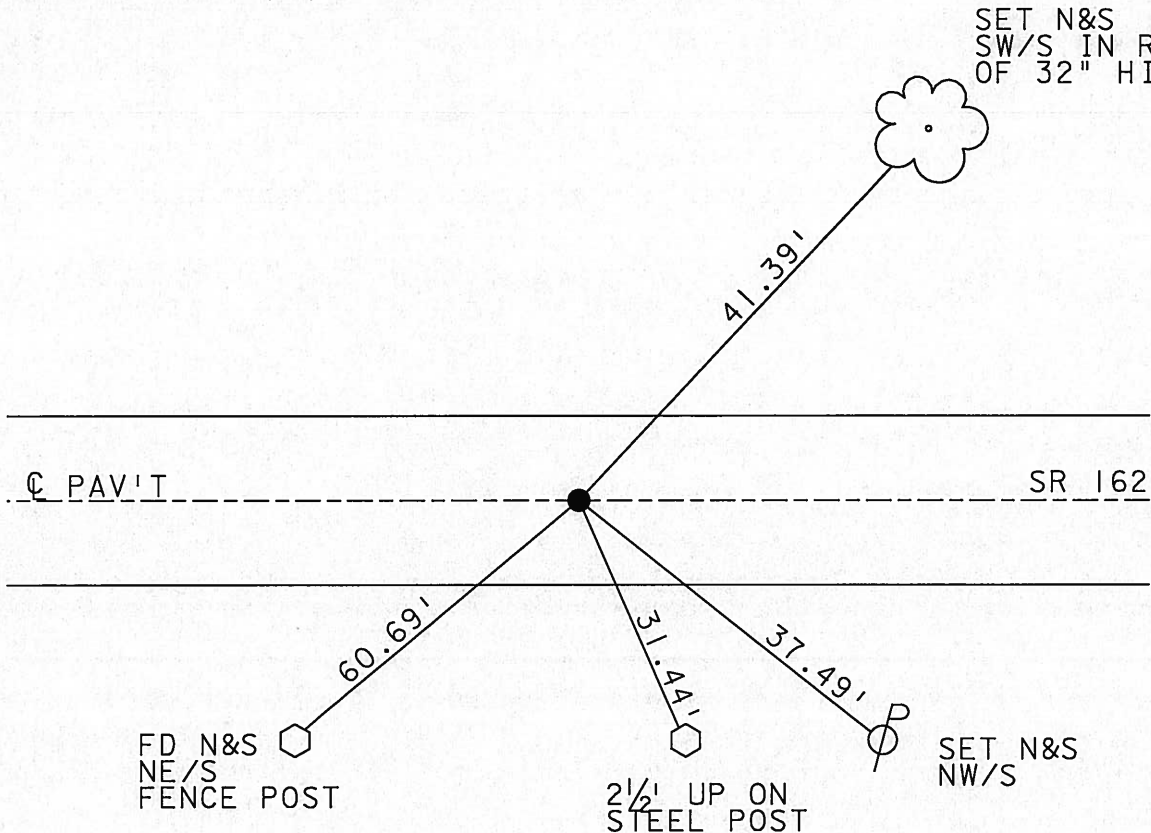

O.D.O.T. DISTRICT 2 SURVEY OFFICE

PERSONNEL

REFERENCE NO. 11

SHEET 10 OF 30

NOTES Pippie ~~Homan~~

H.C. Darbois ~~Homan~~

R.C. Geyman ~~Arms~~

DATE 4-14-04

WEATHER Sunny Windy Sunny

TEMP. 50° 55°

ROUTE 162

COUNTY Sen.

TOWNSHIP Scipio

SECTION 24

T 2 N R 16 E


TYPE MONUMENT P.K. + Washer

ON SURFACE - BELOW on

LEFT- & PAV'T. - RIGHT 3 1/2' LT. &

TO EDGE PAVEMENT

S.L.M. ~~138+01.65~~ 137+32

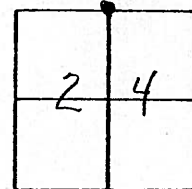

Fd PK Nail 1 1/2" Down

vent Down 7" No RR Spike or Signal on locator

Set

Root of 32" Hickory



41.02' 39°

37.49' 27.74'

31.43' 44'

60.72' 69°

Fd 2 1/2' up on steel post

Fence Post

Fg

SR 162

P.I. Δ = 0° 02' - 30" RT.

Point set by Jerry Weininger

Apr. 1984 N. 1/4 Coener Sec. 24

PLAN Record

P.I. Δ = 0° 01' RT

STA 294 + 43.3

Reset Mag Nail & Washer

10-06-04

PCH

O.D.O.T. DISTRICT 2 SURVEY OFFICE

PERSONNEL

REFERENCE NO. _____

SHEET _____ OF _____

NOTES RIPPLE

H.C. BARBOUR

DATE 2/05/91

ROUTE S.R.#162

R.C. HOFFMAN

WEATHER Cloudy

COUNTY Seneca

BARNHISEL

TEMP. 34°

TOWNSHIP Scipio

Loehrke

SECTION 13 & 24

T. R. N. R. 16 E



TYPE MONUMENT Alignment

ON SURFACE - BELOW _____

LEFT- & PAV'T. - RIGHT _____

TO _____ EDGE PAVEMENT

S.L.M. 2.79

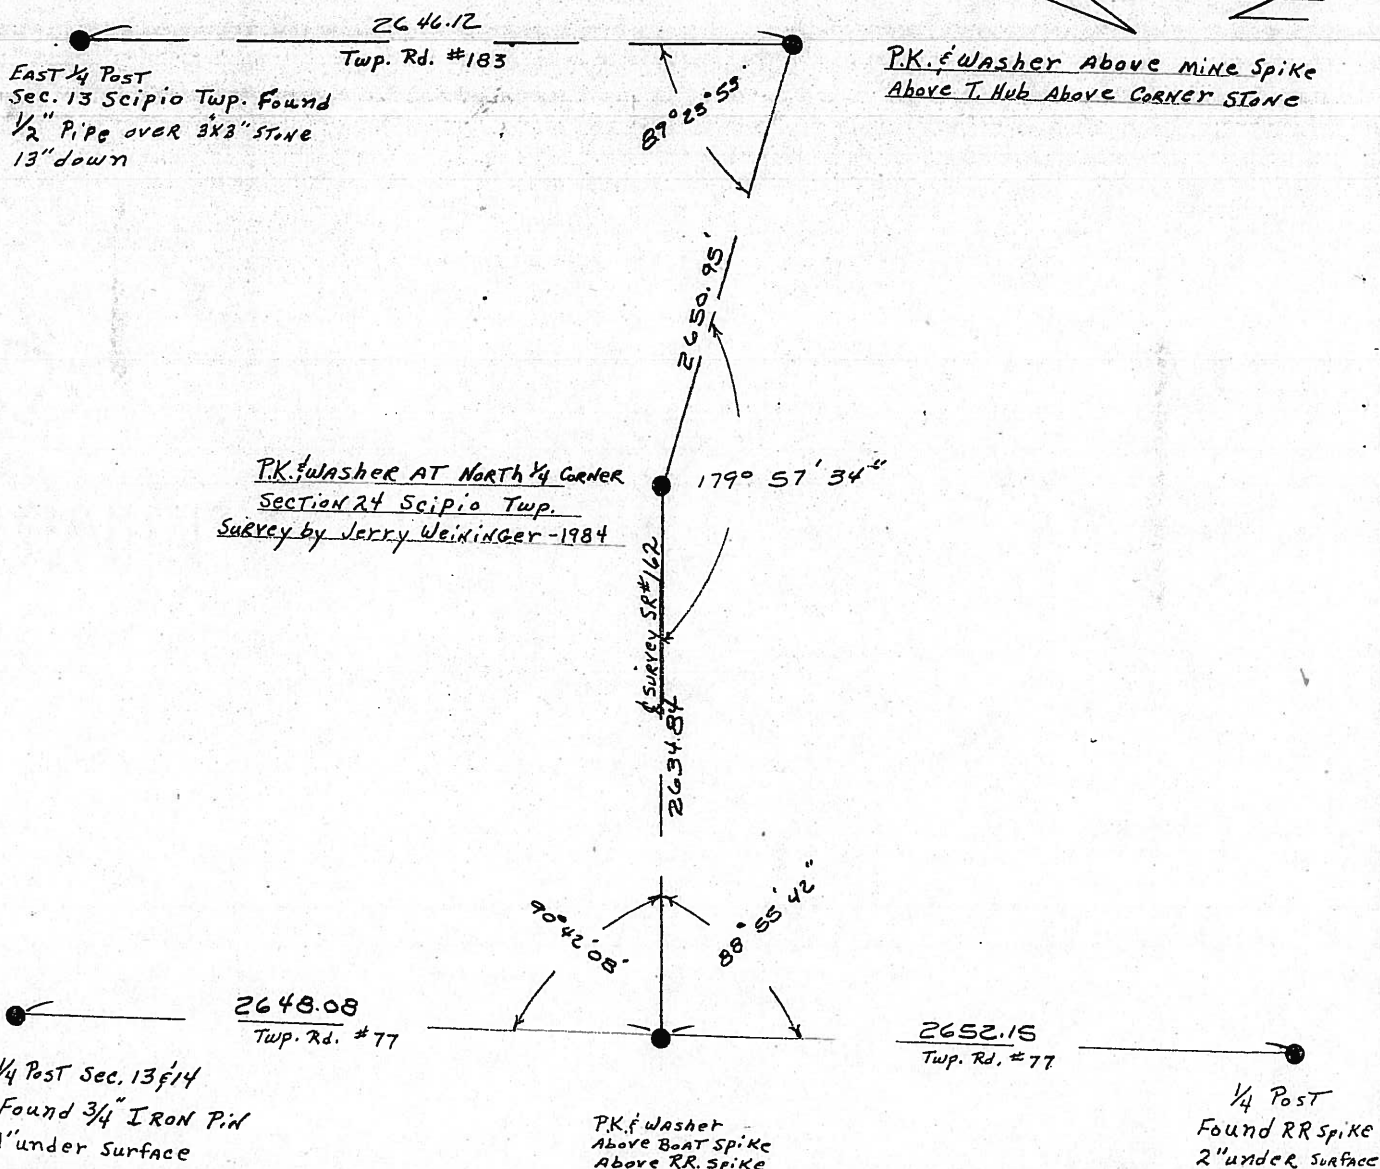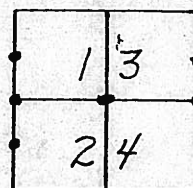

O.D.O.T. DISTRICT 2 SURVEY OFFICE

PERSONNEL _____

REFERENCE NO. 10

SHEET 11 OF 30

NOTES Purple

H.C. BARBOUR

R.C. Gay MAN

DATE 10-24-90

WEATHER _____

TEMP. 53°

ROUTE 162

COUNTY Sen

TOWNSHIP Scipio

SECTION 24

T 2 N R 16 E

TYPE MONUMENT Could Not Locate All Ties Gone

ON SURFACE - BELOW R/R Spike

LEFT- & PAV'T. - RIGHT _____


TO _____ EDGE PAVEMENT

S.L.M. _____

13	18
24	19



$\Delta = 0^{\circ} 01' RT$

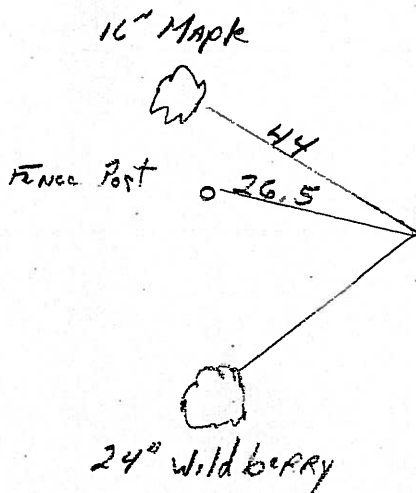

Same Point
as Previous
sheet

O.D.O.T. DISTRICT 2 SURVEY OFFICE

PERSONNEL _____

REFERENCE NO. _____

SHEET 10 OF 30

NOTES Purple

H.C. Barkbous

R.C. Geyman

DATE 10-23 90

WEATHER Sunny Windy

TEMP. 50°

ROUTE 162

COUNTY Sen.

TOWNSHIP Scipio

SECTION 24

T 2 N R 16 E


TYPE MONUMENT P.K. + Washer

ON SURFACE - BELOW _____

LEFT - € PAW'T. - RIGHT 3 1/2' LT. &

TO _____ EDGE PAVEMENT

S.L.M. 138 + 01.65

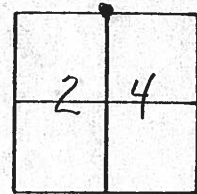

Root of 32" Hickory



41.03

27.74

31.43

60.72

2 1/2' up on steel post.

Fence Post

SR 162

P.I. Δ = 0° 02' - 30" RT.

Point set by Jerry Weininger

Apr. 1984 N. 1/4 COENER Sec. 24

PLAN Record

P.I. Δ = 0° 01' RT.

STA 294 + 43.3

O.D.O.T. DISTRICT 2 SURVEY OFFICE

PERSONNEL _____

REFERENCE NO. _____

SHEET 2 OF 3

NOTES HOFFMAN

H.C. LOCHRESE

R.C. BARNHART

DATE 6-25-90

WEATHER CLEAR

TEMP. 80°

ROUTE 162

COUNTY SENECA

TOWNSHIP Scipio

SECTION 24

T2 N R 16 E


TYPE MONUMENT P.K. / SKINER

ON SURFACE - BELOW YES

LEFT - PAV'T. - RIGHT 3, 4

6.4 TO Lt. EDGE PAVEMENT


S.L.M. 138 + 01.65

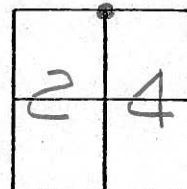

Record:

POINT set by Jerry Weinmayer
APRIL 1984.
NORTH 1/4 CORNER Sec. 24

P.I. $\Delta = 0^{\circ} - 02' - 30''$ RT.
MEAS 6-26-90

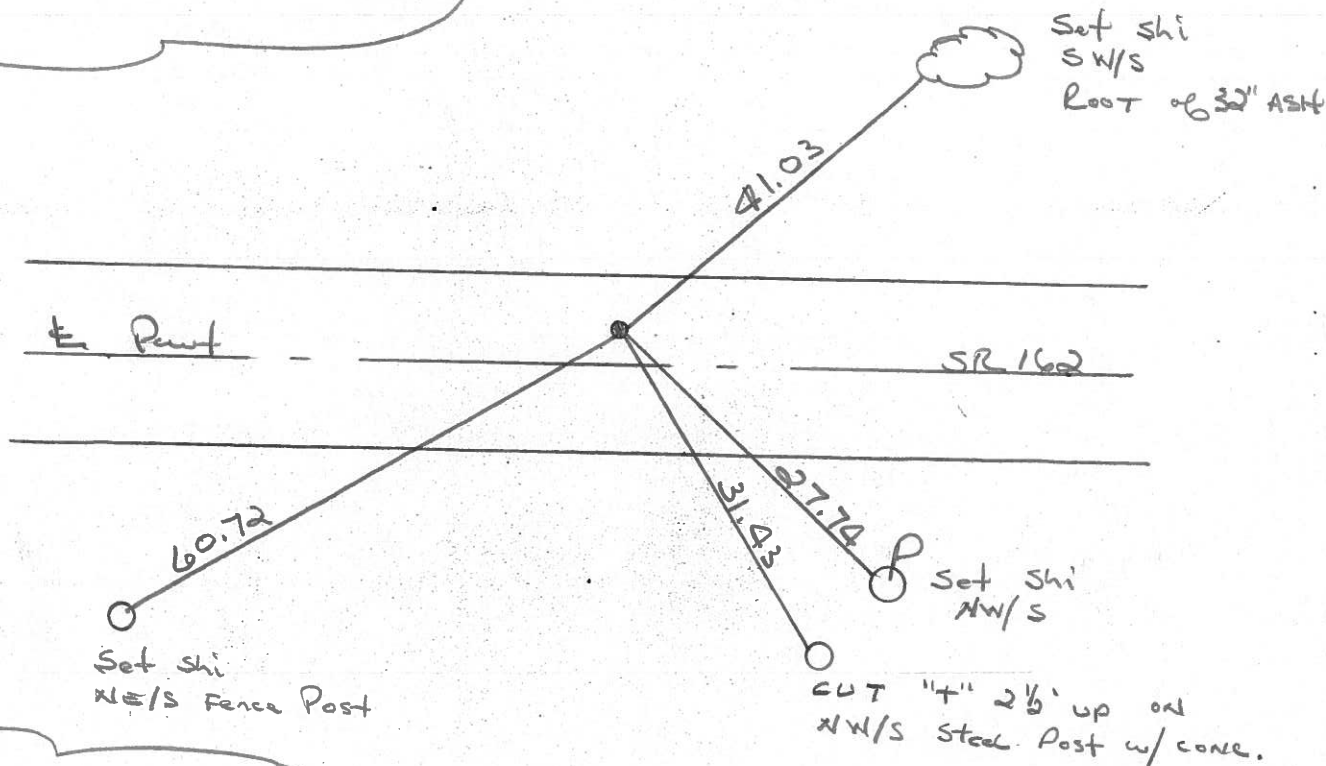

PLAN RECORD:

P.I. $\Delta = 0^{\circ} - 01'$ RT.
Sta. 294 + 43.3
R.R. SPK.

County Seneca S.R. 162

Date 6-11-79

Township Sciprio

Weather Fair

Section 13

Temp. 65°

T₂N, R₁₆E

Personnel Schneider
Mosser
Barbour

Sciprio Reed


13	18
X	
24	19



(11)



⊥ S.R. #162

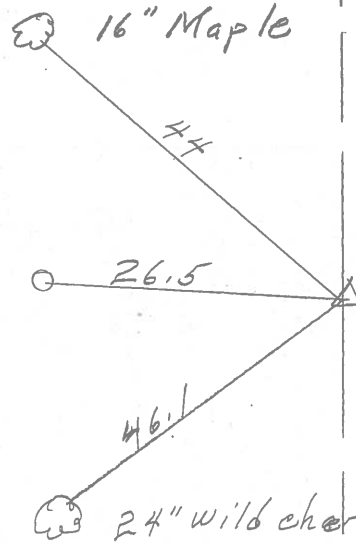

294 + 43.3

R.R. spk.

Δ = 0° 01' RT.

did not find


S. H. 499 Sec M.

(11)

294 + 43.3

R.R. Spike on E
 Did Not Find
 4-14-04

(7)

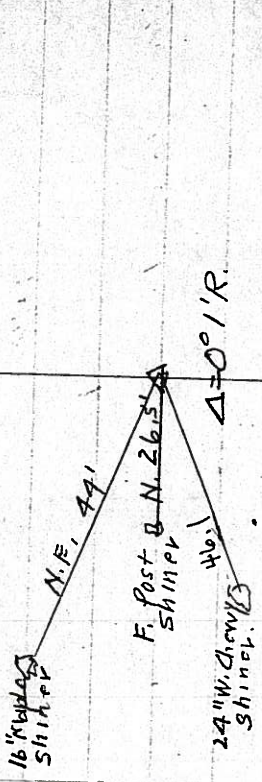


(12)

320 + 95

Cor. Stone, Hub with Takeover
 stone

(10)

$\Delta = 89^{\circ} 56' L.$

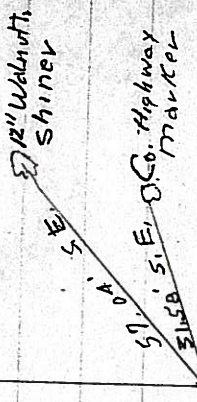


(12-A)

321 + 35.3

(11)

Fd 4-20-65

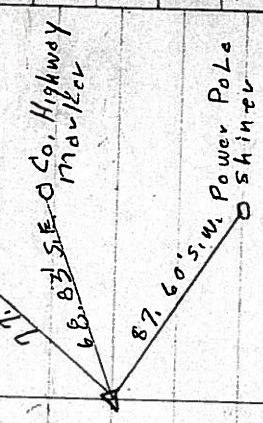

(13)

330 + 97.5

R.R. Spike on E
 Fd 4-20-04

(12)

