

PERSONNEL

TITLE

PERSONNEL

TITLE

SHEET NO. 11

Cronin

BARRON

COUNTY *SENECA*

DATE *9/7/81*

Riddie

S. R. # *221*

WEATHER *SUNNY*

Geyman

SEC. *15.16A - 20.81 - SLM*

TEMP. *56°*

Mosser


DESCRIPTION *1982 Maintenance Program*

LEFT


CENTER LINE

RIGHT

JOB NO.

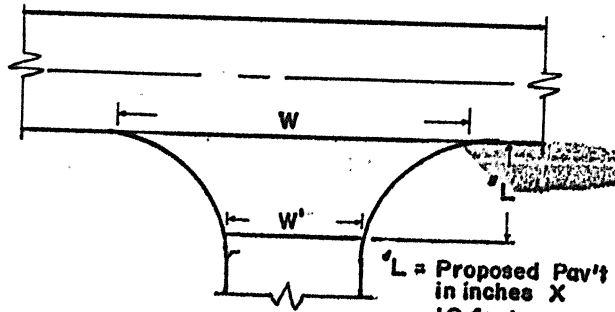

INTERSECTION TYPICAL

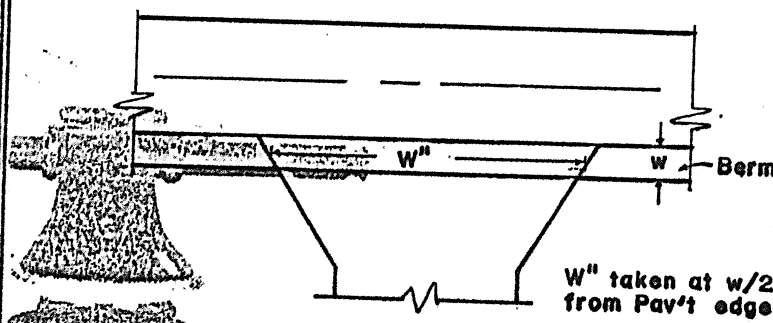

DRIVEWAY TYPICAL

STATION	RT. LT.	L	W	W'	Asph	Conc		STATION	RT. LT.	w	W''	Asph	Conc	Aggr	Dropped Curb Feather NOT Req'd
828+00	Lt.	12.5	268	150	✓	10		829+90	Lt.	3'	76	✓			
830+00	Lt.	12.5	154	96	✓	10		832+95	Lt.	3 1/2'	80	✓			combination berm over
861+93	Lt.	12.5	94	68	✓	Temp Rd #1173		833+94	Lt.	3'	67	✓			
871+01	Lt.	12.5	79	41	✓	old office		874+55	Rt.	3'	23	✓			bermed over
887+43	Rt.	12.5	73	31	✓	Temp Rd #117		876+25	Rt.	3'	25	✓			" "
887+43	Lt.	12.5	67	33	✓	Co. Rd #11		879+62	Lt.	3 1/2'	70	✓			M.B. App. bermed over
910+58	Rt.	12.5	69	34	✓	Temp Rd #117		880+31	Lt.	3 1/2'	57	✓			" " "
910+91	Lt.	12.5	64	34	✓	Temp Rd #117		881+70	Rt.	3'	33	✓			bermed over
923+11	Rt.	12.5	50	24	✓	Temp Rd #165		881+72	Lt.	3 1/4'	59	✓			M.B. App. bermed over
924+52	Lt.	12.5	55	29	✓	Co. Rd #17		882+06	Rt.	3'	32	✓			bermed over
								883+16	Lt.	3 1/2'	69	✓			M.B. App.
								883+34	Rt.	3'	32	✓			bermed over
								885+12	Lt.	3 1/2'	68	✓			M.B. App. bermed over
								885+81	Rt.	3'	32	✓			driv butted to berm
								925+23	Rt.	3 1/2'	80	✓			M.B. App. bermed over
								946+81	Rt.	3 1/2'	70	✓			" " "
								947+14	Lt.	3'	31	✓			bermed over
								949+13	Lt.	3'	29	✓			butted to berm
								950+15	Lt.	3'	29	✓			" " "
								950+16	Rt.	3 1/2'	100	✓			M.B. App. bermed over
								960+97	Rt.	3 1/2'	60	✓			" " " "
								972+01	Rt.	3 1/2'	100	✓			" " " "
								985+52	Rt.	3 1/2'	90	✓			M.B. App. bermed over half butted
								1007+40	Rt.	3 1/2'	71	✓			2 M.B. bermed over