

TWO-LANE RESURFACING PROGRAM

PRIORITY NO. 9 PART 1 OF 2 1067 SHEET 1 OF 3

COUNTY Seneca ROUTE US 224 SECTION 28.13

BEGIN LOG (SLM) 28.13 (const. joint) TERMINI match const. joint

END LOG (SLM) 32.10 TERMINI Huron County Line

TOTAL LENGTH 3.97 MILES 1513+37 North 1545+57
1495+08 South 1560+15

MUNICIPALITY Attica BEGIN LOG (SLM) 28.59 (Rt.) END LOG (SLM) 29.54 (L)

MUNICIPALITY _____ BEGIN LOG (SLM) _____ END LOG (SLM) _____

PROPOSED WORK:
PAVEMENT 1 1/2" 404 SHOULDER Same, 617

OTHER Grind 5' ± @ curb lines in Attica

EXISTING DATA:

SLM <u>1486+22</u> TO _____	PAV'T WIDTH <u>20'</u> (type _____)	SHLD WIDTH <u>3'</u> (type <u>PAVED</u>)
SLM <u>1513+37</u> TO _____	PAV'T WIDTH <u>30.5'</u> (type _____)	SHLD WIDTH <u>CURB</u> (type <u>ET.</u>)
SLM <u>1515+60</u> TO _____	PAV'T WIDTH <u>30.5'</u> (type _____)	SHLD WIDTH <u>CURB</u> (type <u>ET.</u>)
SLM <u>1520+62</u> TO _____	PAV'T WIDTH <u>40'</u> (type _____)	SHLD WIDTH <u>CURB</u> (type _____)
SLM <u>1522+57</u> TO _____	PAV'T WIDTH <u>54'</u> (type _____)	SHLD WIDTH <u>1'</u> (type _____)
SLM <u>1527+18</u> TO _____	PAV'T WIDTH <u>48'</u> (type _____)	SHLD WIDTH <u>1'</u> (type _____)
SLM <u>1529+42</u> TO _____	PAV'T WIDTH <u>36'</u> (type _____)	SHLD WIDTH <u>1'</u> (type _____)
SLM <u>1540+08</u> TO _____	PAV'T WIDTH <u>25'</u> (type _____)	SHLD WIDTH <u>3'</u> (type <u>PAVED</u>)
SLM <u>1548+00</u> TO _____	PAV'T WIDTH <u>25'</u> (type _____)	SHLD WIDTH <u>2'</u> (type <u>"</u>)
SLM <u>1584+64</u> TO _____	PAV'T WIDTH <u>25'</u> (type _____)	SHLD WIDTH <u>2'</u> (type <u>"</u>)
SLM <u>1637+72</u> TO _____	PAV'T WIDTH <u>25'</u> (type _____)	SHLD WIDTH <u>2.5'</u> (type <u>"</u>)
SLM <u>1690+76</u> TO END STA. <u>1695+63</u>	<u>25' WIDE, 5.5' SHLD.</u>	

STRUCTURES:

STR. NO. <u>SEN-224-29.67</u>	WIDTH <u>49.5'</u>	LENGTH <u>12'</u>	PROP. WORK <u>(BEGINNING STA 1413+20)</u>
STR. NO. _____	WIDTH _____	LENGTH _____	PROP. WORK _____
STR. NO. _____	WIDTH _____	LENGTH _____	PROP. WORK _____
RAILROAD CROSSING:

NAME <u>N.S.</u>	STATION <u>1542+38</u>	NO. TRACKS <u>1</u>	LENGTH ALONG C L <u>8.5'</u> ft
NAME _____	STATION _____	NO. TRACKS _____	LENGTH ALONG C L _____ ft
NAME _____	STATION _____	NO. TRACKS _____	LENGTH ALONG C L _____ ft

MISCELLANEOUS:

NO. RAISED PAVEMENT MARKERS; EDGE OF PAVEMENT 0, CENTERLINE 217

NO. MAILBOX APPROACHES 0, MAILBOX SUPPORTS 0

REMARKS:

Butt joint @ RR. crossing; In Attica @ SR 4 intersection, eastbound
pickup bad part both east and west of SR 4 (about 12' x 1000' long).
Use 1 3/4" 402 & grind. (GCM 28.13 = 1485+26.4)

① BEGIN STA. @ CONST. JOINT STA. 1486+22 ESTABLISHED

By CONTINUING S.L.M. FROM U.S. #224 RESURFACING PROJECT
SLM. 19.82 TO 29.17. ② P.I. @ STA. 1508+74 = (STA. 1562+12.5 OF BRIDGE
SURVEY OF OT-224-29.67)

1992 TWO-LANE RESURFACING PROGRAM

APPROACHES (INTERSECTIONS & DRIVES)

SHEET 2 OF 3

COUNTY Seneca

ROUTE US 224

SECTION 28.13

L = Prop Pav't Depth(in.) x 10; W = Width @ Mouth; W-1 = Width @ Throat

[illegible]

* SEE SHEET # 1-3 ADD. PAU. INFO.

PERSONNEL CHENEY TITLE LD PERSONNEL BARBOUR TITLE R.TAPE COUNTY SENECA DATE 8-27-1992
RIFFLE H.TAPE S. R. US #224 WEATHER CLOUDY
 SEC. 28.13-32.10 TEMP. 75°

DESCRIPTION ADDITIONAL PAU'T. INFORMATION JOB NO. 026112-74
 LEFT CENTER LINE RIGHT

STA	LT.	RT.	DESCRIPTION
1513+37		✓	BEGIN CURB IN ATTICA
1515+60	✓		" " " "
1539+87	✓		END CURB IN ATTICA
1541+51		✓	" " " "

NOTE: ON SIDE STREETS WHERE THROAT & MOUTH WERE NOT MEASURED - TYP SECTIONS

EXAMPLE #1

EXAMPLE #2


DESCRIPTION	LEFT	CENTER LINE	RIGHT	JOB NO.
LOCATION OF BROKEN PAV'T.				026112-74

STATION	LT LANE	RT LANE	WIDTH	
1511+13	✓		11'	BEGIN
1514+00	✓		11'	END

NOTE: EAST BOUND LANE IS CRACKED S.R. #4 TO END OF PROJECT. 6" 1/2 WIDTH OF LANE NEAR RT. EIP FROM

THIS PAVEMENT IS NOT KICKING-OUT.

PERSONNEL TITLE PERSONNEL TITLE COUNTY SENECA DATE 8-27-1992
CHEVEY H. TAPE U.S. # 224
RIPPLE R. TAPE S. R. WEATHER CLOUDY
BARBOUR SEC. 28.13-32.10 TEMP. 75°
 DESCRIPTION PAV'T. MARKINGS ON 224 JOB NO. 026112-74

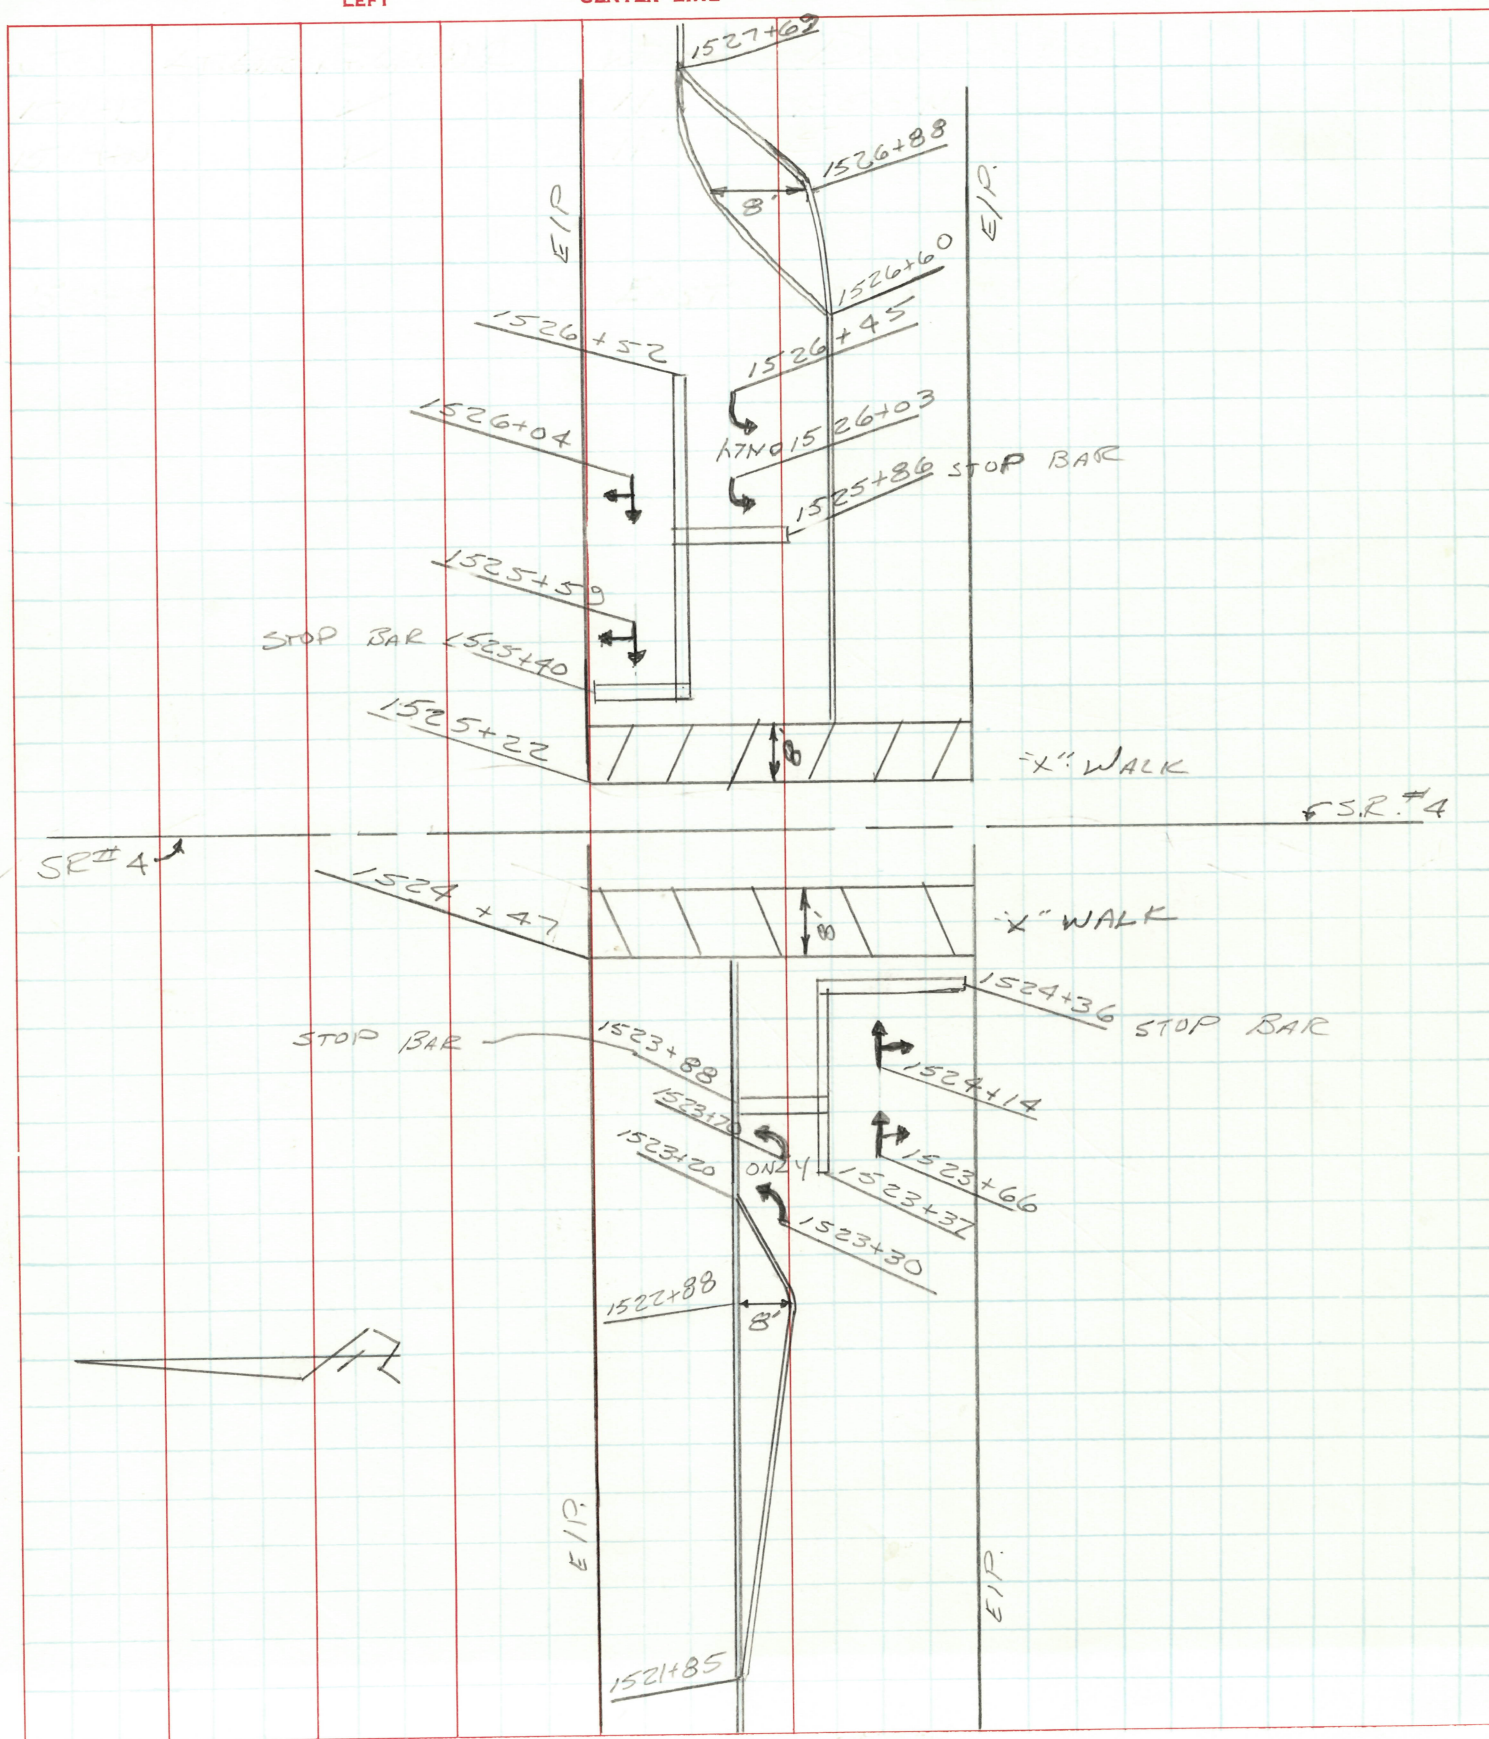

PERSONNEL CHENEY TITLE [initials] PERSONNEL BARBOUR TITLE R. TAPE
COUNTY SENECA DATE 8-27-1972
S. R. U.S. #224 WEATHER CLOUDY
SEC. 28.13-32.10 TEMP. 75°
DESCRIPTION PAV'T. MARKINGS ON 224 JOB NO. 026112-74

