

O.D.O.T. DISTRICT 2 SURVEY OFFICE (USE ONLY)

PERSONNEL

REFERENCE NO. 1A-1D

NOTES MILLER
H.C. MILLER
R.C. _____

DATE 8/13/25
WEATHER CLEAR
TEMP. 55°

ROUTE US 224
COUNTY SENECA
TOWNSHIP LOUDON
SECTION 31
T 2 N R 13 E

DWG BY BARRIERE PID 97425

TYPE MONUMENT MAG NAILS

ON SURFACE - BELOW ON

OFFSET $\varnothing$ PAVEMENT ON LT : RT

STATION: 06+25

HORIZ.DATUM: SEN OCCS


GEOID: 18

GRID: NORTHING: _____

EASTING: _____

LDP: NORTHING: 284289.069

EASTING: 89350.272

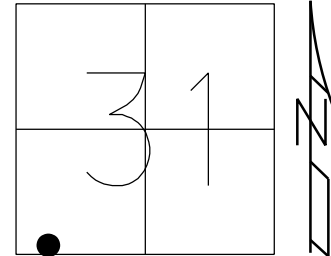

FD MAG NAILS
INSTALLED W/ PROJECT 97425

REF1A
REF1B
REF1C
REF1D
4/22/25, JAM

REF1A
STA 06+25.00
N: 284406.041
E: 89964.251

REF1B
STA 06+55.00
N: 284411.614
E: 89993.715

REF1C
STA 07+15.00
N: 284422.851
E: 90052.619

REF1D
STA 07+45.00
N: 284428.472
E: 90082.137

