
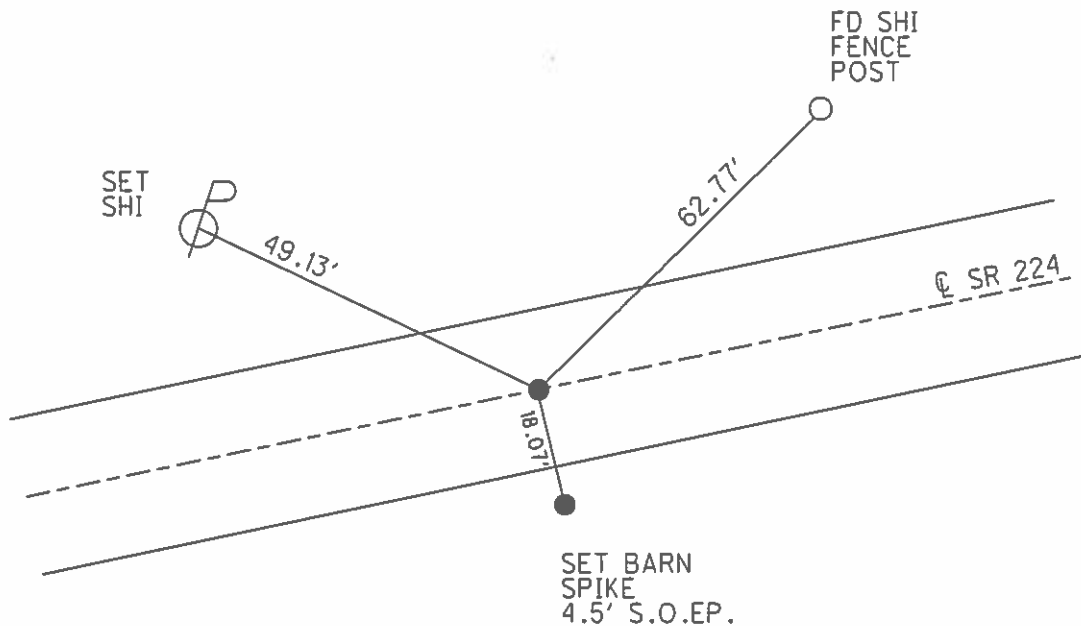


O.D.O.T. DISTRICT 2 SURVEY OFFICE (USE ONLY)

PERSONNEL _____ REFERENCE NO. 22 SHEET 23 OF 39
 NOTES WESTFALL DATE 6/12/13 ROUTE SR 224
 H.C. ROUSOS WEATHER FAIR COUNTY SENECA
 R.C. HOMAN TEMP. 73° TOWNSHIP LOUDON
 _____ SECTION 36
 _____ T 2 N R 13 E

TYPE MONUMENT P.K.NAIL
~~ON SURFACE~~ - BELOW 3"
 LEFT - ☉ PAV'T - RIGHT ON
- TO - EDGE PAVEMENT
 S.L.M. 282+95
 Grid: Northing: 521195.829 Easting: 1742379.170

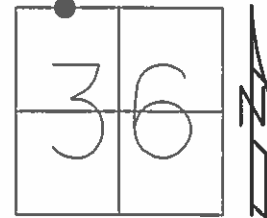


RECORD: P.I.
 $\Delta = 0^\circ 10' RT$
 FD P.K. NAIL
 12/3/63, KRABILL

FD P.K. NAIL
 4" DOWN
 2/10/12, DCH
 GPS, REF23


SET MAG/WASHER
 GPS, REF23
 7/23/14, EBW

| PERSONNEL | TITLE | PERSONNEL | TITLE |
|---|-------|-------------|-------|
| | | | |
| COUNTY <u>Seneca</u> DATE <u>3-22-71</u> | | | |
| S. R. <u>2.24</u> WEATHER <u>cloudy</u> | | | |
| SEC. <u>0.00</u> TEMP. <u>40°</u> | | | |
| DESCRIPTION <u>Hancock Co. Line to Tiffin</u> JOB NO. _____ | | | |
| | LEFT | CENTER LINE | RIGHT |

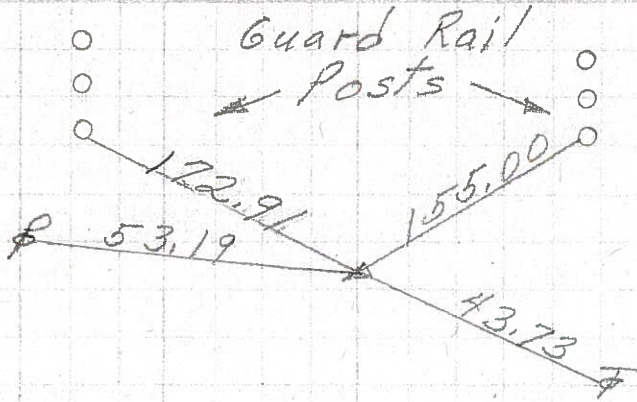

(23) 289 + 87.50
 $\Delta = 0^{\circ} 04' Lt.$
 P. K. Nail
 1" down


8569

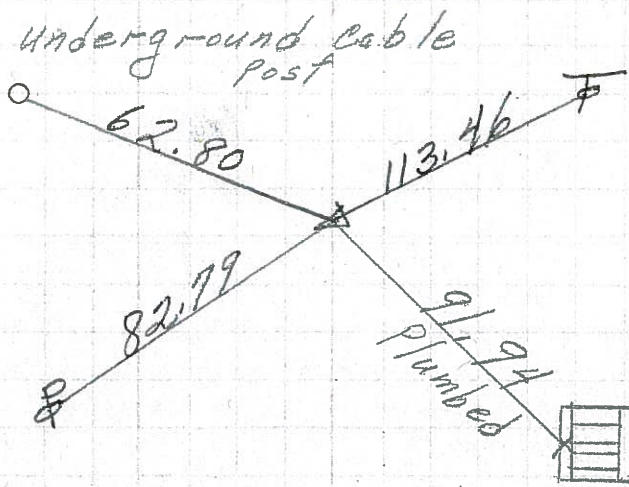

(22) P.I.
 282 + 95.4
 $\Delta = 0^{\circ} 10' Rt.$
 P. K. Nail

"X" on C.B.

8568

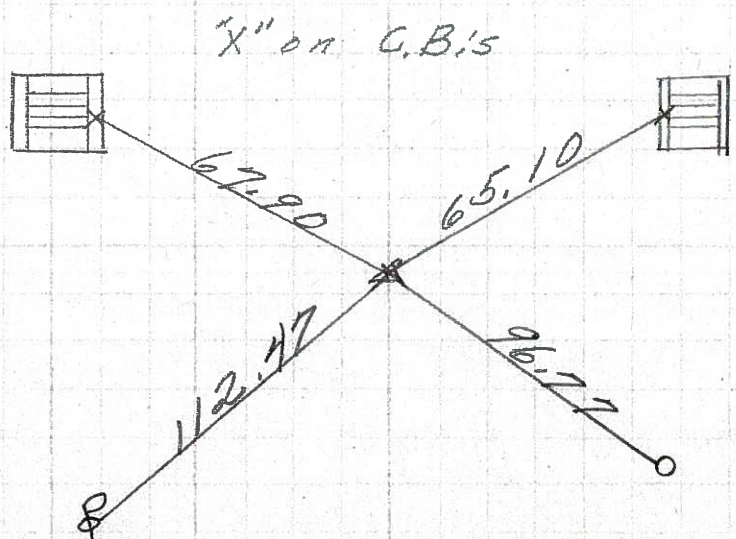

(21) 265 + 30.06
 $\Delta = 0^{\circ} 09' Rt.$
 P. K. Nail

Cor. Post

8567

PERSONNEL TITLE PERSONNEL TITLE

E. Krabill

COUNTY SENECA

DATE

J. Kowalski

S. R. 224

WEATHER

D. Brooks

SEC.

TEMP.

DESCRIPTION

LEFT

CENTER LINE

RIGHT


JOB NO.

282+95.4 ⁽²²⁾ #607
P.I. 40°-10' RT

shiner in under ground
cable marking post

P.K. nail

1/4 (25)

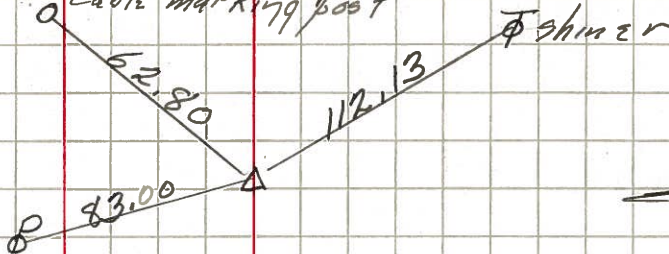

1/4 (36)

12-3-63

(23)

289+87.5 #608
P.I. 40°-04' LT

shiner

Guard Rail

shiner

Tacked Hub
292+00
81.6

Transit Tie NE

172.78
154.91
TIE S.E.

N.E. Co
Conn.
Crib

Sta. 292+30
500 estimate

Ties not too good
Did not set point

Transit NW

44.03 shiner

1/8 (25)

12-4-63

Tacked Hub.
289+50
62.2

shiner in line fence
orange post 4' above ground

(24)

297+73.4 #609
P.I. A-0°-06' LT

shiner in cor fence post

P.K. nail

shiner in 16'
Locust

84.75

50.36

shiner cor. fence post

12-4-63

shiner in 12" Batter nail

1/2 (25)