


O.D.O.T. DISTRICT 2 SURVEY OFFICE (USE ONLY)

PERSONNEL _____ REFERENCE NO. 27 A SHEET 29 OF 39
 NOTES HOMAN DATE 6/7/16 ROUTE SR 224
 H.C. HOMAN WEATHER CLOUDY COUNTY SENECA
 R.C. ROUSOS TEMP. 55° TOWNSHIP HOPEWELL
 _____ SECTION 30
 _____ T 2 N R 14 E

TYPE MONUMENT MAG NAIL
 ON SURFACE - ~~BELOW~~ ON
 LEFT - ☉ PAV'T - RIGHT ON
- TO - EDGE PAVEMENT
 S.L.M. 380+56

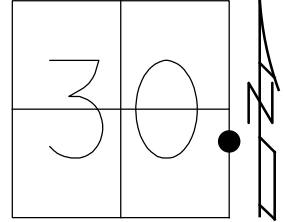


Grid: Northing: 522939.273 Easting: 1751969.768

RECORD:
 FD LG.R.R.SPIKE
 4/16/04, DCH

SET MAG/WASHER
 8/6/04, SAH
 FD MAG NAIL
 2/10/12, DCH

SET MAG/WASHER
 GPS, REF27
 7/23/14, EBW

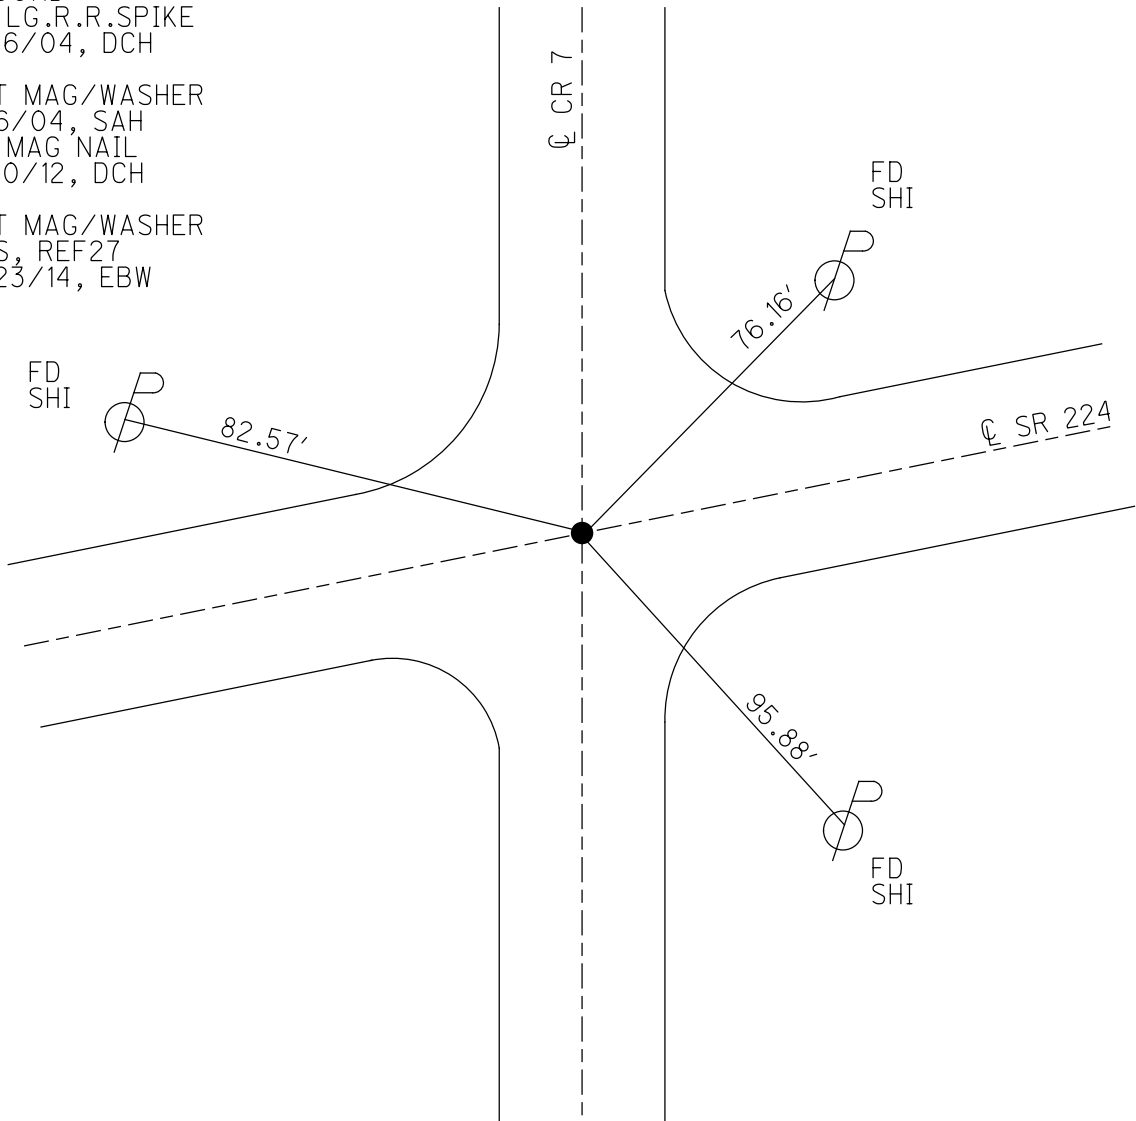

O.D.O.T. DISTRICT 2 SURVEY OFFICE

PERSONNEL

REFERENCE NO. 27-A

SHEET 3 OF 26

NOTES NUHFER

DATE 04-16-04

ROUTE US 224

H.C. HOOKER

WEATHER SUNNY

COUNTY SENECA

R.C. HOMAN

TEMP. 55°

TOWNSHIP HOPEWELL

SECTION 29&30

T 2 N R 14 E


TYPE MONUMENT LG RR SPIKE

~~ON SURFACE~~ - BELOW 5 1/2"

~~LEFT - C~~ PAV'T - ~~RIGHT~~ ON

TO EDGE PAVEMENT

S.L.M. 380+68

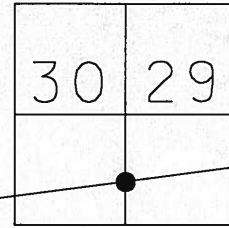

UNKNOWN ORIGIN

SET MAG NAIL
& WASHER
8-06-04
SAH

