


O.D.O.T. DISTRICT 2 SURVEY OFFICE (USE ONLY)

PERSONNEL \_\_\_\_\_ REFERENCE NO. 67 SHEET 10 OF 37  
 NOTES RHOADES DATE 11/7/23 ROUTE US 224  
 H.C. AUBLE WEATHER CLOUDY COUNTY SENECA  
 R.C. ASTON TEMP. 54° TOWNSHIP BLOOM  
           NIESE SECTION 4  
 DWG BY RHOADES PID 101217 T 1 N R 16 E


TYPE MONUMENT MAG/WASHER  
 ON SURFACE - ~~BELOW~~ ON  
 OFFSET Q PAVEMENT ON LT : RT  
10.7' TO RT EDGE PAVEMENT  
 STATION: 1132+08.65

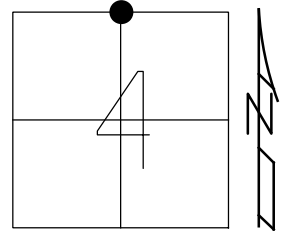

HORIZ.DATUM: NAD83 2011 GEOID: NAVD88 2018  
 GRID: NORTHING: 515752.761 EASTING: 1823822.449

RECORD: P.I.  
 STA. 1182+50.91  
 FD BOAT SPIKE/WASHER  
 2" DOWN  
 ATOP R.R.SPIKE  
 10/28/82  
 FD P.K./WASHER  
 6/30/92, JLR  
 SET P.K./WASHER  
 11/30/92, JLR

FD P.K./WASHER  
 1/17/08  
 SET MAG/WASHER  
 8/4/09, MB  
 10/14/09, KPM  
 FD MAG NAIL  
 REF67  
 9/1/20, DSA  
 SET MAG/WASHER  
 11/7/23, DSA

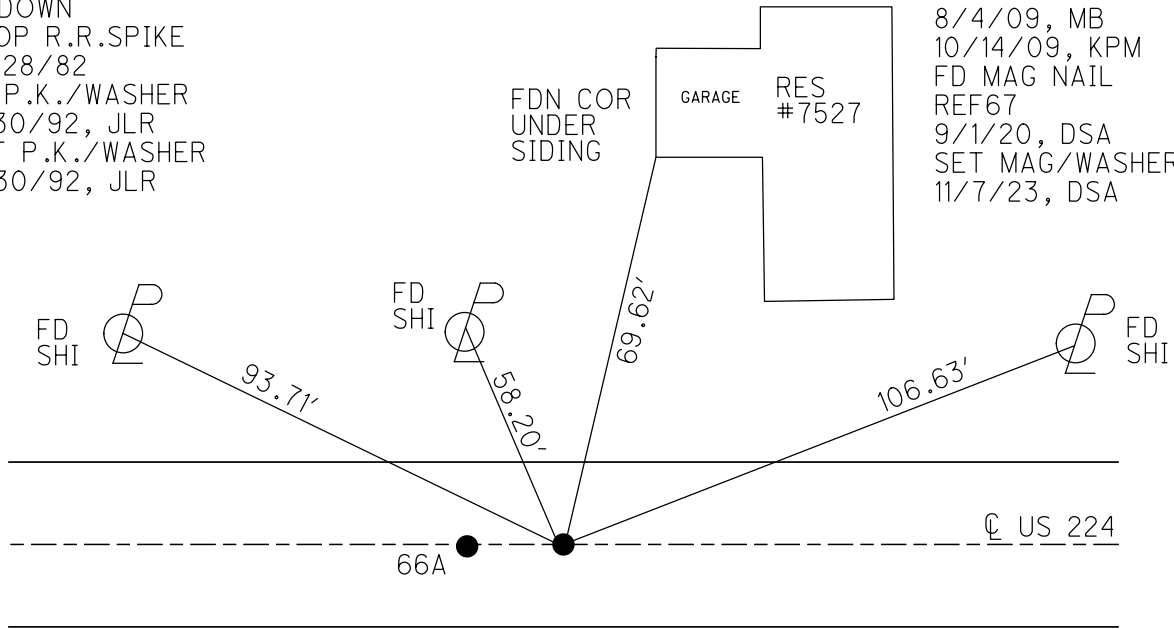

DIST. 66A-67= 9.91'

O.D.O.T. DISTRICT 2 SURVEY OFFICE

PERSONNEL \_\_\_\_\_

REFERENCE NO. 67

SHEET 8 OF 35

NOTES Moser

DATE 8-4-09

ROUTE U.S. 224

H.C. Moser

WEATHER Fair

COUNTY SENECA

R.C. Pietkowski

TEMP. +40°

TOWNSHIP BLOOM

Goldberg

SECTION 4

T. 1 N R. 16 E


TYPE MONUMENT P.K./WASHER

ON SURFACE - ~~BELOW~~ ON

LEFT - ☉ PAV'T - RIGHT ON


10.7' TO RT EDGE PAVEMENT

S.L.M. 1132 + 08.65

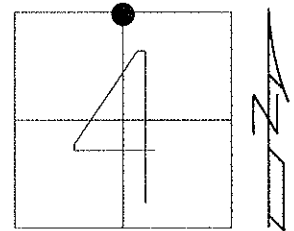

Grid: Northing: 515752.843 Easting: 1823822.382

RECORD: 10-28-82  
 PI STA 1182+50.91  
 BOAT SPK & WASHER 2"  
 BELOW SURFACE ATOP RR SPK  
 HUB FIELD BOOK 54 (FROM LOFT)  
 SET MAG/WASHER 8-4-09

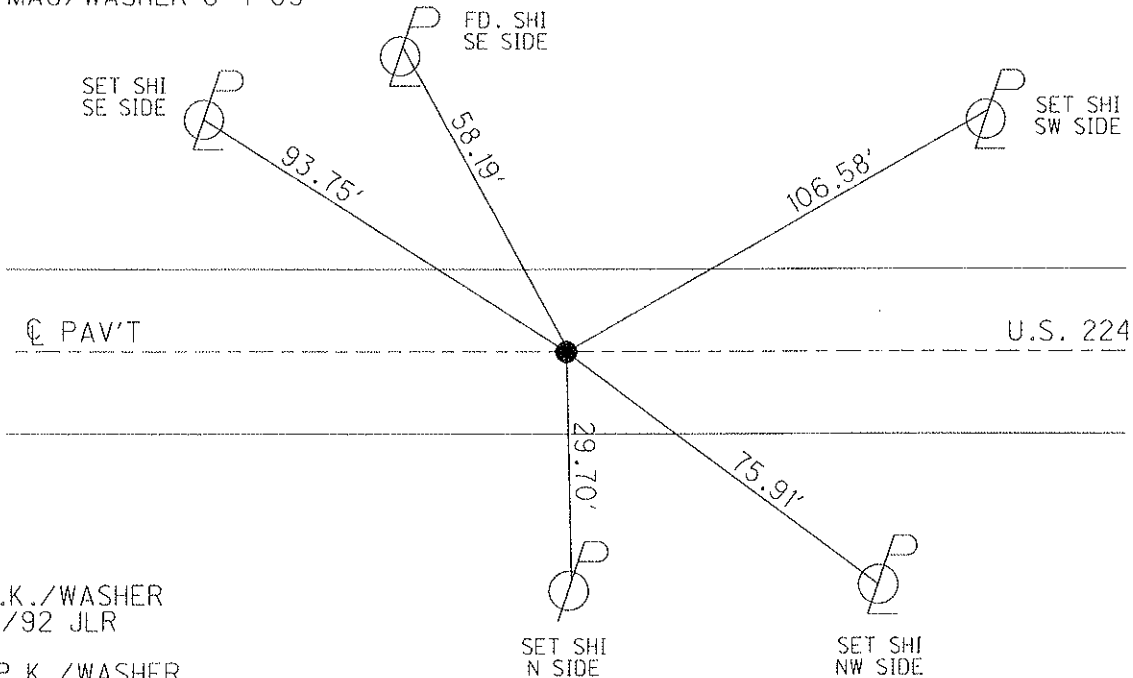

FD P.K./WASHER  
 6/30/92 JLR

SET P.K./WASHER  
 11/30/92 JLR

FD P.K./WASHER  
 1/17/08

SET MAG/WASHER  
 8/4/09 MB

RESET MAG/WASHER  
 10/14/09 KPM

O.D.O.T. DISTRICT 2 SURVEY OFFICE

PERSONNEL

REFERENCE NO. 67

SHEET 6 OF 32

NOTES Cheney

H.C. RIPPLE

R.C. BARBOUR

Geyman

DATE 6-30-92

WEATHER Cloudy

TEMP. 55°

ROUTE U.S. 224

COUNTY Seneca

TOWNSHIP Bloom

SECTION 4

T 1 N R 16 E

TYPE MONUMENT <sup>6-30-92</sup> Fd. P.K. E Washer


ON SURFACE - ~~BELOW~~ yes

~~LEFT - & PAV'T. - RIGHT~~ yes


10' TO RT. EDGE PAVEMENT

S.L.M. 1131+65

Set P.K. E Washer  
11-30-92  
J.L.R.

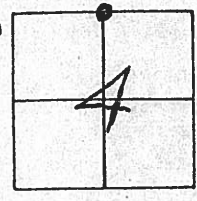

Record: 10-28-82  
P.I. STA. 1182+50.91  
Boat Spk. E Washer 2"  
below surface at Top RR. Spk.  
Hub-Field Book #54 (From Left)

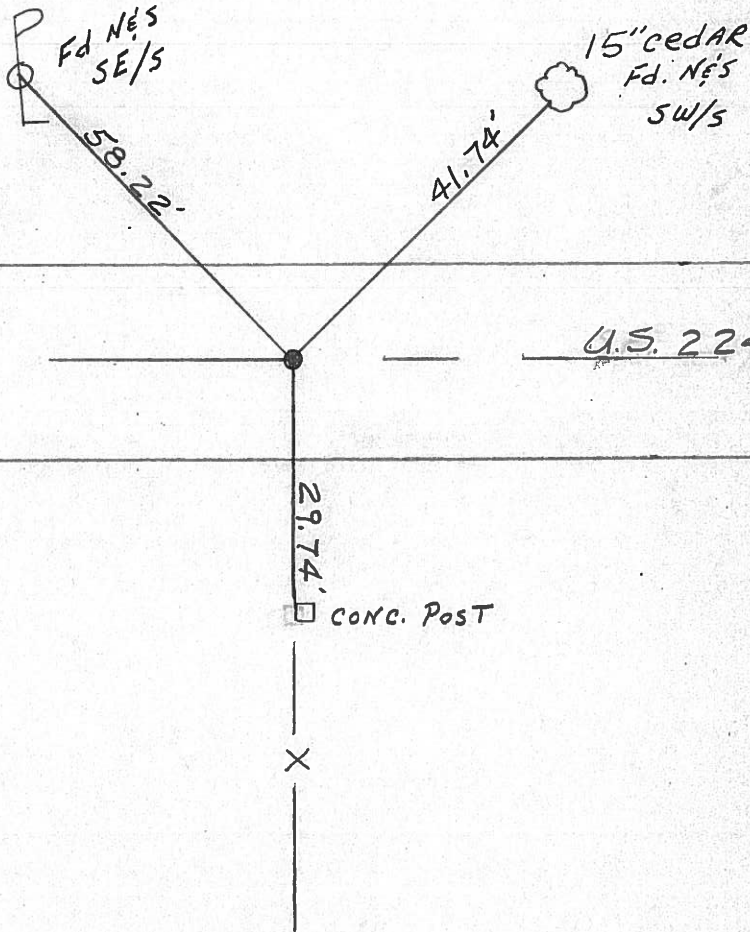

County Seneca S.R. 224

Township Bloom

Section 4

T1N, R16E

Personnel Cronin

Ripple

Geyman

Mosser


Barbour

67


Date 10/28/82 Drawn 11/02/82

Weather sunny

Temp. 60°

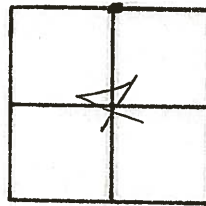

P.I.  
1182+50.91  
Boat spike & washer 2"  
below sur face atop R.R. spike  
Sub-Field Book #54 (from left)

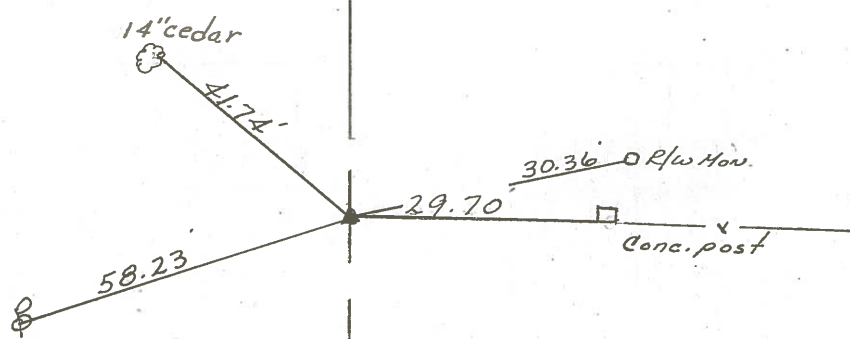

R/W U.S. #224A



PERSONNEL TITLE PERSONNEL TITLE

COUNTY Seneca

DATE 3-25-68

Schneider

Mosser

Barbour

Pott

S. R. U.S.# 224

WEATHER Fair

SEC. SR #100 to Attica

TEMP. 40°

DESCRIPTION Ties for Control Points

JOB NO.

LEFT

CENTER LINE

RIGHT

(69)

P.O.T.

1221+34.86

Reset <sup>boat</sup> small spk. <sup>washer</sup>

1223±

8615

11480


1245

1245

1245

set PK <sup>washer</sup>

2 No of PK Pkt.

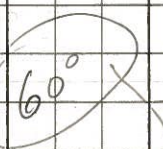

P.I.

R.R. spk. 3' down

1208+89.68

Reset <sup>boat</sup> small spk.

8614

North

R.R. tie

(68)

1184+13± Did not reset

P.I.

small R.R. spk. 2" down

1182+50.91

Reset small spk.

8613

Ed boat spk <sup>washer</sup>

(67)

14" Cedar

74

74

30.36

34

30.44

30.44

29.30

29.30

R/w Mon.

Conc. Post

S.E. Cor. drill hole in hawl.

set PK <sup>washer</sup>

S.R. #19

South

5/24/82  
12" Twin Ash overcast  
stump 60°  
Box edder

set PK <sup>washer</sup>

Box edder

Box edder

PERSONNEL	TITLE	PERSONNEL	TITLE	COUNTY	DATE
Krabill				Seneca	
Kowaleski				S. R. 224	WEATHER
Brooks				SEC.	TEMP.

DESCRIPTION	LEFT	CENTER LINE	RIGHT	JOB NO.
-------------	------	-------------	-------	---------

