

County Seneca S.R. 224

Township Reed

Section 32


T2N, R12E

Personnel Cronin
Ripple
Geuman
Mosser
Barbour

Date 11/02/82 Drawn 11/05/82

Weather sunny-windy

Temp. 65°

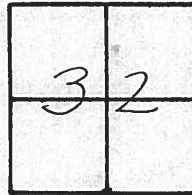


P.I.

5 1/4 Post Sec. 32

stone

Field Bk. #59, Pg 8 from left

No Ties

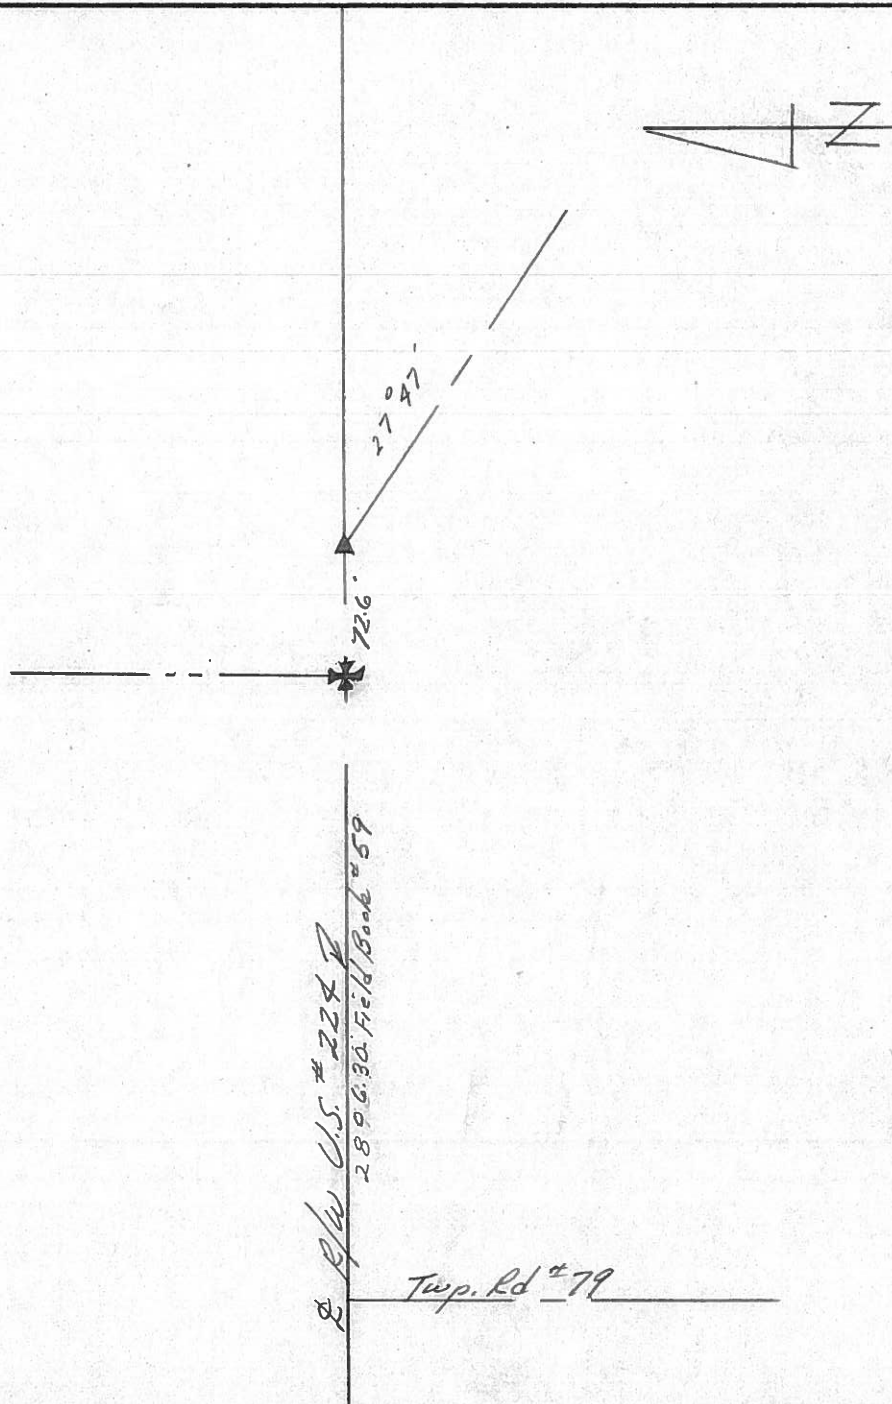

E. R/W U.S. # 224
2896.90 Field Book # 59

Twp. Rd # 79