


O.D.O.T. DISTRICT 2 SURVEY OFFICE (USE ONLY)


PERSONNEL _____ REFERENCE NO. IPID SHEET 33 OF 37
 NOTES RHOADES DATE 3/17/21 ROUTE US 224
 H.C. AUBLE WEATHER FAIR COUNTY SENECA
 R.C. ASTON TEMP. 50° TOWNSHIP REED
NIESE SECTION 32
 DWG BY RHOADES PID 101217 T 2 N R 17 E

TYPE MONUMENT IPID #8258 THELL
 ON SURFACE - ~~BELOW~~ ON
 OFFSET Q PAVEMENT - LT : ~~RT~~
- TO LT EDGE PAVEMENT
 STATION: 1396+79.14

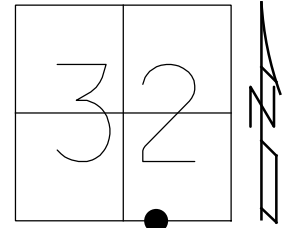

HORZ. DATUM: NAD83 2011 GEOID: NAVD88 2018
 GRID: NORTHING: 515538.944 EASTING: 1850341.337

RECORD:
 FD IPID
 #8258 THELL
 3/17/21, JFO
 SET MAG/WASHER
 11/9/23, DSA

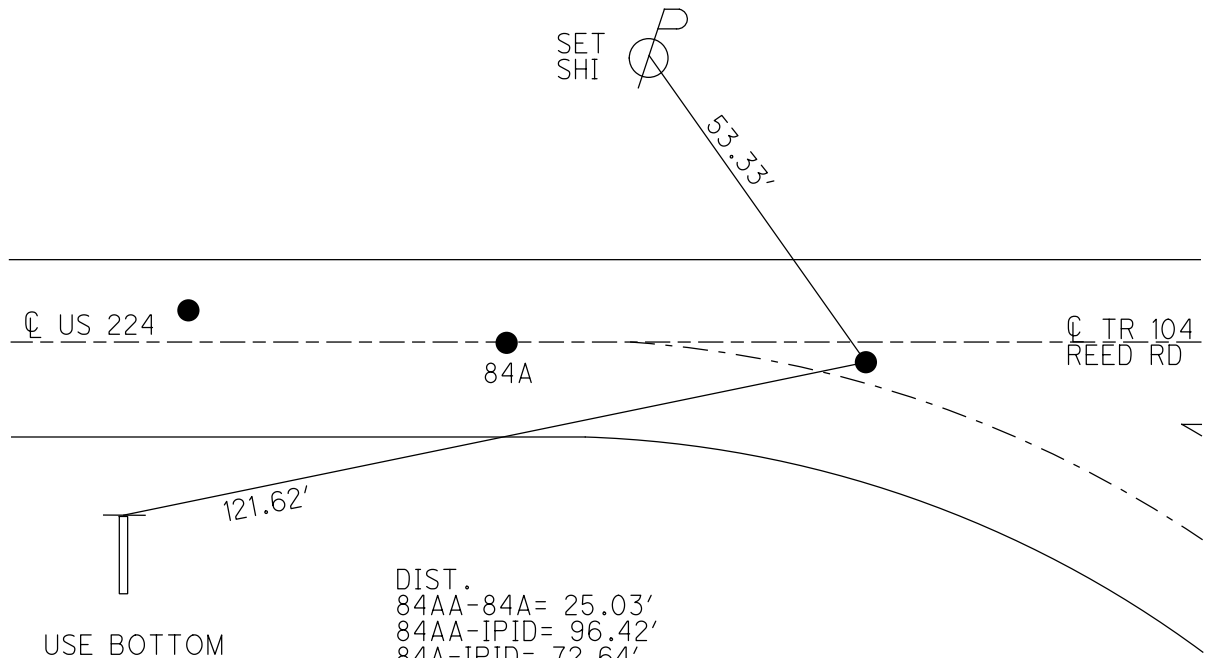

USE BOTTOM
 BOLT IN
 TLM SIGN

DIST.
 84AA-84A= 25.03'
 84AA-IPID= 96.42'
 84A-IPID= 72.64'