

PERSONNEL TITLE PERSONNEL TITLE

COUNTY Seneca

DATE 10-11-49

S. R. #224

WEATHER

SEC. G-D-F-E (Sec. Attica Pt.)

TEMP.

DESCRIPTION S. H #272

LEFT

CENTER LINE

RIGHT


JOB NO.

Sta. 255+88

$\Delta = 20-53' Lt.$

R.R. Spike on $\frac{1}{2}$ R/W

#204

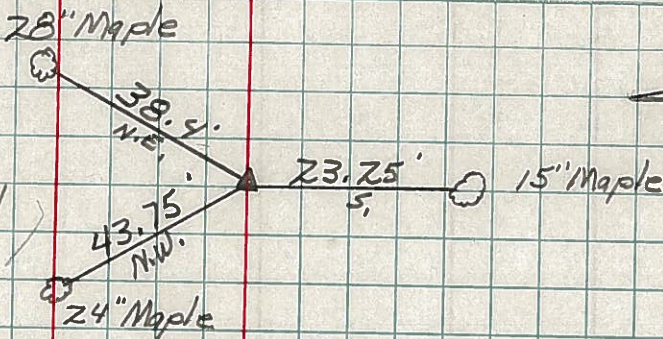


Did not Find

Sta. 258+24.5

$\Delta = 10-10' Lt.$

Nail & shiner on $\frac{1}{2}$ R/W

#205

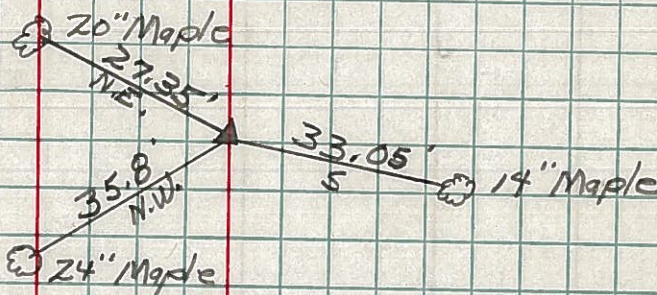

Did not Find


Garage

Sta. 260+19.5

$\Delta = 10-50' Lt.$

Nail & shiner on $\frac{1}{2}$ R/W

#206

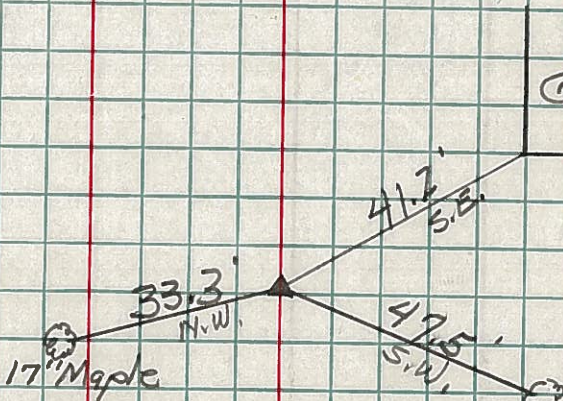

Did not Find

End of Sec. Attica Part.