

O.D.O.T. DISTRICT 2 SURVEY OFFICE (USE ONLY)

PERSONNEL

REFERENCE NO. 89 B1

SHEET 8 OF 16

NOTES RHOADES
 H.C. O'DONNELL
 R.C. POORE

DATE 5/24/17
 WEATHER CLOUDY
 TEMP. 62°

ROUTE US 224
 COUNTY SENECA
 TOWNSHIP VENICE
 SECTION 10

DWG BY MILLER PID 102819

T 1 N R 17 E

TYPE MONUMENT P.K./WASHER

ON SURFACE - ~~BELOW~~ ON

OFFSET Q PAVEMENT 2.5' ~~RT~~ : RT

13.2' TO RT EDGE PAVEMENT



STATION: 1571+59.14

HORIZ.DATUM: NAD83 (2011)

GEOID: NAVD88 2012A

GRID: NORTHING: 509837.259



EASTING: 1861041.190

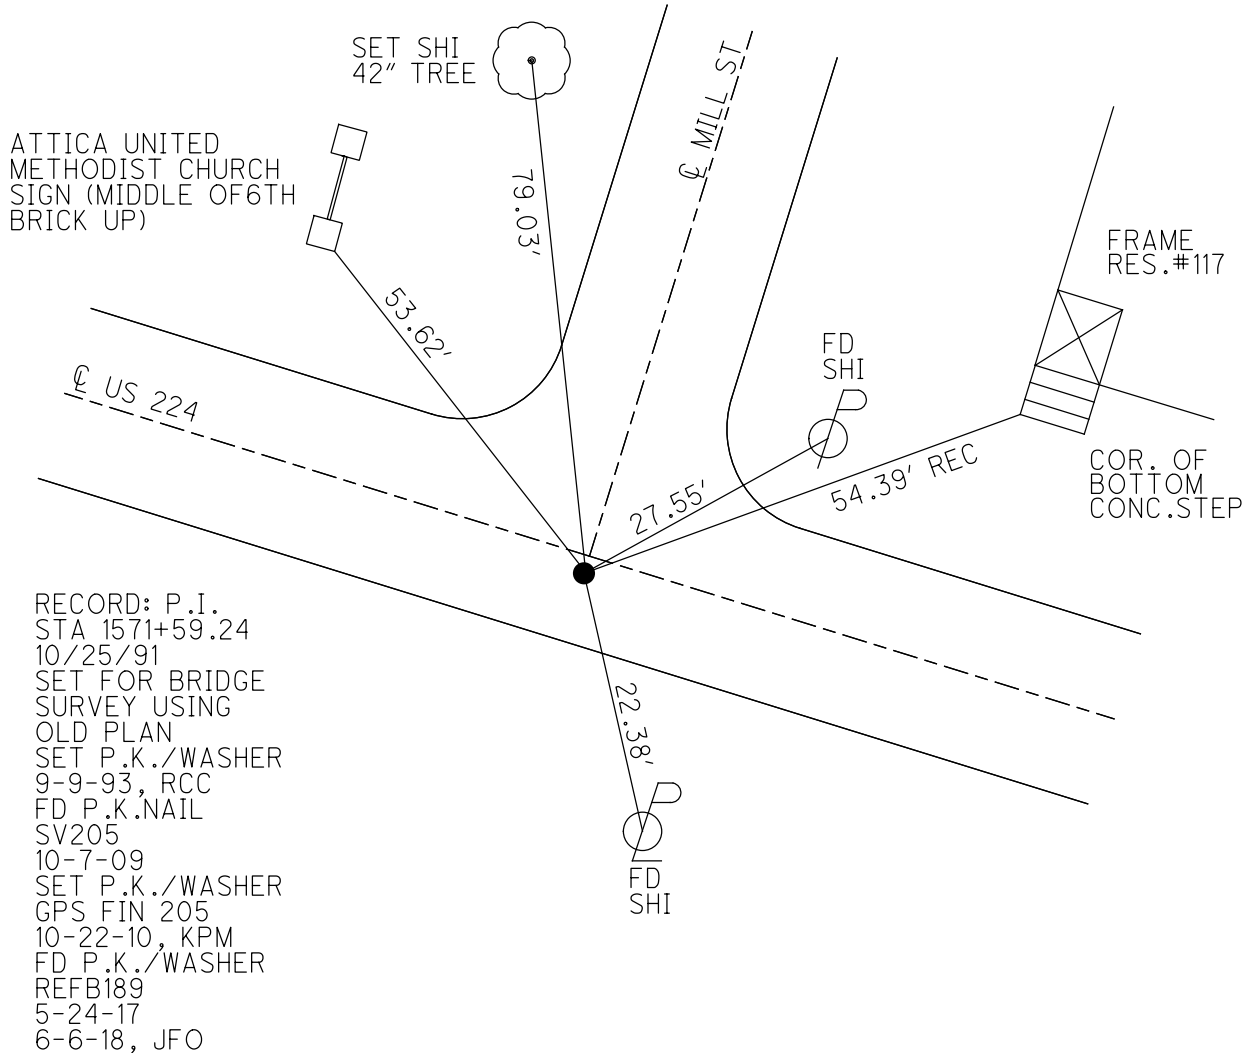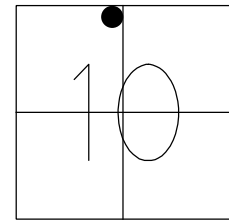

O.D.O.T. DISTRICT 2 SURVEY OFFICE (USE ONLY)

PERSONNEL	REFERENCE NO.	89 B1	SHEET	6	OF	13
NOTES	HARBAUGH	DATE	8/16/10	ROUTE	US 224	
H.C.	MOSER	WEATHER	SUNNY	COUNTY	SENECA	
R.C.	FINGER	TEMP.	83°	TOWNSHIP	VENICE	
				SECTION	10	
				T	1	N
				R	17	E

TYPE MONUMENT P.K.NAIL
 ON SURFACE - ~~BELOW~~ ON
~~LEFT~~ - CL PAV'T - RIGHT 2.5'
13.2' TO RT EDGE PAVEMENT
 S.L.M. 1571+59.14
 GRID: NORTHING: 509837.358 EASTING: 1861041.173

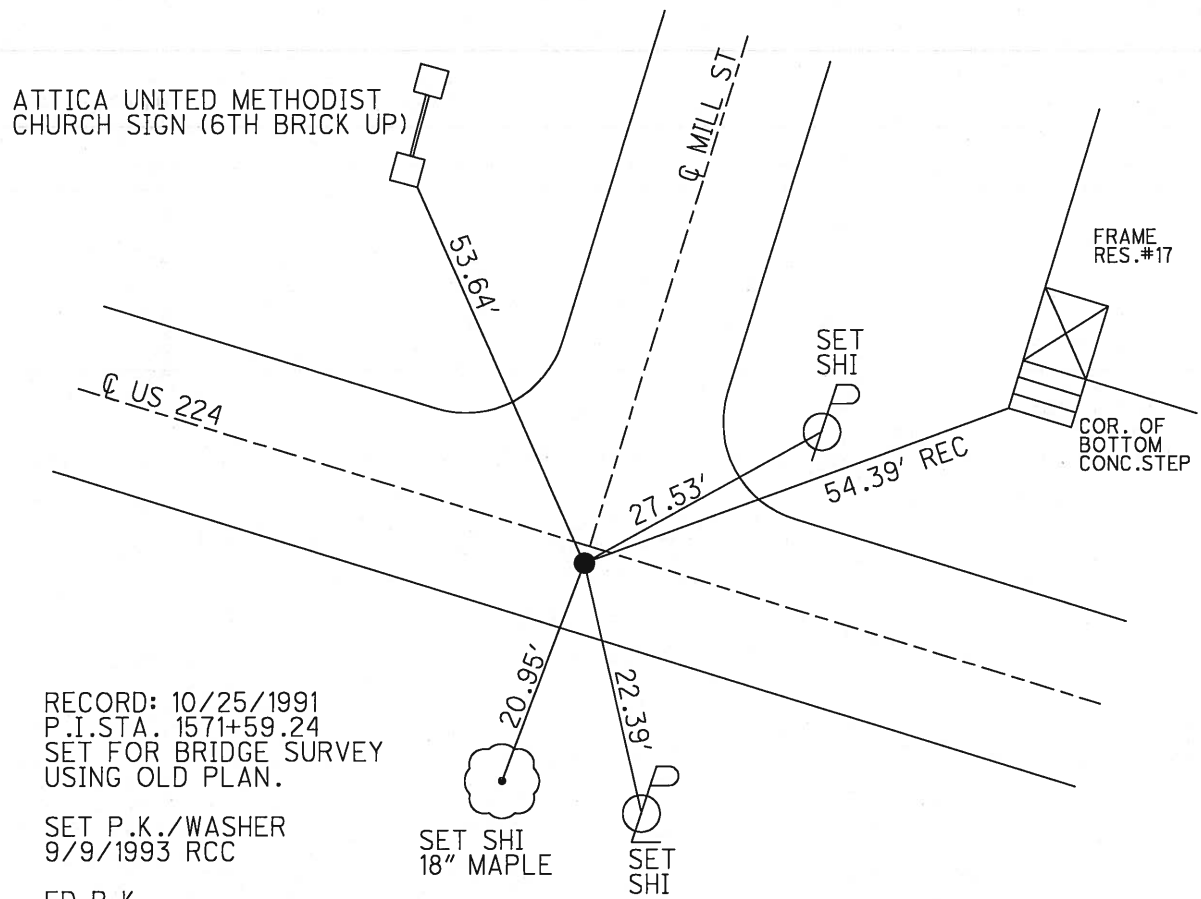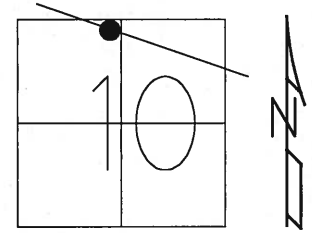

RECORD: 10/25/1991
 P.I. STA. 1571+59.24
 SET FOR BRIDGE SURVEY
 USING OLD PLAN.
 SET P.K./WASHER
 9/9/1993 RCC
 FD P.K.
 10/7/09 SV205
 SET P.K./WASHER
 GPS FIN 205
 10/22/10 KPM

O.D.O.T. DISTRICT 2 SURVEY OFFICE

PERSONNEL

REFERENCE NO. 89-B1

SHEET 6 OF 21

NOTES CHENEY

H.C. RIPPLE

R.C. BARBOUR

GEYMAN

DATE 7-19-1993

WEATHER CLOUDY

TEMP. 80°

ROUTE #224

COUNTY SENECA

TOWNSHIP VENICE

SECTION 10

T. 1 N. R. 18 E.


TYPE MONUMENT NAIL & SHINEE (SET FOR BR. SURVEY)

ON SURFACE - BELLOW GN


~~LEFT~~ - & PAV'T. - RIGHT 3'

13.2' TO RT. EDGE PAVEMENT @ CURB

S.L.M. 1518+23.5

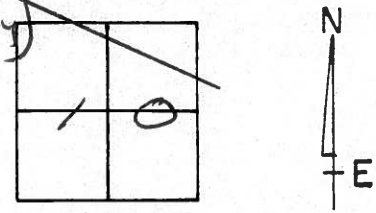

RECORD: 10-25-1991
 P.I. STA. 1571+59.24
 SET FOR BRIDGE SURVEY
 USING OLD PLAN.

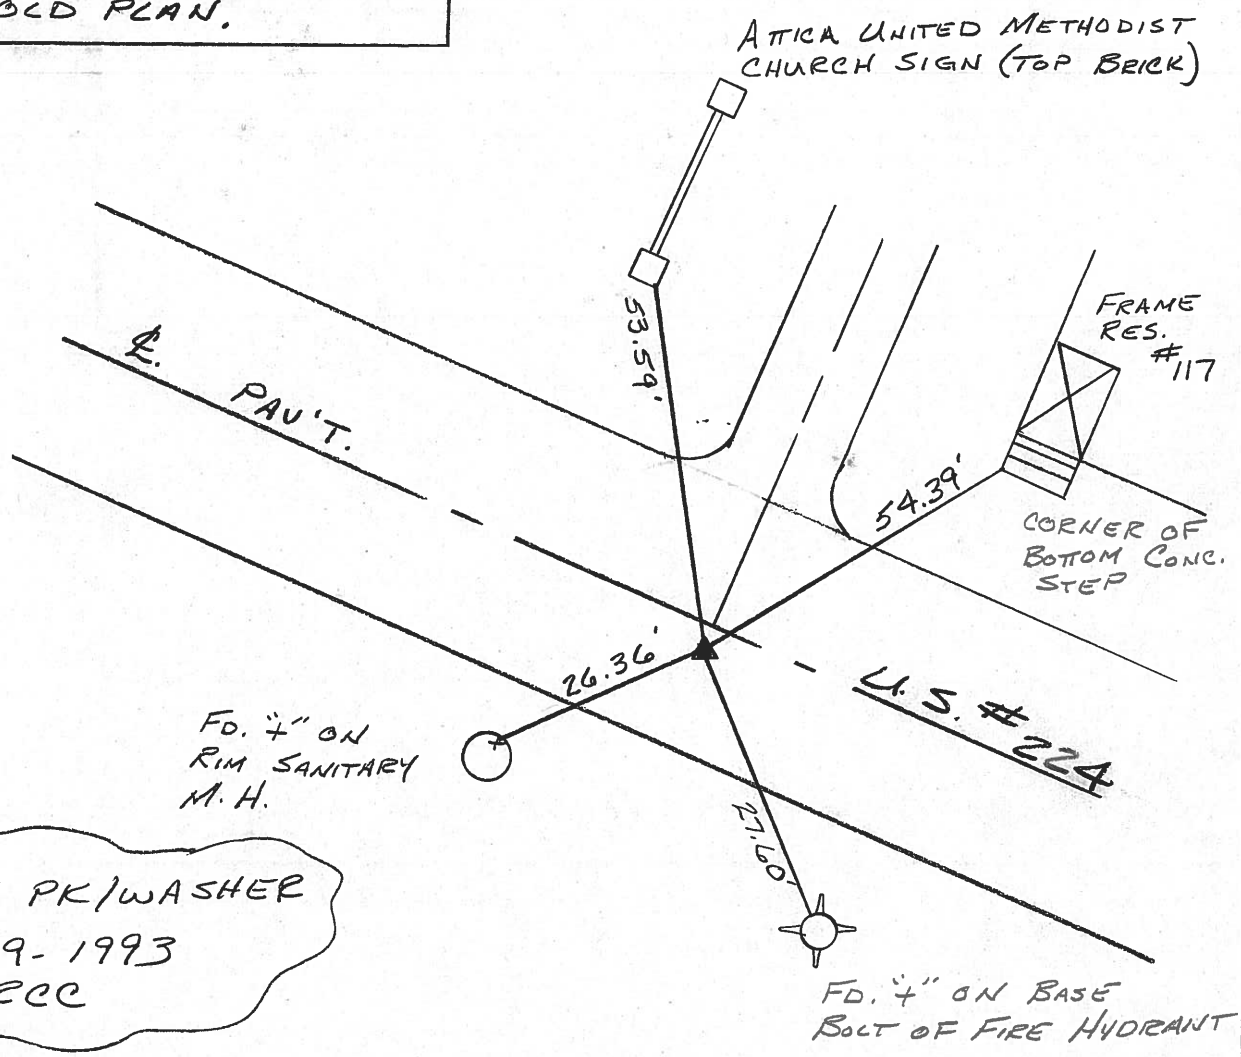

Fd. 4" ON RIM SANITARY M.H.

SET PK/WASHER
 9-9-1993
 RCC

Fd. 4" ON BASE BOLT OF FIRE HYDRANT

O.D.O.T. DISTRICT 2 SURVEY OFFICE

PERSONNEL

REFERENCE NO. 89-B1 SHEET 4 OF 4

NOTES CHENEY

H.C. RIPPLE

R.C. BARBOUR

DATE 10-25-1991

WEATHER _____

TEMP. _____

ROUTE U.S. 224

COUNTY SENECA

TOWNSHIP VENICE

SECTION 10

T1NR1BE

TYPE MONUMENT N/SHI. (SET FOR BR. SURVEY)

ON SURFACE - ~~BELOW~~ _____

~~LEFT~~ - & PAV'T. - RIGHT 3'

13.2' TO RT. EDGE PAVEMENT @ CURB

S.L.M. 1571 + 59.24

