

O.D.O.T. DISTRICT 2 SURVEY OFFICE (USE ONLY)

PERSONNEL

REFERENCE NO. 9

SHEET 5 OF 6

NOTES SCHNEIDER

DATE 7/14/71

ROUTE SR 269

H.C. MOSSER

WEATHER FAIR

COUNTY SENECA

R.C. GEYMAN

TEMP. 75°

TOWNSHIP THOMPSON

VINSON

SECTION 7

DWG BY NIESE PID \_\_\_\_\_

T 3 N R 18 E

TYPE MONUMENT SQ. PIN

~~ON SURFACE~~ - BELOW 4"


OFFSET  $\odot$  PAVEMENT ON LT : RT

- TO - EDGE PAVEMENT


STATION: 242+35

HORZ. DATUM: \_\_\_\_\_ GEOID: \_\_\_\_\_

GRID: NORTHING: \_\_\_\_\_ EASTING: \_\_\_\_\_

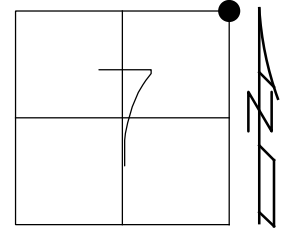

RECORD:  
FD SQ. PIN  
4" DOWN  
7/14/71, SCHNEIDER

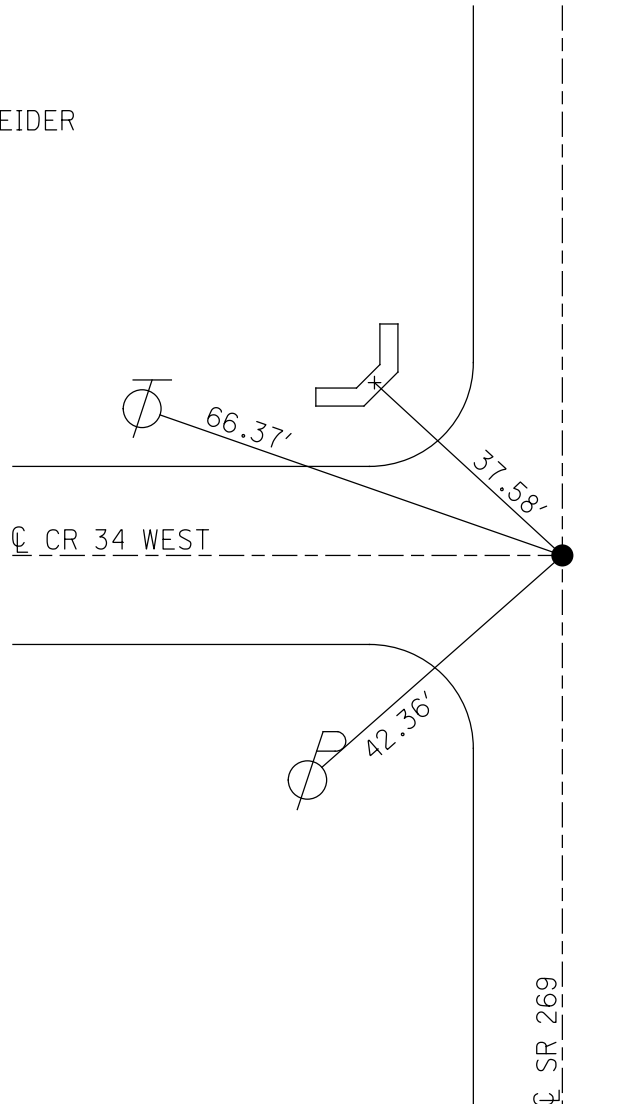

PERSONNEL	TITLE	PERSONNEL	TITLE	COUNTY	DATE
				<u>Seneca</u>	<u>7-17-71</u>
				S. R. <u>269</u>	WEATHER <u>Fair</u>
				SEC. _____	TEMP. <u>75°</u>
DESCRIPTION <u>from S.R. 4 to Sandusky Co. Line</u>				JOB NO. _____	
	LEFT	CENTER LINE	RIGHT		

