

O.D.O.T. DISTRICT 2 SURVEY OFFICE (USE ONLY)

PERSONNEL

REFERENCE NO. 11

SHEET 6 OF 6

NOTES SCHNEIDER

DATE 7/14/71

ROUTE SR 269

H.C. MOSSER

WEATHER FAIR

COUNTY SENECA

R.C. GEYMAN

TEMP. 75°

TOWNSHIP THOMPSON

VINSON

SECTION 1

DWG BY NIESE

PID _____

T 3 N R 17 E

TYPE MONUMENT R.R. SPIKE

~~ON SURFACE~~ - BELOW 3"

OFFSET \varnothing PAVEMENT _____ LT : RT

2.0' TO LT EDGE PAVEMENT


STATION: 297+26

HORZ.DATUM: _____


GEOID: _____

GRID: NORTHING: _____

EASTING: _____

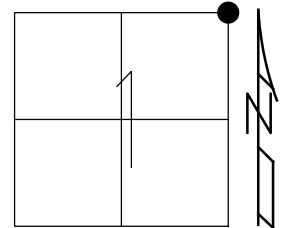

RECORD:
FD R.R. SPIKE
3" DOWN
7/14/71, SCHNEIDER

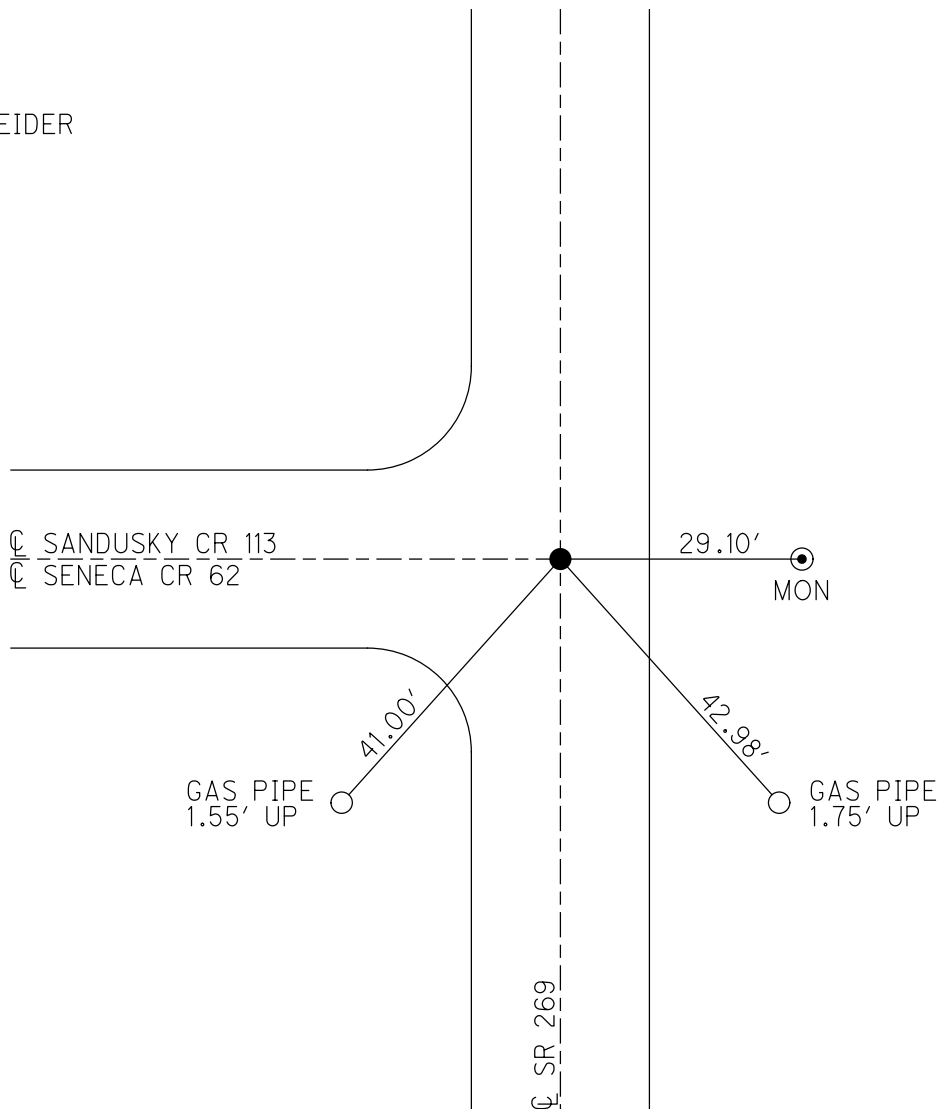

PERSONNEL	TITLE	PERSONNEL	TITLE	COUNTY	Seneca	DATE	7-14-71
				S. R.	269	WEATHER	Fair
				SEC.		TEMP.	75°
DESCRIPTION	from S.R. # to Sandusky Co. Line			JOB NO.			

