

DATE 0-10-83
PERSONNEL RIPPCE-GEYMAN
8-16-93
CHENIEY-GEYMAN-
BARGON R

NOTES TO: B. BASSBROOK 8-18-83
1994 TWO-LANE RESURFACING PROGRAM

PRIORITY NO. 12 OF 3 SHEET 1 OF 6
COUNTY SENECA ROUTE SR 587 SECTION 08.11
BEGIN LOG (SLM) 8.11 428+20.8
END LOG (SLM) 12.24 SR 18
TOTAL LENGTH 4.13 MILES
MUNICIPALITY FOSTORIA BEGIN LOG (SLM) 12.07 END LOG (SLM) 12.24
MUNICIPALITY BEGIN LOG (SLM) END LOG (SLM)

PROPOSED WORK: Resurface and pavement repair
PAVEMENT 1 1/2" 404 SHOULDER 1 1/2" 404 & 617
OTHER 8"-301 pavement repair

STATION ESTABLISHED FROM: #23 CONTROL POINT SR#224 & SR 587 = 428+20.8, CONSTRUCTION
JOINT IS AT STA. 428+52

STRUCTURES:

NUMBER	STATION	WIDTH	LENGTH	PROPOSED WORK
SEN 587	465+55-465+75	28'	20'	
0880				
SEN 587	500+24-500+69	34'	45'	
0948				
SEN 587	597+83-598+09	26'	26'	
1133				
SEN 587	610+76-610+88	34'	12'	
1156				
SEN 587	636+23-636+42	27'	19'	
1204				

RAILROAD CROSSING:

(NO WORK)

NAME STATION NO. TRACKS LENGTH ALONG C L FT

SHEET 2 OF 6

1994 TWO-LANE RESURFACING PROGRAM INTERSECTIONS

COUNTY Seneca ROUTE # 587 SECTION 8.11 to 12.24

L - PROP PAVT DEPTH (IN) X 10; W - WIDTH @ MOUTH; W-1 - WIDTH @ THROAT

[illegible]

[illegible]

SHEET 4 OF 6

PAVEMENT DATA

NOTE: LOCATE ALL

COUNTY SEVEN A

[illegible]

* = STATION LOCATION

[illegible]

DATE 8-16-1993

SHEET 5 OF 6

1994 TWO-LANE RESURFACING PROGRAM
DEFECTIVE PAVEMENT AREAS

COUNTY SENECA ROUTE 587 SECTION 8.11

STATION		LT BERM	LT LANE	RT LANE	RT BERM	SIZE (WIDTH)	EXISTING PAVEMENT CONDITIONS		
FROM	TO						RUTTED	CRACKED	BASE FAILURE
448+44	448+95	✓				2'±			✓
450+16	456+00	✓	✓			3'±	✓	✓	
466+17	466+25	✓				3'±		✓	
466+25	466+36			✓	✓	5'±		✓	
499+28	499+68		✓			1.5'±	✓		
499+35	499+95			✓		3'±	✓		✓
521+78	522+22				✓	3'±			✓
522+77	527+50			✓	✓	5'±	✓	✓	
530+32	553+00			✓	✓	5'±	✓	✓	
559+90	563+23			✓	✓	5'±	✓	✓	
569+00	571+00			✓	✓	4'±		✓	
572+00	575+55			✓	✓	4'±	✓	✓	
578+41	578+61			✓		4'±	✓		
578+61	584+20			✓	✓	4'±		✓	
585+80	586+00			✓	✓	4'±		✓	
592+12	595+20			✓	✓	4'±	✓	✓	
596+18	596+43			✓	✓	4'±			✓
604+62	605+34			✓	✓	4'±	✓	✓	
605+76	608+18			✓	✓	4'±	✓	✓	
611+42	611+79				✓	3'±		KICKING-OUT ✓	

State of Ohio Department of Transportation
Field Notes

SHEET NO. 6-6

TITLE

A. TAPE

2

TITLE

1

1


DATE _____

ATHER

INTERSECTION DETAIL - SEE 2010 OK 10

CENTER LINE

RIGHT

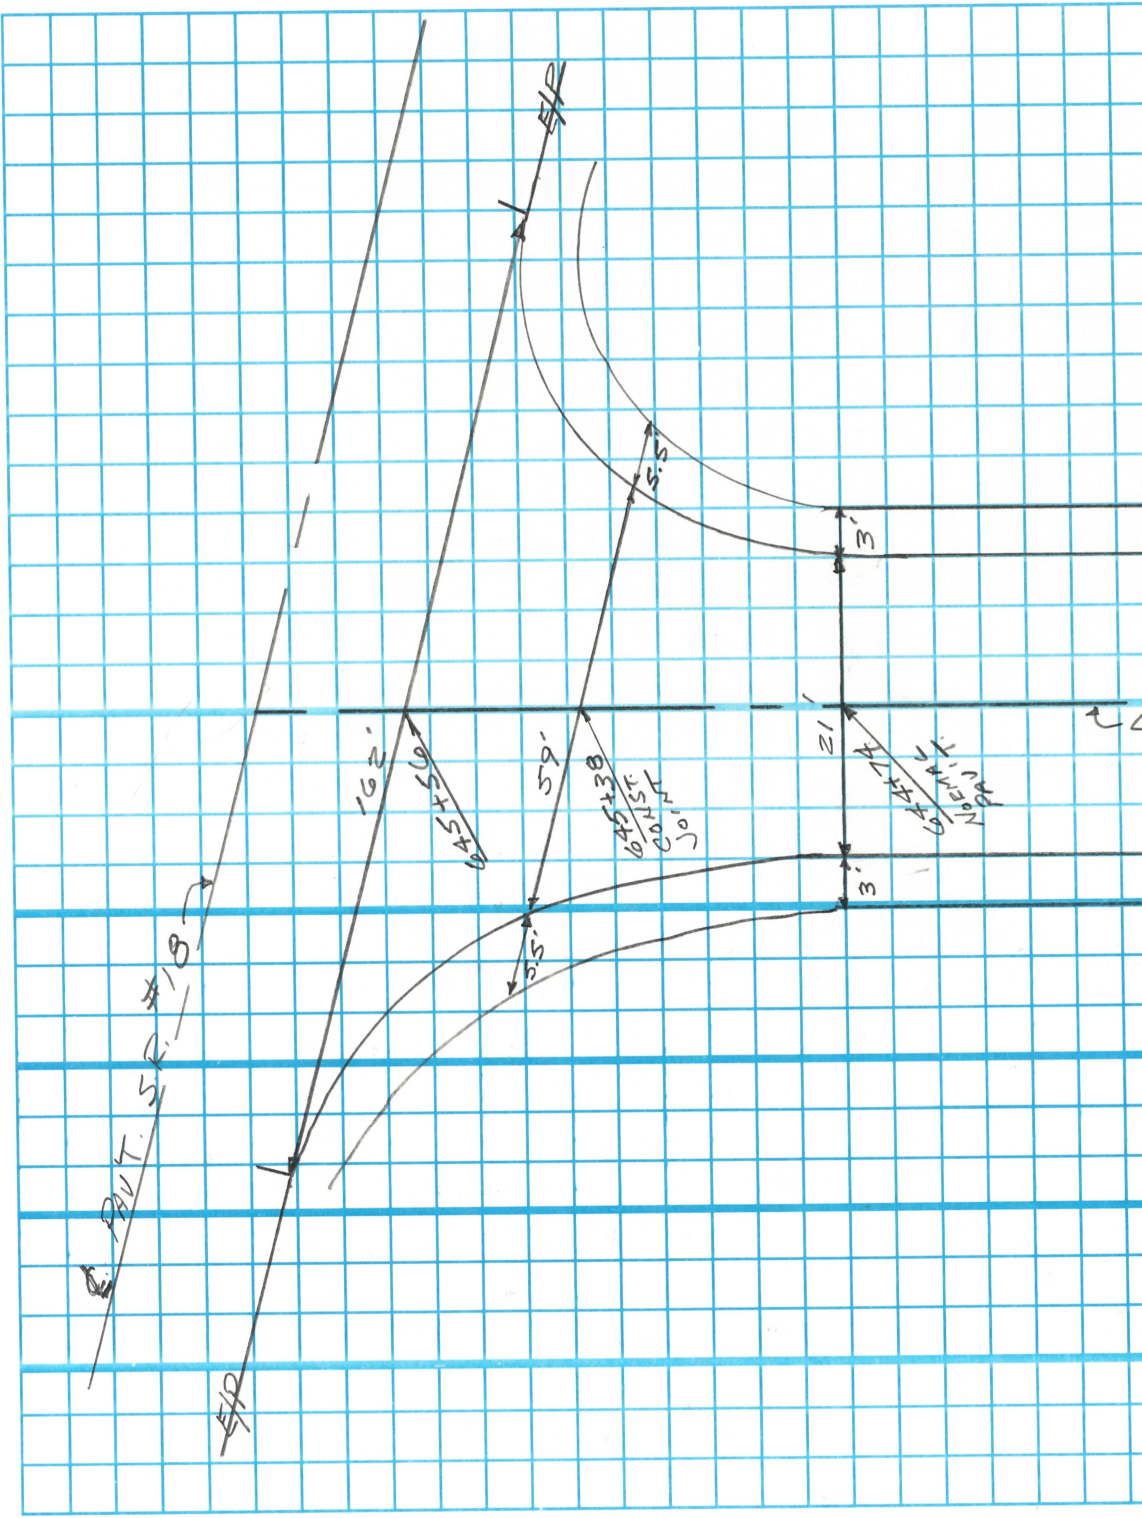

State of Ohio Department of Transportation Field Notes

LD-5
5-92

PERSONNEL
CHELEY
BARBOUR
RIPPLE
GEYMAN

TITLE
A
T
H. TAPE
R. TAPE

PERSONNEL

TITLE

COUNTY
SENECA

S.R.
587

SEC.
12.12

DATE
9-13-1993

WEATHER
FAIR

TEMP.
75°

PA. 02612-74

DESCRIPTION
SURVEY FOR OLD RR. BED - HUMP REMOVAL JOB NO. 02612-74

LEFT
Please note: topo survey stations

CENTER LINE
stations

RIGHT
stations

644+18.5±

644+71±

644+18.5±

644+71±

644+18.5±



643+00
END 50:
STA.

SET NAIL SHINER ON
APPROX. 4' OF OLD
RR. BED.

636+98.35

636+98.35

FD. PK/WASHER @ REF.
#34 STA. 636+21.0
(1/2" x 13" FEET-ROD SET
OVER HUB)

STE. # 12.04

*** ANGLES

4 "A" = 179-55-04

2) 359-50-13

M) 179-50-06

179-55-06 SWN

4 "B" = 89-50-20 ±


4 "C" = 120-20-48 ±

TPO - R.R. HUMP REMOVAL

RIGHT

CENTER LINE

LEFT

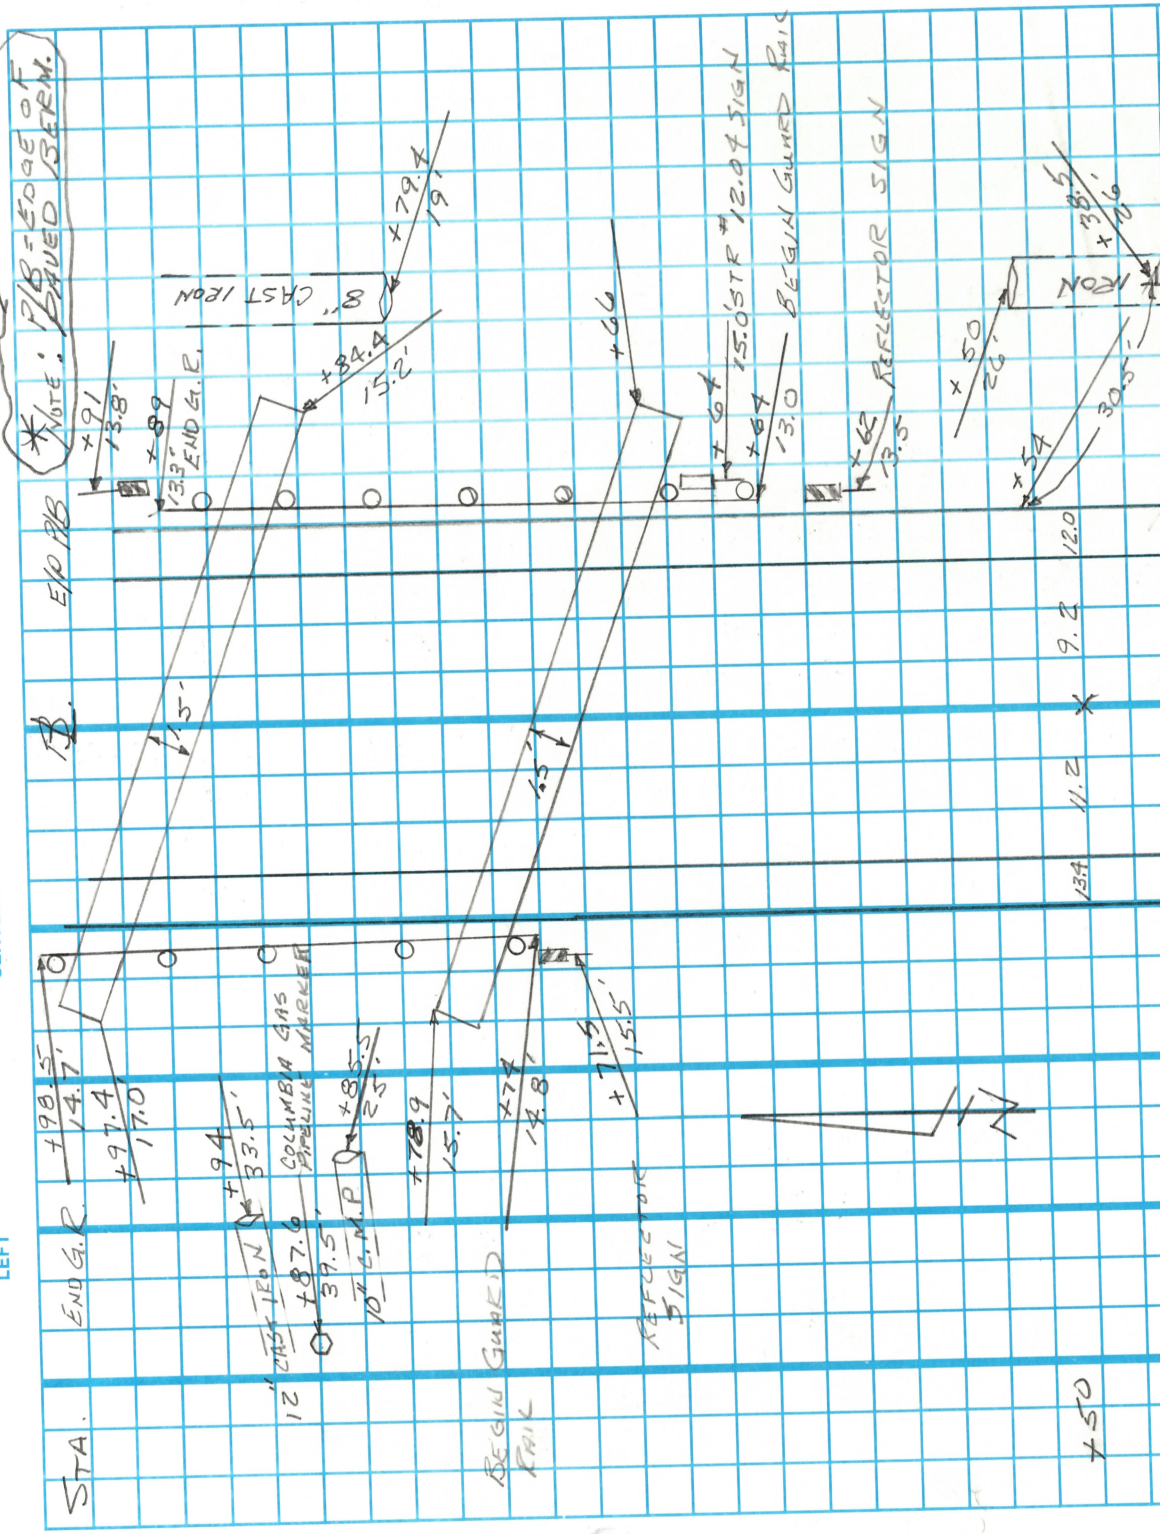

State of Ohio Department of Transportation
Field Notes

LD-5
5-92

SHEET NO. 3-13

COUNTY SENECA DATE 7-14-1993

PERSONNEL
CHENEY
RIPPLE
BARBOUR
GEYMAN


TITLE
M
H. TAPE
R. TAPE
REAG

S.R. #587 WEATHER FAIR

SEC. 12.12 TEMP. 75°

PA. 026112-74 JOB NO. 026112-74

DESCRIPTION TOP-PR. HUMP REMOVAL

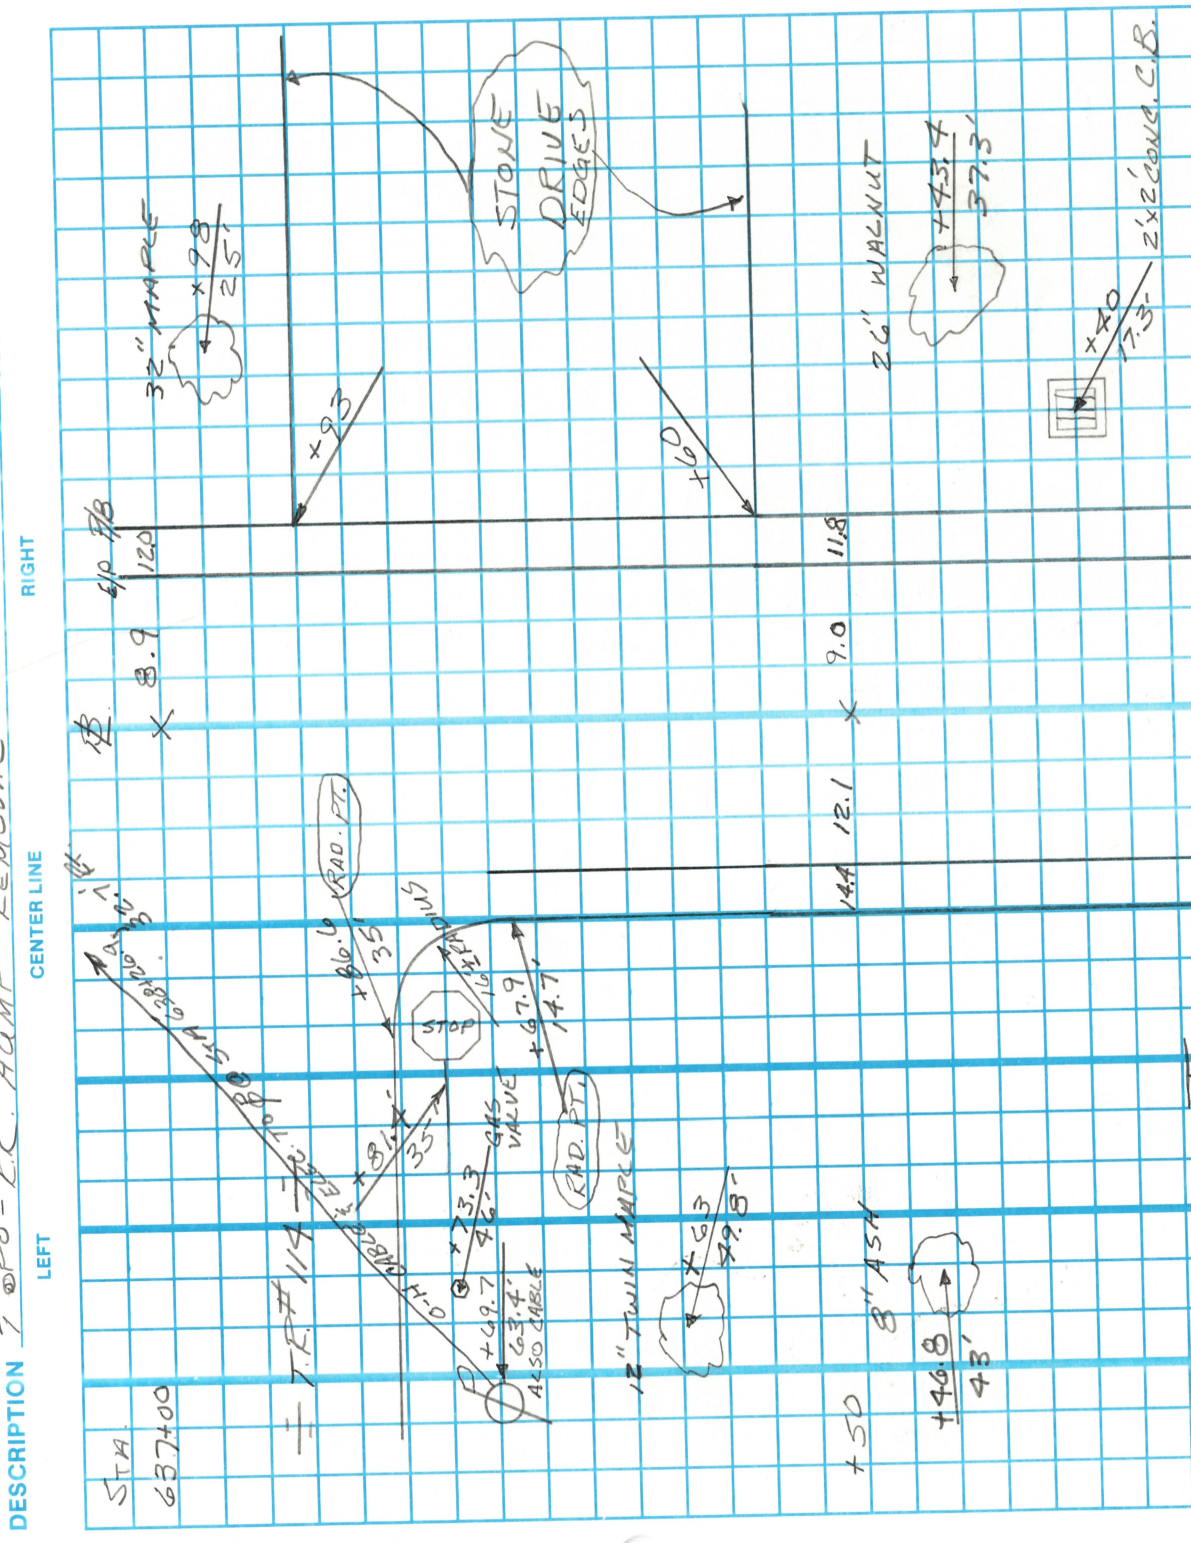


State of Ohio Department of Transportation
Field Notes

LD-5
5-92

SHEET NO. 4-13
DATE 7-14-1993
COUNTY SENECA
S.R. #587 WEATHER CLOUDY
SEC. 12.12 TEMP. 80°
PA. 026112-74
JOB NO. 026112-74

PERSONNEL	TITLE	PERSONNEL	TITLE
CHENEY	M		
RIPPLE	A TAPE		
BARBOUR	R. TAPE		
GEYMAN	FLAG		

DESCRIPTION TOPO - RR HUMP REMOVAL

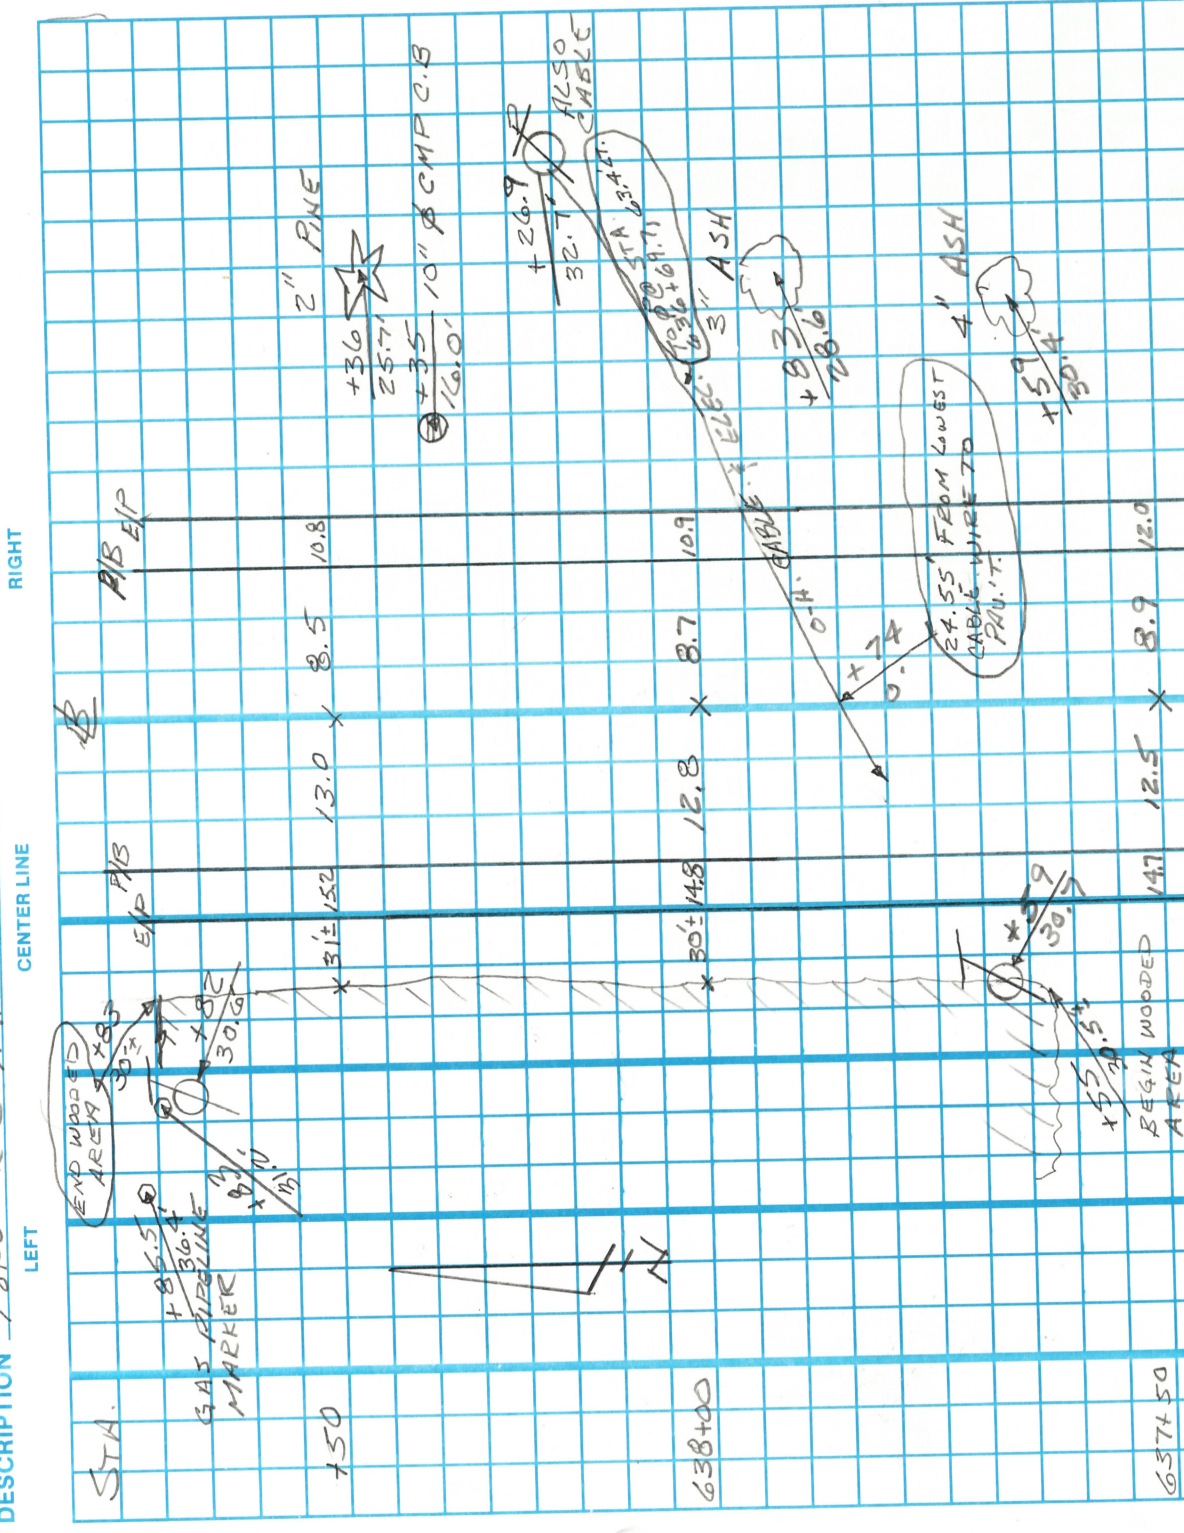


DATE 7-14-1975

WATHER Cloudy

TEMP. 80°

P.A. 026112-74
JOB NO.

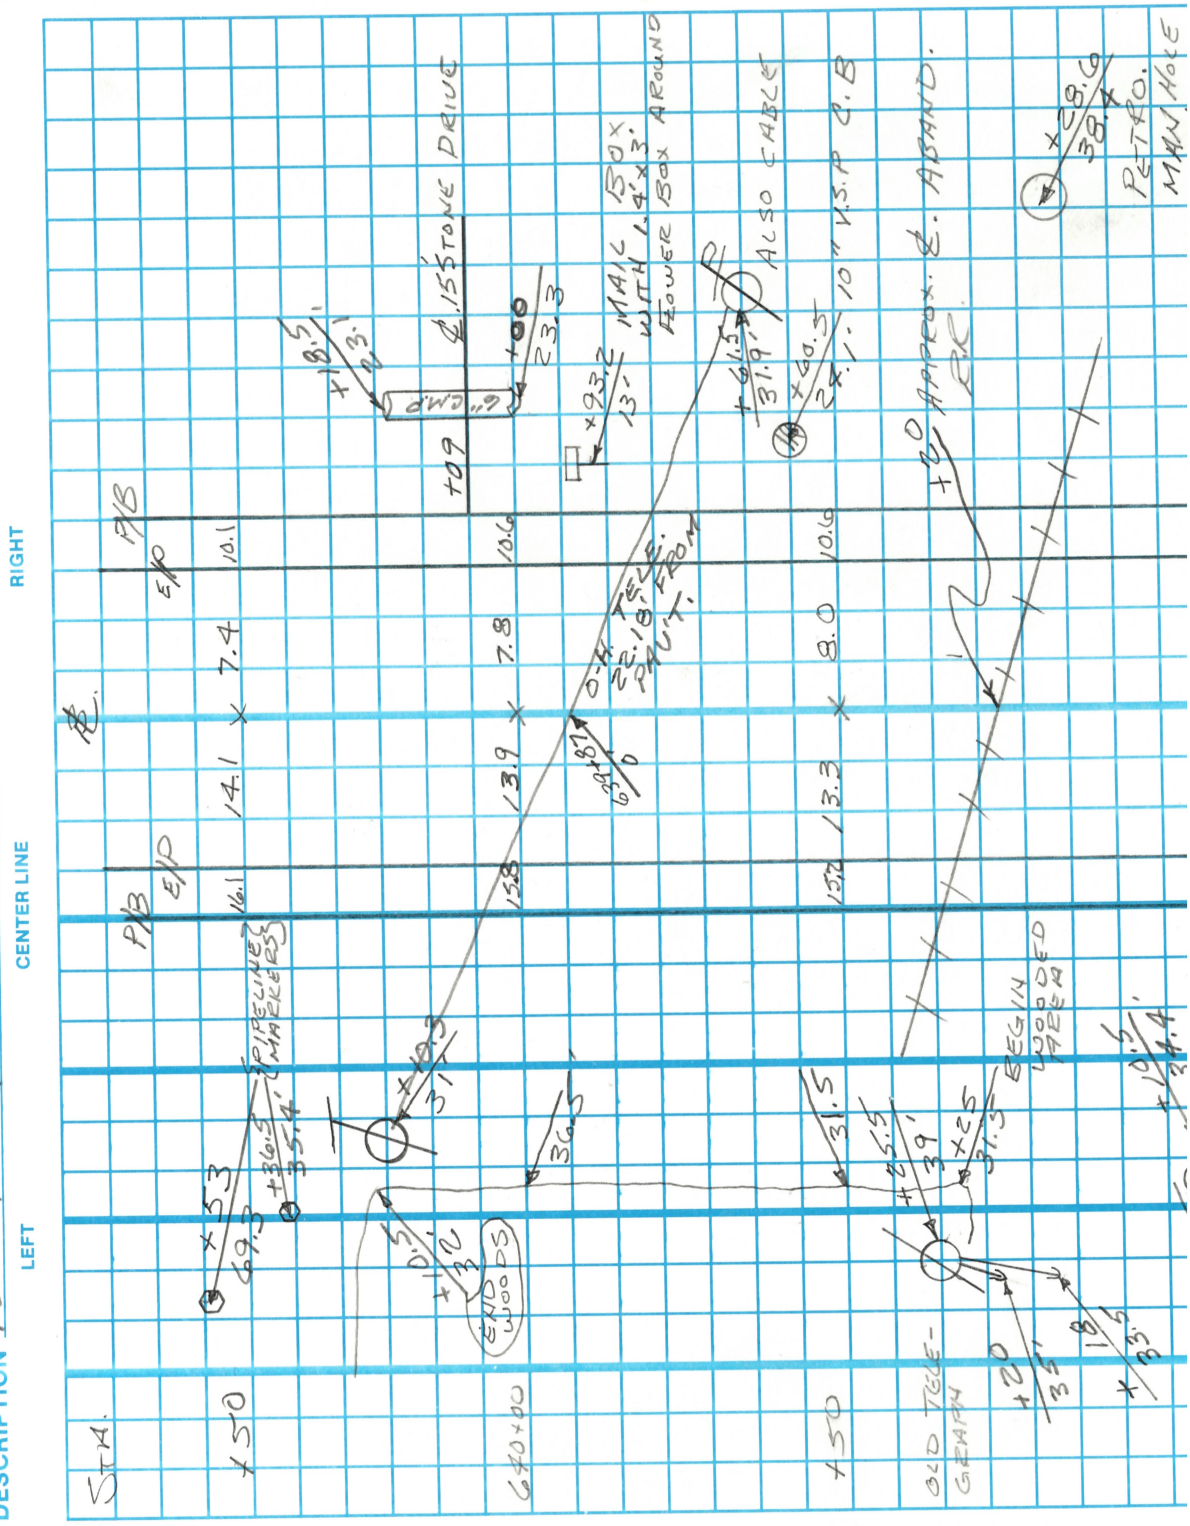

SENeca
187
2,12

WEATHER

TEMP. 00


P.A. 026112-74
JOB NO.

Topo-RR Hump Removal

RIGHT

CENTER LINE

LEFT

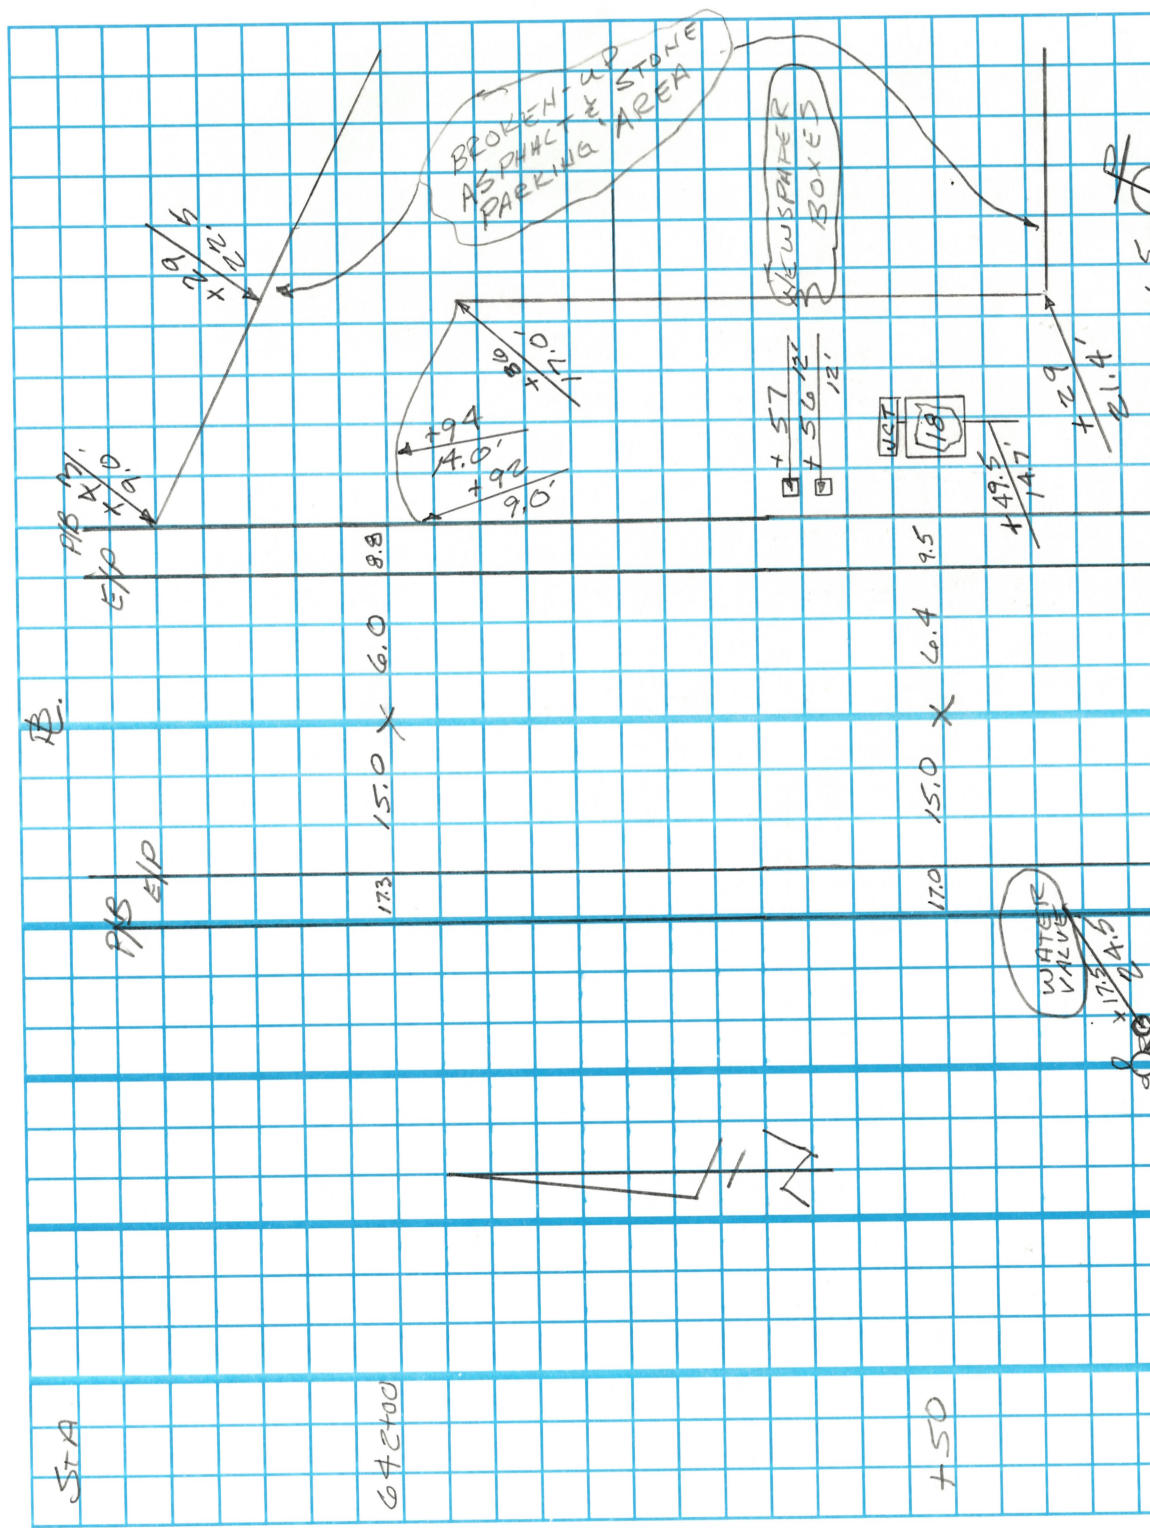

LD-5
5-92

State of Ohio Department of Transportation
Field Notes

PERSONNEL
CHENEY
RIPPLE
BARBOUR
GEYMAN

TITLE
M
H. TAPE
R. TAPE
FLAG

PERSONNEL

TITLE

COUNTY
SENECA

S. R.
#587

WEATHER
Cloudy

DATE
9-14-1993

TEMP.
80°

DESCRIPTION
TOPO - P.R. HUMP RENOVATION


PA. 026112-74
JOB NO.

SHEET NO. 7-13

RIGHT

CENTER LINE

LEFT

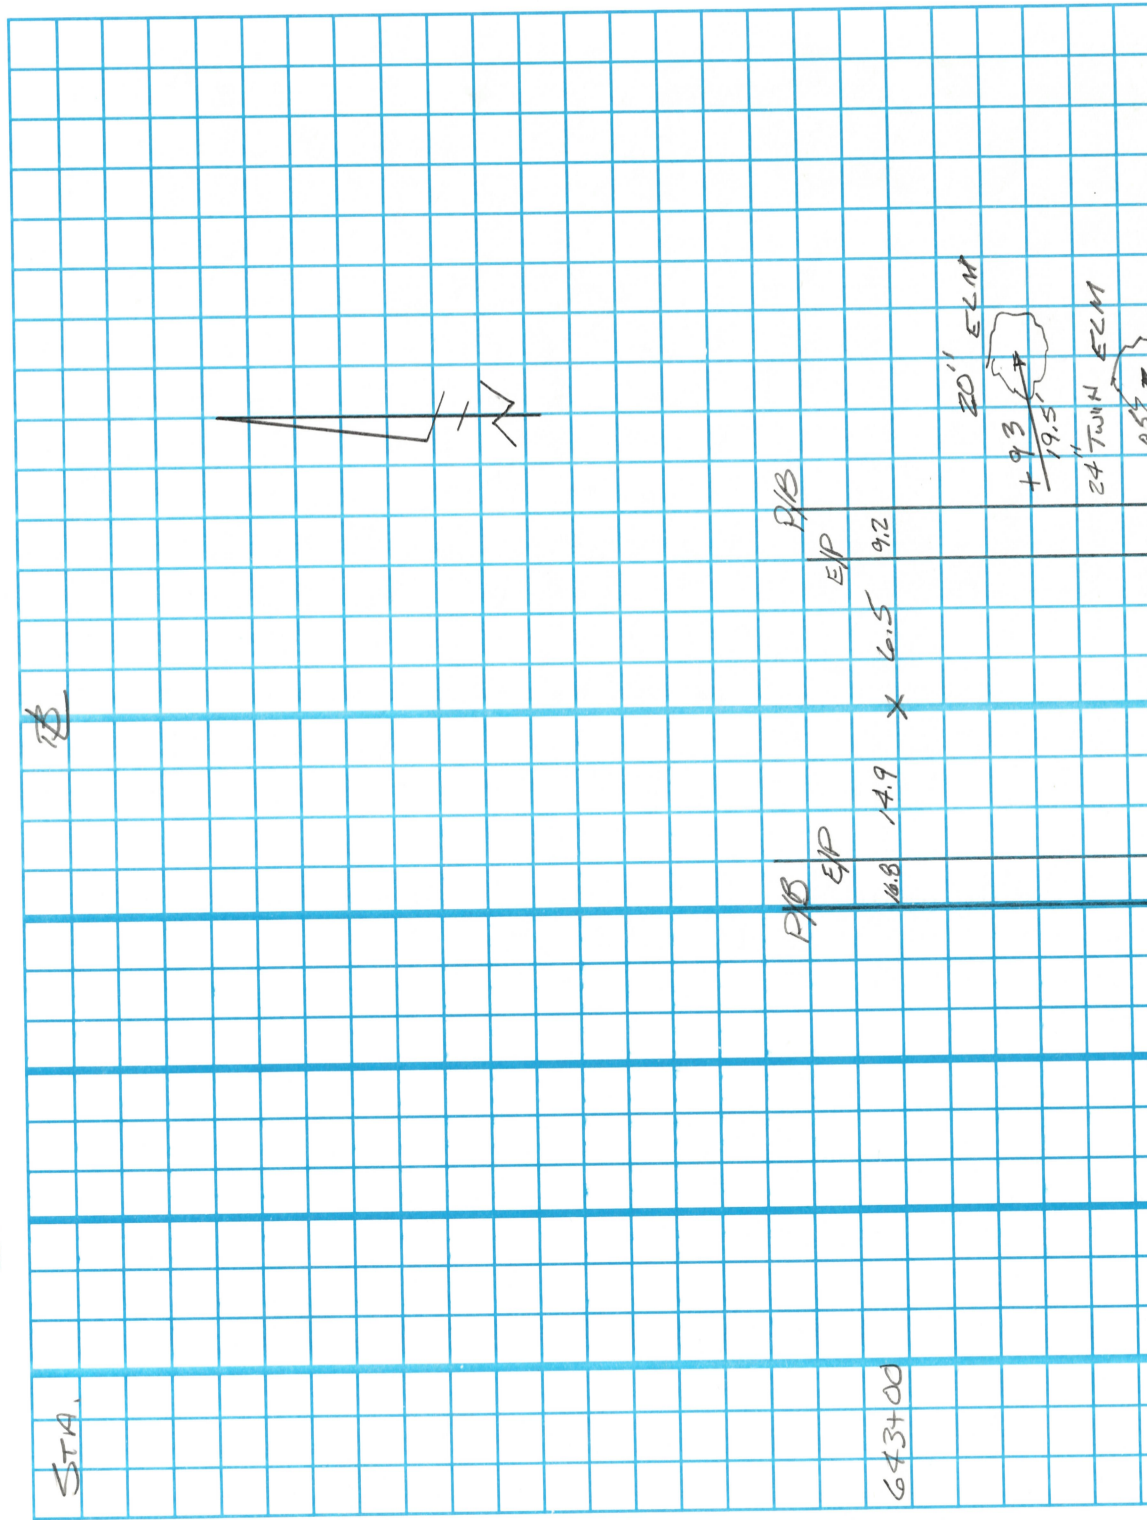

State of Ohio Department of Transportation
Field NotesSHEET NO. B-13

PERSONNEL	TITLE	PERSONNEL	TITLE
<u>CHENEY</u>	<u>M</u>		
<u>RIPPLE</u>	<u>K</u>		
<u>BAERBOUR</u>	<u>P</u>		
<u>GEYMAN</u>	<u>P</u>		

COUNTY	DATE	WEATHER
<u>SENECA</u>	<u>9-13-1993</u>	<u>FAIR</u>

S. R.	TEMP.
<u>#587</u>	<u>85°</u>

P.A. 026112-74

DESCRIPTION

BENCH CIRCUIT FOR OLD RR HUMP REMOVAL

LEFT		CENTER LINE		RIGHT	
STA.			ELEV.		
B.M.	7.98	N.I.			B.M.#1: BENCH CUT F.D. ON N.E. COR. OF CONC. CATCH BASIN @ STA. 636+41, 1993.
B.M.			106.63		B.M.#2: CUT 4' ON S. FLANGE BOLT OF FIRE HYDRANT @ STA. 64+18, 26.5' LT.
B.M.	0.99	107.62	106.63	B.M.#2	
B.M.			100.00	B.M.#1	

COUNTY SENECA

WEATHER

TEMP

TEMP. —

CENTER LINE

RIGHT

[illegible]

State of Ohio Department of Transportation
Field Notes

LD-5
5-92

PERSONNEL
CHENEY
RIPLEY
BARBOUR
GEYMAN

TITLE
A
T
TAPE
Φ

PERSONNEL
-

TITLE
A.1.

COUNTY
SENECA

S.R.
#587

SEC.
12.12

DATE
9-15-1993

WEATHER
CLOUDY

TEMP.
60°

PA.

DESCRIPTION
X-SECTIONS, RR. HUMP REMOVAL

JOB NO.
026112-74

SHEET NO.
11-13

STA.	LEFT	CENTER LINE	RIGHT
638+00	5.3 28 6.6 32 7.3 39	4.33 4.05 4.02 4.03 4.2 12 4.5 16 3.6 26 3.9 38	4.2 12 4.5 16 3.6 26 3.9 38
+35		4.66 7.03 100.84 98.47 TOP C.B. BOTTOM C.B.	
+50	4.4 26 6.3 32 7.2 36 45	3.13 3.06 2.62 1.2 P/B E/P E/P P/B 1.4 4.3 1.7 3.3	3.2 14 2.9 12 3.1 17 2.2 2.5
639+00	5.4 34 6.6 44	1.01 1.07 0.22 0.20 0.10 E/P P/B E/P P/B 0.2 14 0.5 25 1.1 29 0.6 44	0.2 14 0.5 25 1.1 29 0.6 44
+06.5		3.38 102.12 TOP OF PETRO PAVEMENT MANHOLE, 35' LT.	

State of Ohio Department of Transportation
Field Notes

LD-5
5-92

SHEET NO. 12-13

PERSONNEL
CHELSEY
RIPPE
BARBOUR
GREYMAN

TITLE
M
K
TAPE
P

PERSONNEL
COUNTY SENECA
S.R. #587
SEC. 12.12
TEMP. 60°

DATE 9-15-1993
WEATHER CLOUDY

DESCRIPTION X-SECTIONS, RR. HUMP REMOVAL

PA. 026112-74
JOB NO. 026112-74

LEFT		CENTER LINE		RIGHT	
STA.	+	+	+	+	+
639+50	5.1	5.5	4.7	4.39	4.29
	28	22	17	P/B	EIP
	5.4	5.4			
	37	43			
+60.5				5.84	103.80
+60.5				8.91	100.73
640+00	6.0	6.0	5.3	4.93	4.84
	35	23	17	P/B	EIP
	5.9	5.9			
	42	42			
+00				5.50	104.14
+18.5				5.27	104.37
+09					
+50	5.9	5.9	5.2	4.90	4.79
	34	23	17	P/B	EIP

10.0
16.0
12.0

