

O.D.O.T. DISTRICT 2 SURVEY OFFICE (USE ONLY)

PERSONNEL

REFERENCE NO. 17

SHEET 20 OF 30

NOTES FINGER

DATE 5/24/11

ROUTE SR 587

H.C. MOSER

WEATHER OVERCAST

COUNTY SENECA

R.C. HARBAUGH

TEMP. 65°

TOWNSHIP BIG SPRINGS

DWG BY NIESE

PID PAVE TRAIN

SECTION 12

T 1 N R 13 E

TYPE MONUMENT P.K./WASHER

ON SURFACE - ~~BELOW~~ ON

OFFSET C PAVEMENT 1.6' LT : ~~RT~~

12.3' TO RT EDGE PAVEMENT



STATION: 276+37

HORZ.DATUM: NAD83

GEOID: 2009

GRID: NORTHING: 506942.641

EASTING: 1741930.078

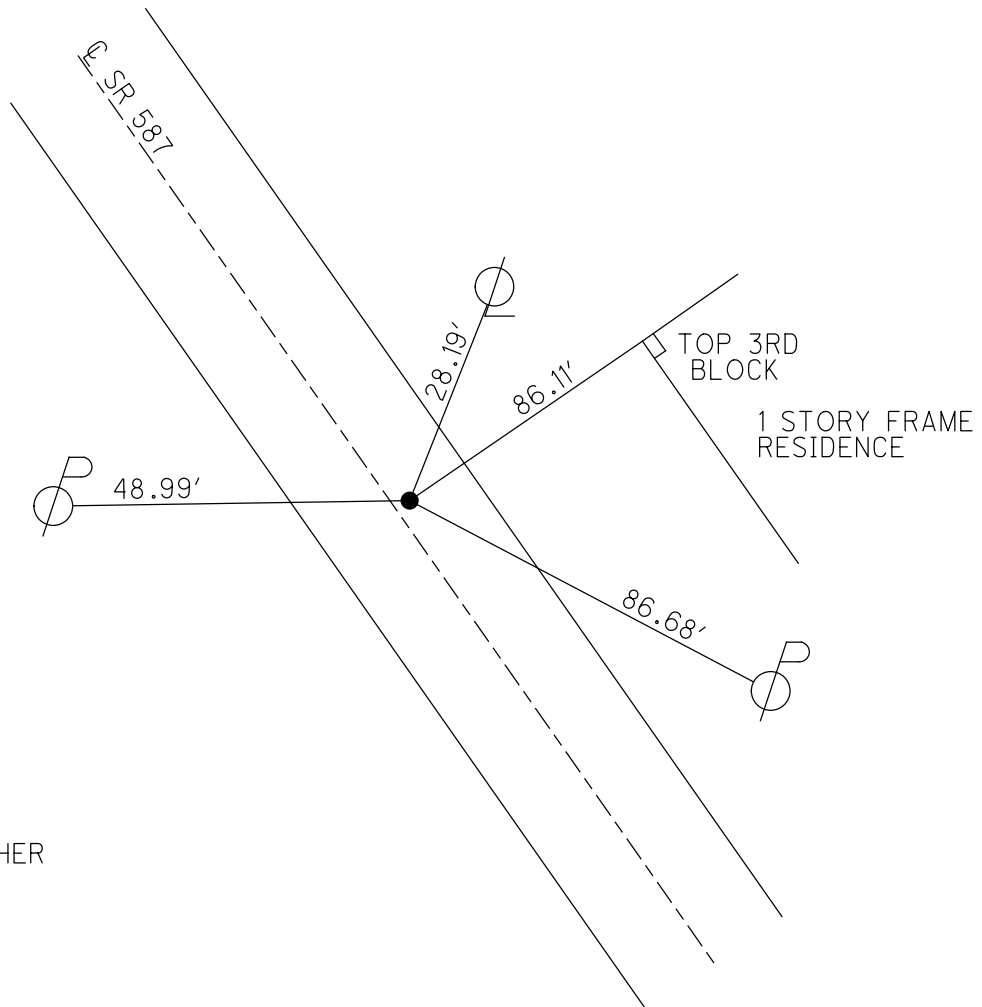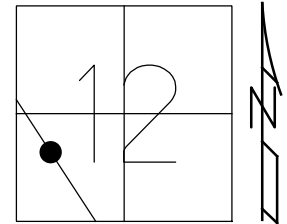

RECORD:
STA 275+37
FD P.K./WASHER
5/24/11, KPM
REF17
5/26/11, KPM
COVERED
7/2/21, JMR

O.D.O.T. DISTRICT 2 SURVEY OFFICE (USE ONLY)

PERSONNEL

REFERENCE NO. 17

SHEET 20 OF 30

NOTES FINGER

DATE 5/24/11

ROUTE SR 587

H.C. MOSER

WEATHER OVERCAST

COUNTY SENECA

R.C. _____

TEMP. 65°

TOWNSHIP BIG SPRINGS

HARBAUGH

SECTION 12

DWG BY NIESE

PID PAVE TRAIN

T 1 N R 13 E

TYPE MONUMENT P.K./WASHER

ON SURFACE - ~~BELOW~~ ON

OFFSET 12.3' TO RT PAVEMENT 1.6' LT : ~~RT~~

12.3' TO RT EDGE PAVEMENT


STATION: 276+37

HORZ.DATUM: _____


GEOID: _____

GRID: NORTHING: 506942.641

EASTING: 1741930.078

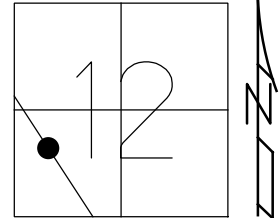

RECORD:
 STA 275+37
 FD P.K./WASHER
 5/24/11, KPM
 REF17
 5/26/11, KPM
 COVERED
 7/2/21, JMR

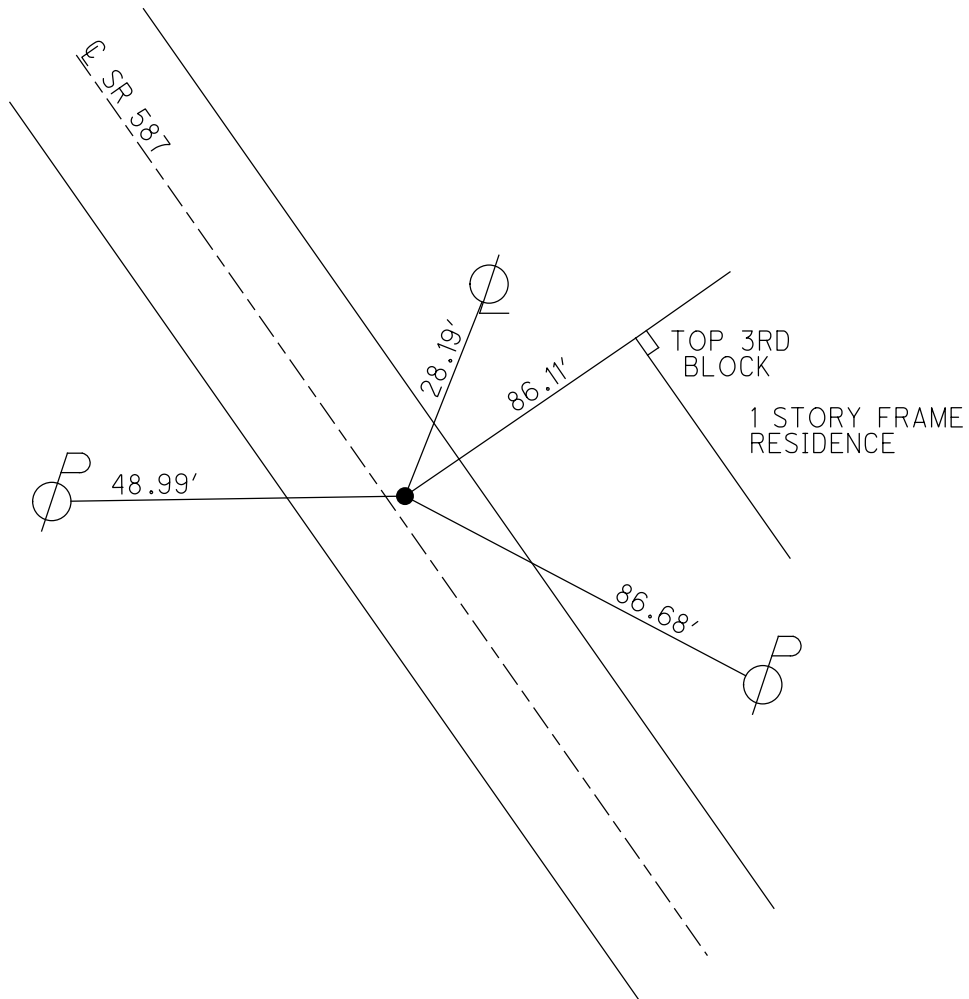

O.D.O.T. DISTRICT 2 SURVEY OFFICE

PERSONNEL

REFERENCE NO. 17

SHEET 20 OF 30

NOTES FINGER

DATE 5-24-11

ROUTE SR 587

H.C. MOSER

WEATHER OVERCAST

COUNTY SENECA

R.C. HARBAUGH

TEMP. 65°

TOWNSHIP BIG SPRINGS

SECTION 12

T 1 N R 13 E

TYPE MONUMENT PK/WASHER


ON SURFACE - ~~BELOW~~ ON

LEFT - ~~C PAV'T~~ - RIGHT 1.6'

12.3' TO RT. EDGE PAVEMENT

S.L.M. 276+37


Grid: Northing: 506942.641 Easting: 1741930.078

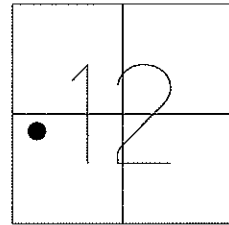

RECORD:
275+37

FD P.K/WASHER
5/24/11, KPM

GPS, REF 17
5/26/11, KPM

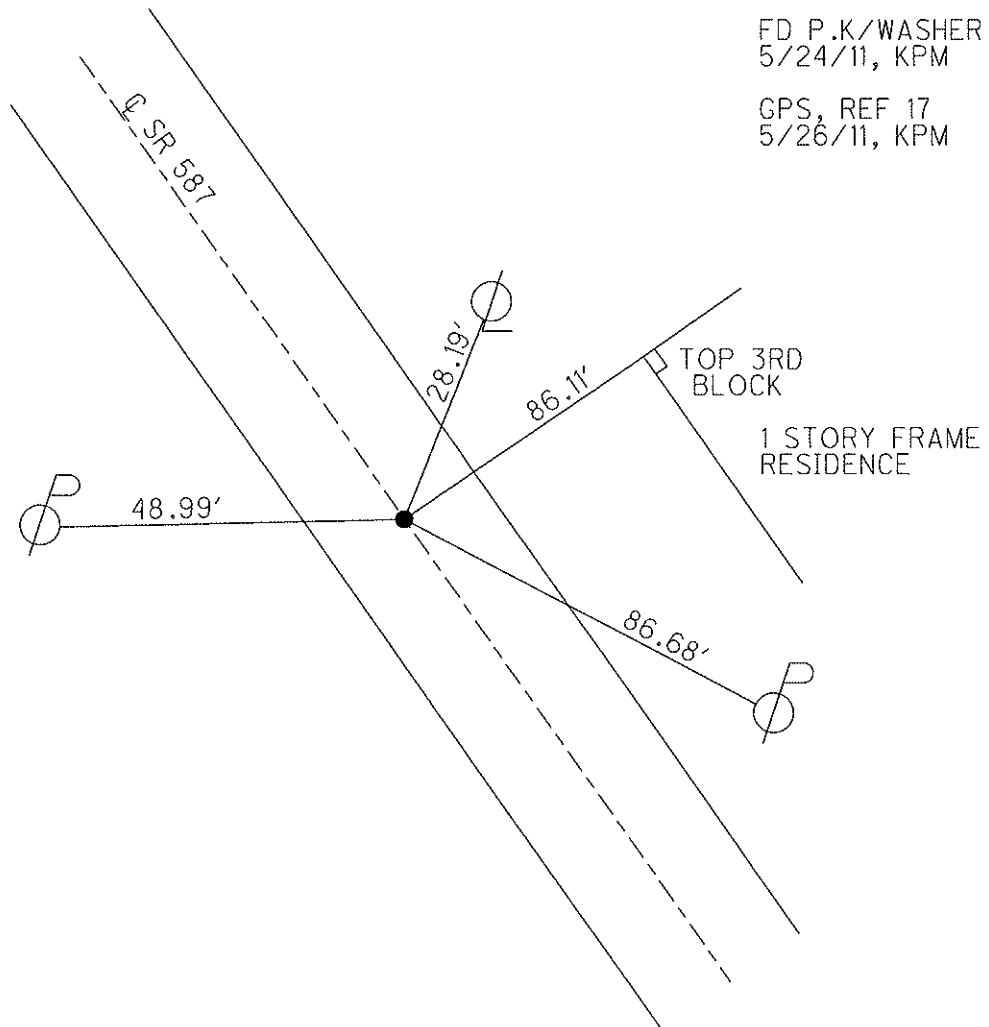

O.D.O.T. DISTRICT 2 SURVEY OFFICE

PERSONNEL

REFERENCE NO. 17

SHEET 18 OF 24

NOTES CANTERBURY

H.C. ROUSOS

R.C. LOEHRKE

DATE 5-5-98

WEATHER SUN

TEMP. +65° F

ROUTE #587

COUNTY SENECA

TOWNSHIP BIG SPRINGS

SECTION 12

T 1 N R 13 E


TYPE MONUMENT P.K. & WASHER ATOP R.R. SPK.

ON SURFACE - BELOW SURFACE


LEFT - ☉ PAV'T. - RIGHT 1.5' LT ☉

12.0' TO RT EDGE PAVEMENT

S.L.M.K. = 8+410.82

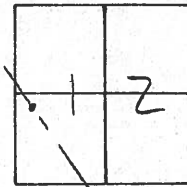

SLM = 5.234

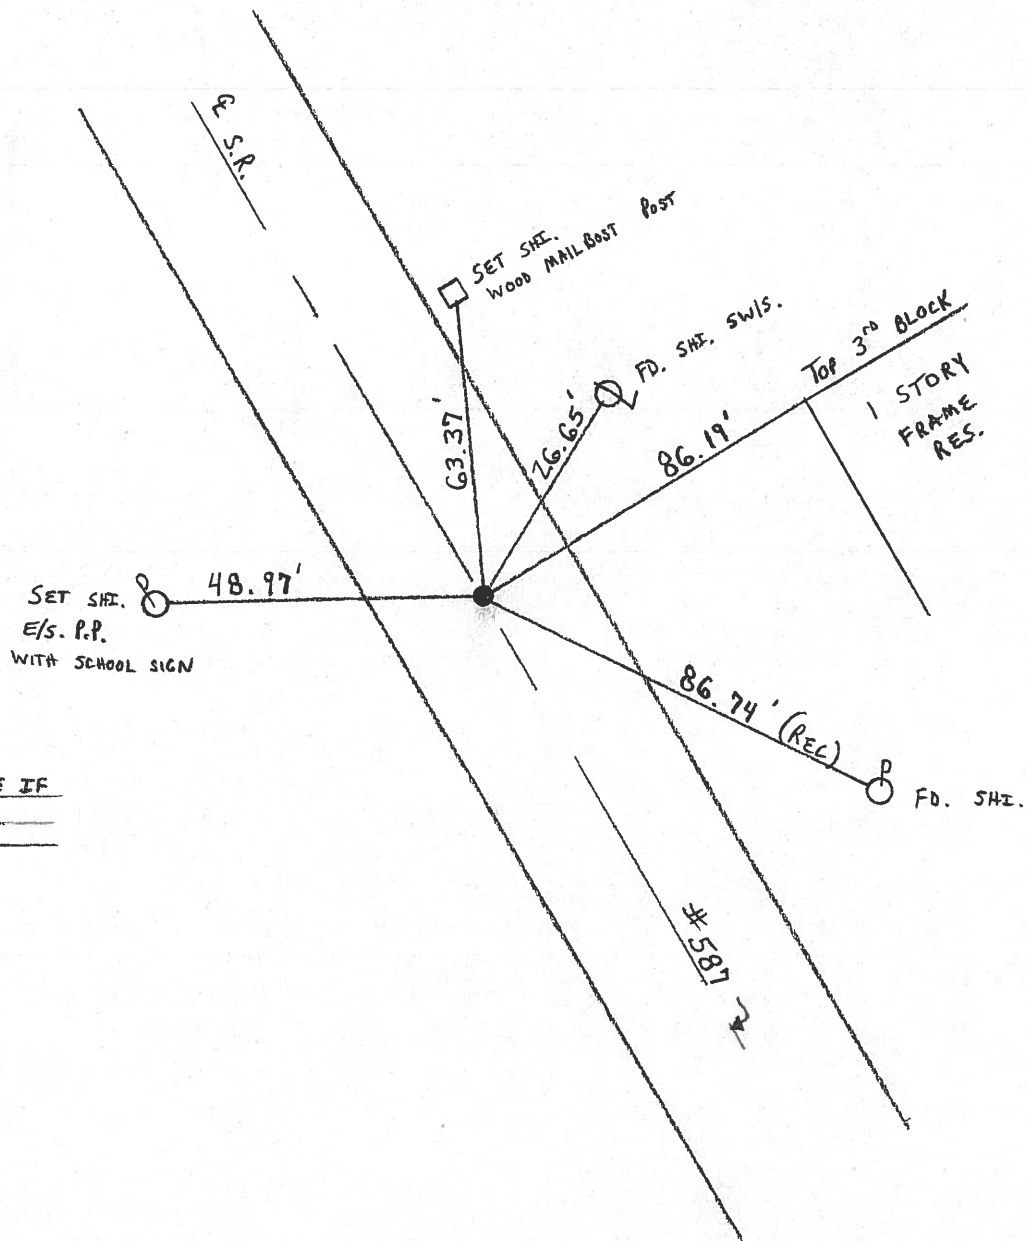

RECORD: CHECK TO SEE IF
POINT IS ON LINE.
276+37

O.D.O.T. DISTRICT 2 SURVEY OFFICE

PERSONNEL



NOTES CRONIN
H.C. RIPPLE
R.C. BARBOUR
GEYMAN

REFERENCE NO. 17
DRAWN 8/30/85
DATE 8/26/85
WEATHER SUNNY
TEMP. 73°


SHEET 18 OF

ROUTE # 587
COUNTY SENECA
TOWNSHIP BIG SPRINGS
SECTION 12
T 1 N R 13 E

TYPE MONUMENT P.K. WASHER AT OP P.R. SPIKE
ON SURFACE - BELOW TOP I. P.W. ON SURFACE
LEFT - ℄ PAV'T. - RIGHT ℄ PAV'T
 TO EDGE PAVEMENT
S.L.M. 5.234 ±

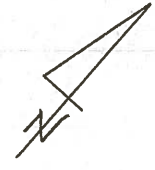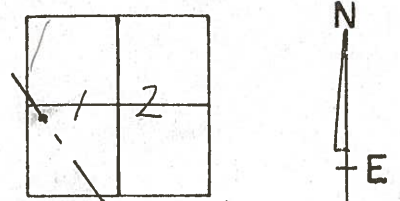

276+37 ±
CHECK TO SEE IF
POINT IS ON LINE

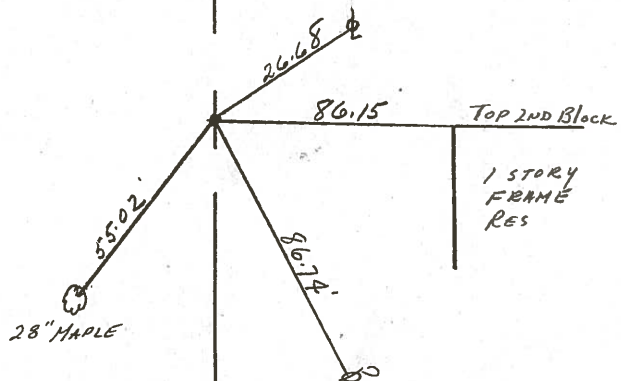

PERSONNEL	TITLE	PERSONNEL	TITLE	COUNTY	DATE	WEATHER	TEMP.
Ash				Seneca	9/28/72	overcast	62°
Cramin				S. R. #587			
Ripple							
Anderson							

DESCRIPTION Wyandot-Seneca Co Line - Northwest JOB NO. _____

LEFT CENTER LINE RIGHT

