


O.D.O.T. DISTRICT 2 SURVEY OFFICE (USE ONLY)

PERSONNEL _____ REFERENCE NO. 21 SHEET 25 OF 30
 NOTES MILLER DATE 12/28/23 ROUTE SR 587
 H.C. RHOADES WEATHER RAIN COUNTY SENECA
 R.C. MILLER TEMP. 44° TOWNSHIP BIG SPRINGS
 DWG BY RHOADES PID PAVING TRAIN SECTION 2
 T 1 N R 13 E


TYPE MONUMENT P.K.NAIL
 ON SURFACE - ~~BELOW~~ ON
 OFFSET 0.6' LT : ~~RT~~
12.3' TO RT EDGE PAVEMENT
 STATION: 383+90

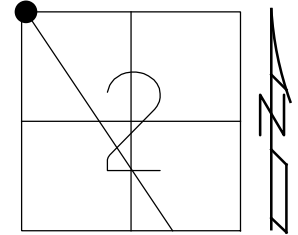

HORIZ.DATUM: NAD83 2011 GEOID: NAVD88 2018
 GRID: NORTHING: 515955.972 EASTING: 1735944.070

RECORD:
 SET P.K./WASHER
 10/13/98, MRC
 FD P.K./WASHER
 5/25/11, KPM
 REFA21
 5/26/11, KPM
 9/12/11
 FD P.K. NAIL
 7/2/21, JMR
 REF21
 9/15/23,
 12/28/23, JMR

SENECA LPD:
 N: 284339.388
 E: 110671.387

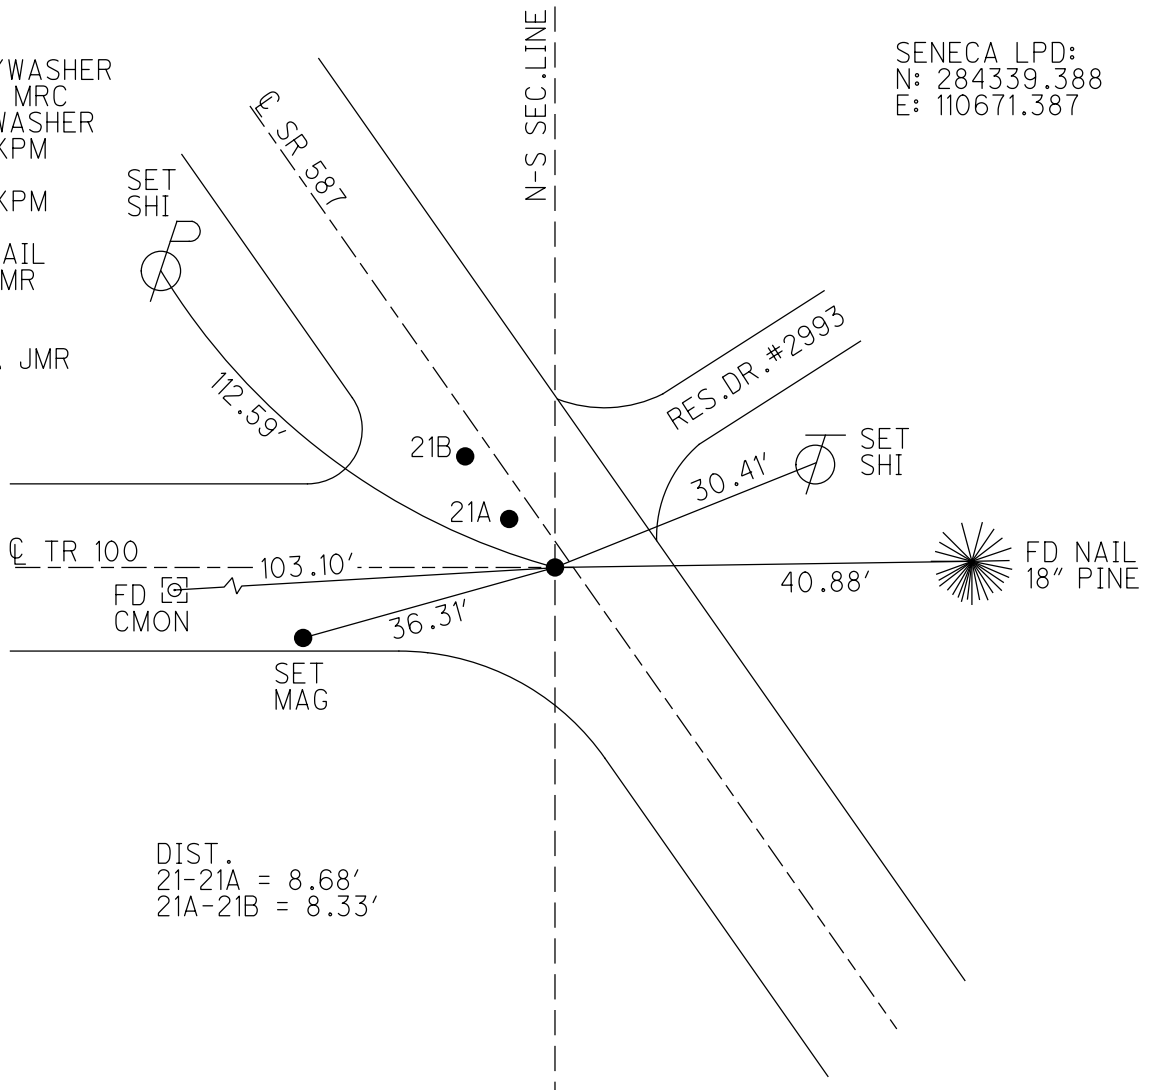

DIST.
 21-21A = 8.68'
 21A-21B = 8.33'

O.D.O.T. DISTRICT 2 SURVEY OFFICE (USE ONLY)

PERSONNEL

REFERENCE NO. 21

SHEET 25 OF 30

NOTES FINGER DATE 5/25/11
 H.C. MOSER WEATHER SUNNY
 R.C. LUMBREZER TEMP. 60°

ROUTE SR 587
 COUNTY SENECA
 TOWNSHIP BIG SPRINGS
 SECTION 2

DWG BY NIESE PID PAVE TRAIN

T 1 N R 13 E

TYPE MONUMENT P.K.

ON SURFACE - ~~BELOW~~ ON

OFFSET CL PAVEMENT 0.6' LT : ~~RT~~

12.3' TO RT EDGE PAVEMENT



STATION: 383+90

HORZ.DATUM: _____

GEOID: _____

GRID: NORTHING: 515955.971

EASTING: 1735944.066

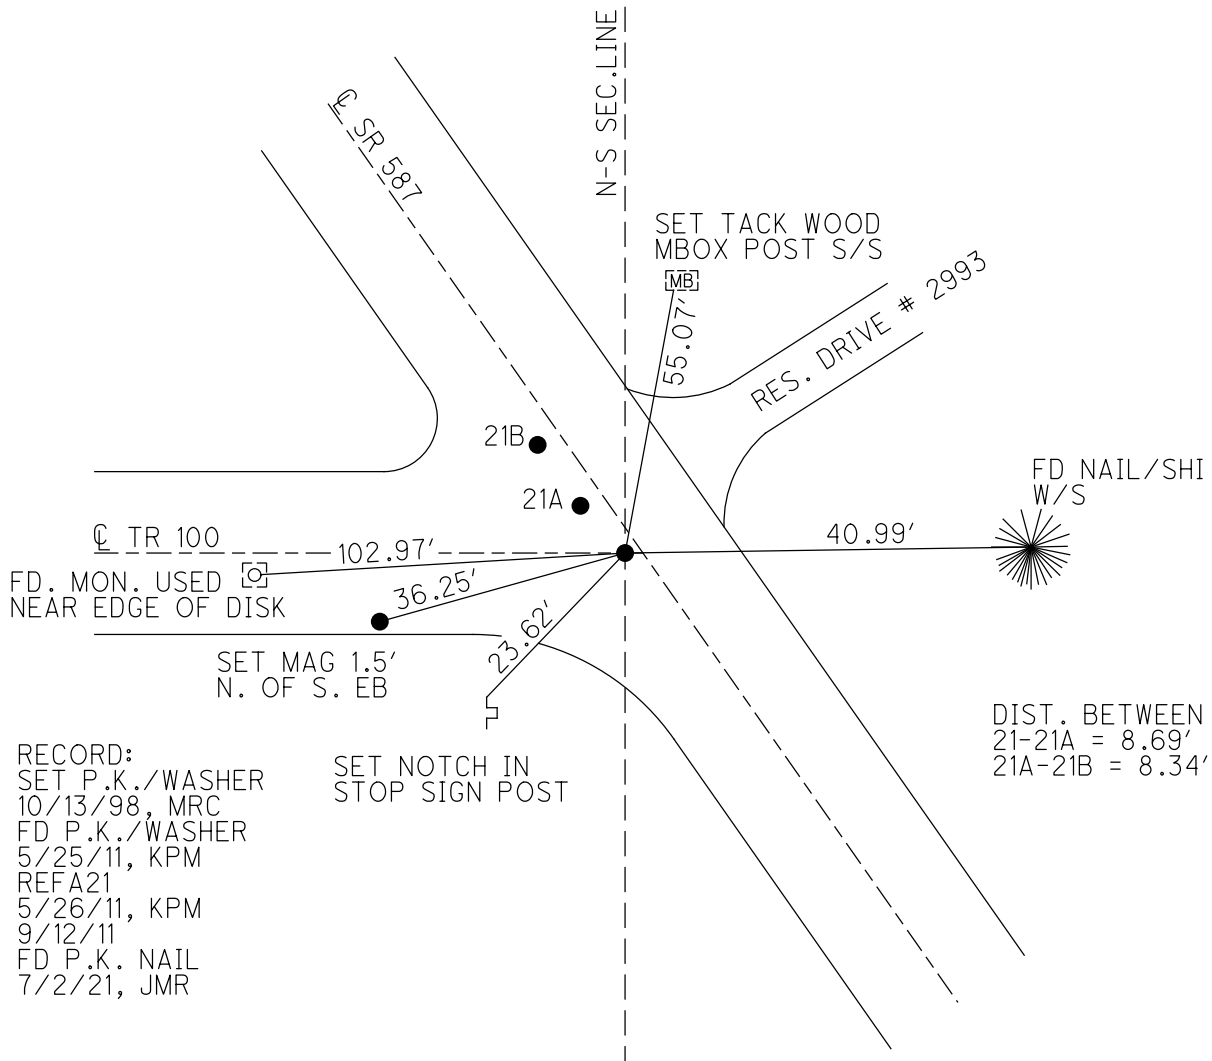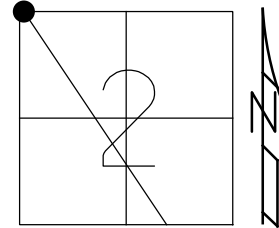

O.D.O.T. DISTRICT 2 SURVEY OFFICE

PERSONNEL _____

REFERENCE NO. 21

SHEET 25 OF 30

NOTES FINGER _____

DATE 5-25-11

ROUTE SR 587

H.C. MOSER

WEATHER SUNNY

COUNTY SENECA

R.C. LUMBREZER

TEMP. 60°

TOWNSHIP BIG SPRINGS

SECTION 2

T 1 N 13 E

TYPE MONUMENT PK


ON SURFACE - ~~BELOW~~ ON _____

LEFT - C PAV'T - RIGHT 0.6'


12.3' TORT. EDGE PAVEMENT

S.L.M. 383+90

Grid: Northing: 515955.971 Easting: 1735944.066

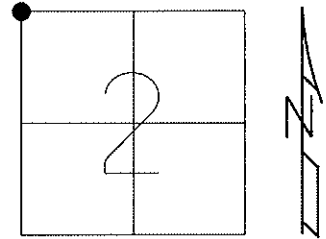

Preventative Maintenance
Chip & Seal
Existing Point Uncovered
Date: 9-12-2011

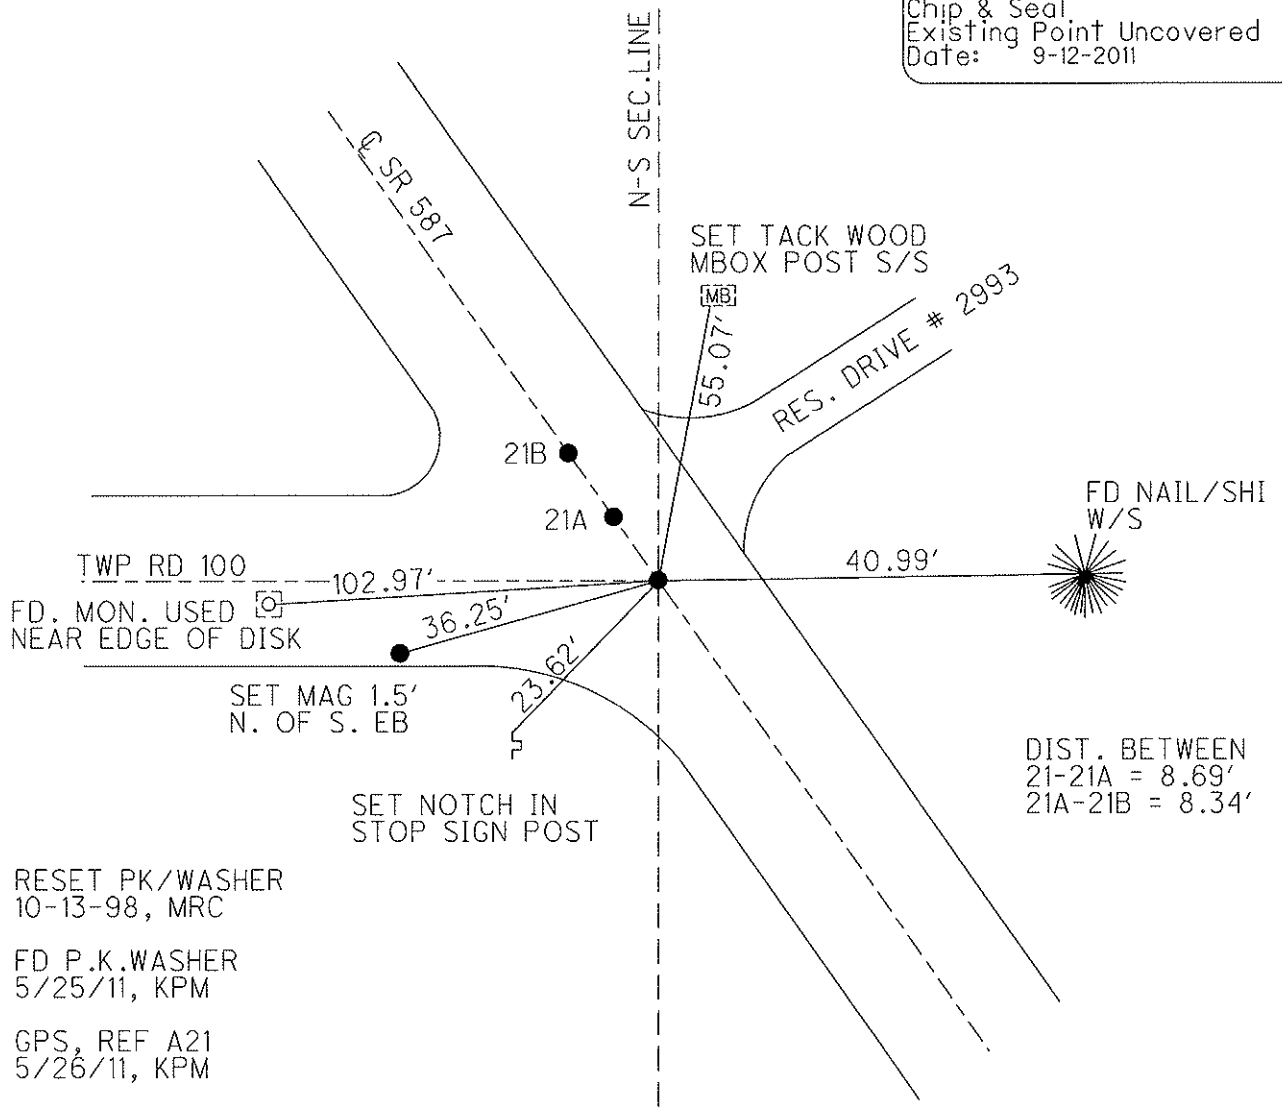

O.D.O.T. DISTRICT 2 SURVEY OFFICE

PERSONNEL

REFERENCE NO. 21

SHEET 22 OF 24

NOTES CANTERBURY

H.C. Rousos

R.C. LOEHRKE

DATE 5-5-98

WEATHER SUN

TEMP. +65° F


ROUTE # 587

COUNTY SENECA

TOWNSHIP BIG SPRINGS


SECTION 2

T1 N R 13 E

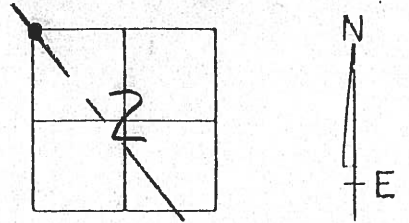

TYPE MONUMENT P.K. & WASHER ATOP R.R. SPK.
 ON SURFACE - ~~BELOW~~ ON SURFACE
 LEFT - ~~C~~ PAV'T. - RIGHT 1.4' LT &
12.8' TO RT EDGE PAVEMENT
 S.L. ~~MARK~~ = 11+704.02

RESET P.K. & WASHERS @ BOTH
 10-13-98
 M.R.C.

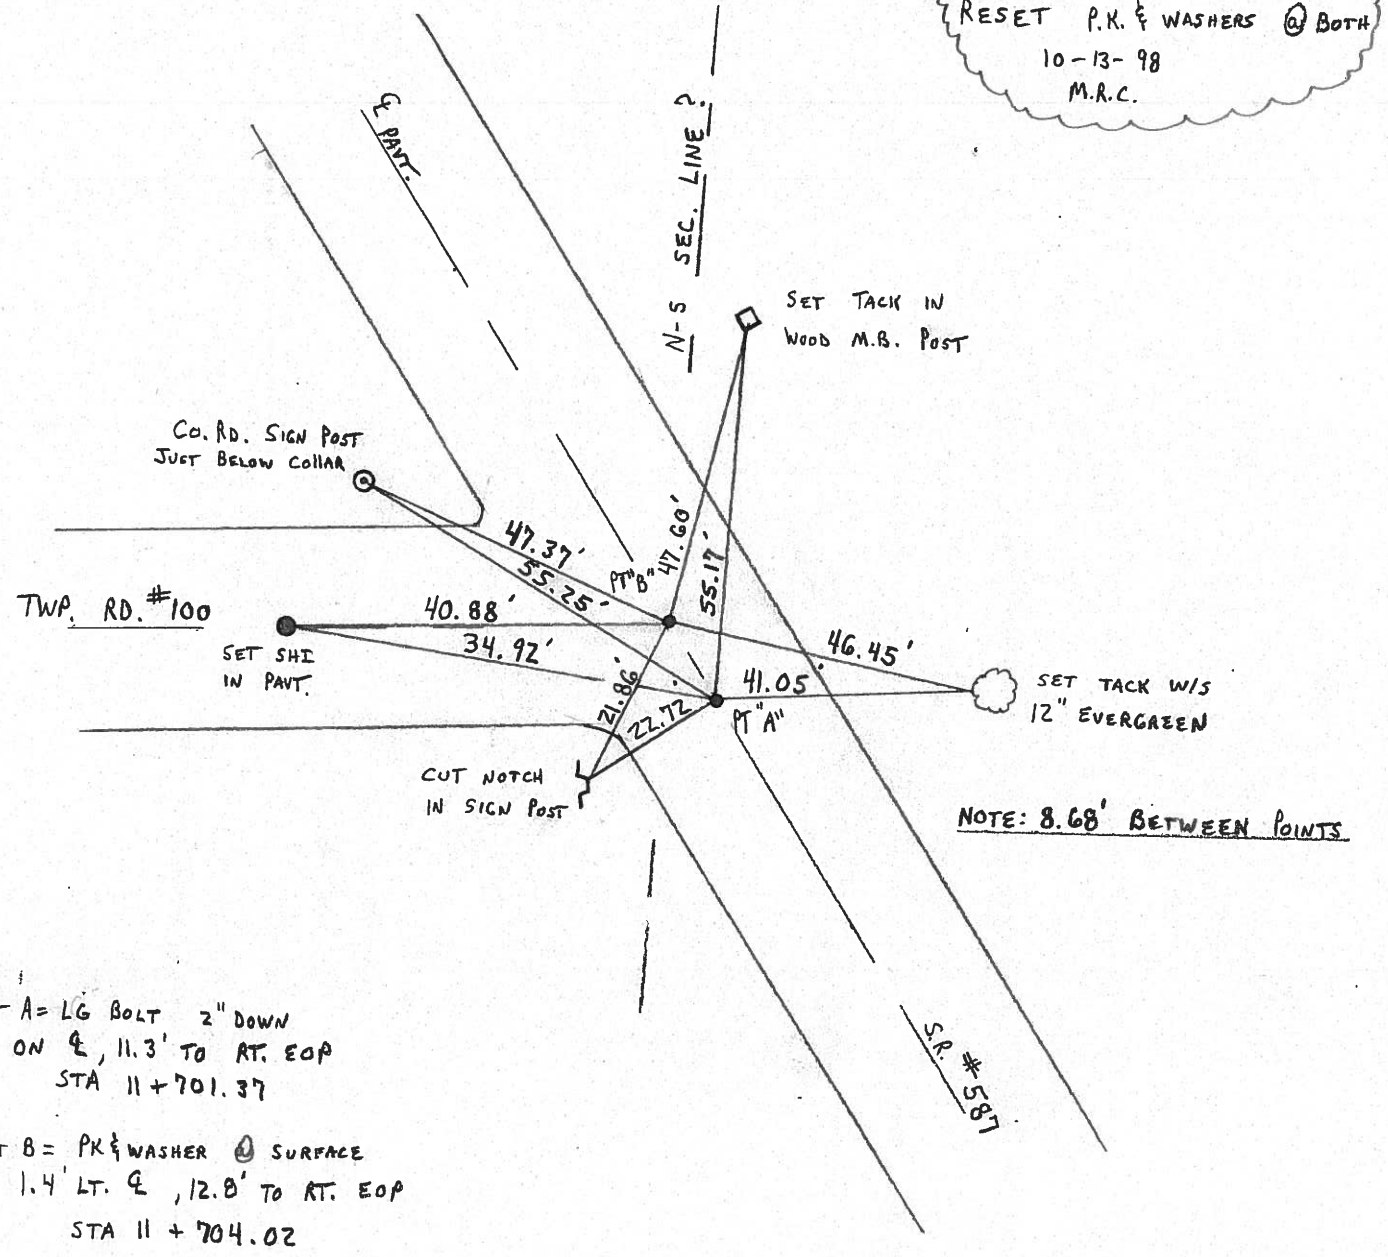

PT A = LG BOLT 2" DOWN
 ON &, 11.3' TO RT. EOP
 STA 11+701.37

PT B = PK & WASHER @ SURFACE
 1.4' LT. &, 12.8' TO RT. EOP
 STA 11+704.02