

O.D.O.T. DISTRICT 2 SURVEY OFFICE (USE ONLY)

PERSONNEL _____

REFERENCE NO. 1

SHEET 1 OF 2

NOTES CORDES

DATE 10/1/95

ROUTE SR 613

H.C. BARNHISEL

WEATHER SUNNY

COUNTY SENECA

R.C. VAN DUSEN

TEMP. 65°

TOWNSHIP LOUDON

SECTION 6

DWG BY NIESE PID _____

T 2 N R 13 E

TYPE MONUMENT MONBOX W/ R.R. SPIKE

ON SURFACE - ~~BELOW~~ ON

OFFSET \varnothing PAVEMENT ON LT : RT

- TO - EDGE PAVEMENT


STATION: 13+19

HORZ. DATUM: _____


GEOID: _____

GRID: NORTHING: _____

EASTING: _____

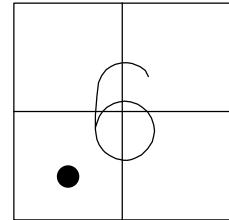

RECORD:
FD MONBOX
W/ R.R. SPIKE
10/1/93, MB
11/23/93

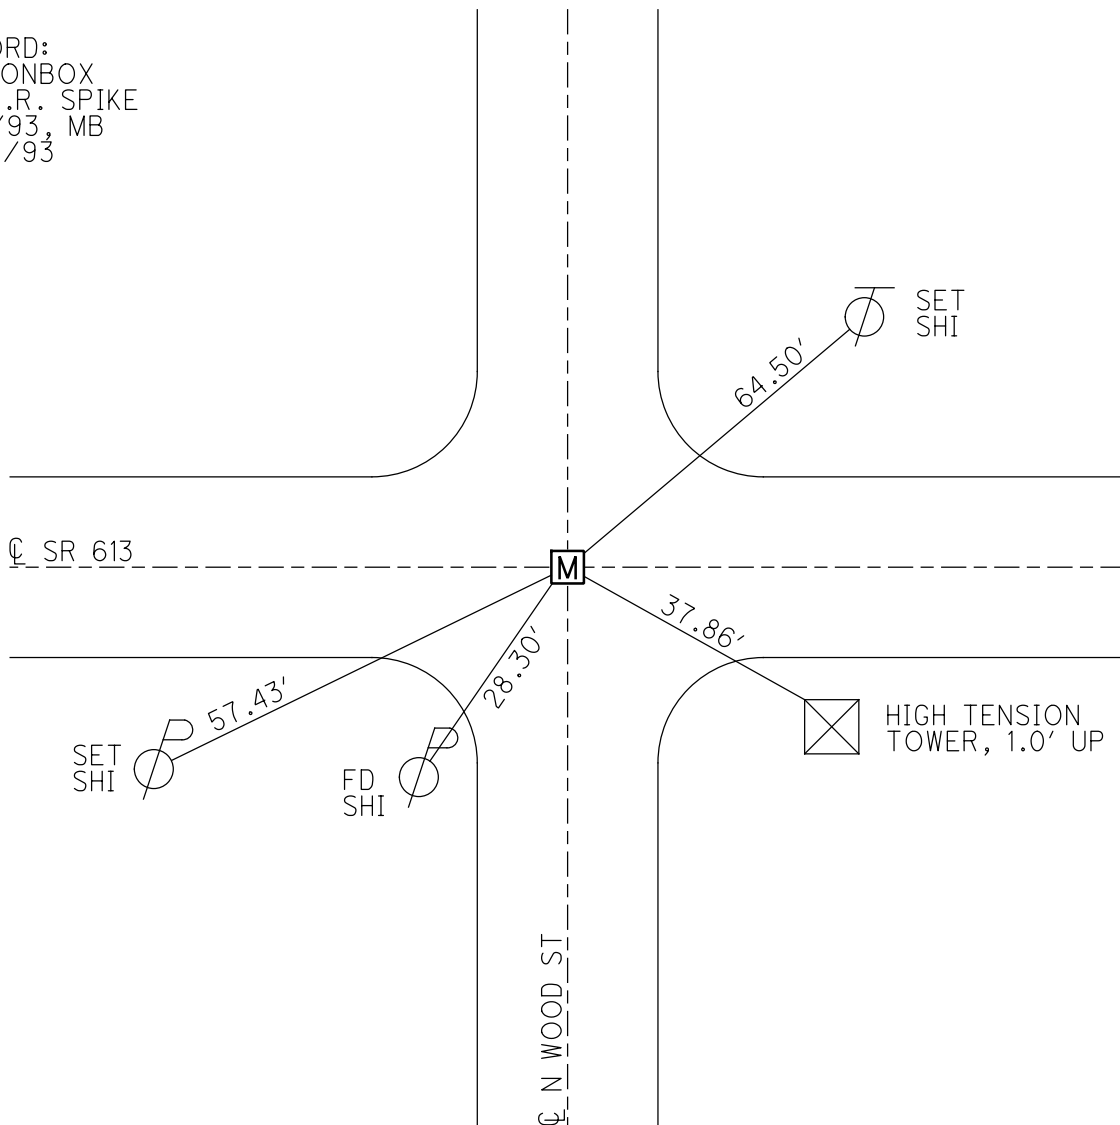

O.D.O.T. DISTRICT 2 SURVEY OFFICE (USE ONLY)

PERSONNEL _____

REFERENCE NO. 2

SHEET 2 OF 2

NOTES CORDES

DATE 10/1/93

ROUTE SR 613

H.C. BARNHISEL

WEATHER SUNNY

COUNTY SENECA

R.C. VAN DUSEN

TEMP. 65°

TOWNSHIP LOUDON

SECTION 6

DWG BY NIESE PID _____

T 2 N R 13 E

TYPE MONUMENT P.K./WASHER

ON SURFACE - ~~BELOW~~ ON


OFFSET ☉ PAVEMENT ON LT : RT

- TO - EDGE PAVEMENT

STATION: 19+54

HORZ.DATUM: _____ GEOID: _____

GRID: NORTHING: _____ EASTING: _____

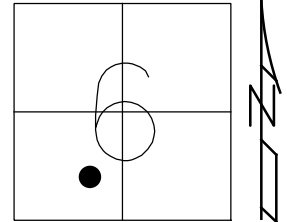

RECORD:
FD P.K./WASHER
10/1/93, MB
11/23/93

