

O.D.O.T. DISTRICT 2 SURVEY OFFICE (USE ONLY)

PERSONNEL _____

REFERENCE NO. 1

SHEET 1 OF 2

NOTES CORDES

DATE 10/1/95

ROUTE SR 613

H.C. BARNHISEL

WEATHER SUNNY

COUNTY SENECA

R.C. VAN DUSEN

TEMP. 65°

TOWNSHIP LOUDON

SECTION 6

DWG BY NIESE PID _____

T 2 N R 13 E

TYPE MONUMENT MONBOX W/ R.R. SPIKE

ON SURFACE - ~~BELOW~~ ON

OFFSET \varnothing PAVEMENT ON LT : RT

- TO - EDGE PAVEMENT


STATION: 13+19

HORIZ.DATUM: _____


GEOID: _____

GRID: NORTHING: _____

EASTING: _____

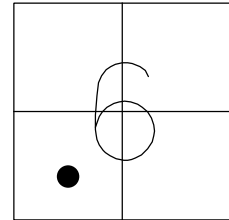

RECORD:
FD MONBOX
W/ R.R. SPIKE
10/1/93, MB
11/23/93

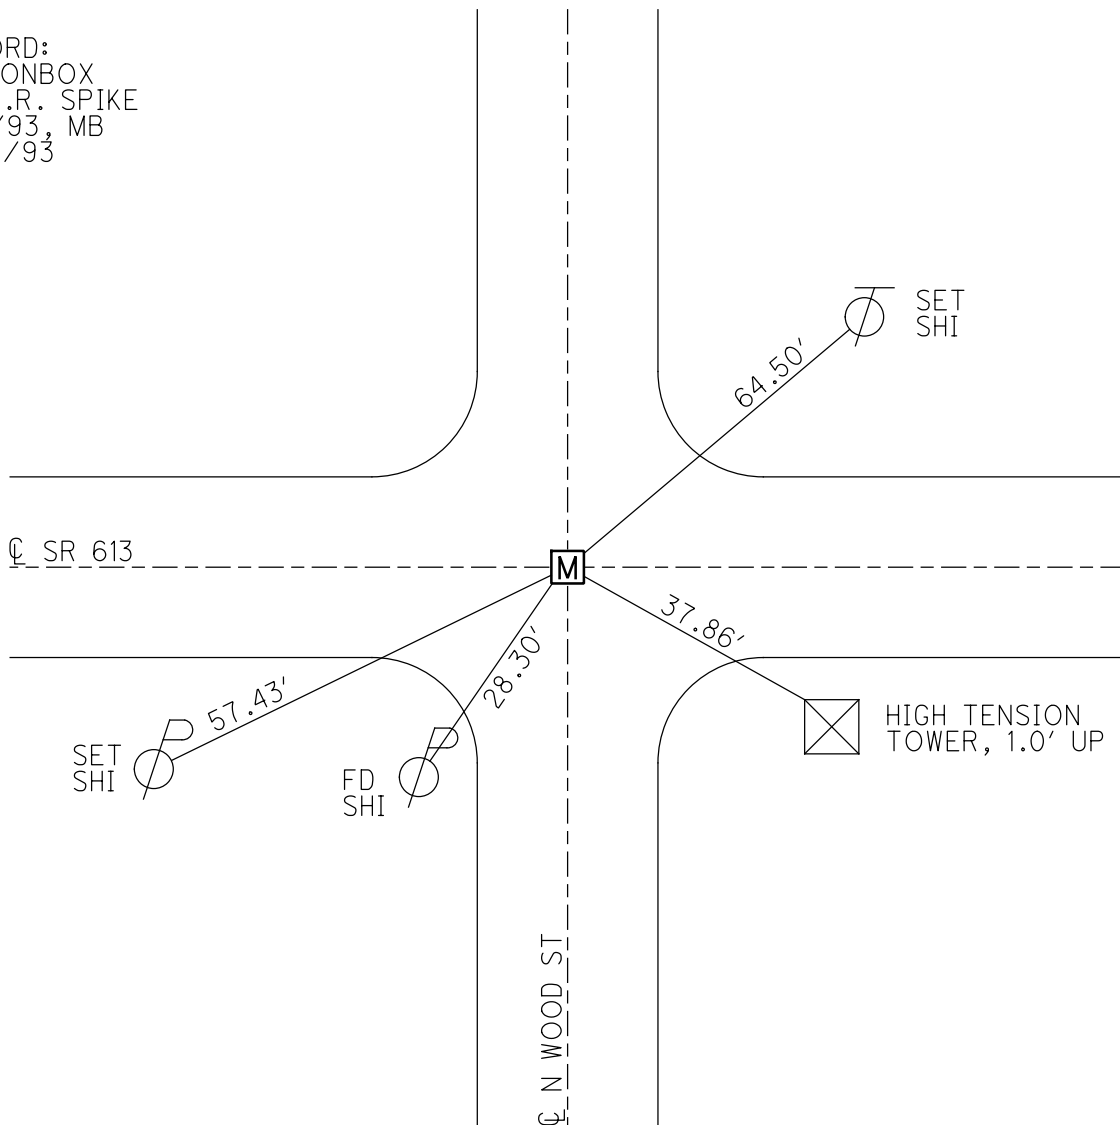

O.D.O.T. DISTRICT 2 SURVEY OFFICE

PERSONNEL

REFERENCE NO. _____


SHEET _____ OF _____

NOTES CORDES
 M.C. BARNHISEL
 R.C. VAN DUSEN

DATE 10-1-93
 WEATHER SUNNY
 TEMP. +65° F

ROUTE 613
 COUNTY SENECA
 TOWNSHIP LOUDON
 SECTION 6
 T 2 N R 13 E

TYPE MONUMENT RR SPIKE IN MON BOX
 ON SURFACE - BELOW _____
~~LEFT~~ E PAVT. - ~~RIGHT~~ ON E
 _____ TO _____ EDGE PAVEMENT
 S.L.M. _____

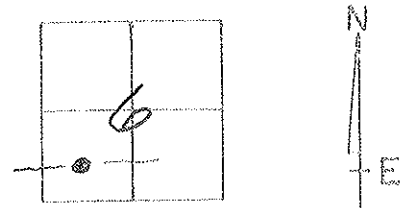

RR SPK IN MON, BOX
 11-23-93

