

O.D.O.T. DISTRICT 2 SURVEY OFFICE (USE ONLY)

PERSONNEL _____

REFERENCE NO. 2

SHEET 2 OF 2

NOTES CORDES

DATE 10/1/93

ROUTE SR 613

H.C. BARNHISEL

WEATHER SUNNY

COUNTY SENECA

R.C. VAN DUSEN

TEMP. 65°

TOWNSHIP LOUDON

SECTION 6

DWG BY NIESE PID _____

T 2 N R 13 E

TYPE MONUMENT P.K./WASHER

ON SURFACE - ~~BELOW~~ ON


OFFSET ☉ PAVEMENT ON LT : RT

- TO - EDGE PAVEMENT


STATION: 19+54

HORZ.DATUM: _____ GEOID: _____

GRID: NORTHING: _____ EASTING: _____

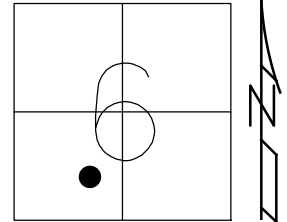

RECORD:
FD P.K./WASHER
10/1/93, MB
11/23/93

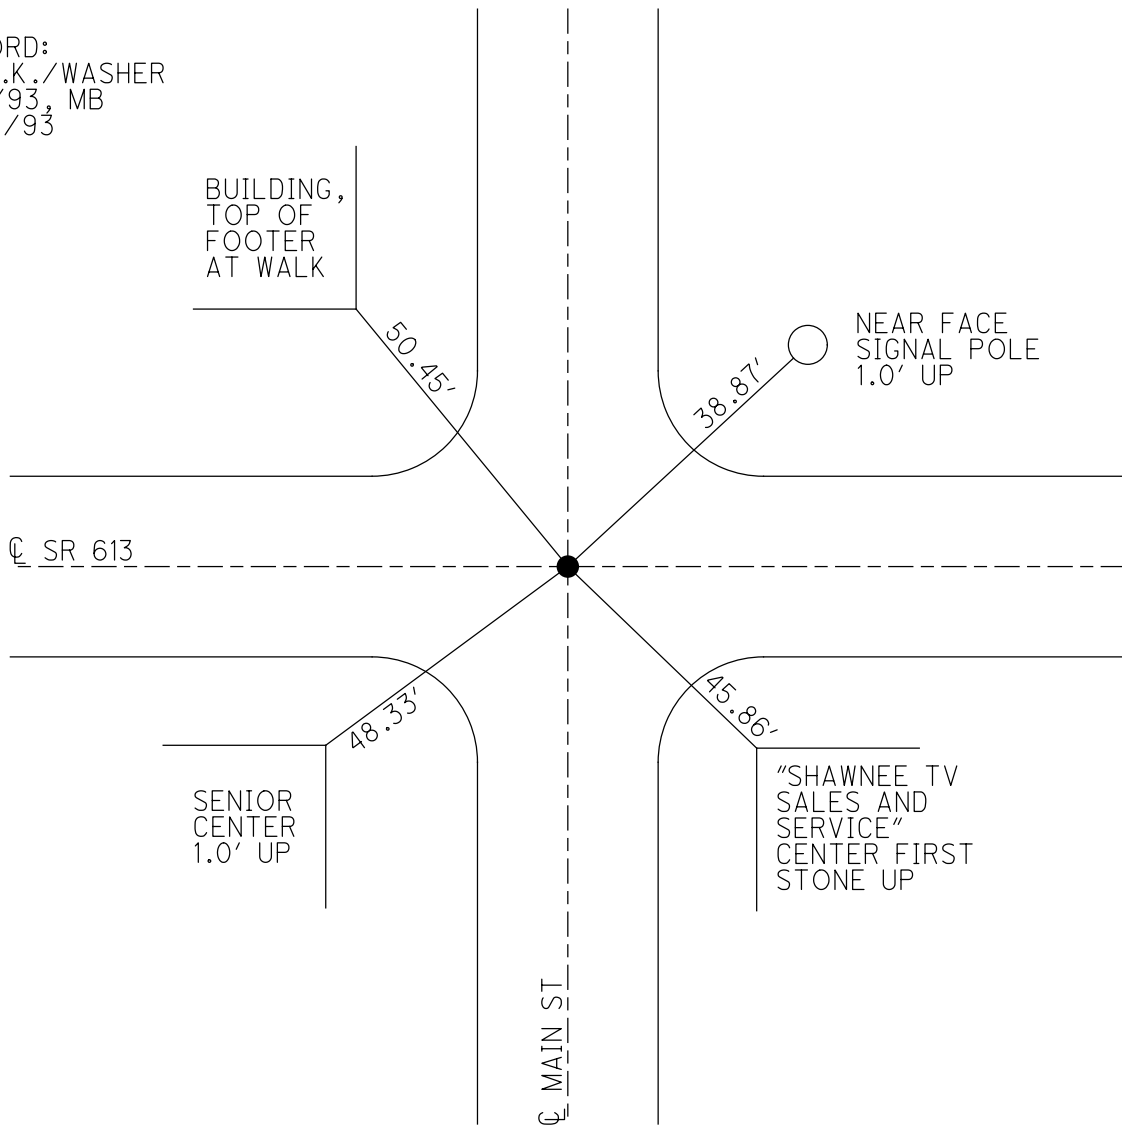

O.D.O.T. DISTRICT 2 SURVEY OFFICE

PERSONNEL _____

REFERENCE NO. _____

SHEET _____ OF _____

NOTES COEDS

H.C. BARNHISEL

R.C. VAN DUSEN

DATE 10-1-93

WEATHER SUNNY

TEMP. +65°F

ROUTE 613

COUNTY SENECA

TOWNSHIP LOUDON

SECTION 6

T 2 N R 13 E


TYPE MONUMENT PK & WASHER

ON SURFACE - ~~BELOW~~ YES

~~LEFT - & PAV'T. - RIGHT~~ ON &

TO EDGE PAVEMENT

S.L.M. 19+54

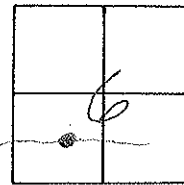

PK & WASHER
 @ SURFACE
 (POINT NOT DISTURBED)
 11-23-93

NEAR FACE
 SIGNAL POLE
 1.0' UP

