


O.D.O.T. DISTRICT 2 SURVEY OFFICE (USE ONLY)


PERSONNEL _____ REFERENCE NO. 40 SHEET 18 OF 46
 NOTES HOMAN DATE 7/21/09 ROUTE SR 101
 H.C. HOMAN WEATHER SUNNY COUNTY SENECA
 R.C. ROUSOS TEMP. 80° TOWNSHIP ADAMS
 _____ SECTION 19
 _____ T 3 N R 16 E

TYPE MONUMENT IPIN
~~ON SURFACE~~ - BELOW 1 1/2"
 LEFT - ☉ PAV'T - RIGHT ON
- TO - EDGE PAVEMENT
 S.L.M. 509+76

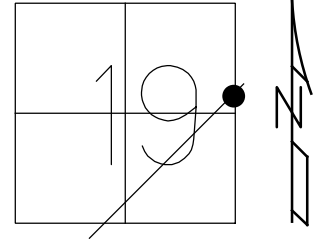

GRID: NORTHING: 561671.718 EASTING: 1816059.766

RECORD:
 STA. 0+00
 FD P.K./WASHER
 ATOP IPIN
 SET P.K./WASHER
 8/27/90
 FD P.K./WASHER
 2/4/05, SAH
 SET MAG/WASHER
 10/8/09, DCH
 FD MAG/WASHER
 REF40
 6/14/16, JFO
 UNCOVERED
 9/18/17, JFO

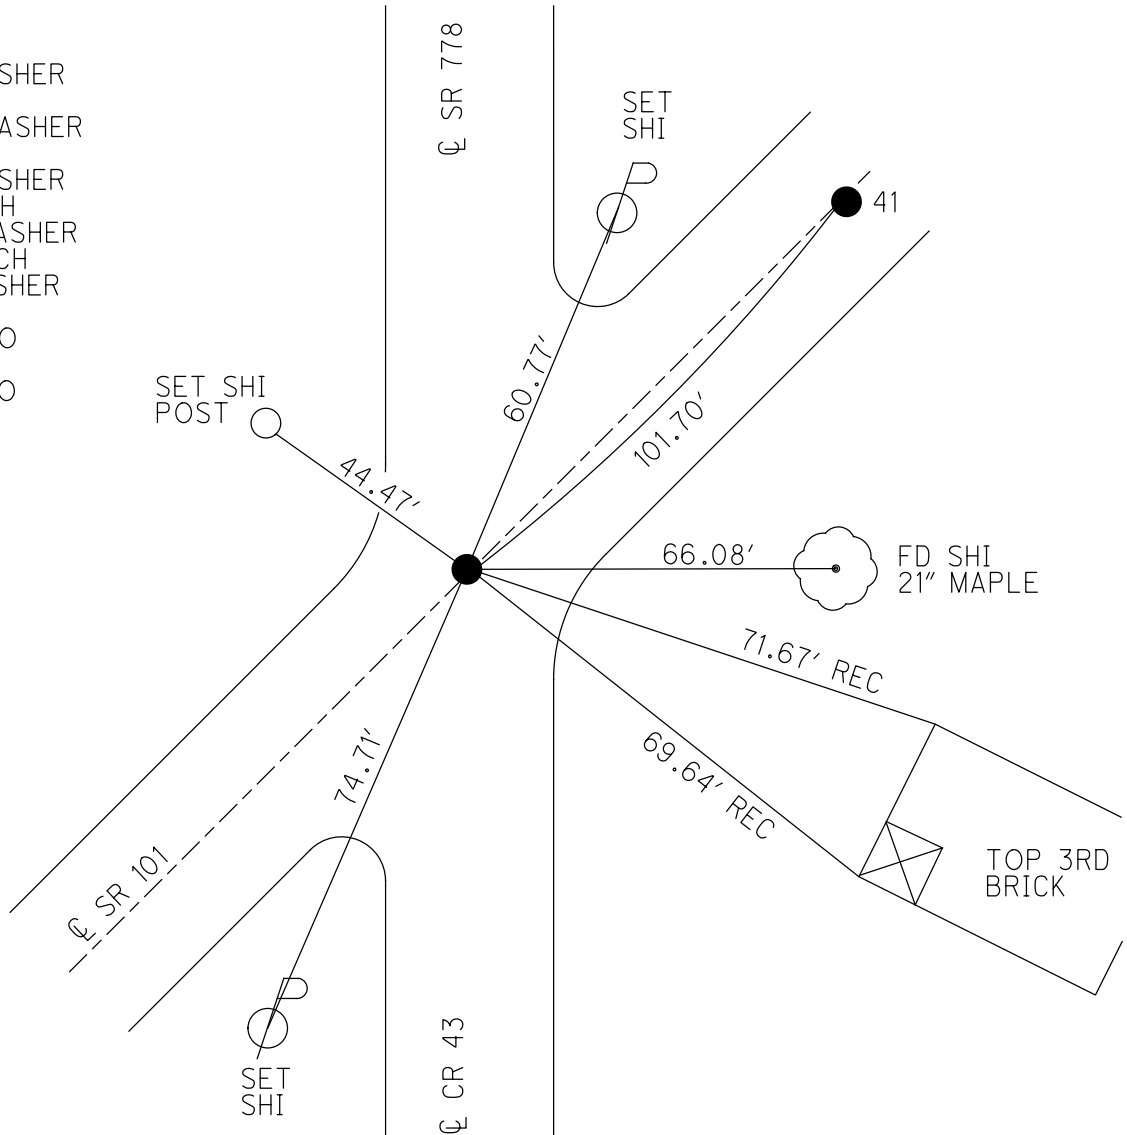


O.D.O.T. DISTRICT 2 SURVEY OFFICE (USE ONLY)

PERSONNEL _____ REFERENCE NO. 74 SHEET 24 OF 32
 NOTES RHOADES DATE 6-4-18 ROUTE SR 19
 H.C. O'DONNELL WEATHER CLOUDY COUNTY SENECA
 R.C. TRENKA TEMP. 62° TOWNSHIP ADAMS
 _____ SECTION 17
 _____ T 3 N R 16 E

TYPE MONUMENT MAG/WASHER
 ON SURFACE - ~~BELOW~~ ON
 LEFT - Q PAV'T - RIGHT ON
9.0' TO LT EDGE PAVEMENT
 S.L.M. 908+68.80

GRID: NORTHING: 563918.290 EASTING: 1816026.018

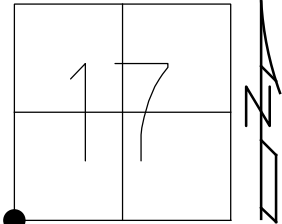

RECORD:
 SET P.K./WASHER
 10-07-96
 FD P.K./WASHER
 12-15-03, 7-15-09,
 7-15-10
 FD PK/WASHER
 REF 74
 4-26-16
 6-27-16, JFO
 8-23-16, JFO
 SET MAG/WASHER
 6-4-18, JFO

