


O.D.O.T. DISTRICT 2 SURVEY OFFICE (USE ONLY)

PERSONNEL \_\_\_\_\_ REFERENCE NO. 40 SHEET 18 OF 46  
 NOTES HOMAN DATE 7/21/09 ROUTE SR 101  
 H.C. HOMAN WEATHER SUNNY COUNTY SENECA  
 R.C. ROUSOS TEMP. 80° TOWNSHIP ADAMS  
 \_\_\_\_\_ SECTION 19  
 \_\_\_\_\_ T 3 N R 16 E

TYPE MONUMENT IPIN  
~~ON SURFACE~~ - BELOW 1 1/2"  
 LEFT - ☉ PAV'T - RIGHT ON  
- TO - EDGE PAVEMENT  
 S.L.M. 509+76

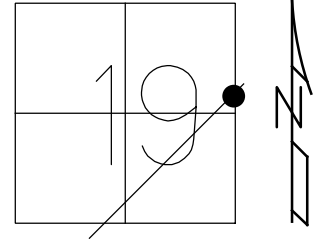

GRID: NORTHING: 561671.718 EASTING: 1816059.766

RECORD:  
 STA. 0+00  
 FD P.K./WASHER  
 ATOP IPIN  
 SET P.K./WASHER  
 8/27/90  
 FD P.K./WASHER  
 2/4/05, SAH  
 SET MAG/WASHER  
 10/8/09, DCH  
 FD MAG/WASHER  
 REF40  
 6/14/16, JFO  
 UNCOVERED  
 9/18/17, JFO

