


PERSONNEL	TITLE	PERSONNEL	TITLE	COUNTY	DATE	WEATHER	TEMP.
CROWIN				SENECA	2/22/89	cloudy - flurries	28°
RIPPLE				T.R. #33			
GEYMAN				SEC. ABBOTT'S BRIDGE ACCESS			

DESCRIPTION STONE AREA TO BE BLACKTOPPED - ODNR PARK JOB NO. _____

LEFT CENTER LINE RIGHT

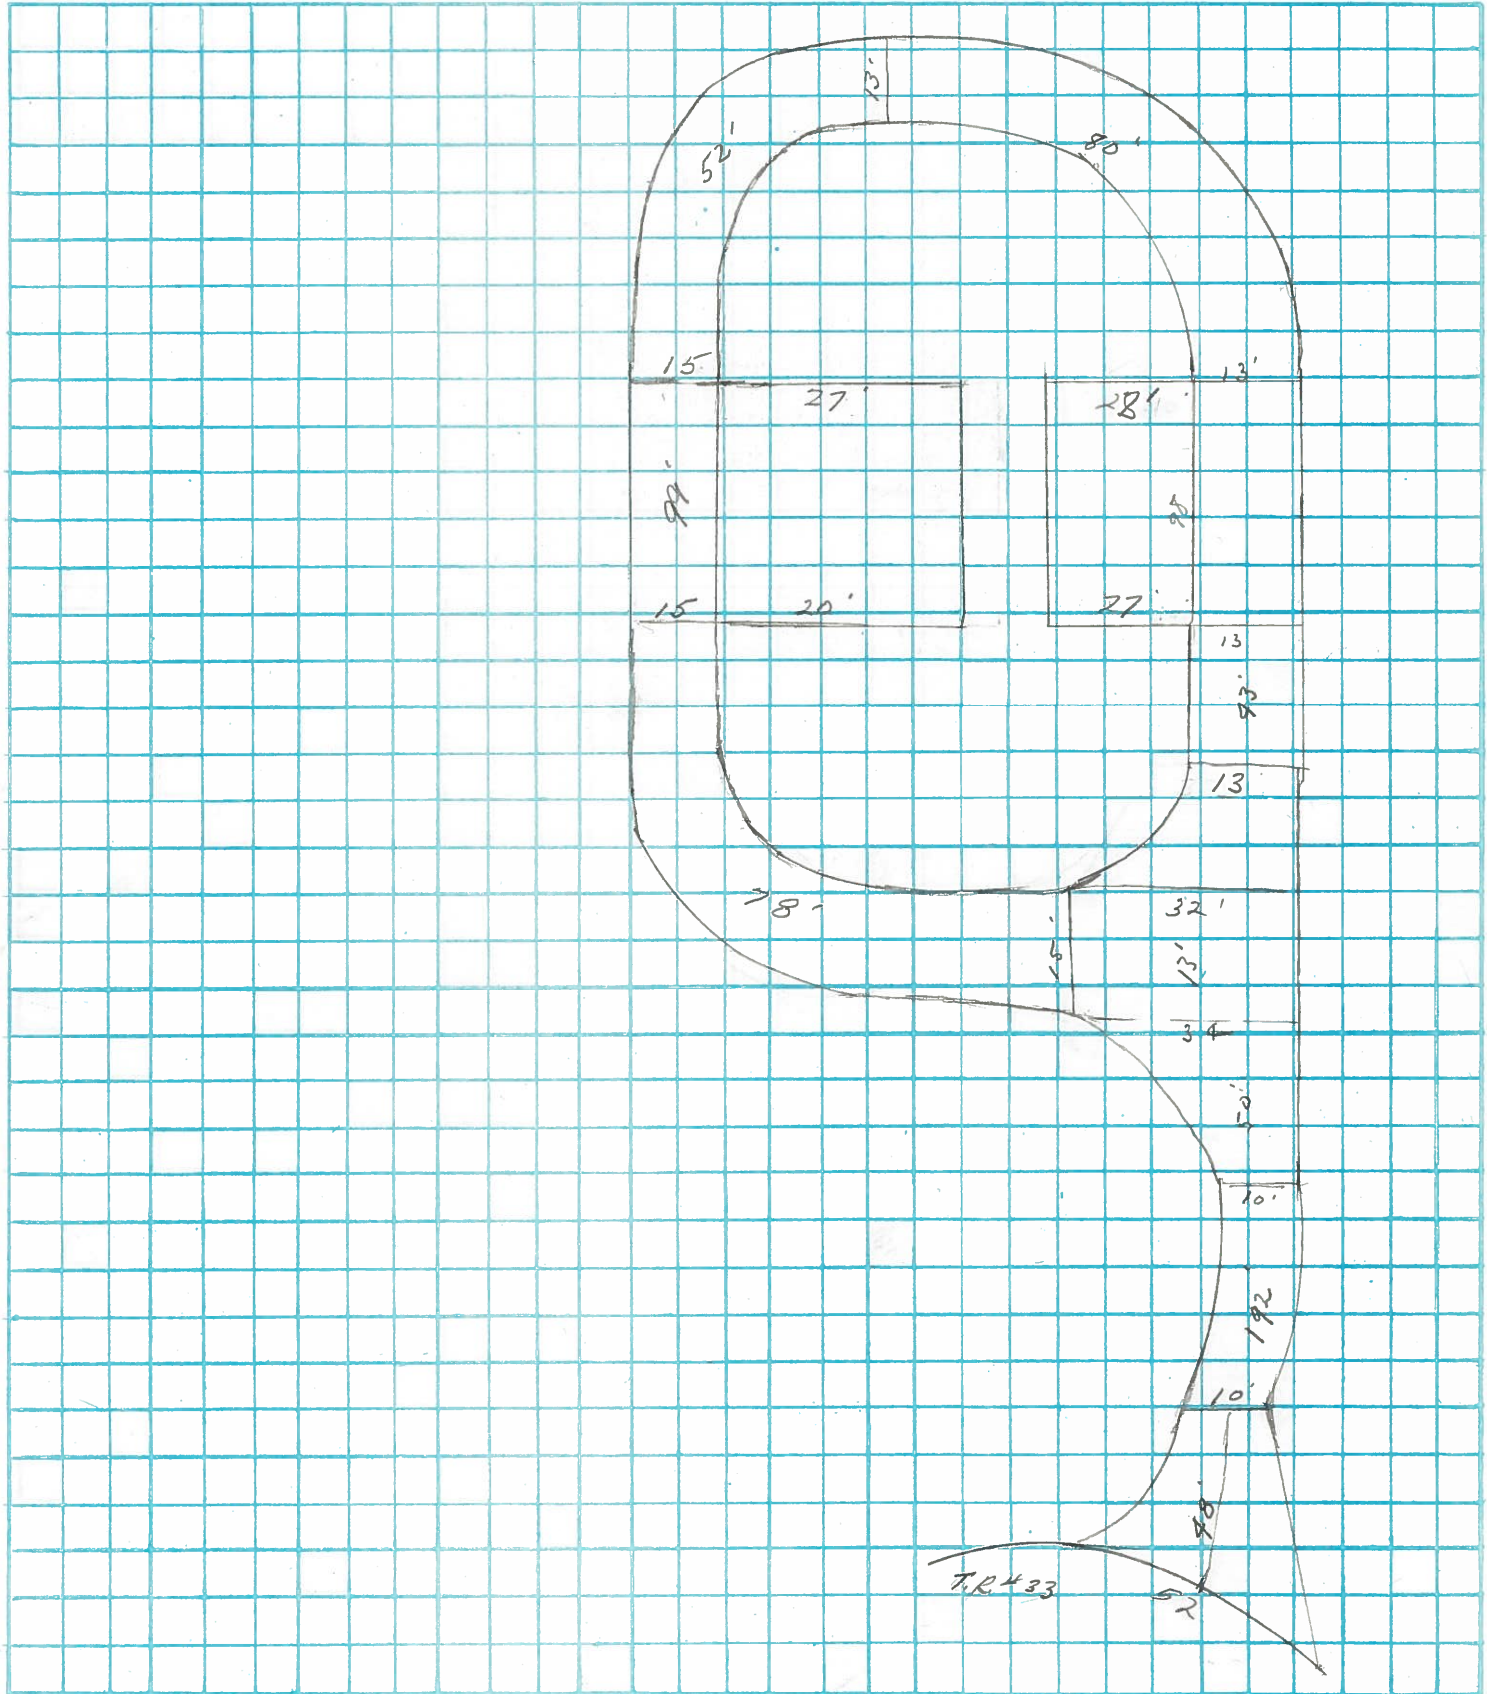

PERSONNEL TITLE PERSONNEL TITLE

CROWIN

COUNTY SENECA

DATE 2/14/89

RIPPLE

S. R. T.R.#131

WEATHER SUNNY

GEYMAN

SEC. COLLIER'S PICNIC AREA

TEMP. 40°

DESCRIPTION STONE AREA TO BE BLACKTOPPED - O.D.I.N.R. PARK

JOB NO.

LEFT

CENTER LINE

RIGHT

