


O.D.O.T. DISTRICT 2 SURVEY OFFICE (USE ONLY)


PERSONNEL _____ REFERENCE NO. 1 SHEET 1 OF 8
 NOTES RHOADES DATE 8/4/16 ROUTE SR 2
 H.C. O'DONNELL WEATHER FAIR COUNTY WILLIAMS
 R.C. RHOADES TEMP. 80° TOWNSHIP CENTER
 DWG BY RHOADES PID 85269 SECTION 35
 T 6 N R 2 E

TYPE MONUMENT MONBOX W/1" IPIN
 ON SURFACE - ~~BELOW~~ ON
 OFFSET \odot PAVEMENT 11.8' \perp : RT
0.9' TO RT EDGE PAVEMENT
 STATION: 0+00

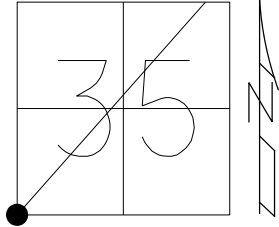

HORZ.DATUM: NAD83 2011 GEOID: NAVD88 2012A
 GRID: NORTHING: 648281.816 EASTING: 1389322.822

NOTE: REF1 SR 576

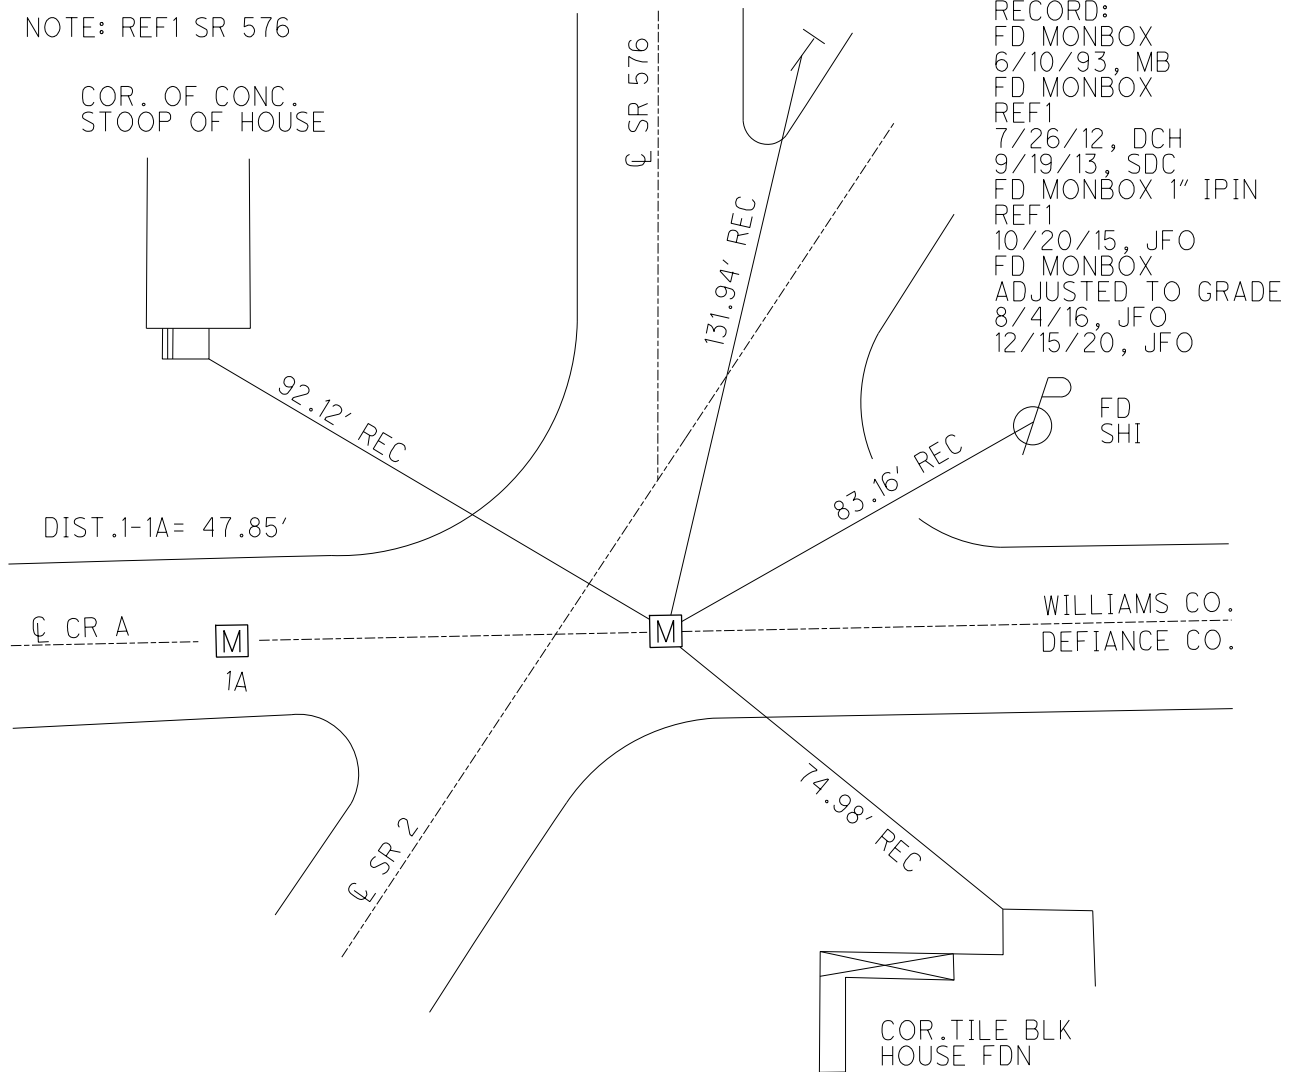

O.D.O.T. DISTRICT 2 SURVEY OFFICE (USE ONLY)

PERSONNEL

REFERENCE NO. 1

SHEET 1 OF 8

NOTES VAN DUSEN

DATE 6/10/93

ROUTE SR 2

H.C. KUSZ

WEATHER CLOUDY

COUNTY WILLIAMS

R.C. BARNHISEL

TEMP. 65°

TOWNSHIP CENTER

OTTO

SECTION 35

DWG BY NIESE

PID -

T 6 N R 2 E

TYPE MONUMENT MON BOX

ON SURFACE - ~~BELOW~~ ON

OFFSET 0.9' TO RT EDGE PAVEMENT


STATION: 0+00

HORZ.DATUM: -

GEOID: -


GRID: NORTHING: 648281.816

EASTING: 1389322.822

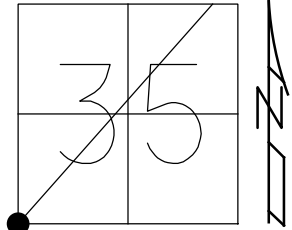

DIST FROM 1 - 1A = 47.85'

RECORD:
FD MONBOX
9/19/13, SDC
FD MONBOX 1" IPIN
REF1
10/20/15, JFO
FD MONBOX
12/15/20

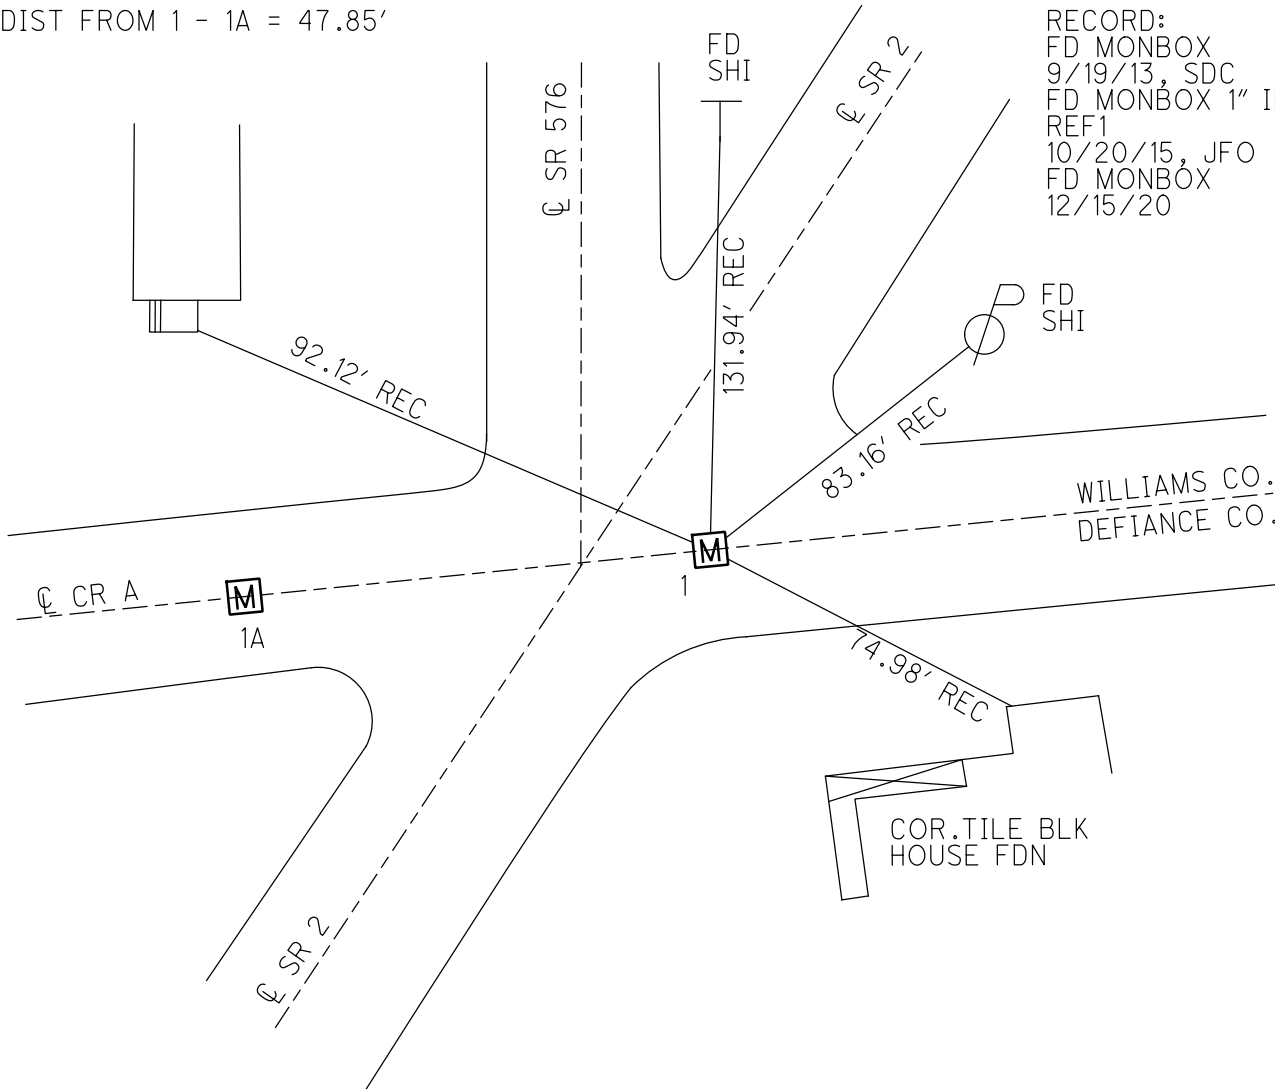

O.D.O.T. DISTRICT 2 SURVEY OFFICE (USE ONLY)

PERSONNEL _____ REFERENCE NO. 1 SHEET 1 OF 8

NOTES VAN DUSEN DATE 6-10-93 ROUTE SR 2
 H.C. KUSZ WEATHER CLOUDY COUNTY WILLIAMS
 R.C. BARNHISEL TEMP. 65° TOWNSHIP CENTER
 _____ SECTION 35
 _____ T 6 N R 2 E

TYPE MONUMENT MON BOX



ON SURFACE - ~~BELOW~~ ON _____

~~LEFT~~ - ℄ PAV'T - RIGHT 11.8'

0.9' TO RT EDGE PAVEMENT

S.L.M. 0+00

Grid: Northing: 648281.816 Easting: 1389322.822

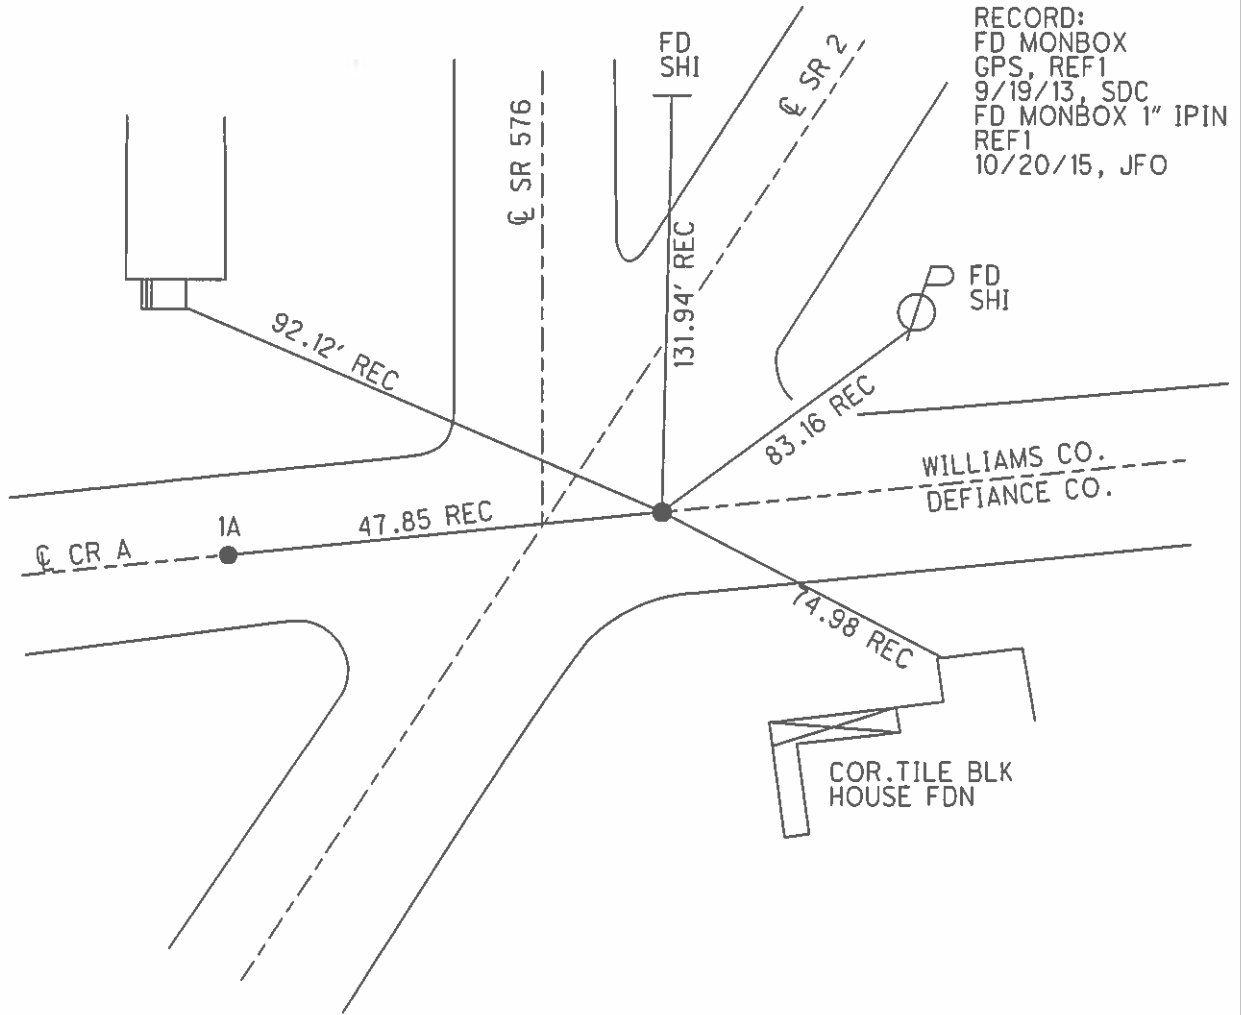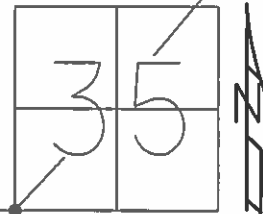

RECORD:
 FD MONBOX
 GPS, REF1
 9/19/13, SDC
 FD MONBOX 1" IPIN
 REF1
 10/20/15, JFO

O.D.O.T. DISTRICT 2 SURVEY OFFICE

PERSONNEL

REFERENCE NO. 1

SHEET OF

NOTES VAN DUSEN

H.C. KUSZ

DATE 6-10-93

ROUTE 2

R.C. BARNHISEL

WEATHER Cloudy

COUNTY WILLIAMS

OTTO

TEMP. +65°

TOWNSHIP CENTER

SECTION 35

(DIDN'T OPEN)

T. 6 N. R. 2 E


TYPE MONUMENT Mon. Box (EASTERLY ONE)

ON SURFACE - ~~BELOW~~ yes


~~LEFT~~ - & PAV'T. - RIGHT 11.8

0.9 TO RT EDGE PAVEMENT

S.L.M. 0+00

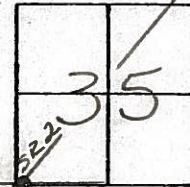

Co. Rd

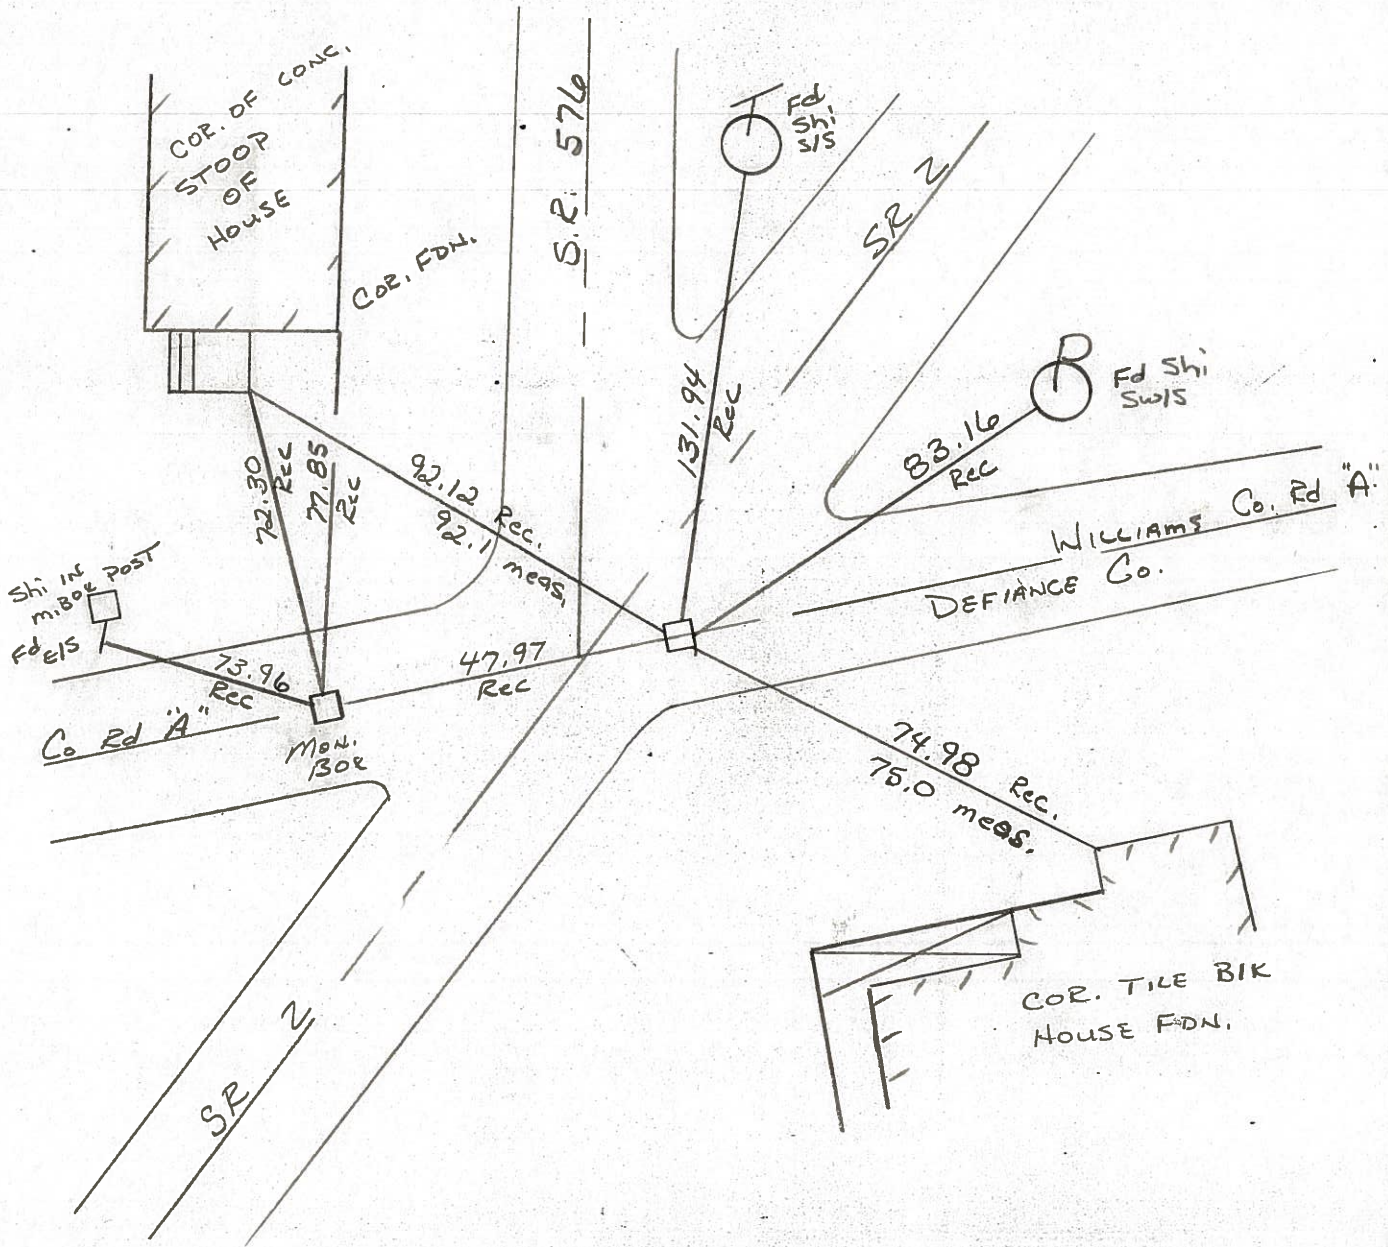

County Williams S.R. 2

Date 6-1-79

Township CENTER

Weather CLOUDY

Section _____

Temp. +70°

T N, R E



Personnel BURNSIDE

SMITH

BOWERS

KNAPE

MEAD

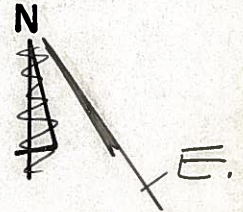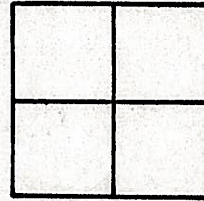

Resurfaced 1993

①

