

O.D.O.T. DISTRICT 2 SURVEY OFFICE (USE ONLY)

PERSONNEL

REFERENCE NO. 25 A

SHEET 3 OF 8

NOTES RHOADES

DATE 10/25/15

ROUTE SR 2

H.C. O'DONNELL

WEATHER CLEAR

COUNTY WILLIAMS

R.C. HOMAN

TEMP. 50°

TOWNSHIP CENTER

SECTION 35

DWG BY NIESE PID -

T 6 N R 2 E

TYPE MONUMENT P.K./WASHER

ON SURFACE - ~~BELOW~~ ON

OFFSET 7.1' TO RT PAVEMENT 4.6' ~~LT~~ : RT

7.1' TO RT EDGE PAVEMENT


STATION: 9+19.63

HORIZ.DATUM: -

GEOID: -


GRID: NORTHING: 648991.481

EASTING: 1389907.648

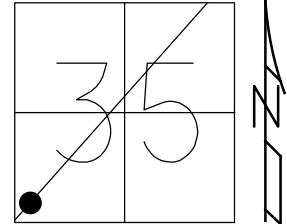

RECORD:

P.K./WASHER
8/24/93, MB
FD P.K./WASHER
9/19/13, SDC
SET MAG/WASHER
NEWREFA25
8/14/16, JFO
FD MAG/WASHER
12/15/20

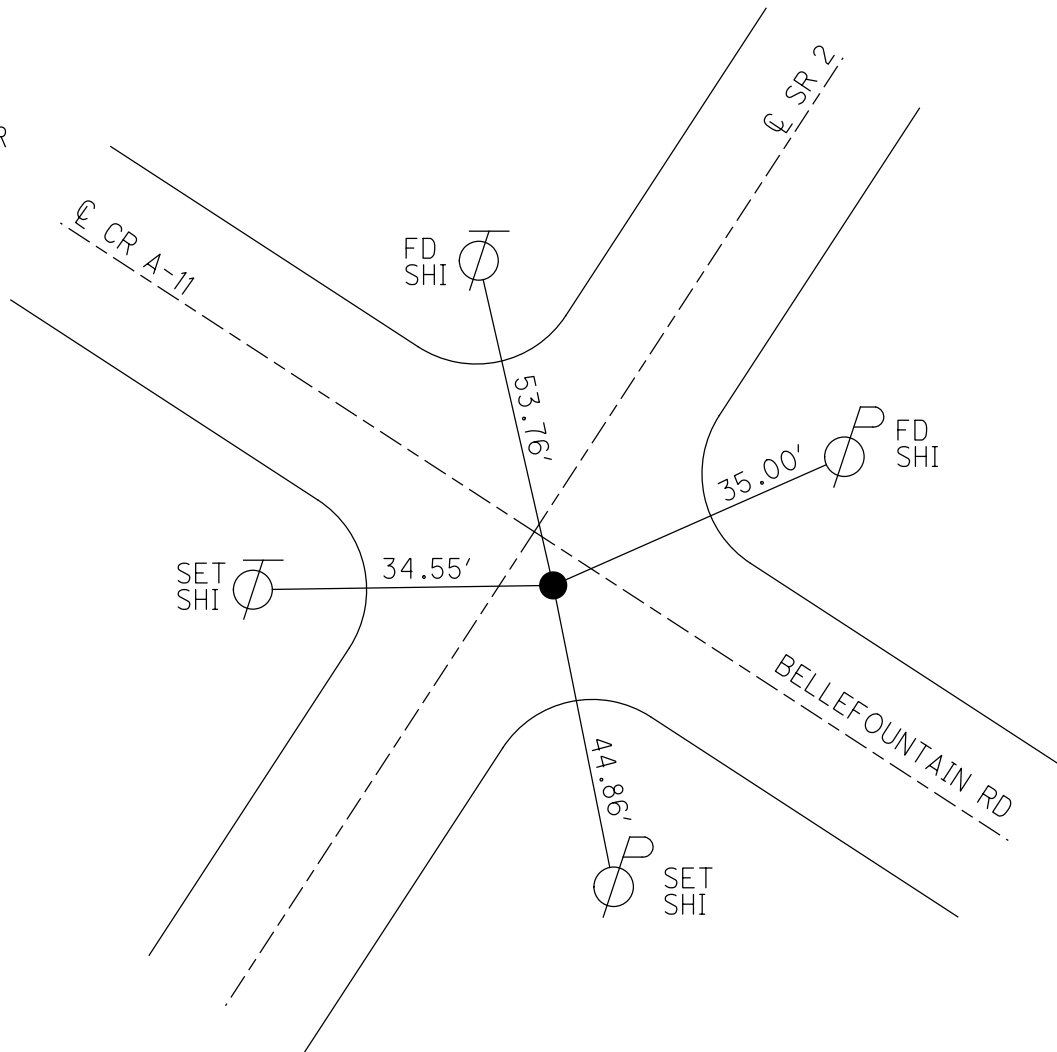

O.D.O.T. DISTRICT 2 SURVEY OFFICE (USE ONLY)

PERSONNEL _____ REFERENCE NO. 25 A SHEET 3 OF 8

NOTES RHOADES DATE 10/20/15 ROUTE SR 2
 H.C. O'DONNELL WEATHER CLEAR COUNTY WILLIAMS
 R.C. HOMAN TEMP. 50° TOWNSHIP CENTER
 SECTION 35
T 6 N R 2 E

TYPE MONUMENT P.K./WASHER


ON SURFACE - ~~BELOW~~ ON _____

~~LEFT~~ - ℄ PAV'T - RIGHT 4.6', 2.5' S OF ℄ E


7.1' TO RT EDGE PAVEMENT

S.L.M. 9+19.63

Grid: Northing: 648991.481 Easting: 1389907.648

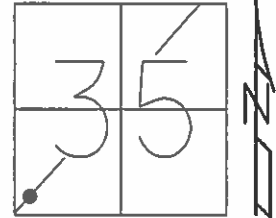

RECORD:
 P.K./WASHER
 8-24-93, MB
 FD P.K./WASHER
 REFA25
 9/19/13, SDC
 SET MAG/WASHER
 NEWREFA25
 8/14/16, JFO

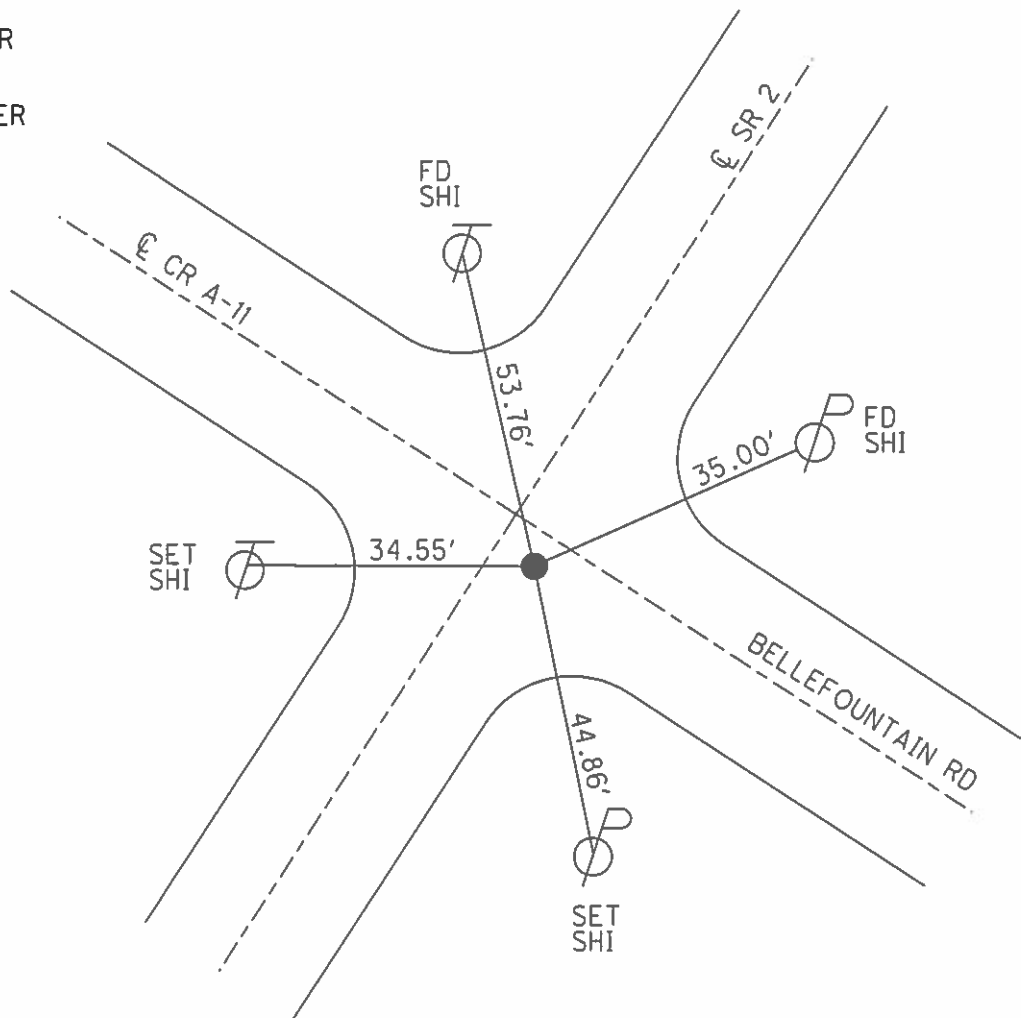

O.D.O.T. DISTRICT 2 SURVEY OFFICE

PERSONNEL

REFERENCE NO. 25-A

SHEET OF

NOTES VAN DUSEN

H.C. KUSZ

DATE 6-10-93

ROUTE 2

R.C. BARNHISEL III

WEATHER Cloudy

COUNTY Williams

OTTO

TEMP. +65°

TOWNSHIP CENTER

SECTION 35

T 6 N R 2 E


TYPE MONUMENT PK NAIL

ON SURFACE - ~~BELOW~~ yes


~~LEFT~~ - PAV'T. - RIGHT 4.6

7.1 TO RT EDGE PAVEMENT

S.L.M. 9+20 2.5 S. OF & EAST

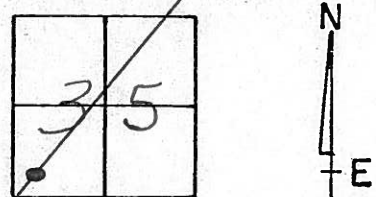

Reset PK & WASHER
8-24-93
MB

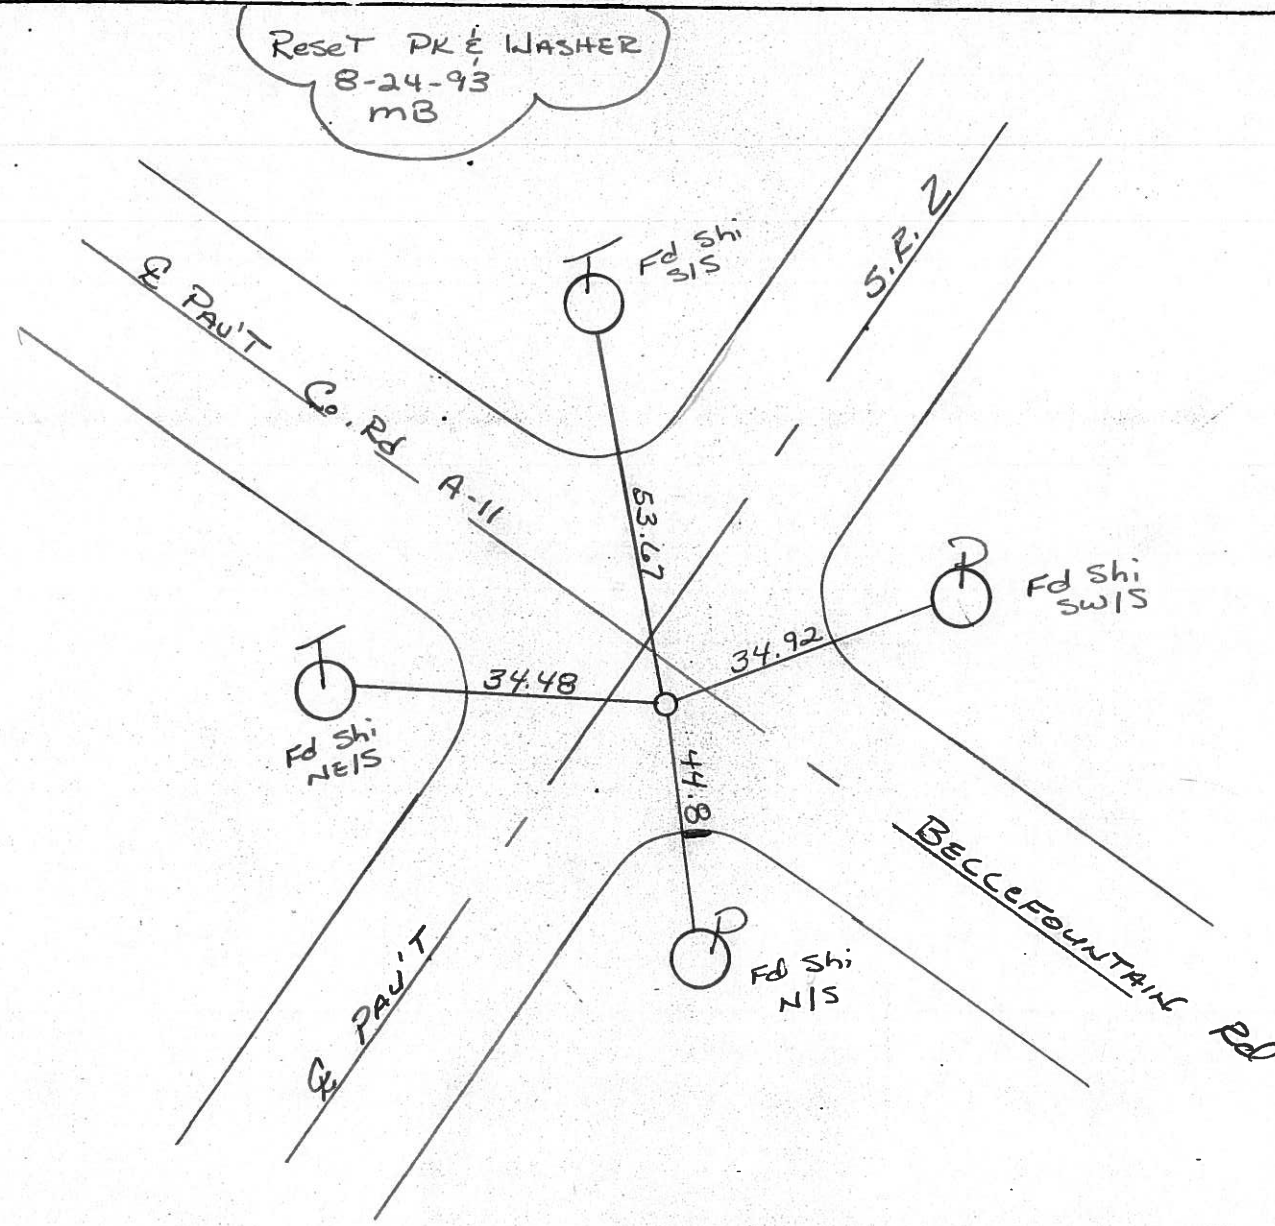

County Williams S.R. # 20

Date 31 Aug. 84

Township Center

Weather Cloudy

Section 35

Temp. 70°

T N, R E


Personnel I. Stone

P. Newsen

R. Michalak


D. Curtis

25-A

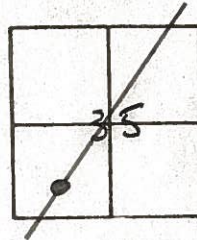

SLM STA. 9+30

REF. NO. 25-A


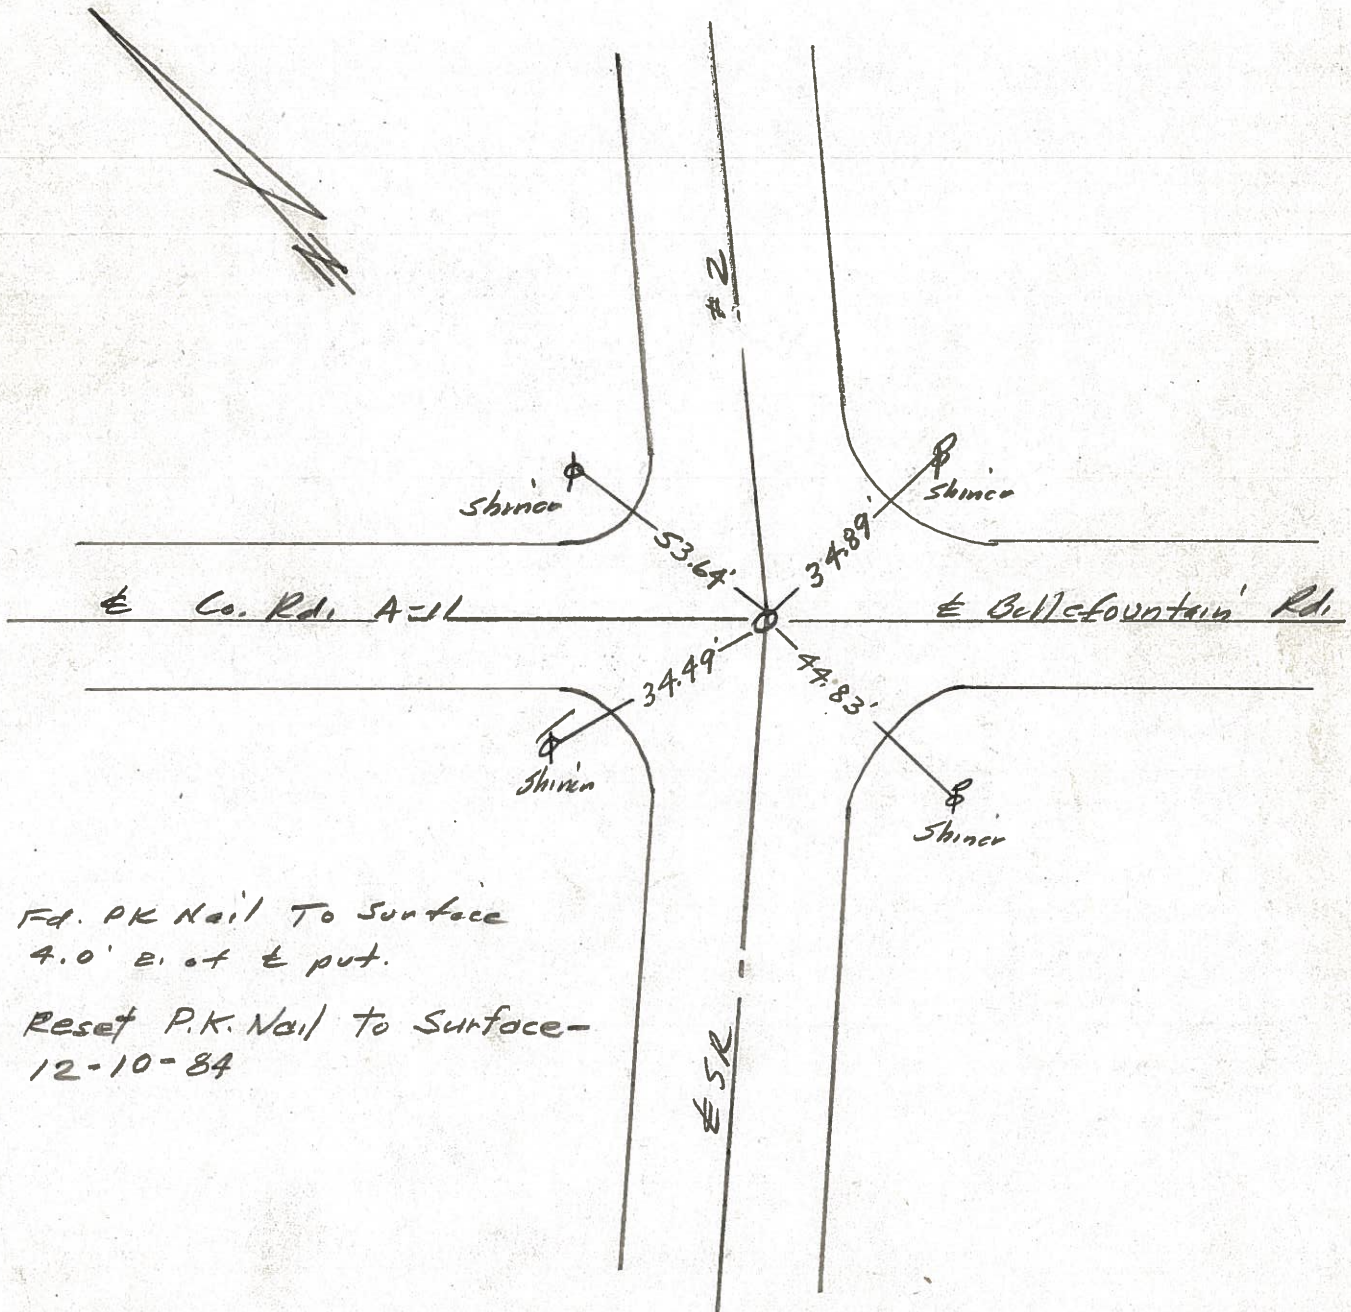


Fd. PK Nail To Surface
4.0' E. of E put.


Reset P.K. Nail To Surface-
12-10-84

County WILLIAMS S.R. 2
 Township CENTER
 Section WILLIAMS CENTER
 T N, R E
 Personnel BURNSIDE
SMITH
BOWERS
KNAPE
MEAD

Date 6-1-79
 Weather CLOUDY
 Temp. +70°

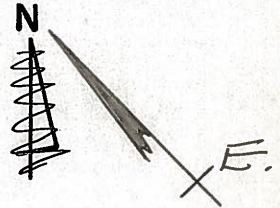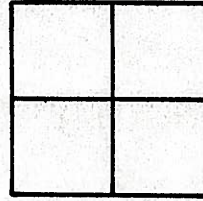

#25.A

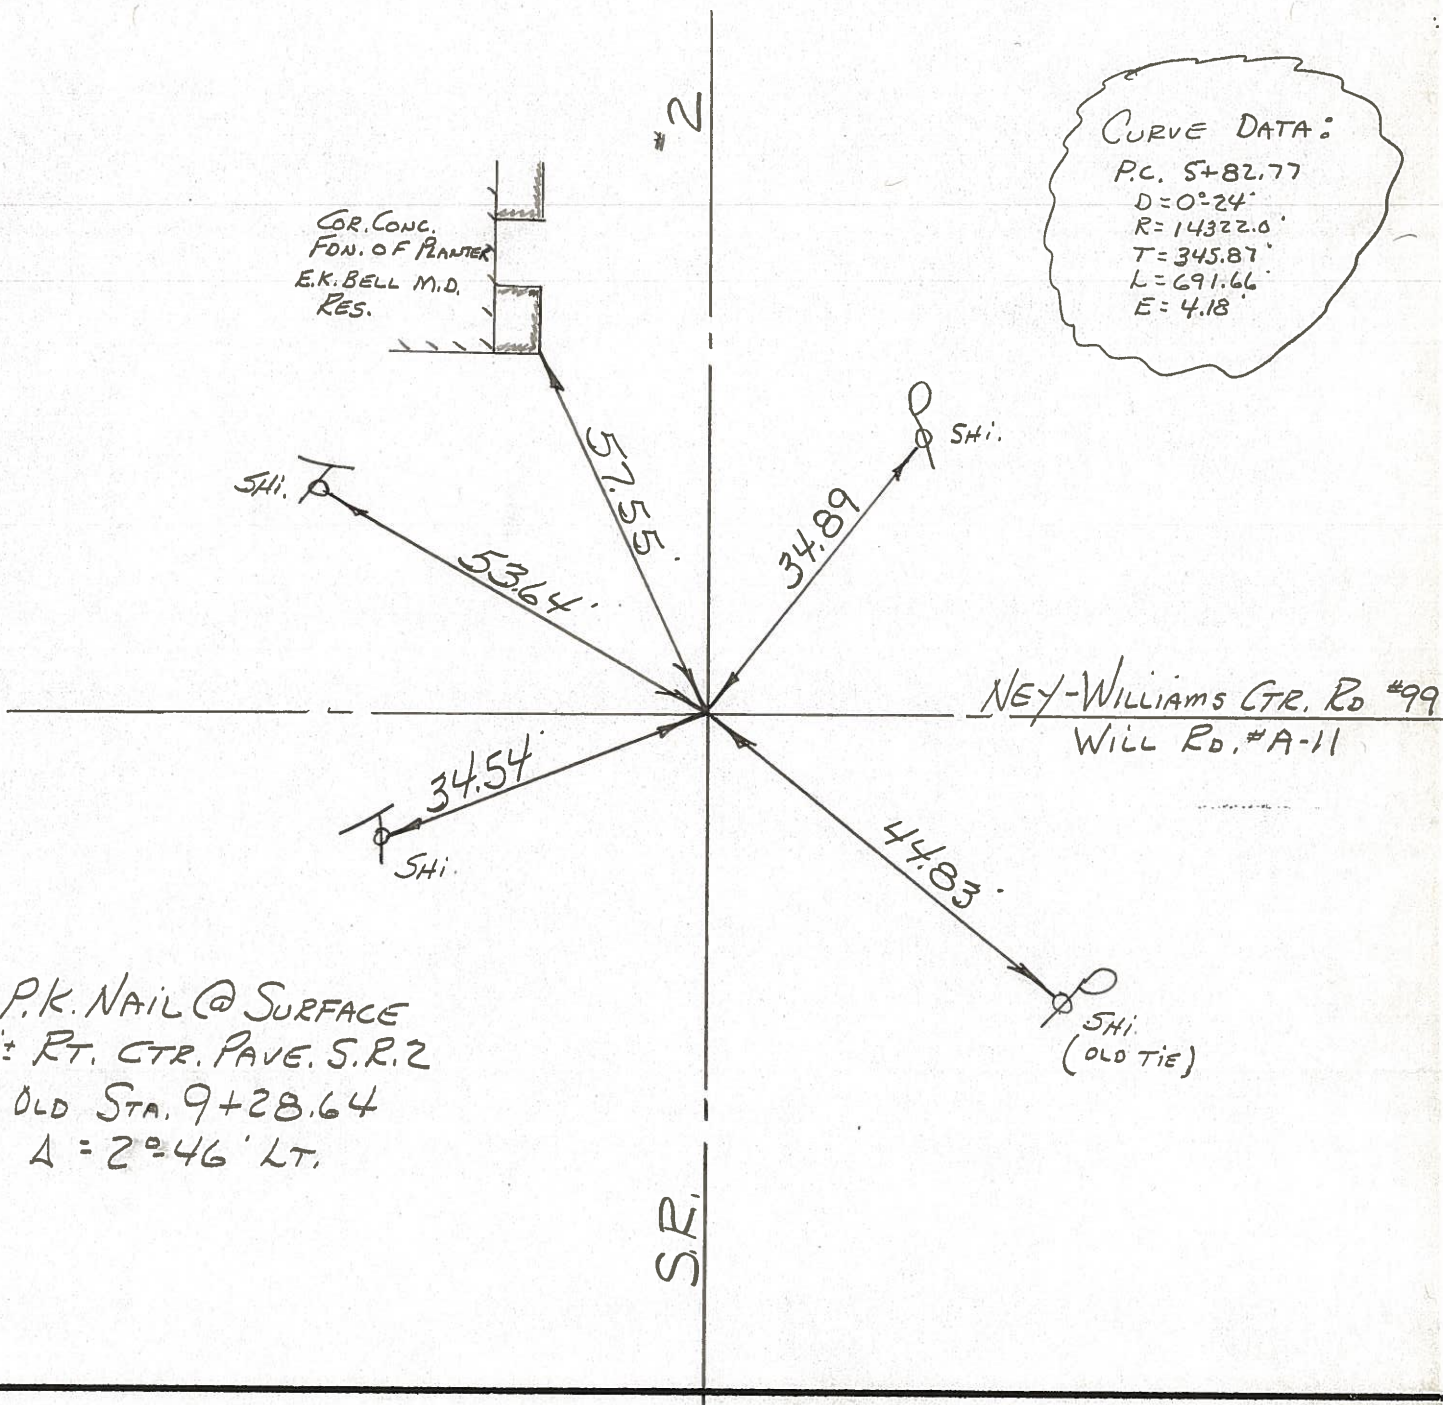

Fd. P.K. NAIL @ SURFACE
 4' RT. CTR. PAVE. S.R. 2
 P.I. OLD STA. 9+28.64
 Δ = 2°46' LT.

PERSONNEL TITLE PERSONNEL TITLE

COUNTY Wi.

DATE 7-15-58

Louys
Persefall
Wise
Krahn

S. R. 2
Williams Center
SEC. To Bryan

WEATHER Cloudy
TEMP. 75°

DESCRIPTION

Re-check of Witnesses


JOB NO. _____

LEFT


CENTER LINE

RIGHT


27-A

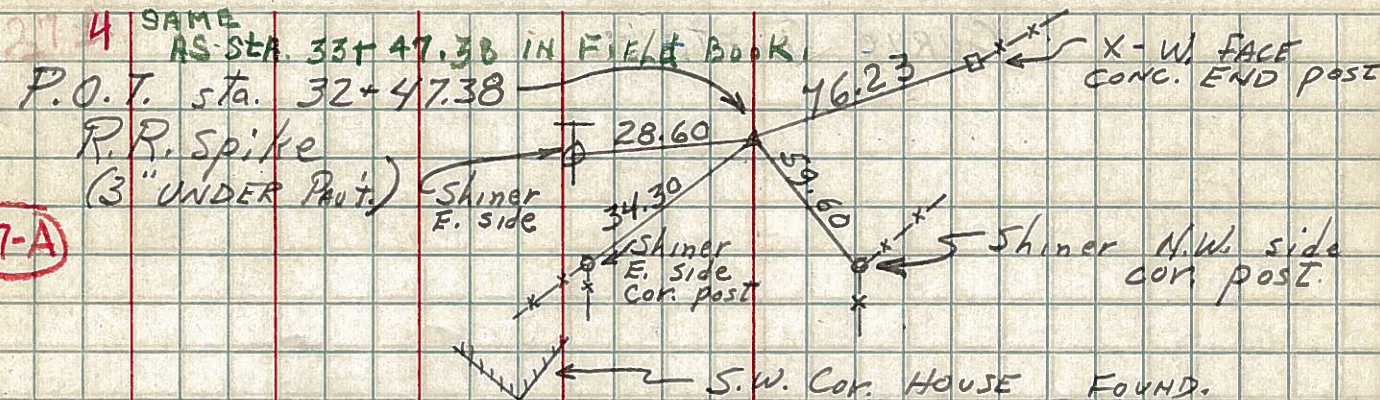

26-A

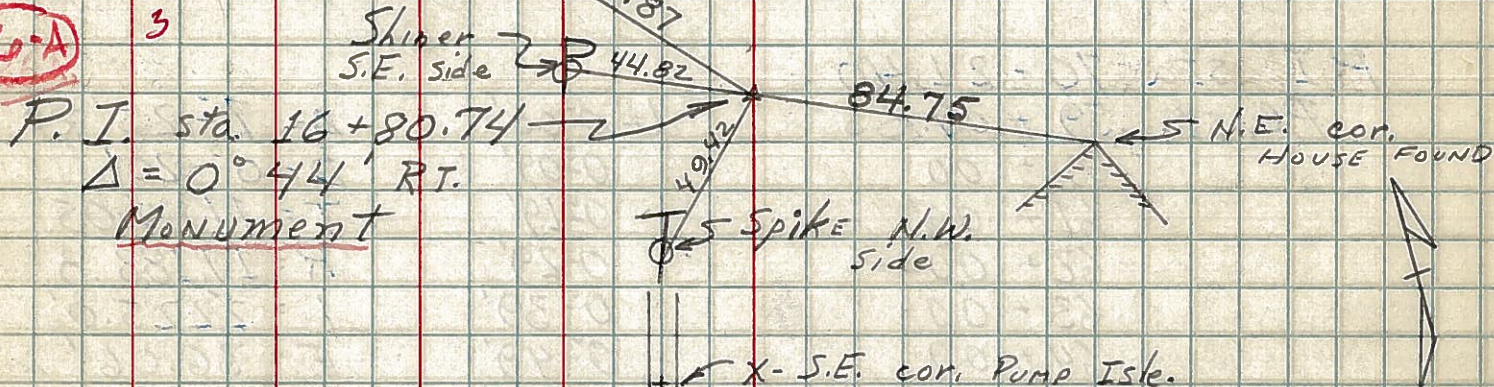

25-A

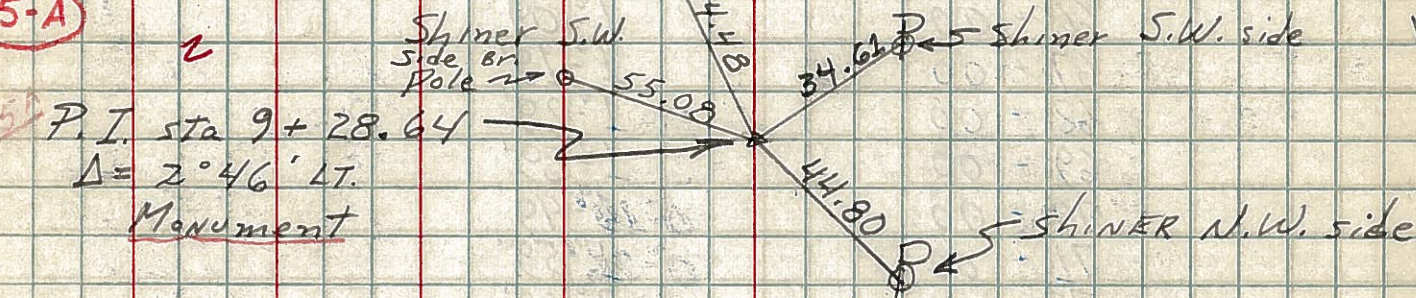

24-A

