


O.D.O.T. DISTRICT 2 SURVEY OFFICE (USE ONLY)

PERSONNEL _____ REFERENCE NO. 26 A SHEET 4 OF 8


NOTES RHOADES DATE 10-20-15 ROUTE SR 2
 H.C. O'DONNELL WEATHER CLEAR COUNTY WILLIAMS
 R.C. HOMAN TEMP. 50° TOWNSHIP CENTER
 SECTION 35
 T 6 N R 2 E

TYPE MONUMENT P.K./WASHER
 ON SURFACE - ~~BELOW~~ ON _____
 LEFT - ☉ PAV'T - ~~RIGHT~~ 7.5'
9.0' TO LT EDGE PAVEMENT
 S.L.M. 16+71.59

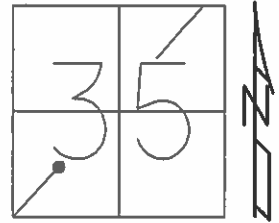

Grid: Northing: 649587.832 Easting: 1390365.796

RECORD:
 P.K./WASHER
 8-24-93, MB
 FD P.K./WASHER
 REFA26
 9/19/13, SDC
 SET MAG/WASHER
 NEWREFA26
 8/14/16, JFO

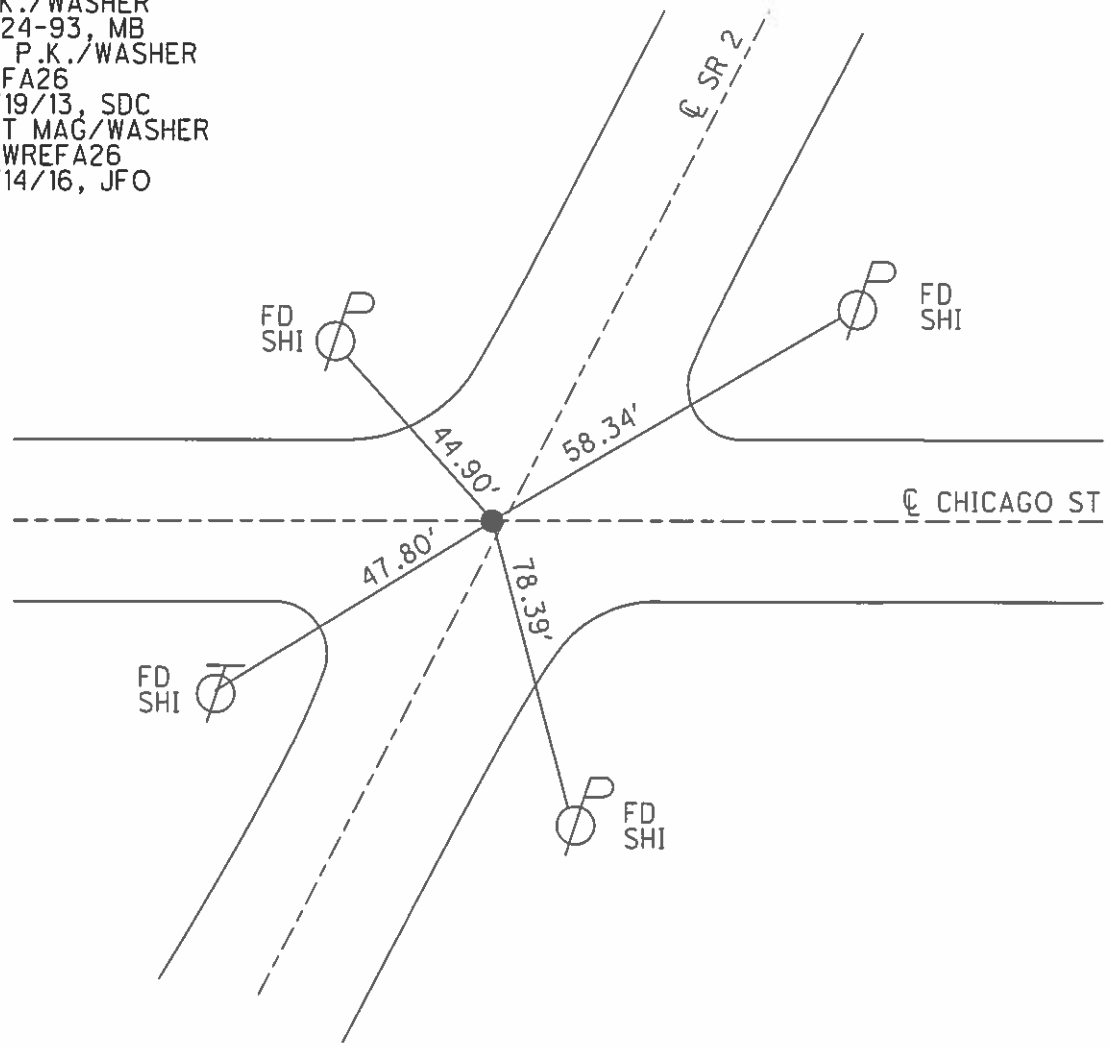

O.D.O.T. DISTRICT 2 SURVEY OFFICE

PERSONNEL

REFERENCE NO. 25-A

SHEET OF

NOTES VAN DUSEN

H.C. KUSZ

DATE 6-10-93

ROUTE 2

R.C. BARNHISEL III

WEATHER Cloudy

COUNTY Williams

OTTO

TEMP. +65°

TOWNSHIP CENTER

SECTION 35

T 6 N R 2 E


TYPE MONUMENT PK NAIL

ON SURFACE - ~~BELOW~~ yes


~~LEFT~~ - PAV'T. - RIGHT 4.6

7.1 TO RT EDGE PAVEMENT

S.L.M. 9+20 2.5 S. OF & EAST

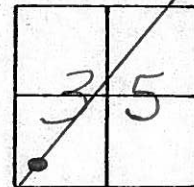

Reset PK & WASHER
8-24-93
MB

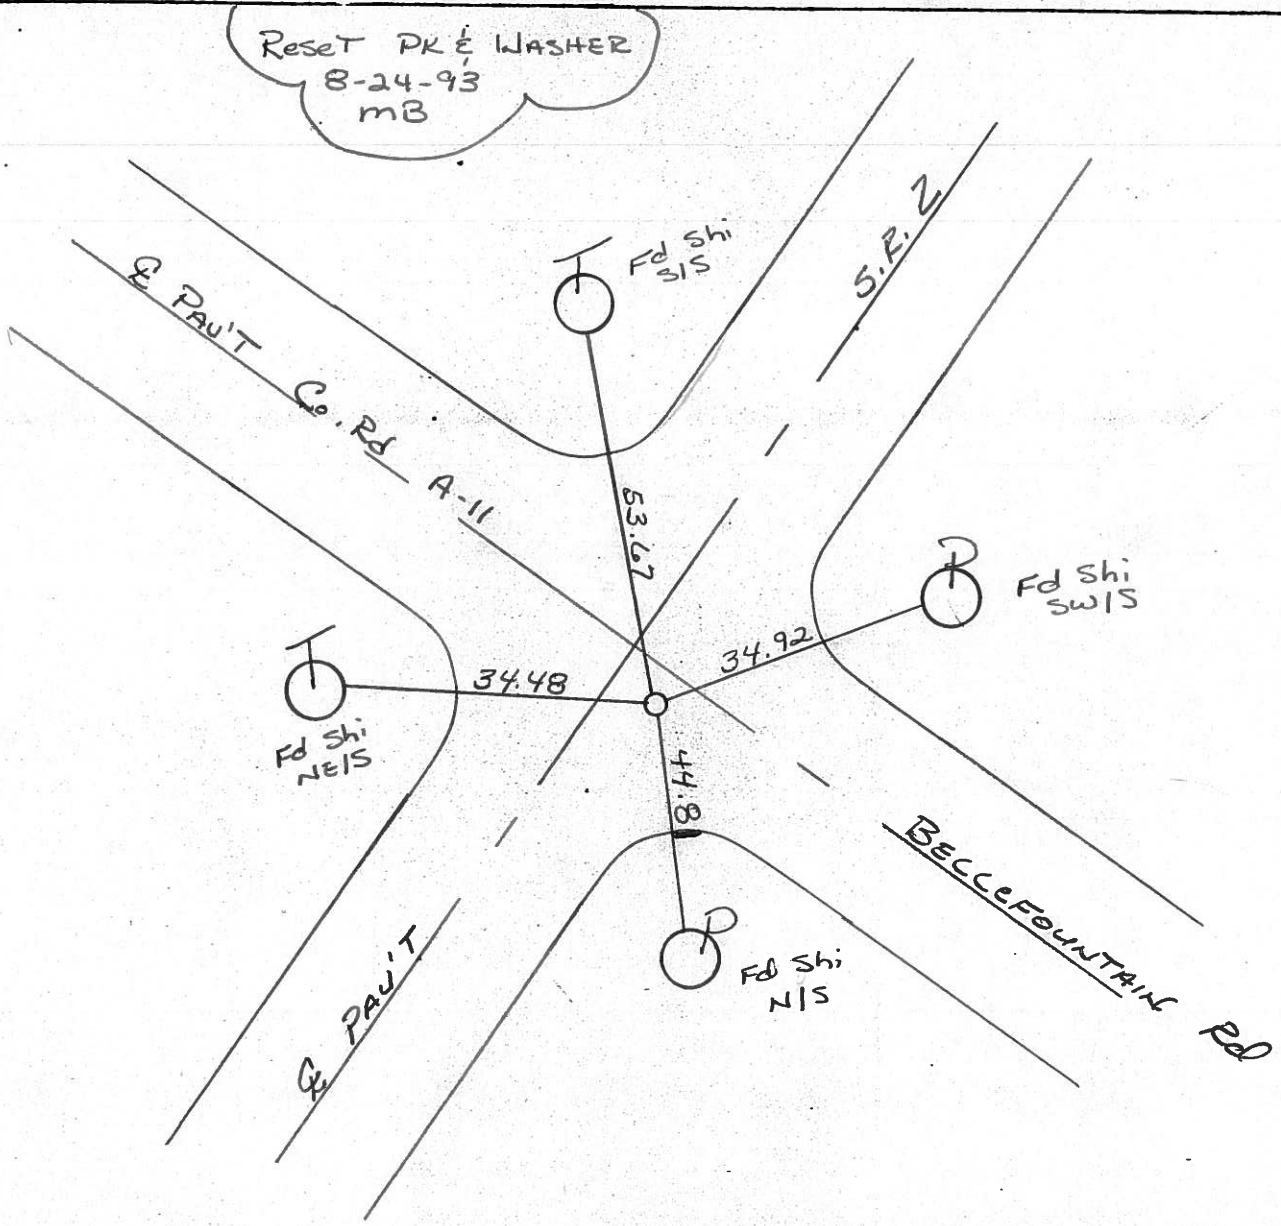

County Williams S.R. #20

Date 31 Aug 84

Township Center

Weather Cloudy

Section 35

Temp. 70°

T N, R E


Personnel I. Stone

P. Newsen

R. Michalak


D. Curtis

25-A

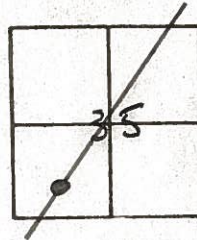

SLM STA. 9+30

REF. NO. 25-A


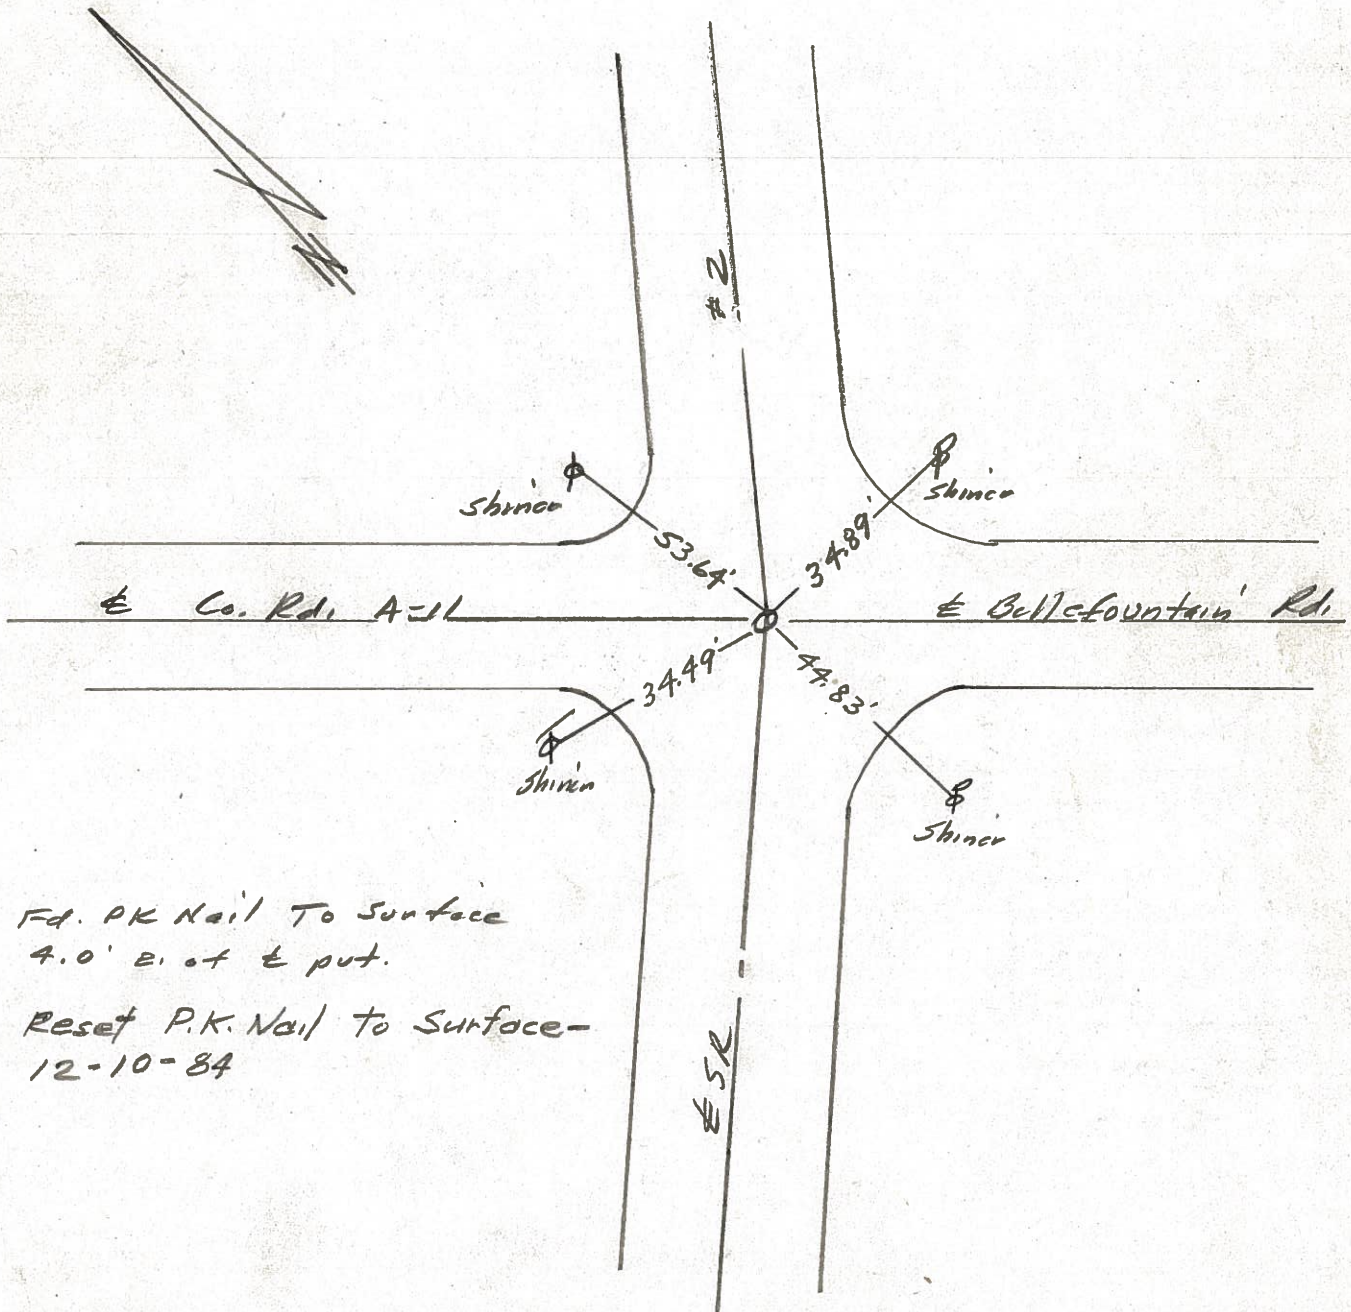


Fd. PK Nail To Surface
4.0' E. of E put.


Reset P.K. Nail To Surface-
12-10-84

County WILLIAMS S.R. 2
 Township CENTER
 Section WILLIAMS CENTER
 T N, R E
 Personnel BURNSIDE
SMITH
BOWERS
KNAPE
MEAD

Date 6-1-79
 Weather CLOUDY
 Temp. +70°

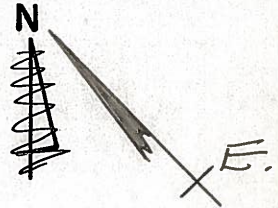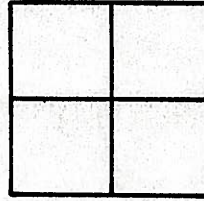

#25.A

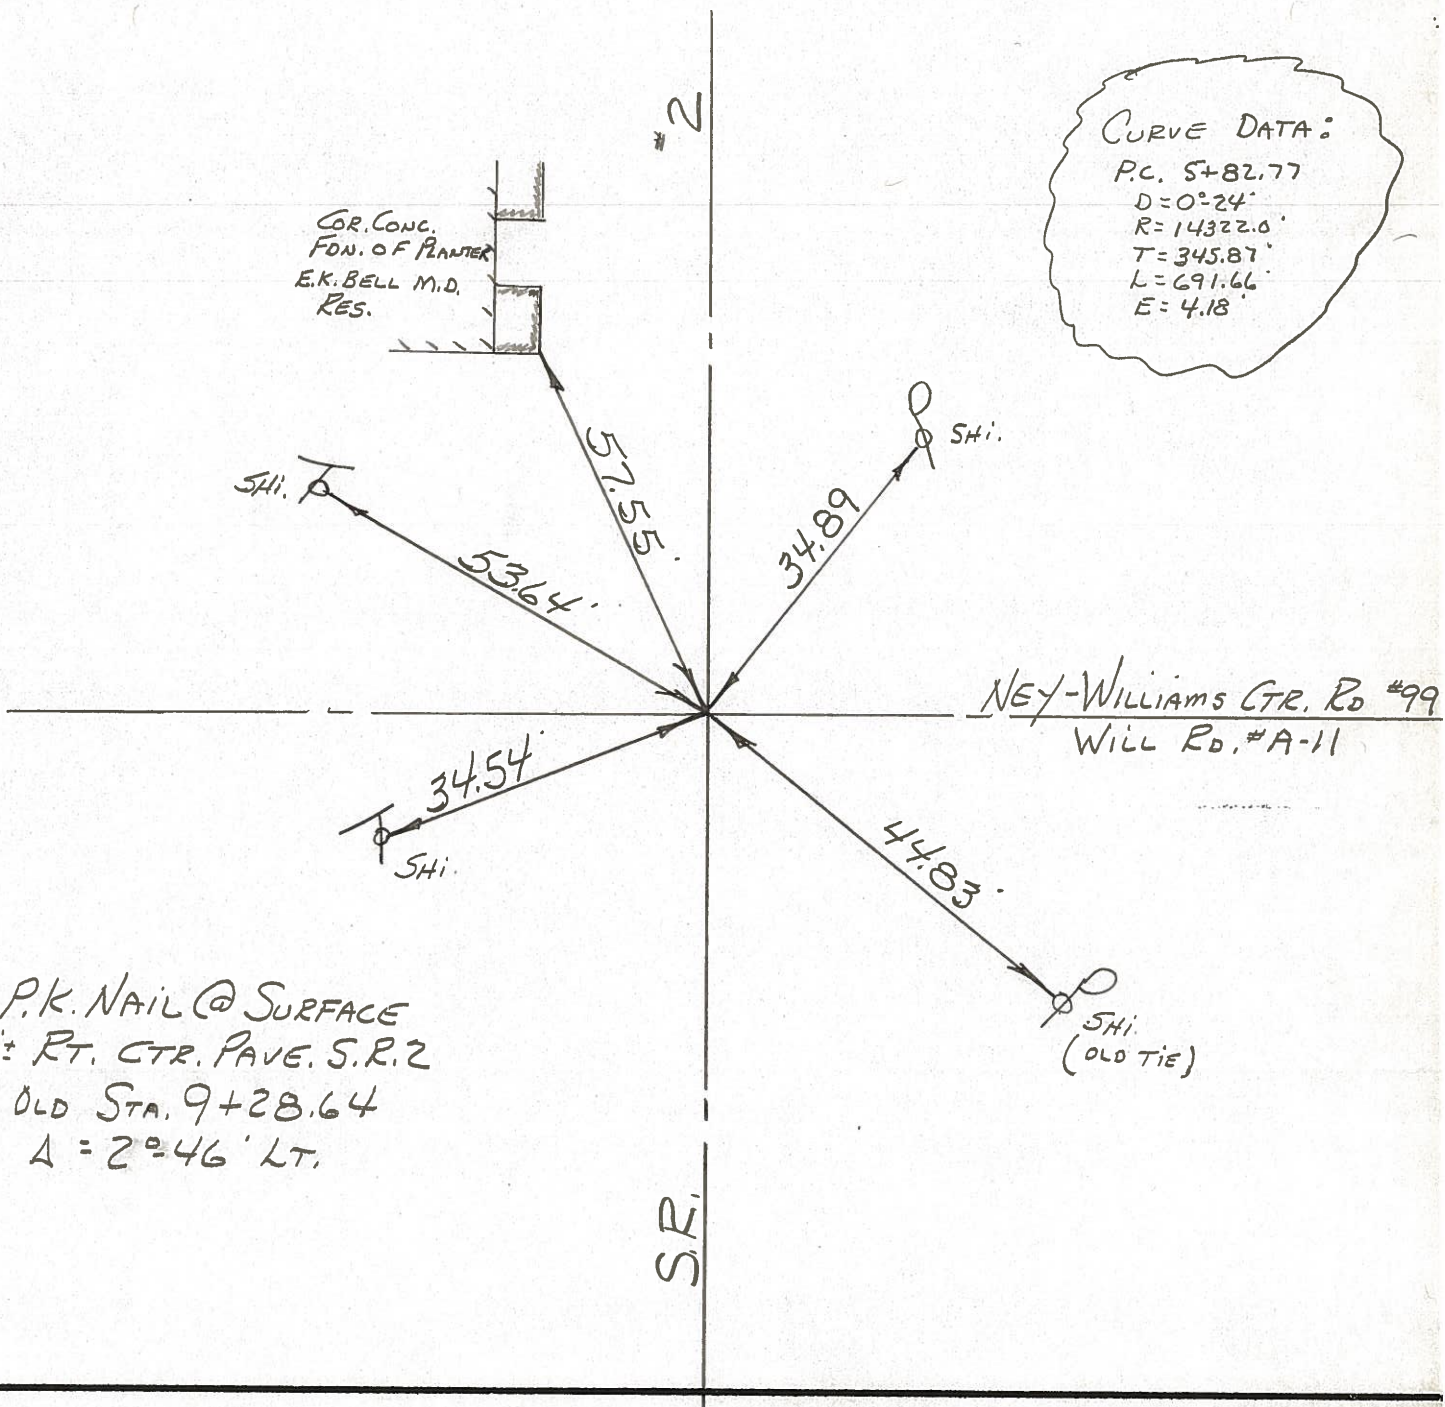

PERSONNEL TITLE PERSONNEL TITLE

COUNTY Wi.

DATE 7-15-58

Louys
Persefall
Wise
Krahn

S. R. 2
Williams Center
SEC. To Bryan


WEATHER Cloudy
TEMP. 75°

DESCRIPTION

Re-check of Witnesses

JOB NO. _____

LEFT CENTER LINE RIGHT

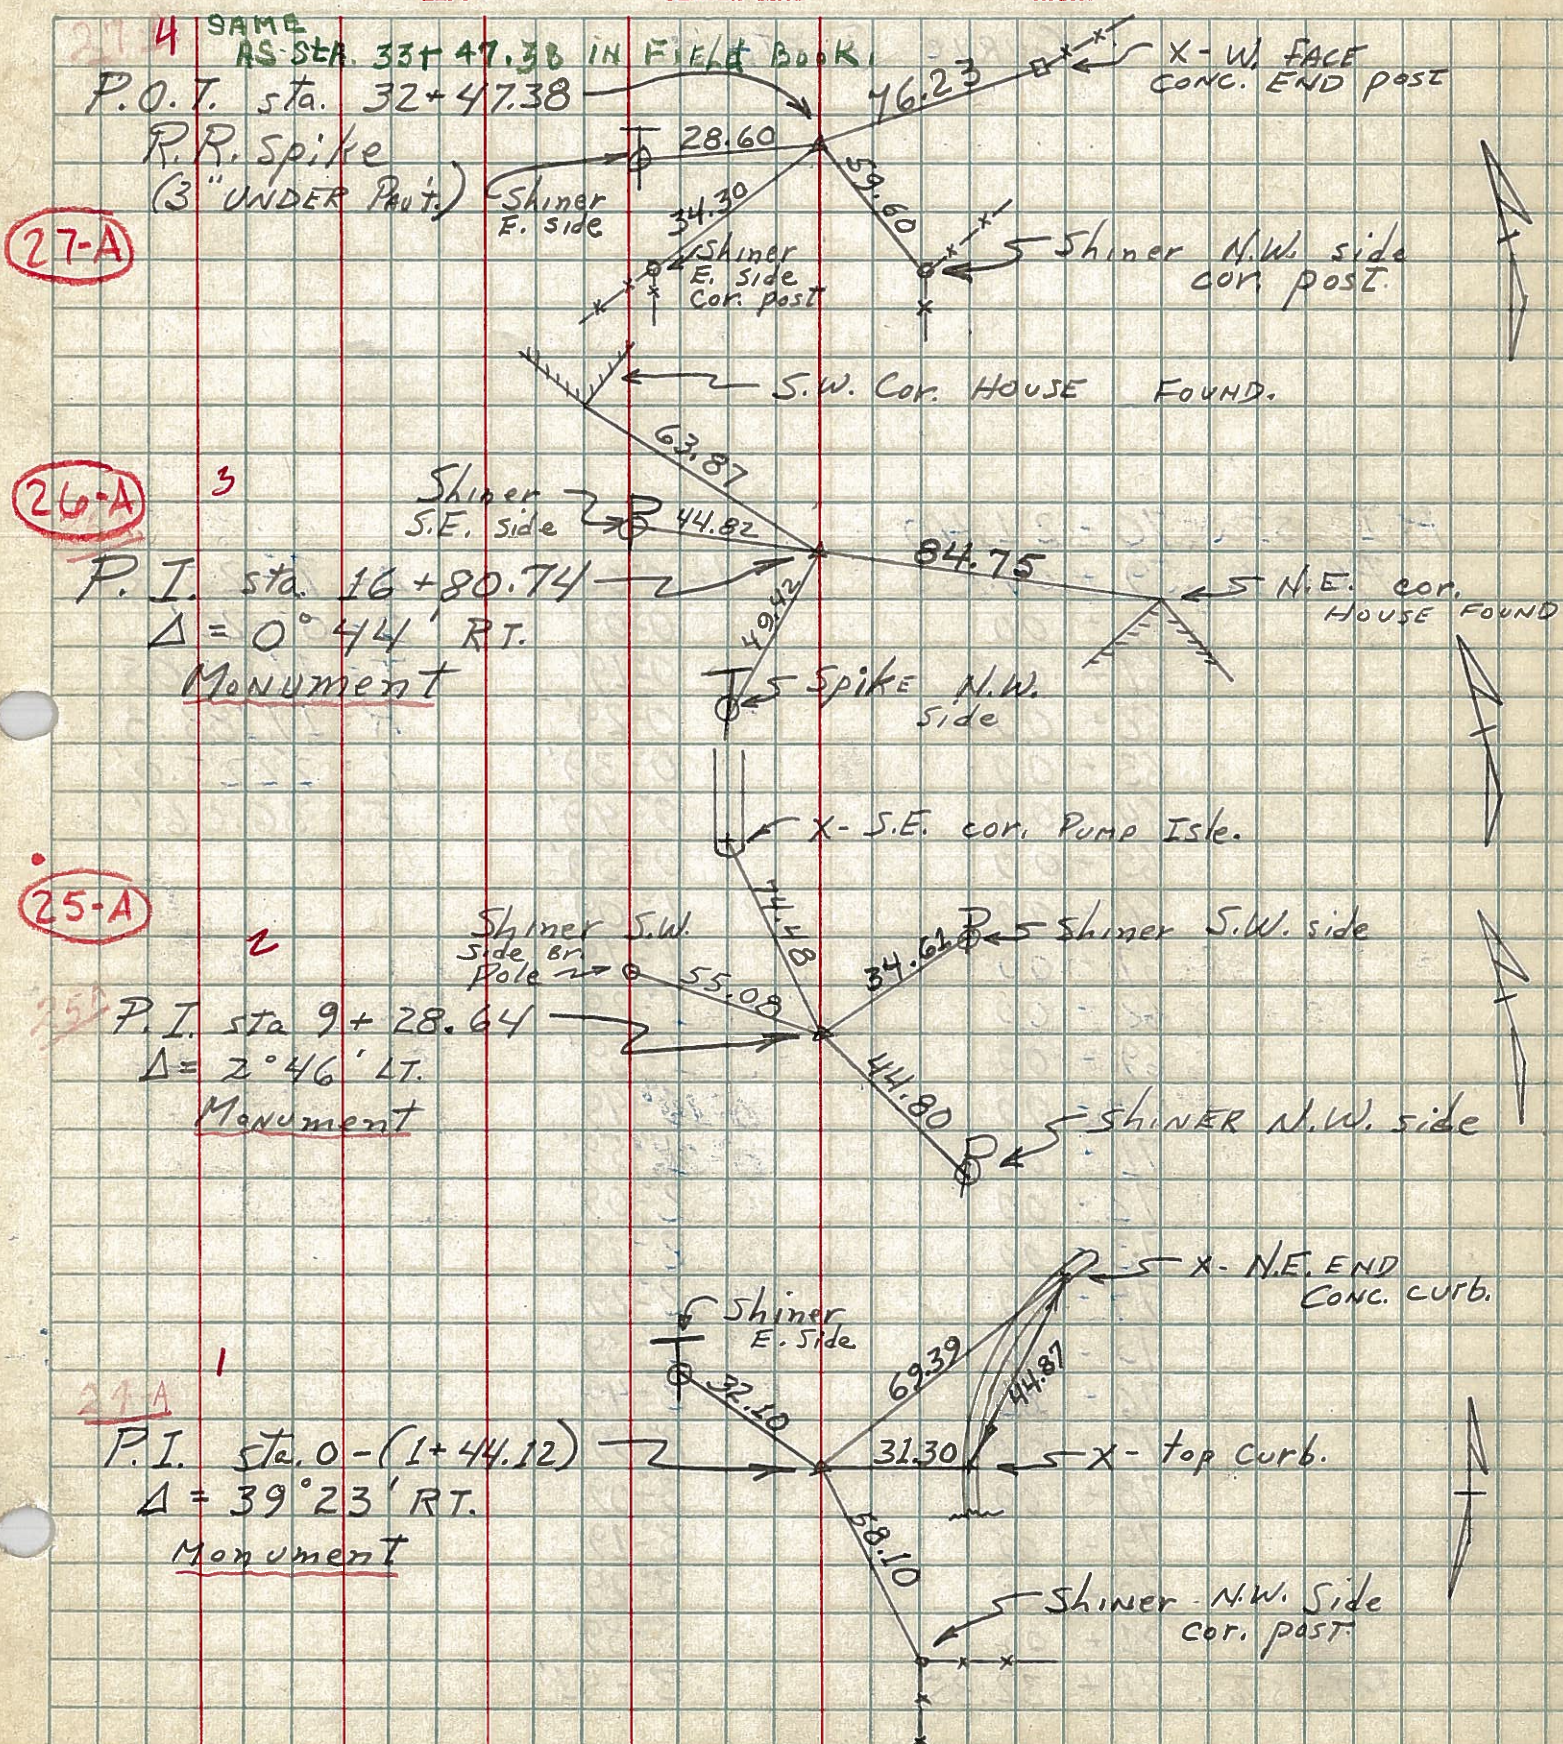

PERSONNEL	TITLE	PERSONNEL	TITLE	COUNTY	DATE	WEATHER	TEMP.
Louys				Wi.	7-15-58	Cloudy	75°
Pessefall							
se				S. R. 2			
Krahn				Williams Center			
				To Bryan			

DESCRIPTION _____ LEFT _____ CENTER LINE _____ RIGHT _____ JOB NO. _____

Curve Data

P.I. - sta. 16 + 80.74
 P.C. - 16 + 44.07

$\Delta = 0^{\circ} - 44' \text{ Rt.}$
 $D = 1^{\circ} - 00'$
 $R = 5729.6'$
 $T = 36.67'$
 $L = 73.33'$
 $E = 0.12'$

P.I. - sta 9 + 28.64
 P.C. = 5 + 82.77
 6 + 00
 7 + 00
 8 + 00
 9 + 00
 10 + 00
 11 + 00
 12 + 00
 12 + 74.43

$d = 0^{\circ} - 00'$
 $= 0^{\circ} - 02'$
 $0^{\circ} - 14'$
 $0^{\circ} - 26'$
 $0^{\circ} - 38'$
 $0^{\circ} - 50'$
 $1^{\circ} - 01'$
 $1^{\circ} - 12'$
 $1^{\circ} - 21.5'$

$\Delta = 2^{\circ} - 46' \text{ Lt}$
 $D = 0^{\circ} - 24'$
 $R = 14,322.0'$
 $T = 345.87'$
 $L = 691.66'$
 $E = 4.18'$