

O.D.O.T. DISTRICT 2 SURVEY OFFICE (USE ONLY)

PERSONNEL

REFERENCE NO. 27

SHEET 5 OF 8

NOTES RHOADES

DATE 10/20/15

ROUTE SR 2

H.C. O'DONNELL

WEATHER CLEAR

COUNTY WILLIAMS

R.C. HOMAN

TEMP. 50°

TOWNSHIP CENTER

DWG BY NIESE PID -

SECTION 35

T 6 N R 2 E

TYPE MONUMENT LG R.R. SPIKE

~~ON SURFACE~~ - BELOW 4 1/2"


OFFSET  $\varnothing$  PAVEMENT ON ~~LT:RT~~

10.8' TO LT EDGE PAVEMENT


STATION: 21+53.03

HORIZ. DATUM: - GEOID: -

GRID: NORTHING: 649966.201 EASTING: 1390664.765

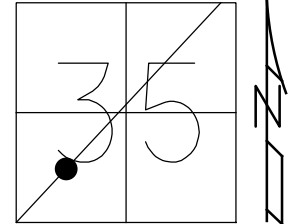

RECORD:  
 P.K./WASHER  
 8/24/93, MB  
 FD P.K./WASHER  
 9/19/13, SDC  
 SET MAG/WASHER  
 NEWREF27  
 8/4/16, JFO  
 FD MAG/WASHER  
 12/15/20

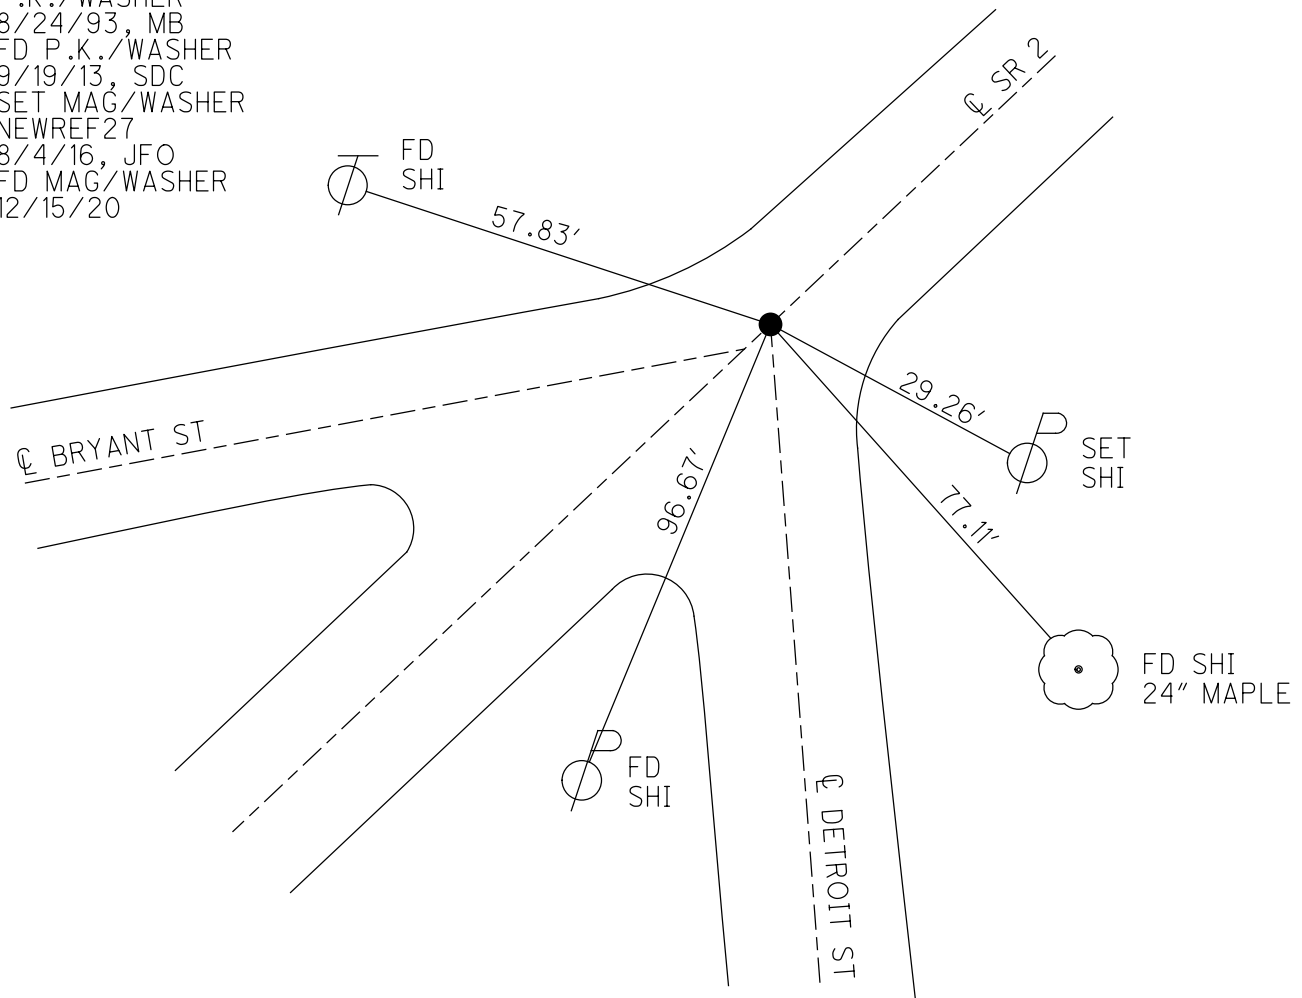

**O.D.O.T. DISTRICT 2 SURVEY OFFICE (USE ONLY)**

PERSONNEL \_\_\_\_\_ REFERENCE NO. 27 SHEET 5 OF 8

NOTES RHOADES DATE 10-20-15 ROUTE SR 2  
 H.C. O'DONNELL WEATHER CLEAR COUNTY WILLIAMS  
 R.C. HOMAN TEMP. 50° TOWNSHIP CENTER  
 SECTION 35  
 T 6 N R 2 E

TYPE MONUMENT LG R.R. SPIKE


~~ON SURFACE~~ - BELOW 4 1/2"

LEFT - Q PAV'T - RIGHT ON


10.8' TO LT EDGE PAVEMENT

S.L.M. 21+53.03

Grid: Northing: 649966.201 Easting: 1390664.765

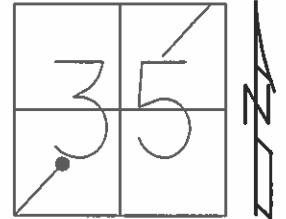

RECORD:  
 P.K./WASHER  
 8-24-93, MB  
 FD P.K./WASHER  
 REF27  
 9/19/13, SDC  
 SET MAG/WASHER  
 NEWREF27  
 8/4/16, JFO

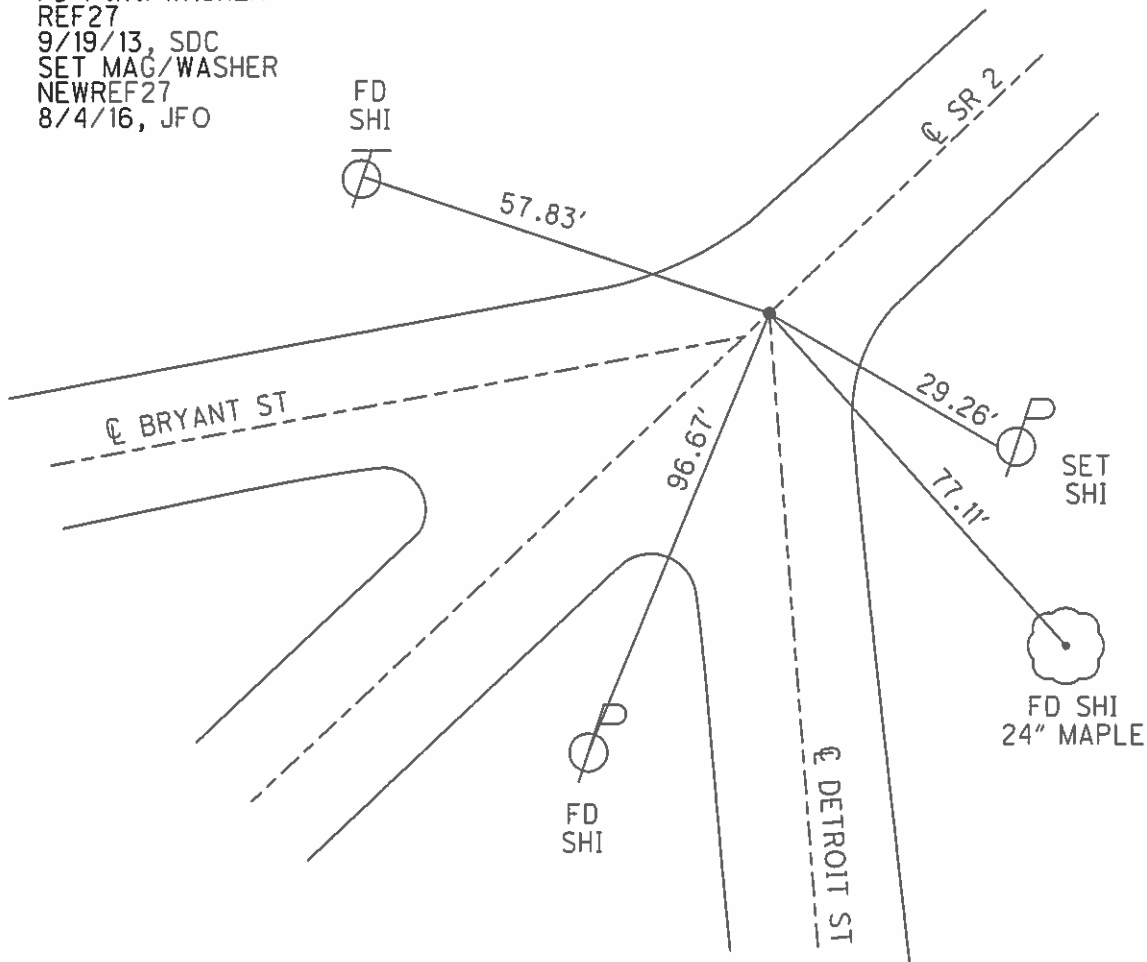

# O.D.O.T. DISTRICT 2 SURVEY OFFICE

PERSONNEL

REFERENCE NO. 27

SHEET      OF     

NOTES VAN DUSEN

H.C. KUSZ

DATE 6-10-93

ROUTE 2

R.C. BARNHISEL

WEATHER CLOUDY

COUNTY WILLIAMS

OTTO

TEMP. +65°

TOWNSHIP CENTER

SECTION 35

T. 6 N R. 2 E


TYPE MONUMENT Lg R.R. Spk

ON SURFACE - ~~BELOW~~ yes


~~LEFT~~ - E PAV'T. - ~~RIGHT~~ yes

10.8 TO LT EDGE PAVEMENT

S.L.M. 21+55 ON. E PAVT SOUTH

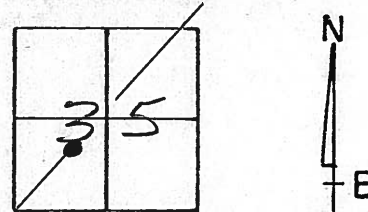

Reset PK & WASHER  
8-24-93  
m.B.

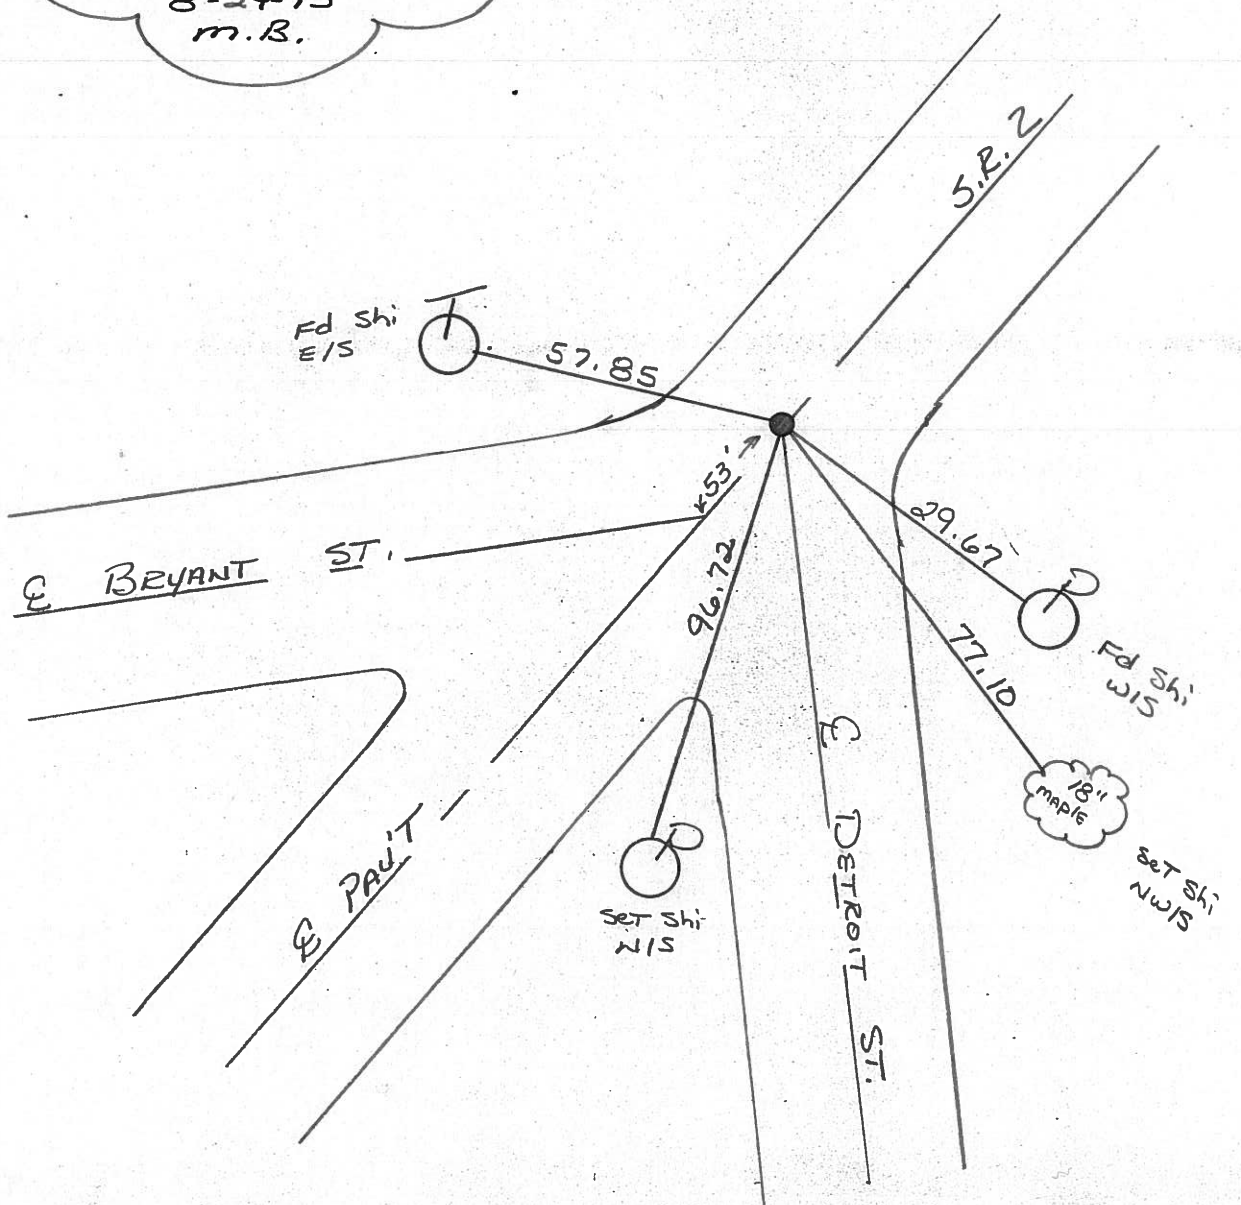

County Williams S.R. #2

Date 21 Aug 84

Township Centco

Weather Cloudy

Section 35

Temp. 70°

T N, R E


Personnel J. Stone

P. Neuse

R. Michalak

D. Curtis

(27)

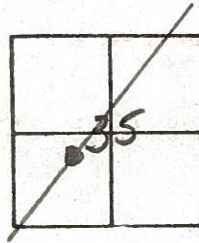


SLM STA. 21+64

REF. NO. 27

Ed. RR Spk. To Surface  
 11.2' to E. edge put.  
 10.8' to W. edge put.

Fd. R.R. Spk. 2" DEEP -  
 12-10-84


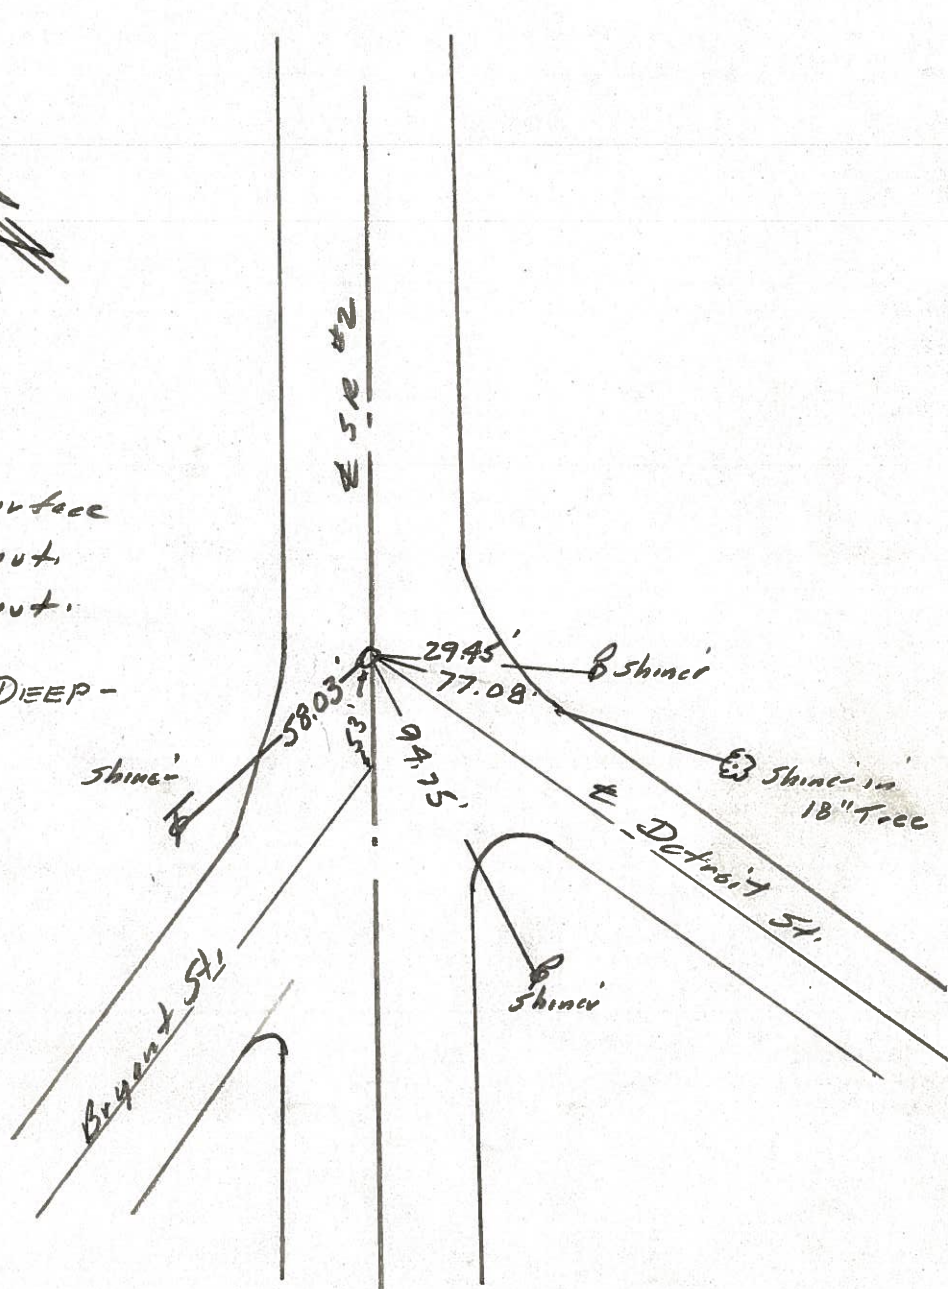


County WILLIAMS S.R. 2  
Township CENTER  
Section WILLIAMS CENTER

Date 6-4-79  
Weather CLEAR  
Temp. +67°

T\_N, R\_E

Personnel BURNSIDE  
SMITH  
BOWERS  
KNAPE  
MEAD

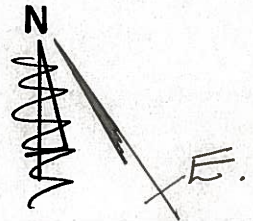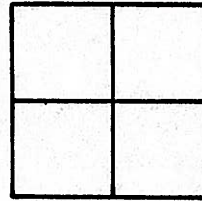

#27  
NEW

