




O.D.O.T. DISTRICT 2 SURVEY OFFICE (USE ONLY)

PERSONNEL \_\_\_\_\_ REFERENCE NO. 28 B SHEET 8 OF 8  
 NOTES BARNHISEL DATE 11/17/95 ROUTE SR 2  
 H.C. CANTERBURY WEATHER SNOW COUNTY WILLIAMS  
 R.C. CORDES TEMP. 32° TOWNSHIP CENTER  
 SECTION 26  
 T 6 N R 2 E


TYPE MONUMENT LG.R.R.SPIKE  
 ON SURFACE - ~~BELOW~~ ON \_\_\_\_\_  
 LEFT - ☉ PAV'T - RIGHT ON \_\_\_\_\_  
 - TO - EDGE PAVEMENT  
 S.L.M. 66+75.80

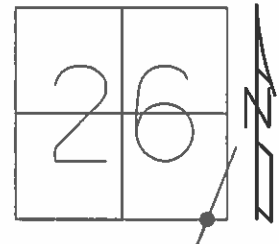

Grid: Northing: 653503.073 Easting: 1393482.018

NOTE: US6 = REF 11 B

RECORD:  
 1947 PLAN = P.O.T. STA 403+31.3  
 FROM THE WEST=  
 1957 PLAN P.O.T. STA 0+00 EAST

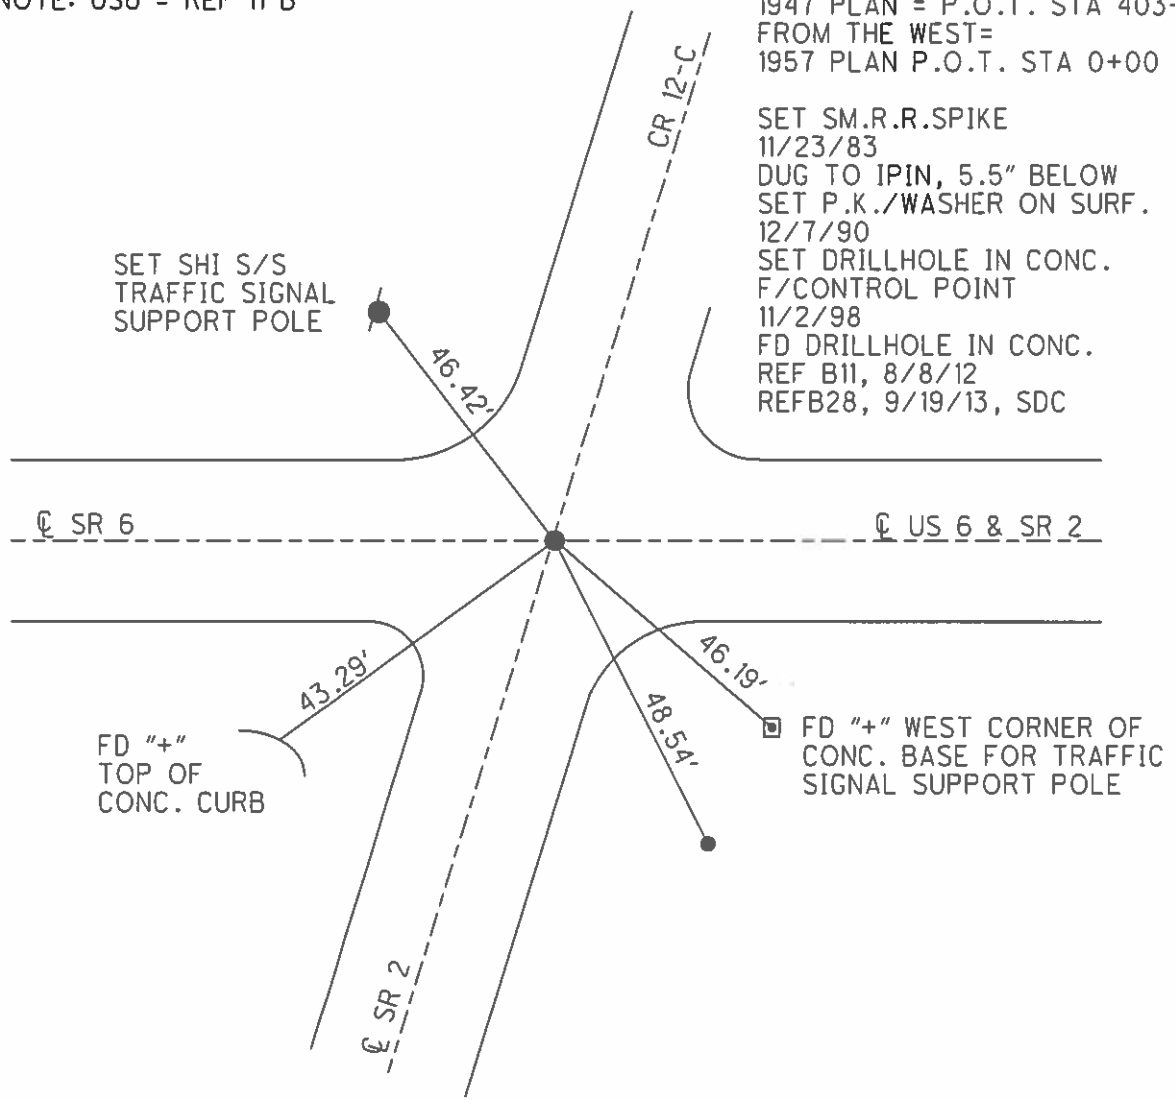

SET SM.R.R.SPIKE  
 11/23/83  
 DUG TO IPIN, 5.5" BELOW  
 SET P.K./WASHER ON SURF.  
 12/7/90  
 SET DRILLHOLE IN CONC.  
 F/CONTROL POINT  
 11/2/98  
 FD DRILLHOLE IN CONC.  
 REF B11, 8/8/12  
 REFB28, 9/19/13, SDC

# O.D.O.T. DISTRICT 2 SURVEY OFFICE

PERSONNEL

REFERENCE NO. 11-B

SHEET      OF     

NOTES HOFFMAN

H.C. BARNHISEL

R.C. LOHRKE

DATE 10-12-88

WEATHER R CLEAR

TEMP. 49°

ROUTE US 6

COUNTY Williams

TOWNSHIP CENTER

SECTION 26

T6 NR 2 E

TYPE MONUMENT SMALL R.R. SPIKE


ON SURFACE - BELOW YES

LEFT- & PAV'T. - RIGHT CTR of BOTH

     TO EDGE PAVEMENT

S.L.M. 579 +09


28-B

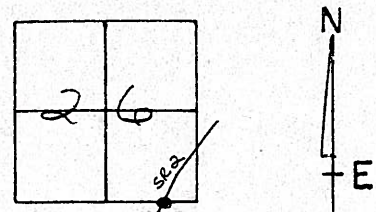

**RECORD:**

1947 PLAN = P.O.T. sta 403+31.3  
 FROM THE WEST =  
 1957 PLAN P.O.T. sta 0+00 EAST

Set SMALL R.R. SPIKE  
 11-23-88 SWH

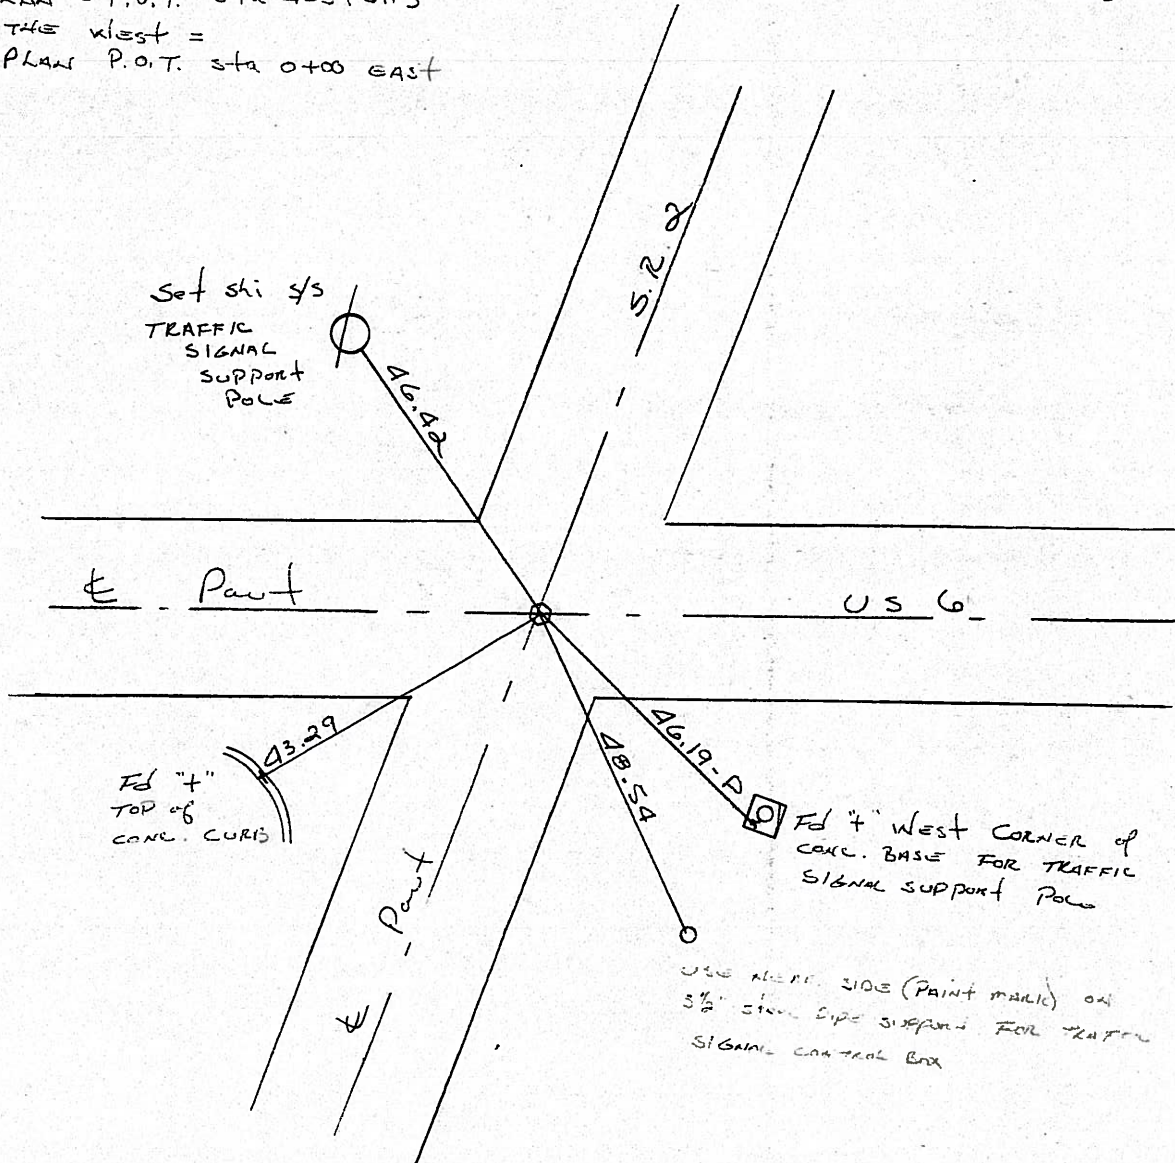



County WILLIAMS S.R. 2

Date 6-4-79

Township \_\_\_\_\_

Weather CLEAR

Section \_\_\_\_\_

Temp. +82°

T N, R E



Personnel BURNSIDE

SMITH

BOWERS

KNAPE

MEAD

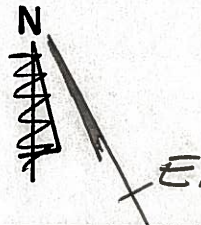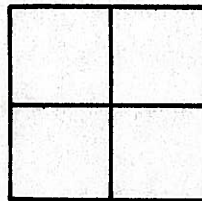

#28-B

FD. SMALL R.R. SPK. @  
SURFACE E' IN CTR.  
INTERSECTION

P.O.C. OLD STA. = 66+85.3

#2

" " TOP CONC. CURB  
OF TRAFFIC ISLAND


#6

" " TOP COR. OF  
CONC. BASE  
FOR TRAFFIC  
SIGNAL

" " TOP COR. OF  
CONC. BASE FOR  
TRAFFIC SIGNAL

" " TOP CONC.  
CURB OF TRAFFIC  
ISLAND

S.R.

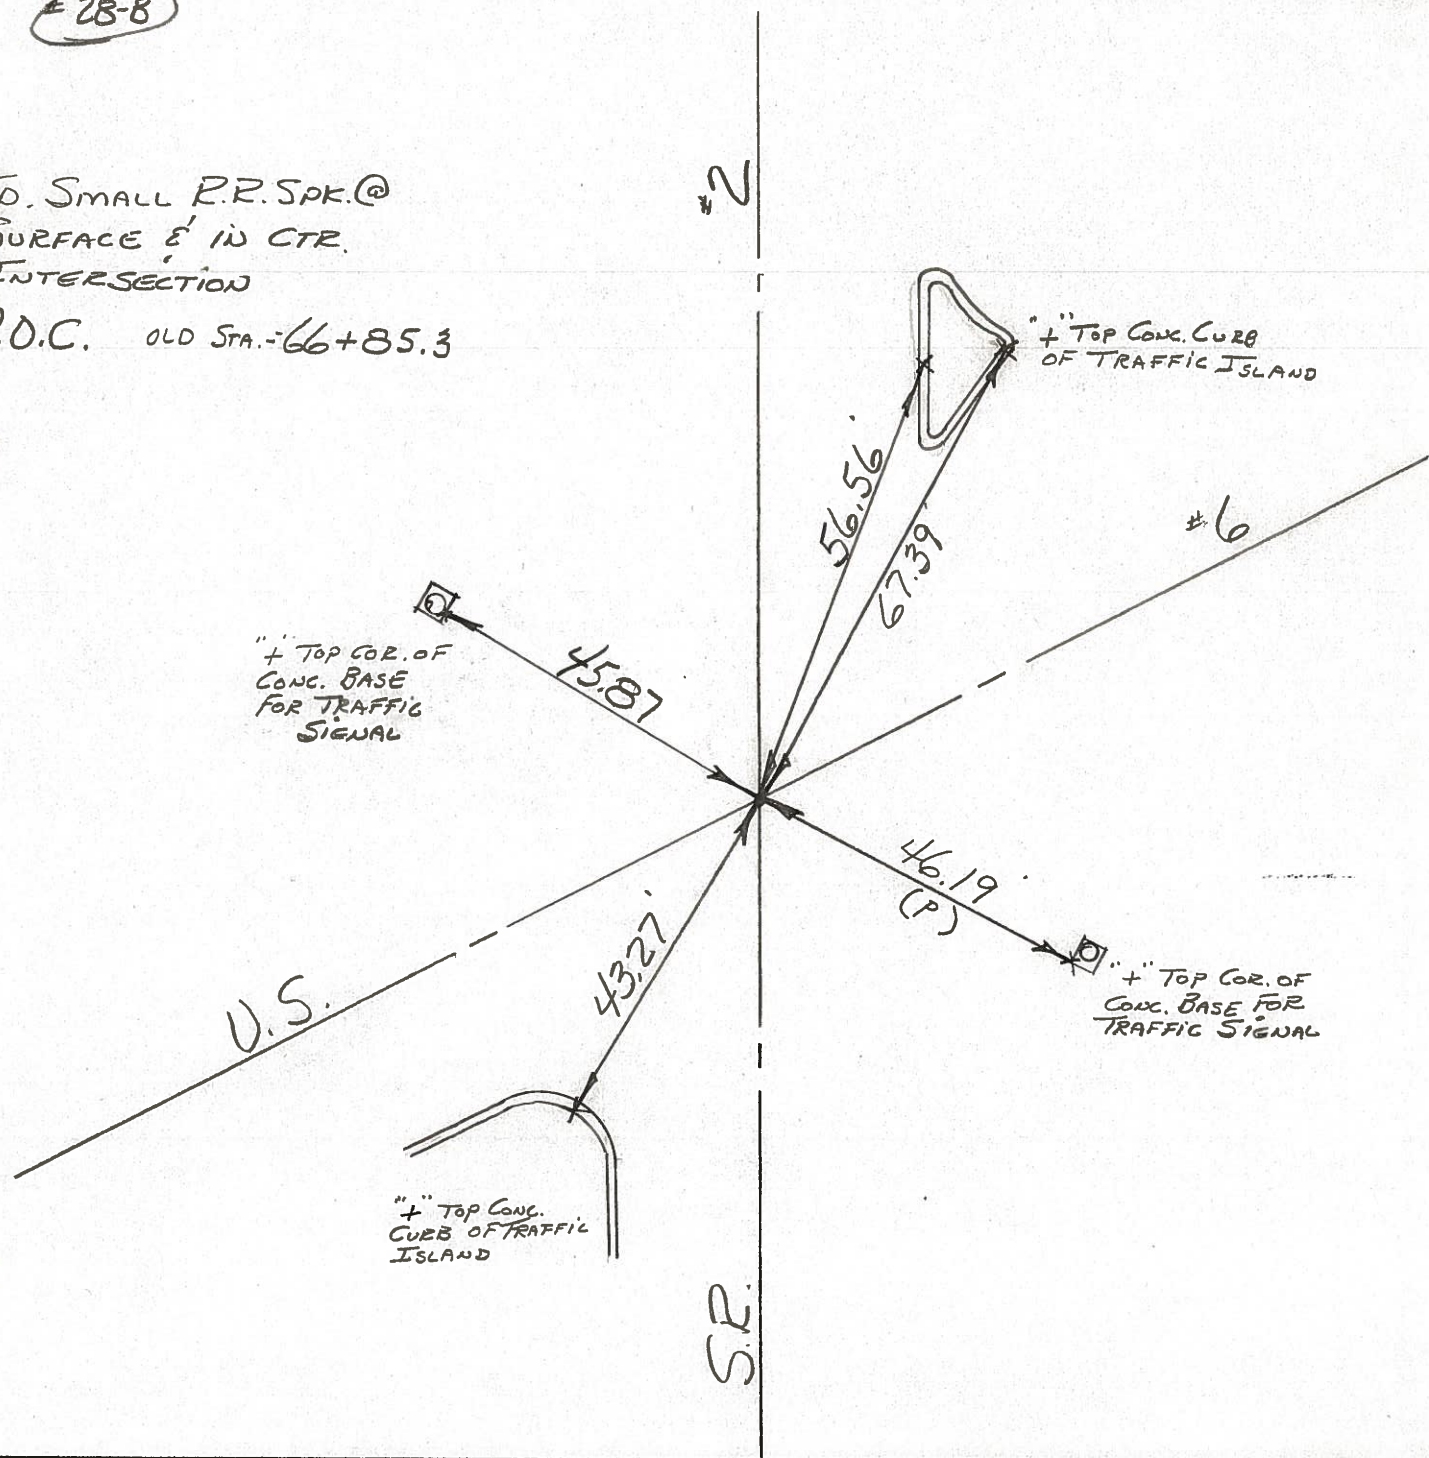



PERSONNEL TITLE PERSONNEL TITLE

COUNTY W.V.

DATE 7-15-58

Louys  
Pessell  
Wise  
Koehn

S. R. 2  
Williams Center  
to Bryan

WEATHER Cloudy  
TEMP. 75°

DESCRIPTION

Re-check of witnesses.

JOB NO. \_\_\_\_\_

LEFT

CENTER LINE

RIGHT

