

O.D.O.T. DISTRICT 2 SURVEY OFFICE

PERSONNEL _____

REFERENCE NO. 29-A

SHEET _____ OF _____

NOTES BARNHISEL

H.C. Loehke

R.C. _____

DATE 8-21-89

WEATHER Sunny

TEMP. +75°

ROUTE S.R. 2

COUNTY Williams

TOWNSHIP Center

SECTION 26

T. 6 N. R. 2 E.



TYPE MONUMENT Sm RR Spk

ON SURFACE - ~~BELOW~~ yes

LEFT ~~PAV'T.~~ - RIGHT OFF Roadway

- TO - EDGE PAVEMENT

S.L.M. 70+36

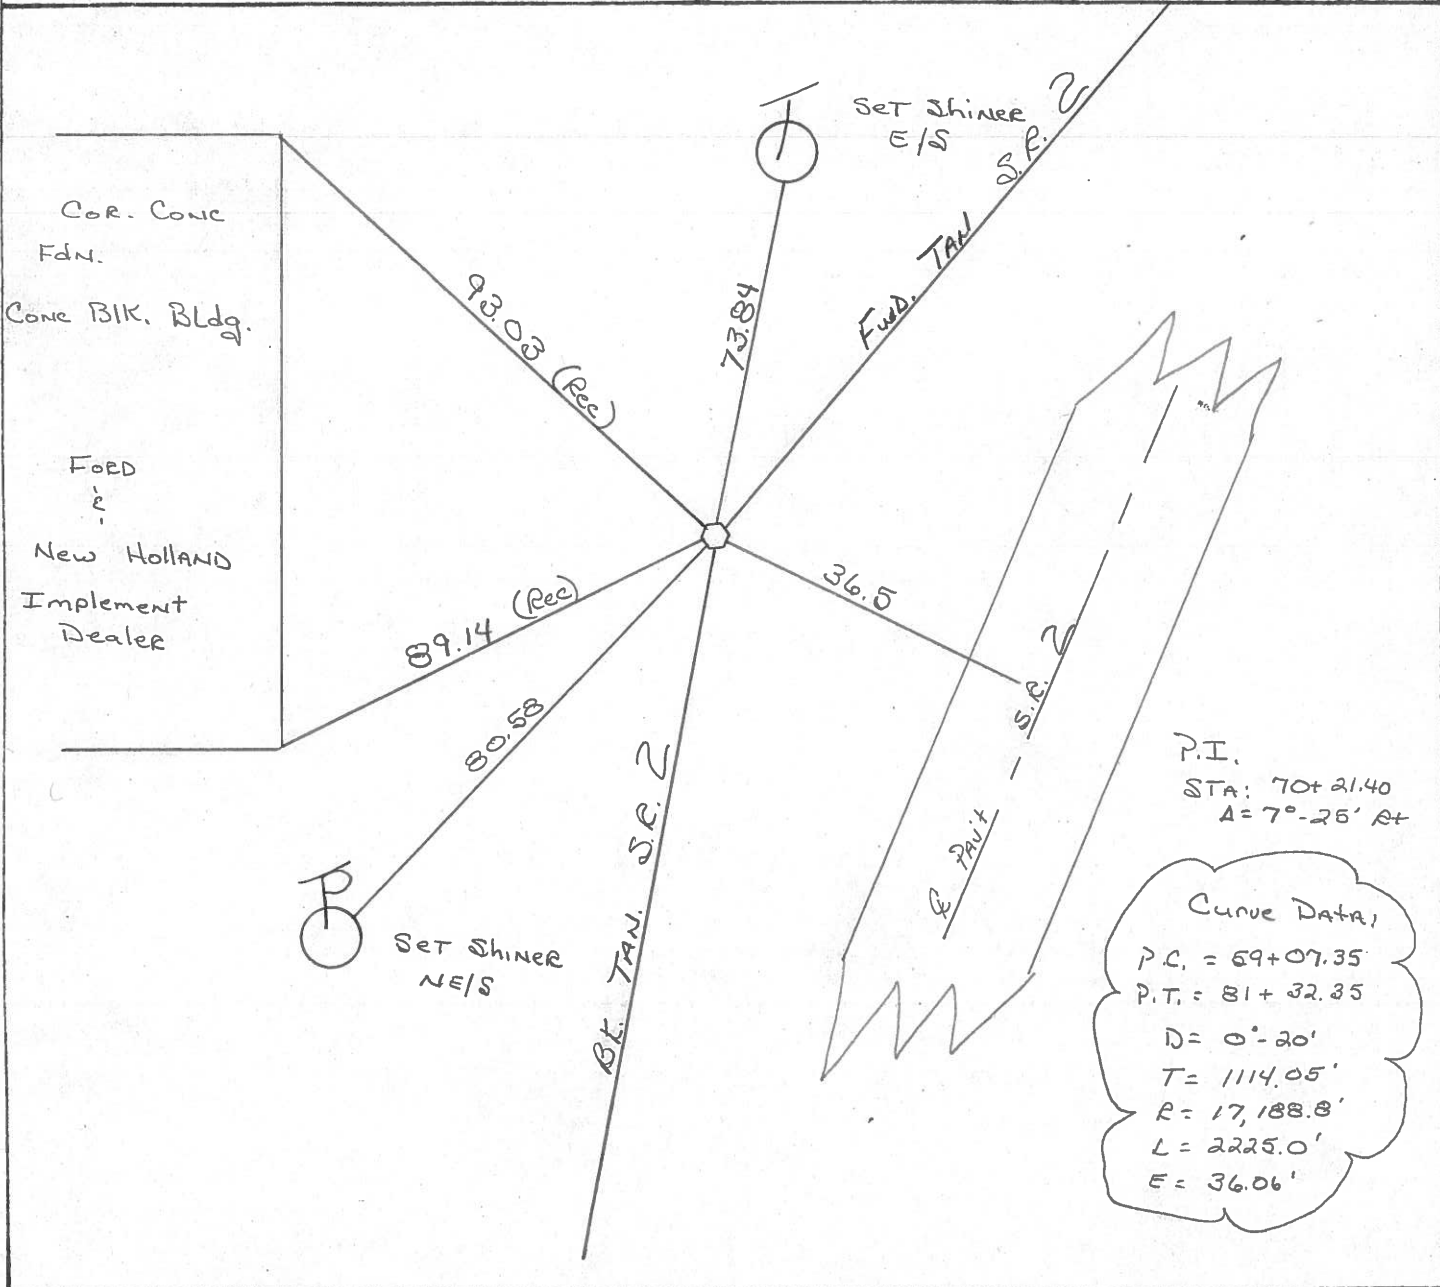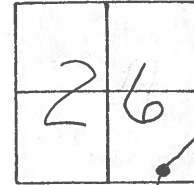

County Williams S.R. 2

Date 6-4-79

Township _____

Weather CLEAR

Section _____

Temp. +85°

T N, R E



Personnel BURNSIDE

SMITH

BOWERS

KNAPE


MEAD

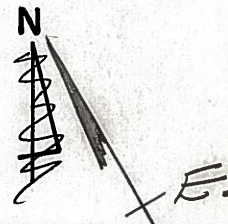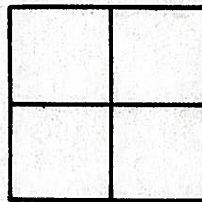


#29-A

P.I. STA. 70+21.40
 $\Delta = 7^\circ 25' \text{ Rt.}$

CURVE DATA:
P.C. = 59+07.35
P.T. = 81+32.35
D = 0° 20'
T = 1114.05'
R = 17,188.8'
L = 2225.0'
E = 36.06'

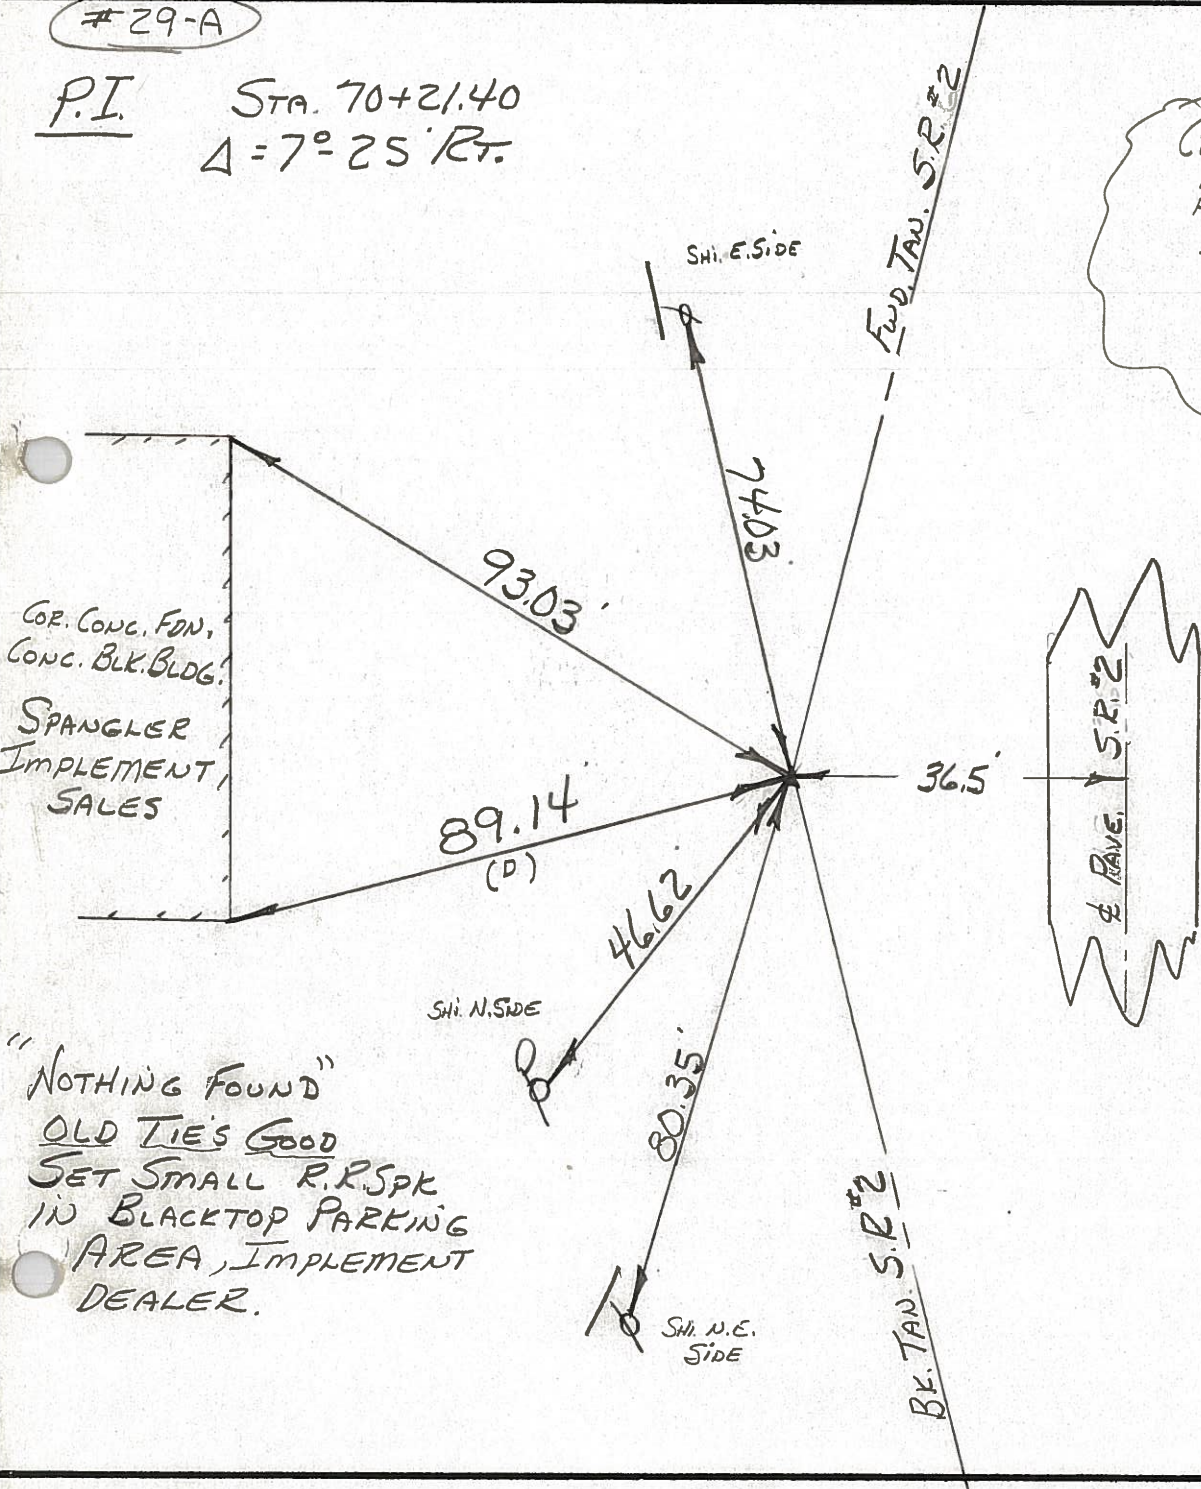

COR. CONC. FDN,
CONC. BLK. BLDG.
SPANGLER
IMPLEMENT
SALES

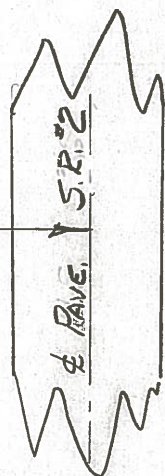

"NOTHING FOUND"
OLD TIES GOOD
SET SMALL R.R. SPK
IN BLACKTOP PARKING
AREA, IMPLEMENT
DEALER.

BE. TAN. S.R. #2

SHI. N.E. SIDE