

O.D.O.T. DISTRICT 2 SURVEY OFFICE

PERSONNEL _____

REFERENCE NO. 31-B

SHEET _____ OF _____

NOTES BARNHISEL

H.C. Lochete

R.C. _____

DATE 8-21-89

WEATHER SUNNY

TEMP. +75°

ROUTE S.E. 2

COUNTY Williams

TOWNSHIP Center

SECTION 25

T. 6 N. R. 2 E.


TYPE MONUMENT Sm RR Spk

ON SURFACE - BELOW 2"


LEFT - & PAV'T. - RIGHT yes

9.7 TO LT EDGE PAVEMENT

S.L.M. 118+91

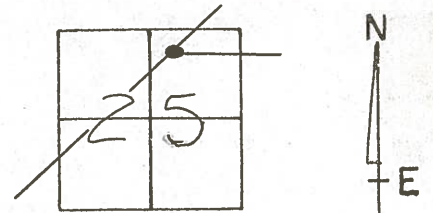

Set P.K. & Wlashee
12-5-89
MB

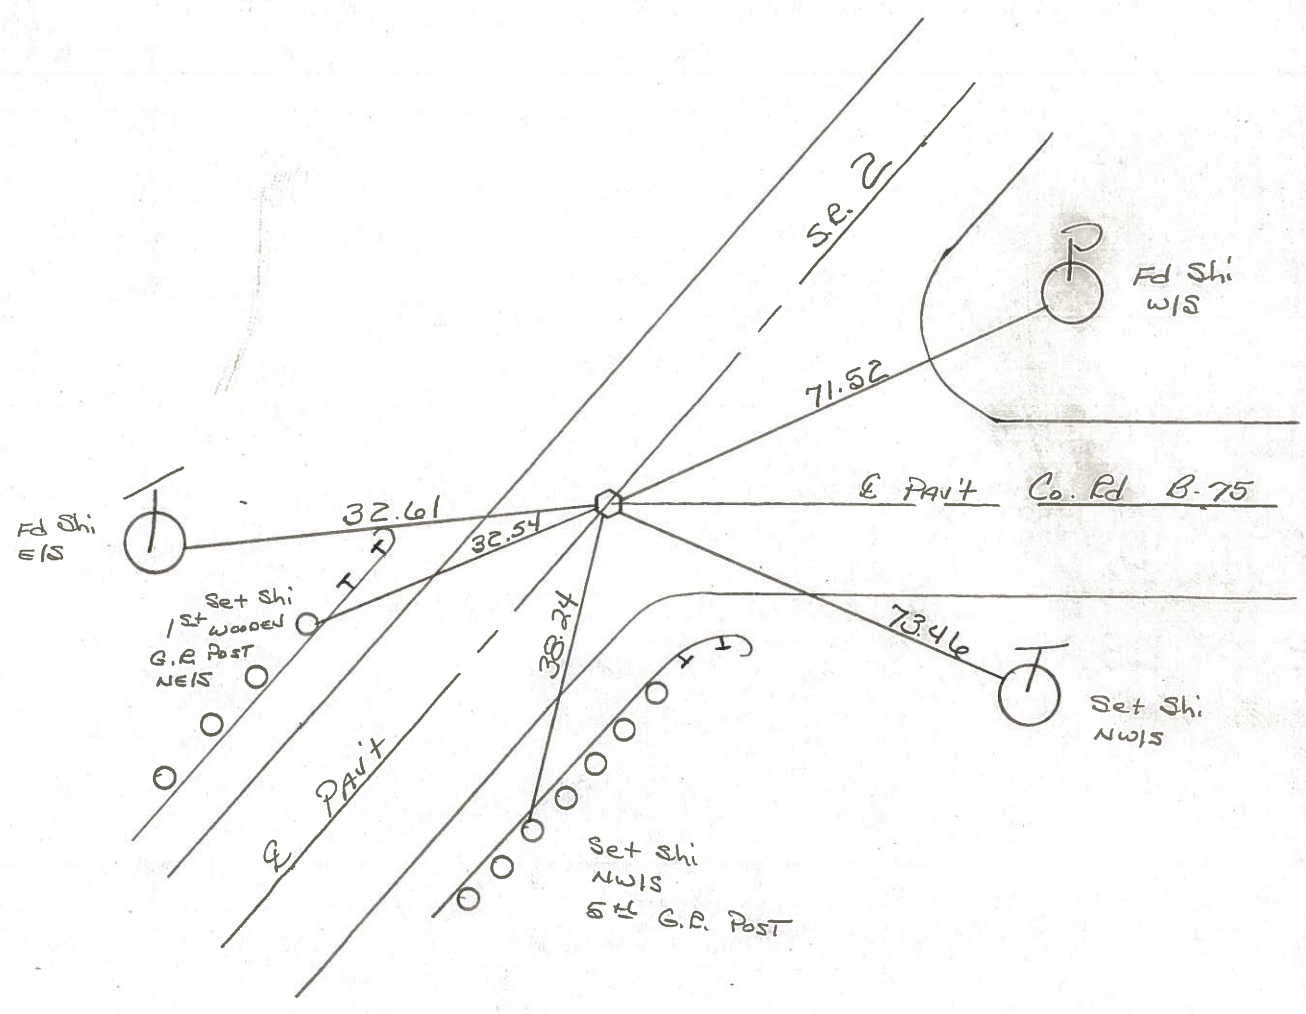

County Williams S.R. #2

Date 27 July 84

Township Center

Weather Cloudy

Section 25

Temp. 70°


T N, R E

Personnel I. Stone

P. Newson


R. Michalak

D. Curtis

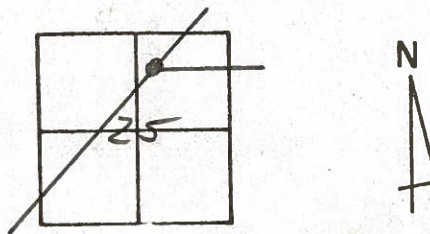

SLM STA 118+81

REF. NO. 31-B

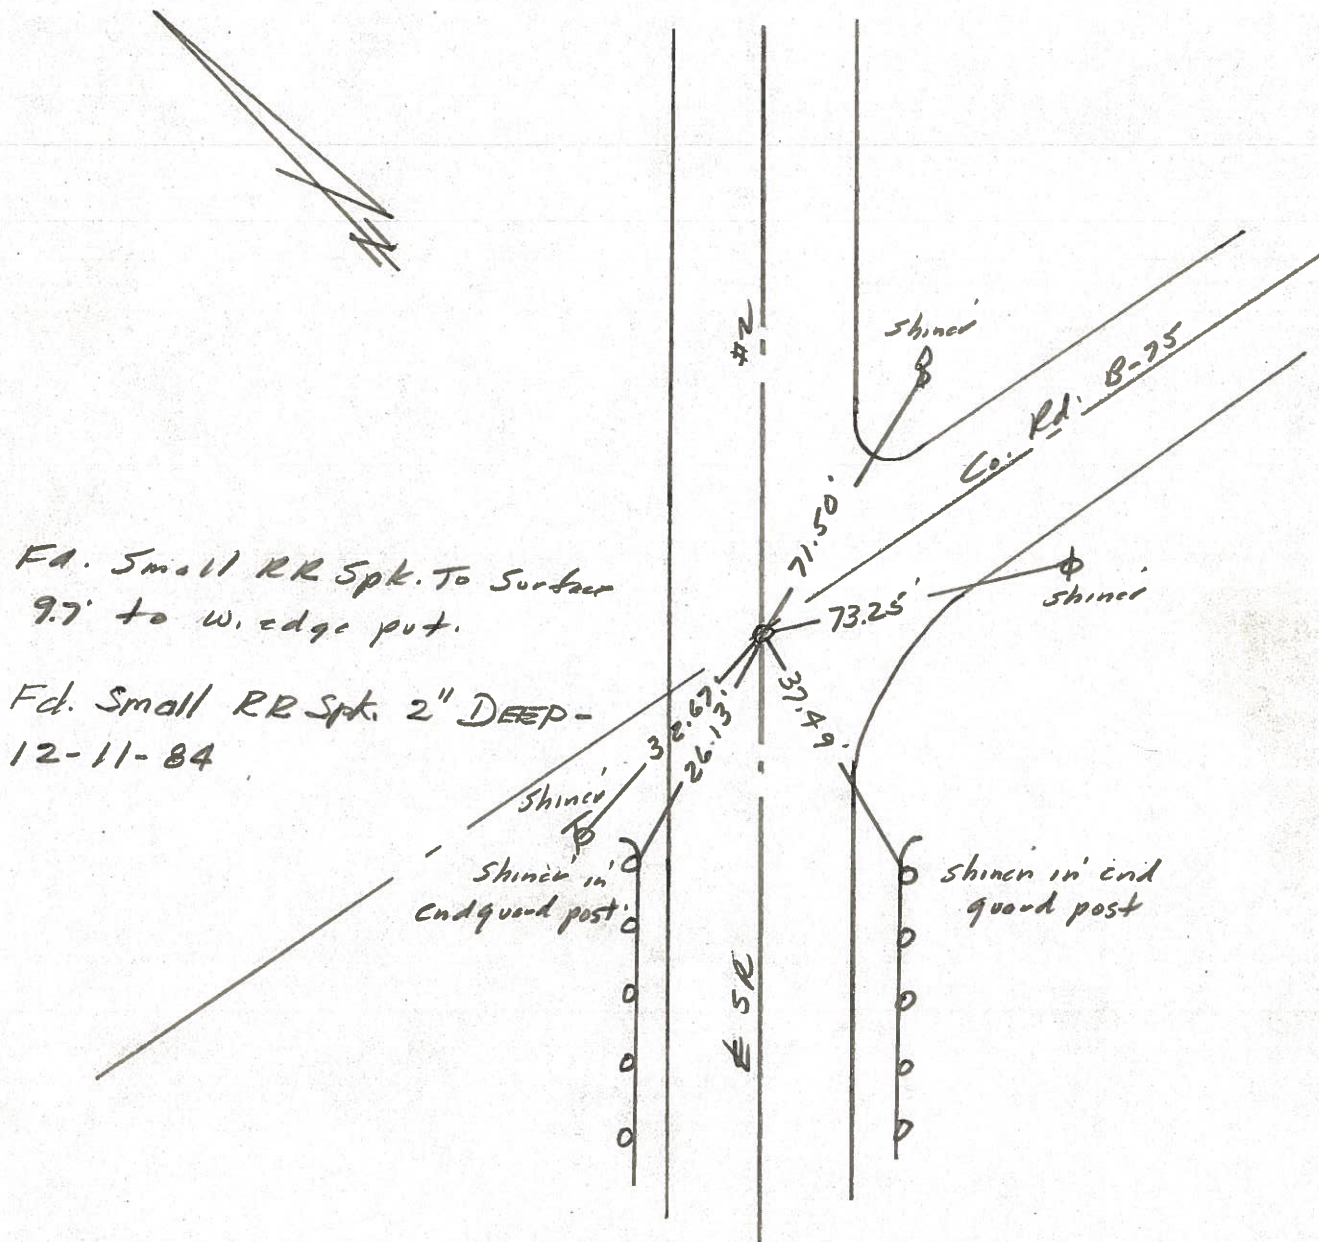

Fd. Small RR Spk. To Surface
9.7' to W. edge post.

Fd. Small RR Spk. 2" DEEP -
12-11-84