

# O.D.O.T. DISTRICT 2 SURVEY OFFICE

PERSONNEL \_\_\_\_\_

REFERENCE NO. 32

SHEET \_\_\_\_\_ OF \_\_\_\_\_

NOTES BRENHISEL

H.C. Loehcke

R.C. \_\_\_\_\_

DATE 8-21-89

WEATHER SUNNY

TEMP. +75°

ROUTE S.E. 2

COUNTY Williams

TOWNSHIP Center

SECTION 25

T 4 N R 2 E


TYPE MONUMENT 3m RE Spk

ON SURFACE - BELOW 2"


LEFT - Q PAV'T. - RIGHT YES ON Q OF #1250 Also

- TO - EDGE PAVEMENT

S.L.M. 121+89

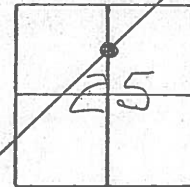

Set P.K. & Washer  
12-5-89  
MB

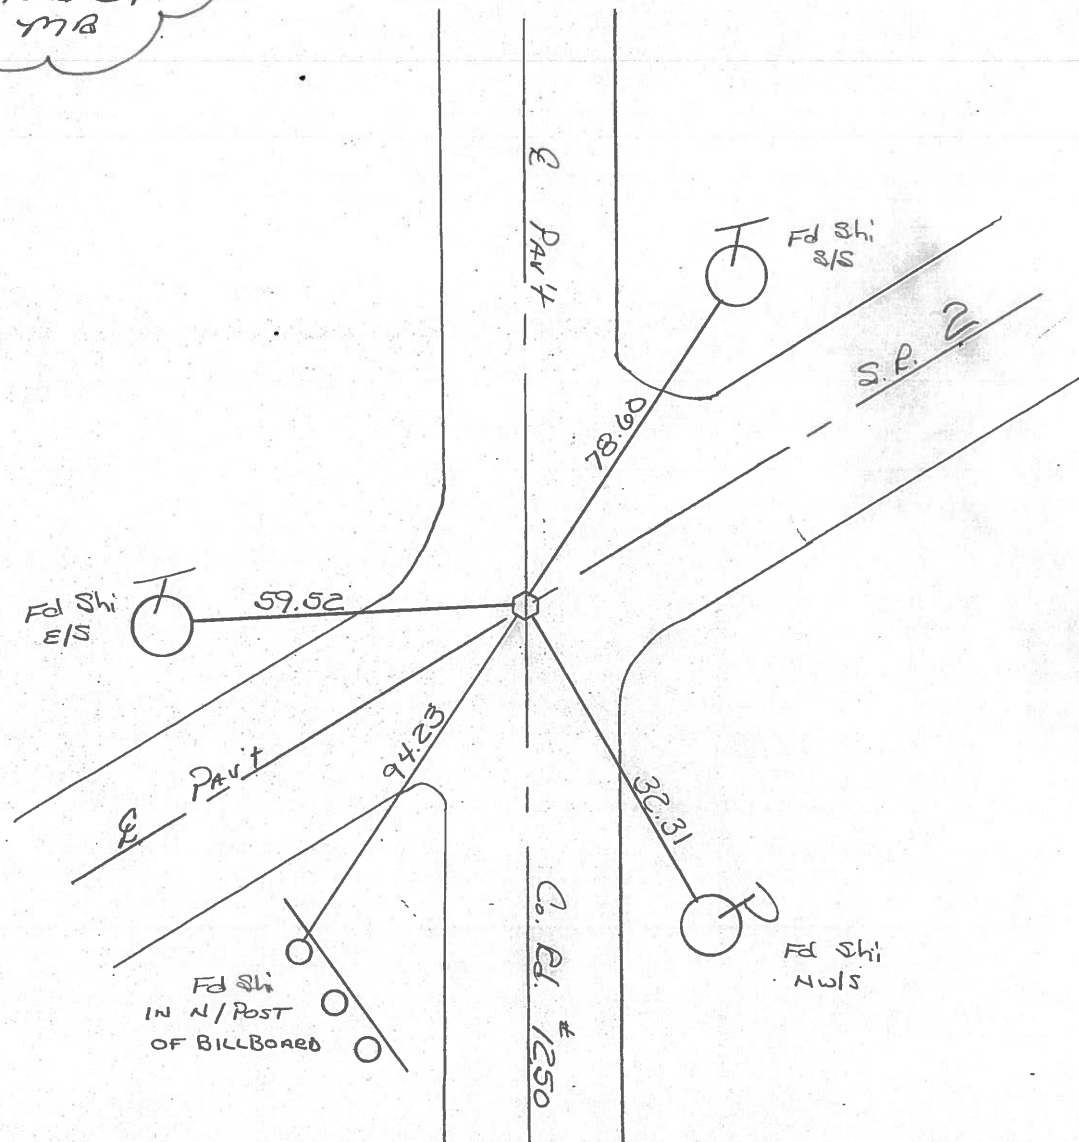

County Williams S.R. #2

Date 27 July 84

Township Center

Weather Cloudy

Section 25

Temp. 70°


T N, R E

Personnel L. Stone

P. Nourse

R. Michalak

D. Curtis

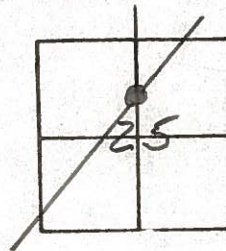

SLM STA. 121+76

REF. NO. 32-B

