

# O.D.O.T. DISTRICT 2 SURVEY OFFICE

PERSONNEL \_\_\_\_\_

REFERENCE NO. 32-A

SHEET \_\_\_\_\_ OF \_\_\_\_\_

NOTES BAENHISEL

H.C. Loehcke

DATE 8-21-89

ROUTE S.R. 2

R.C. \_\_\_\_\_

WEATHER Sunny

COUNTY Williams

\_\_\_\_\_

TEMP. +75°

TOWNSHIP Center

\_\_\_\_\_

SECTION 25

T. 6 N. R. 2 E.



TYPE MONUMENT 3/8" Iron Rod

ON SURFACE - BELOW 5"

LEFT - C. PAV'T. - RIGHT 16.2

5' ± ~~TO~~ <sup>ET</sup> EDGE PAVEMENT

S.L.M. 125+51

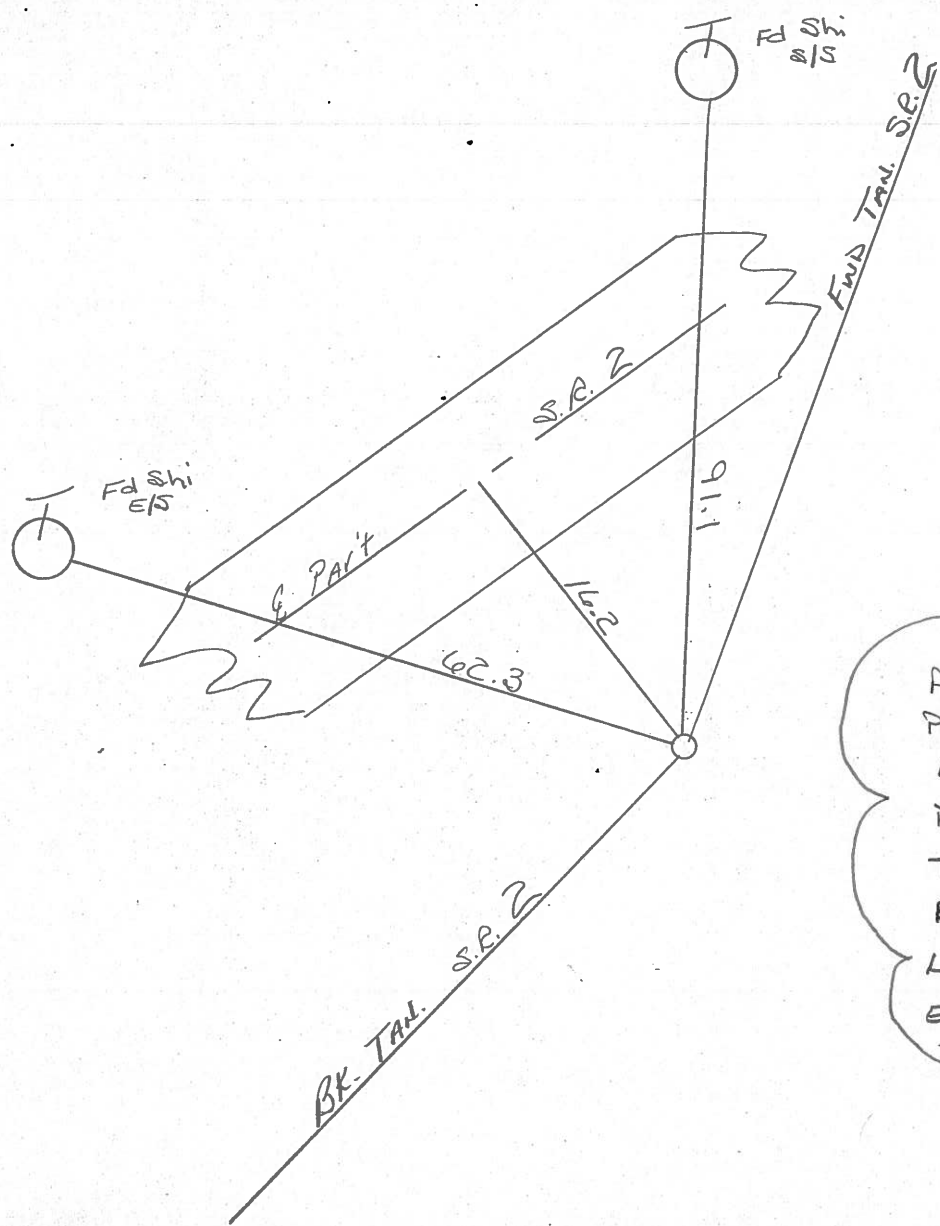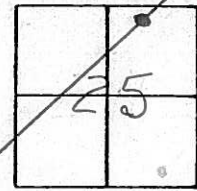

Curve Data:

P.C. = 122+92 ±  
 P.T. = 127+84 ±  
 A = 14°-46' Lt  
 D = 3°-00'  
 T = 247.48'  
 R = 1909.86  
 L = 492.22  
 E = 15.96

County WILLIAMS S.R. 2

Date 6-6-79

Township \_\_\_\_\_



Weather CLOUDY

Section \_\_\_\_\_

Temp. +78°

T N, R E


Personnel BURNSIDE  
SMITH  
BOWERS  
KNAPE  
MEAD

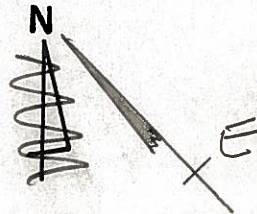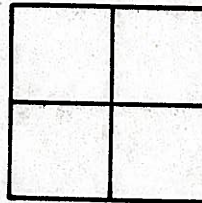

#32-A

P.I. STA. 125+40 ±

CURVE DATA:  
 P.C. = 122+92 ±  
 P.T. = 127+84 ±  
 Δ = 14° 46' Lt.  
 D = 3° 00'  
 T = 247.48'  
 R = 1909.86'  
 L = 492.22'  
 E = 15.96'

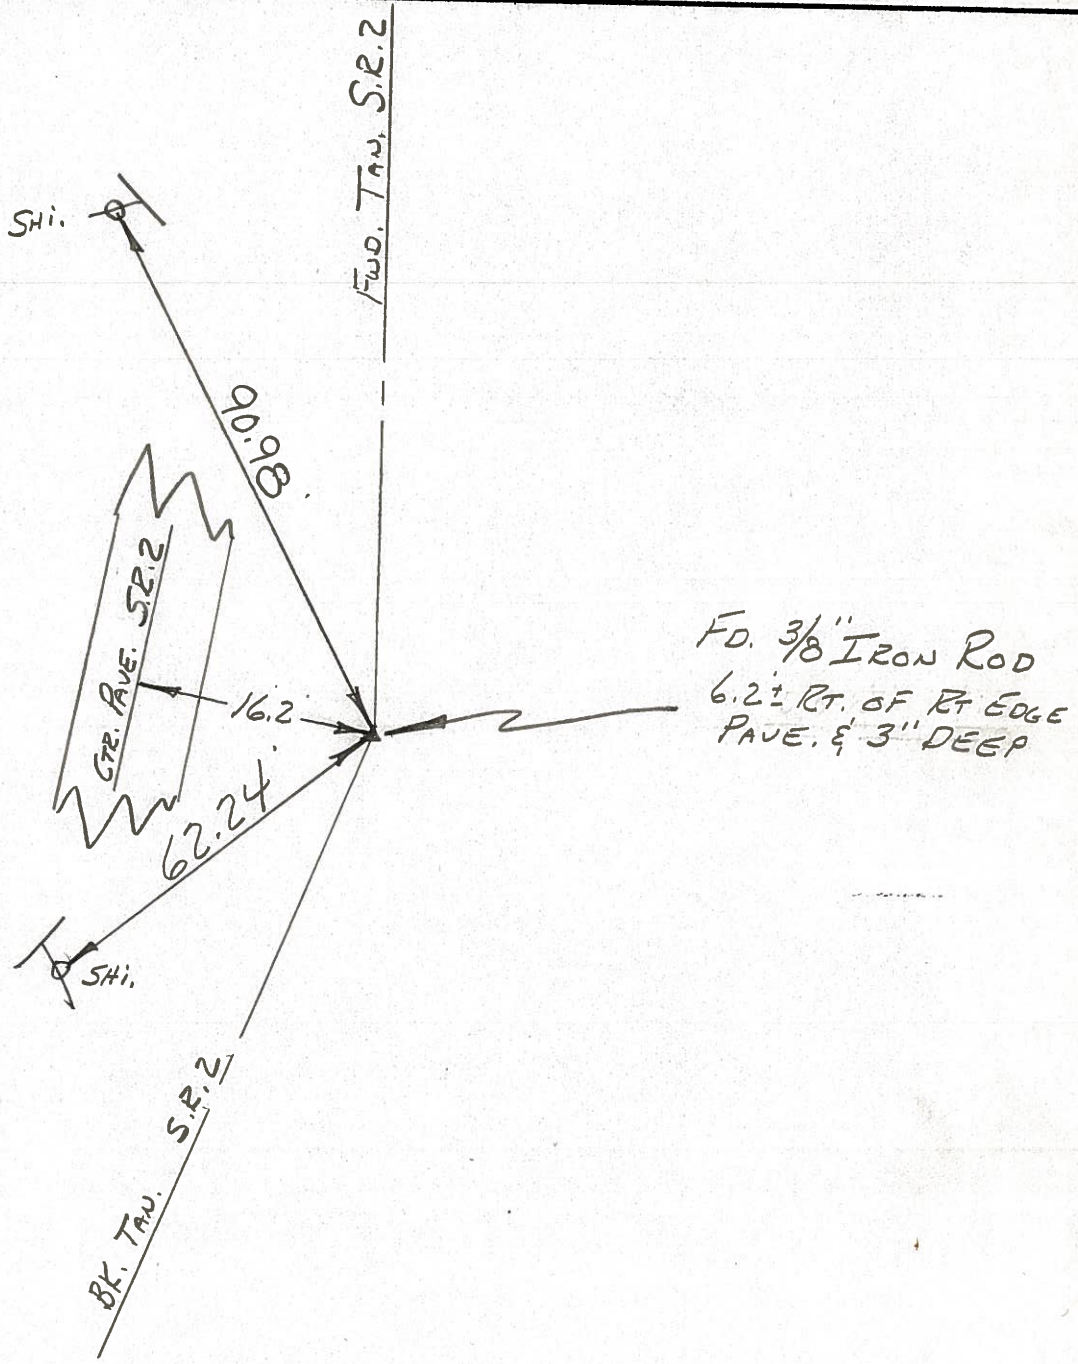



PERSONNEL TITLE PERSONNEL TITLE

COUNTY Wi.

DATE 7-15-58

Louys  
Pass-fall  
Wise  
Krohn

S. R. 2  
Williams Center  
to Bryan.

WEATHER Fair.  
TEMP. 75°

DESCRIPTION

Re-check of Witnesses

JOB NO.


LEFT

CENTER LINE

RIGHT


12

P.I. Sta. 162+46.34  
 $\Delta = 21^{\circ} 01' Lt.$   
R.R. Spike,

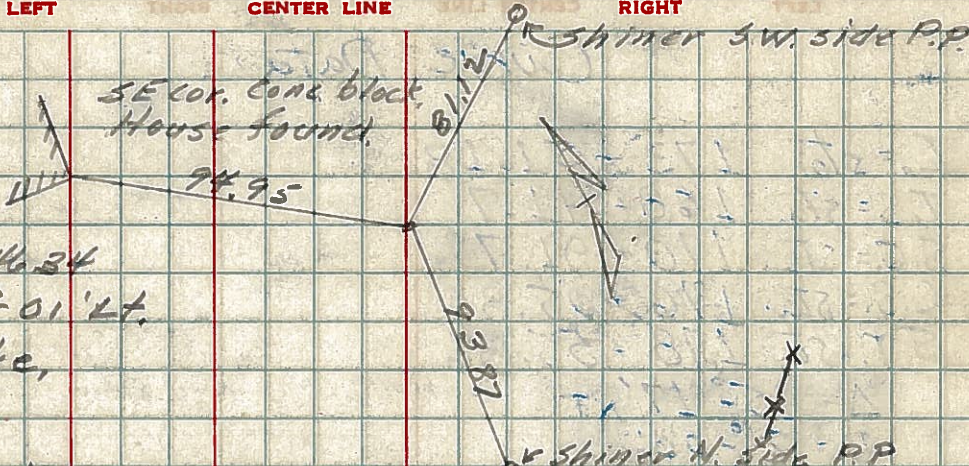


11

P.I. Sta. 137+  
 $\Delta = 30^{\circ} 10' Rt.$   
Tie Bolt  
(6' Below Part)

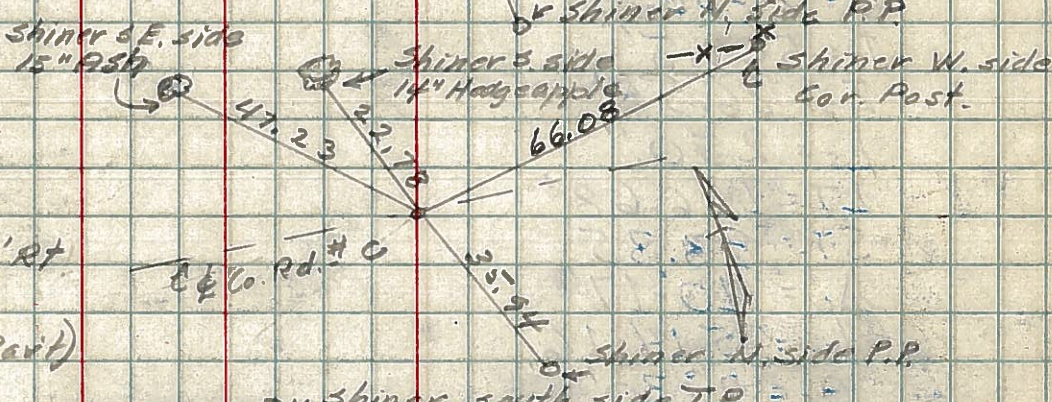

10

P.I. Sta. 125+40±  
Found Hub  
Placed 3/8" Iron Rod

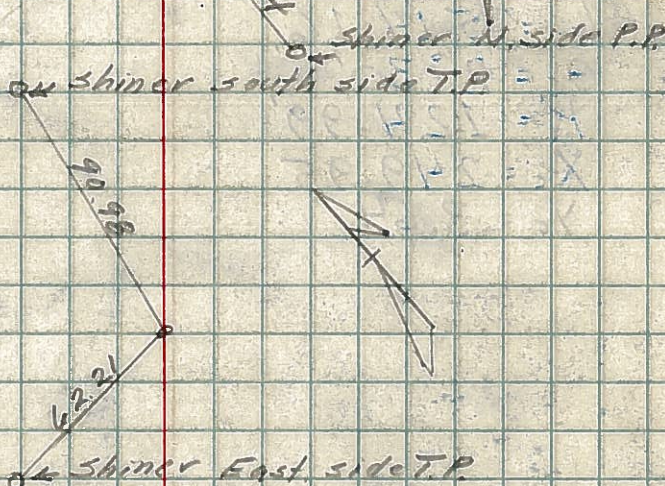

9

P.I. Sta. 103+28.5  
 $\Delta = 0^{\circ} 02' Lt.$   
Monument

